

[illegible]

A

B

C

D

E

DO NOT
SCALE

F

ANTENNA MOUNTS

TYPE: EXISTING & PROPOSED TELSTRA
STEEL PIPES
COLOUR: GALVANISED FINISH
REFERENCE DRAWING: SHEETS T3-4
TO T3-12 & T8-7

GENERAL NOTES

"DURING BUILD WORKS, THE ELECTRICIAN SHALL CAPTURE AC POWER-RELATED INFORMATION FROM THE SITE AND COMPLETE THE PVA REPORT, PROVIDE AC POWER PHOTOS, AND A SINGLE-LINE DIAGRAM SO THAT AN E2 SHEET CAN BE PRODUCED AS PART OF THE HOP PACK TO TELSTRA"

SPECIFY PROPERTY SIGNAGE AS PER
DOCUMENT 017866A12.
PROPERTY SIGN INCLUDES RFNSA
SITE NUMBER.
SITE NAME: BRANDED SITE IDENTIFICATION
REGULAR (BSr).
TELSTRA S/I NUMBER 187/00929.
JABAC PART NUMBER TFMS929-M.

VIA 9 MISSENDEN RD, CAMPERDOWN, NSW 2050
REFER TO SHEET S1 FOR DETAILS

SITE SIGNAGE

ALL EME SIGNAGE IS REFERENCED ON
DRAWINGS S1, S1-1, S3, S3-1 & S3-2.
REFER TO DOCUMENT 005486 FOR DETAILS.

A

B

C

D

E

**UNAPPROVED
DRAWING**

FOR CONSTRUCTION



MOBILE NETWORK SITE 40893
CAMPERDOWN RYDGES MISSENDEN RD
 SITE SPECIFIC NOTES - SHEET 1 OF 3
 9 MISSENDEN RD, CAMPERDOWN, NSW 2050

DWG NO.	N26167	SHT NO.	S0
------------	--------	------------	----

NOTE: THIS DRAWING TO BE READ IN CONJUNCTION WITH SHEETS S0-1 & S0-2

ORDER	DRWN	CHKD	AMENDMENT	EXAM	APPD	DATE	ISS
NA15095.01	SB	SB	AS BUILT 7267045 W0001 LTE700	SB	BB	21.11.14	3
NA17236.01	MS	LY	AS BUILT - 30060257W0071ERIC - RRU AND LTE2600 UPDATE	KSK	CF	09.05.17	4
NA21231.01	SH	JG	FOR CONSTRUCTION 30084274 WO267 5G NR3600	MWM	MWM	30.04.20	5
NA21231.01	UH	RM	AS BUILT - 30084274 WO315 - NR3600	DEG	DEG	11.08.20	6
NA23527.01	LB	WR	AS BUILT - 30092852WO195ERIC - M700/NR850/DSS26	PD	DEG	09.02.22	7
NA25797.01	RS	RT	FOR CONSTRUCTION - 80005689WO540CYI - LTE2100	MB	MB	21.05.26	8

© Telstra Limited ACN 086 174 781 All rights reserved.

CYIENT

Level-14, 3 Parramatta Square, 153 Macquarie St, Parramatta, NSW 2150, Australia
T +61 2 8896 6160 | www.cvient.com

1

2

3

4

5

6

A

B

C

D

E

F

EQUIPMENT NOTES - PROJECT NO. NA25797.01

ITEM	EQUIPMENT	EQUIPMENT DETAILS	EXISTING	PROPOSED	TOTAL	REFERENCE DWG
1	45RU PATHFINDER RACK	530 x 530 x 2200mm (W,D,H)	1	0	1	SHEETS E1 & E5
2	DECON RGL-091 RACK	-	1	0	1	SHEETS E1 & E5
3	FILTER RACK	-	1 (SPARE)	0	0	SHEET E1
4	HALLAM RACK	600 x 800 x 1860mm (W,D,H)	1	0	1	SHEET E1
5	ELTEK SP22-HC (PSU)	600 x 600 x 2200mm (W,D,H)	1	0	1	SHEET E4
6	ELTEK SP22-HC RECTIFIERS	FP HE, 2kW	8	0	8	SHEET E4
7	ELTEK SP22-HC DC-DC CONVERTERS	48V FP2, 1.35kW	8	0	8	SHEET E1
8	ELTEK SP22-HC BATTERY STRINGS	SBS190F EON	3	0	3	SHEET E1
9	ENATEL DC/DC CONVERTERS	CM1748-48	3	0	3	SHEET E1
10	ENATEL DC-DC CONVERTER SUB RACK	-	1	0	1	SHEET E1
11	ERICSSON DCDU	TO BE INSTALLED IN PATHFINDER RACK AT RT/1/1	0	1	1	SHEET E5
12	KEREM A100 PDP	INSTALLED IN DECON RGL-091 RACK AT RT/2/3	1	0	1	SHEET E5
13	ERICSSON RBS3206 (WCDMA850)	600(W) x 470(D) x 1850(H) NATURAL COLOUR	1 (SPARE)	0	1	SHEET E1
14	ERICSSON RBS6202	500 x 525 x 568mm (W,D,H) SUPPORT TYPE 19" RACK	1	1 (SPARE)	1	SHEET E5
15	ERICSSON BB6630	INSTALLED IN PATHFINDER RACK AT RT/1/1	3	-3	0	SHEET E5
16	ERICSSON RP6672 (LTE700/NR850/LTE1800/LTE2100/NR/LTE2600/NR3600)	TO BE INSTALLED IN PATHFINDER RACK AT RT/1/1	0	1	1	SHEET E5
17	ERICSSON DUW 30 01	INSTALLED IN PATHFINDER RACK AT RT/1/1	1	-1	0	SHEET E5
18	ERICSSON RUS 02 (B28B)	INSTALLED IN RBS6202 AT RT/1/1	6	6 (SPARE)	6	SHEETS E1 & E5
19	ERICSSON R503	INSTALLED IN PATHFINDER RACK AT RT/1/1	2	-2	0	SHEETS E1 & E5
20	ERICSSON R6675 ROUTER	TO BE RELOCATED IN PATHFINDER RACK RT/1/1	1	0	1	SHEETS E1 & E5
21	FIBRE PATCH PANEL	TO BE INSTALLED IN PATHFINDER RACK RT/1/1	1	0	1	SHEET E5
22	SLIDE OUT FIBRE MANAGEMENT TRAYS	TO BE INSTALLED IN PATHFINDER RACK RT/1/1	1	1	2	SHEET E5
23	FIBRE MANAGEMENT TRAYS	-	2	-1	1	SHEETS E1 & E5
24	HYBRID CABLE MANAGEMENT TRAYS	TO BE INSTALLED IN PATHFINDER RACK RT/1/1	0	3	3	SHEET E5
25	4490 ADAPTOR SHELFs	TO BE INSTALLED IN DECON RGL-091 RACK AT RT/2/3	0	3	3	SHEET E5
26	ERICSSON SITE INTEGRATION UNIT (SIU)	482 x 350 x 45mm (W,D,H)	1	1 (SPARE)	1	SHEET E1
27	ERICSSON SITE CONTROLLER (ESC)	INSTALLED IN RT/2/4 RACK	1	0	1	SHEET E1
28	VERTIV EXTERNAL SURGE PROTECTION DEVICE (12.3 WAY)	IN WEATHER PROOF ENCLOSURE/WALL MOUNTED	1	0	1	SHEET E1
29	SPD MODIFICATION KIT 101	-	1	0	1	-
30	W&B RRU INTERFACE JUNCTION BOX (4P16F)	TC4039MOBILE02	3	0	3	SHEETS S1-1, S3, S3-1 & S3-2

SITE DESIGN BRIEF (LTE2100) (NA25797.01)
ISSUE 01 DATED 12/09/2025

NOTE: THIS DRAWING TO BE READ IN CONJUNCTION WITH SHEETS S0 & S0-2

CYIENT

Level-14, 3 Parramatta Square, 153 Macquarie St, Parramatta, NSW 2150, Australia
T +61 2 8896 6160 | www.cyient.com

ORDER	DRWN	CHKD	AMENDMENT	EXAM	APPD	DATE	ISS
XMJUNWCF.01	KM	SK	XMJ - 30053116W0286TELSTRA - LTE700	LY	BB	01.07.16	4
NA17236.01	MS	LY	AS BUILT - 30060257W0071ERIC - RRU AND LTE2600 UPDATE	KSK	CF	09.05.17	5
NA21231.01	SH	JG	FOR CONSTRUCTION 30084274 WO267 5G NR3600	MWM	MWM	30.04.20	6
NA21231.01	UH	RM	AS BUILT - 30084274 WO315 - NR3600	DEG	DEG	11.08.20	7
NA23527.01	LB	WR	AS BUILT - 30092852WO195ERIC - M700/NR850/DSS26	PD	DEG	09.02.22	8
NA25797.01	RS	RT	FOR CONSTRUCTION - 800056889WO540CYI - LTE2100	MB	MB	21.05.26	9

© Telstra Limited ACN 086 174 781 All rights reserved.

UNAPPROVED
DRAWING

COMPLIANCE BOX

COMPLETED AS PER DESIGN

ALTERATIONS IN RED

NAME (PRINT)

SIGNATURE

DATE

FOR CONSTRUCTION

Telstra

MOBILE NETWORK SITE 40893
CAMPERDOWN RYDGES MISSENDEN RD
SITE SPECIFIC NOTES - SHEET 2 OF 3
9 MISSENDEN RD, CAMPERDOWN, NSW 2050

DWG NO.

N26167

SHT NO.

S0-1

DO NOT SCALE

F

1

2

3

4

5

6

A3

EQUIPMENT NOTES - PROJECT NO. NA25797.01

A

B

C

D

E

F

ITEM	EQUIPMENT	EQUIPMENT DETAILS	EXISTING	PROPOSED	TOTAL	REFERENCE DWG
31	ERICSSON RRUS 32 B3 (LTE1800)	431 (W) x 182 (D) x 500mm (H) NATURAL COLOUR	3	-3	0	SHEETS S1-1, S3, S3-1 & S3-2
32	ERICSSON RRUS 32 B7 (NR/LTE2600)	431 (W) x 182 (D) x 500mm (H) NATURAL COLOUR	3	-3	0	SHEETS S1-1, S3, S3-1 & S3-2
33	ERICSSON RADIO 4480 (B5/B28) (WCDMA850/LTE700/NR850)	400 x 145 x 550mm (W,D,H) NATURAL COLOUR	3	-3	0	SHEET E5
34	ERICSSON RADIO 4485 (B3/B1/B7) (LTE1800/LTE2100/NR/LTE2600)	398 x 145 x 533mm (W,D,H) NATURAL COLOUR	0	3	3	SHEETS S1-1, S3, S3-1 & S3-2
35	ERICSSON RADIO 4490HP (B28/B26) (LTE700/NR850)	397 x 165 x 522mm (W,D,H) NATURAL COLOUR	0	3	3	SHEET E5
36	ERICSSON DUAL DUPLEX FILTER (WCDMA850)	KRF 102 268/1	3 (SPARE)	0	3	SHEET E5
37	TRIASX DUAL DUPLEX FILTER (WCDMA850)	DDF0022	3 (SPARE)	0	3	SHEET E5
38	KAEIUS TWIN BANDSTOP FILTER	BSF0020F1V2	6	-6	0	SHEET E5
39	KAEIUS QUAD FILTERS (LTE700/NR850)	KA-6035	0	3	3	SHEET E5
40	KAEIUS TWIN COMBINER	DBC0086F1V1-1 INSTALLED IN PATHFINDER RACK AT RT/1/1	3	3 (SPARE)	3	SHEET E5
41	TRIASX DUAL DUPLEX FILTER (WCDMA850)	DDF0022F1V1	6 (SPARE)	0	6	SHEET E1
42	KAEIUS TWIN TMA (LTE700/WCDMA850/NR850)	TMA21058F01V2-1E	6	-6	0	SHEETS S1-1, S3, S3-1 & S3-2
43	KAEIUS TMA (LTE700/NR850)	KA-1031 TMA	0	6	6	SHEETS S1-1, S3, S3-1 & S3-2
44	ANDREW LDF5-50	30m LENGTH	6, 4 (SPARE)	6 (SPARE)	10	SHEETS S1-1, S3, S3-1 & S3-2
45	RFS LCF78-50JA	38m LENGTH	3	0	3	SHEETS S1-1, S3, S3-1 & S3-2
46	RFS LCF78-50J	38m LENGTH	3	0	3	SHEETS S1-1, S3, S3-1 & S3-2
47	RFS LCF78-50JA	27m LENGTH	2	0	2	SHEETS S1-1, S3, S3-1 & S3-2
48	RFS LCF78-50J	27m LENGTH	2	0	2	SHEETS S1-1, S3, S3-1 & S3-2
49	RFS LCF78-50JA	13m LENGTH	1	0	1	SHEETS S1-1, S3, S3-1 & S3-2
50	RFS LCF78-50J	13m LENGTH	1	0	1	SHEETS S1-1, S3, S3-1 & S3-2
51	W&B HYBRID CABLE 7/8"	30m LENGTH	1	0	1	SHEETS S1-1, S3, S3-1 & S3-2
52	W&B HYBRID CABLE 7/8"	40m LENGTH	2	0	2	SHEETS S1-1, S3, S3-1 & S3-2
53	GPS SPLITTER	INSTALLED IN 45RU PATHFINDER RACK AT RT/1/1	1	1 (SPARE)	1	SHEET E5
54	GPS RECEIVER	INSTALLED IN 45RU PATHFINDER RACK AT RT/1/1	2	-2	0	SHEET E5
55	GPS RECEIVER UNIT	ERICSSION GRU 05 01 RECEIVER NCD90189/1	0	1	1	SHEET E5
56	GPS ANTENNA (LTE)	GPS KRE 101 2082 1 OMNI	1	-1	0	SHEETS S1, S3, S3-1, S3-2 & E1
57	KAEIUS, DUAL BAND GNSS GPS ACTIVE ANT	KNAA-7005-1110	0	1	1	SHEETS S1, S3, S3-1 & S3-2
58	RF JUMPER 1_5M N F TO SMA M	TSR951339/1500	0	1	1	-
59	GPS WBT TOD CABLE	WBT R6000 TOD CABLE - 3M	0	1	1	-
60	GPS SYNC CABLE	RPM1136127/2000	0	1	1	-
61	LNMIC L600P2 AIR CONDITIONER	WALL MOUNTED RAC TYPE	2	0	2	SHEET E1
62	COOLING FAN	L355D	1	0	1	SHEET E1
63	COOLING FAN FILTER	-	1	-1	0	SHEET E1
64	COOLING FAN FILTER	VAK00019	0	1	1	SHEET E1

UNAPPROVED
DRAWING

COMPLIANCE BOX

COMPLETED AS PER DESIGN☐

ALTERATIONS IN RED☐

NAME (PRINT)
SIGNATUREDATE

FOR CONSTRUCTION

CYIENT

Level-14, 3 Parramatta Square, 153 Macquarie St,
Parramatta, NSW 2150, Australia
T +61 2 8896 6160 | www.cyient.com

ORDER	DRWN	CHKD	AMENDMENT	EXAM	APPD	DATE	ISS
NA25797.01	RS	RT	FOR CONSTRUCTION - 80005689 WO540CYI - LTE2100	MB	MB	21.05.26	1

Telstra

MOBILE NETWORK SITE 40893
CAMPERDOWN RYDGES MISSENDEN RD
SITE SPECIFIC NOTES - SHEET 3 OF 3
9 MISSENDEN RD, CAMPERDOWN, NSW 2050

DWG NO.

N26167

SHT NO.




S0-2

DO NOT SCALE

DIMS IN

NOTE: THIS DRAWING TO BE READ IN CONJUNCTION WITH SHEETS S0 & S0-1

© Telstra Limited ACN 086 174 781 All rights reserved.

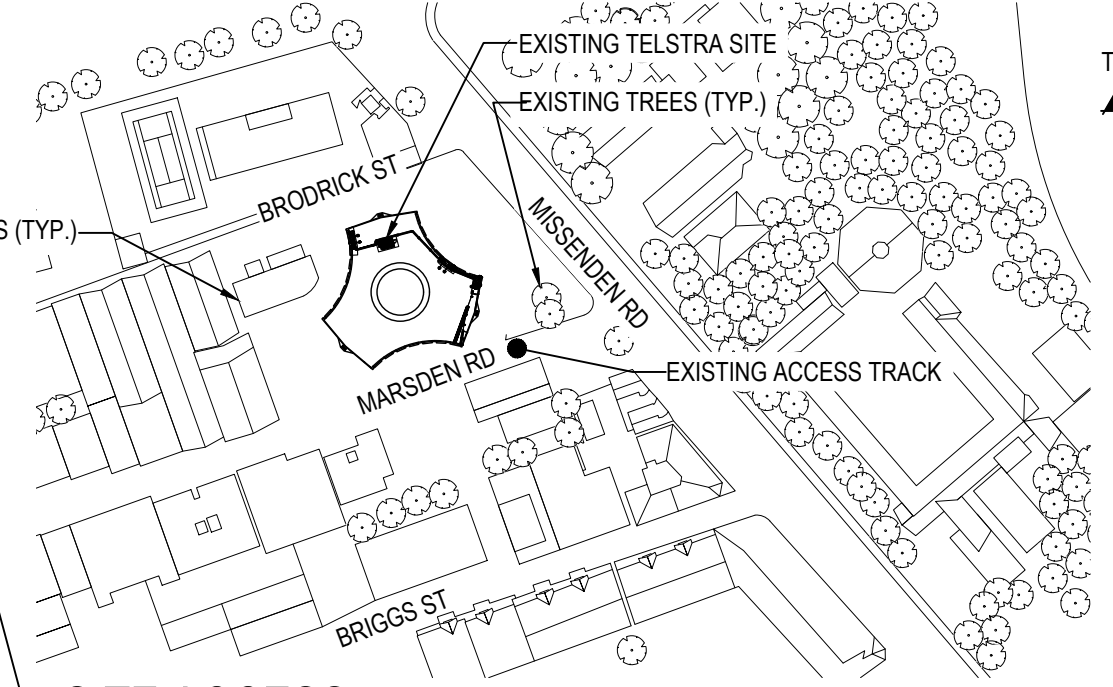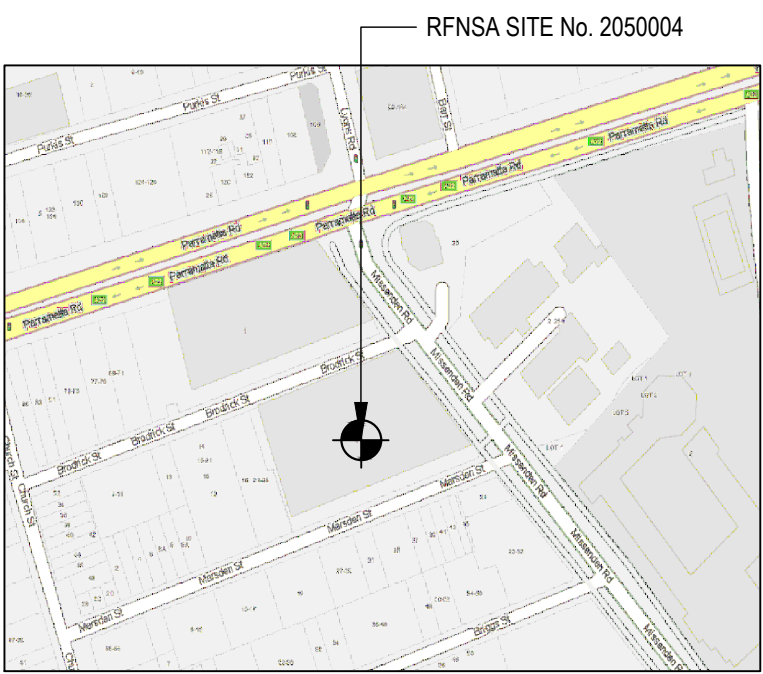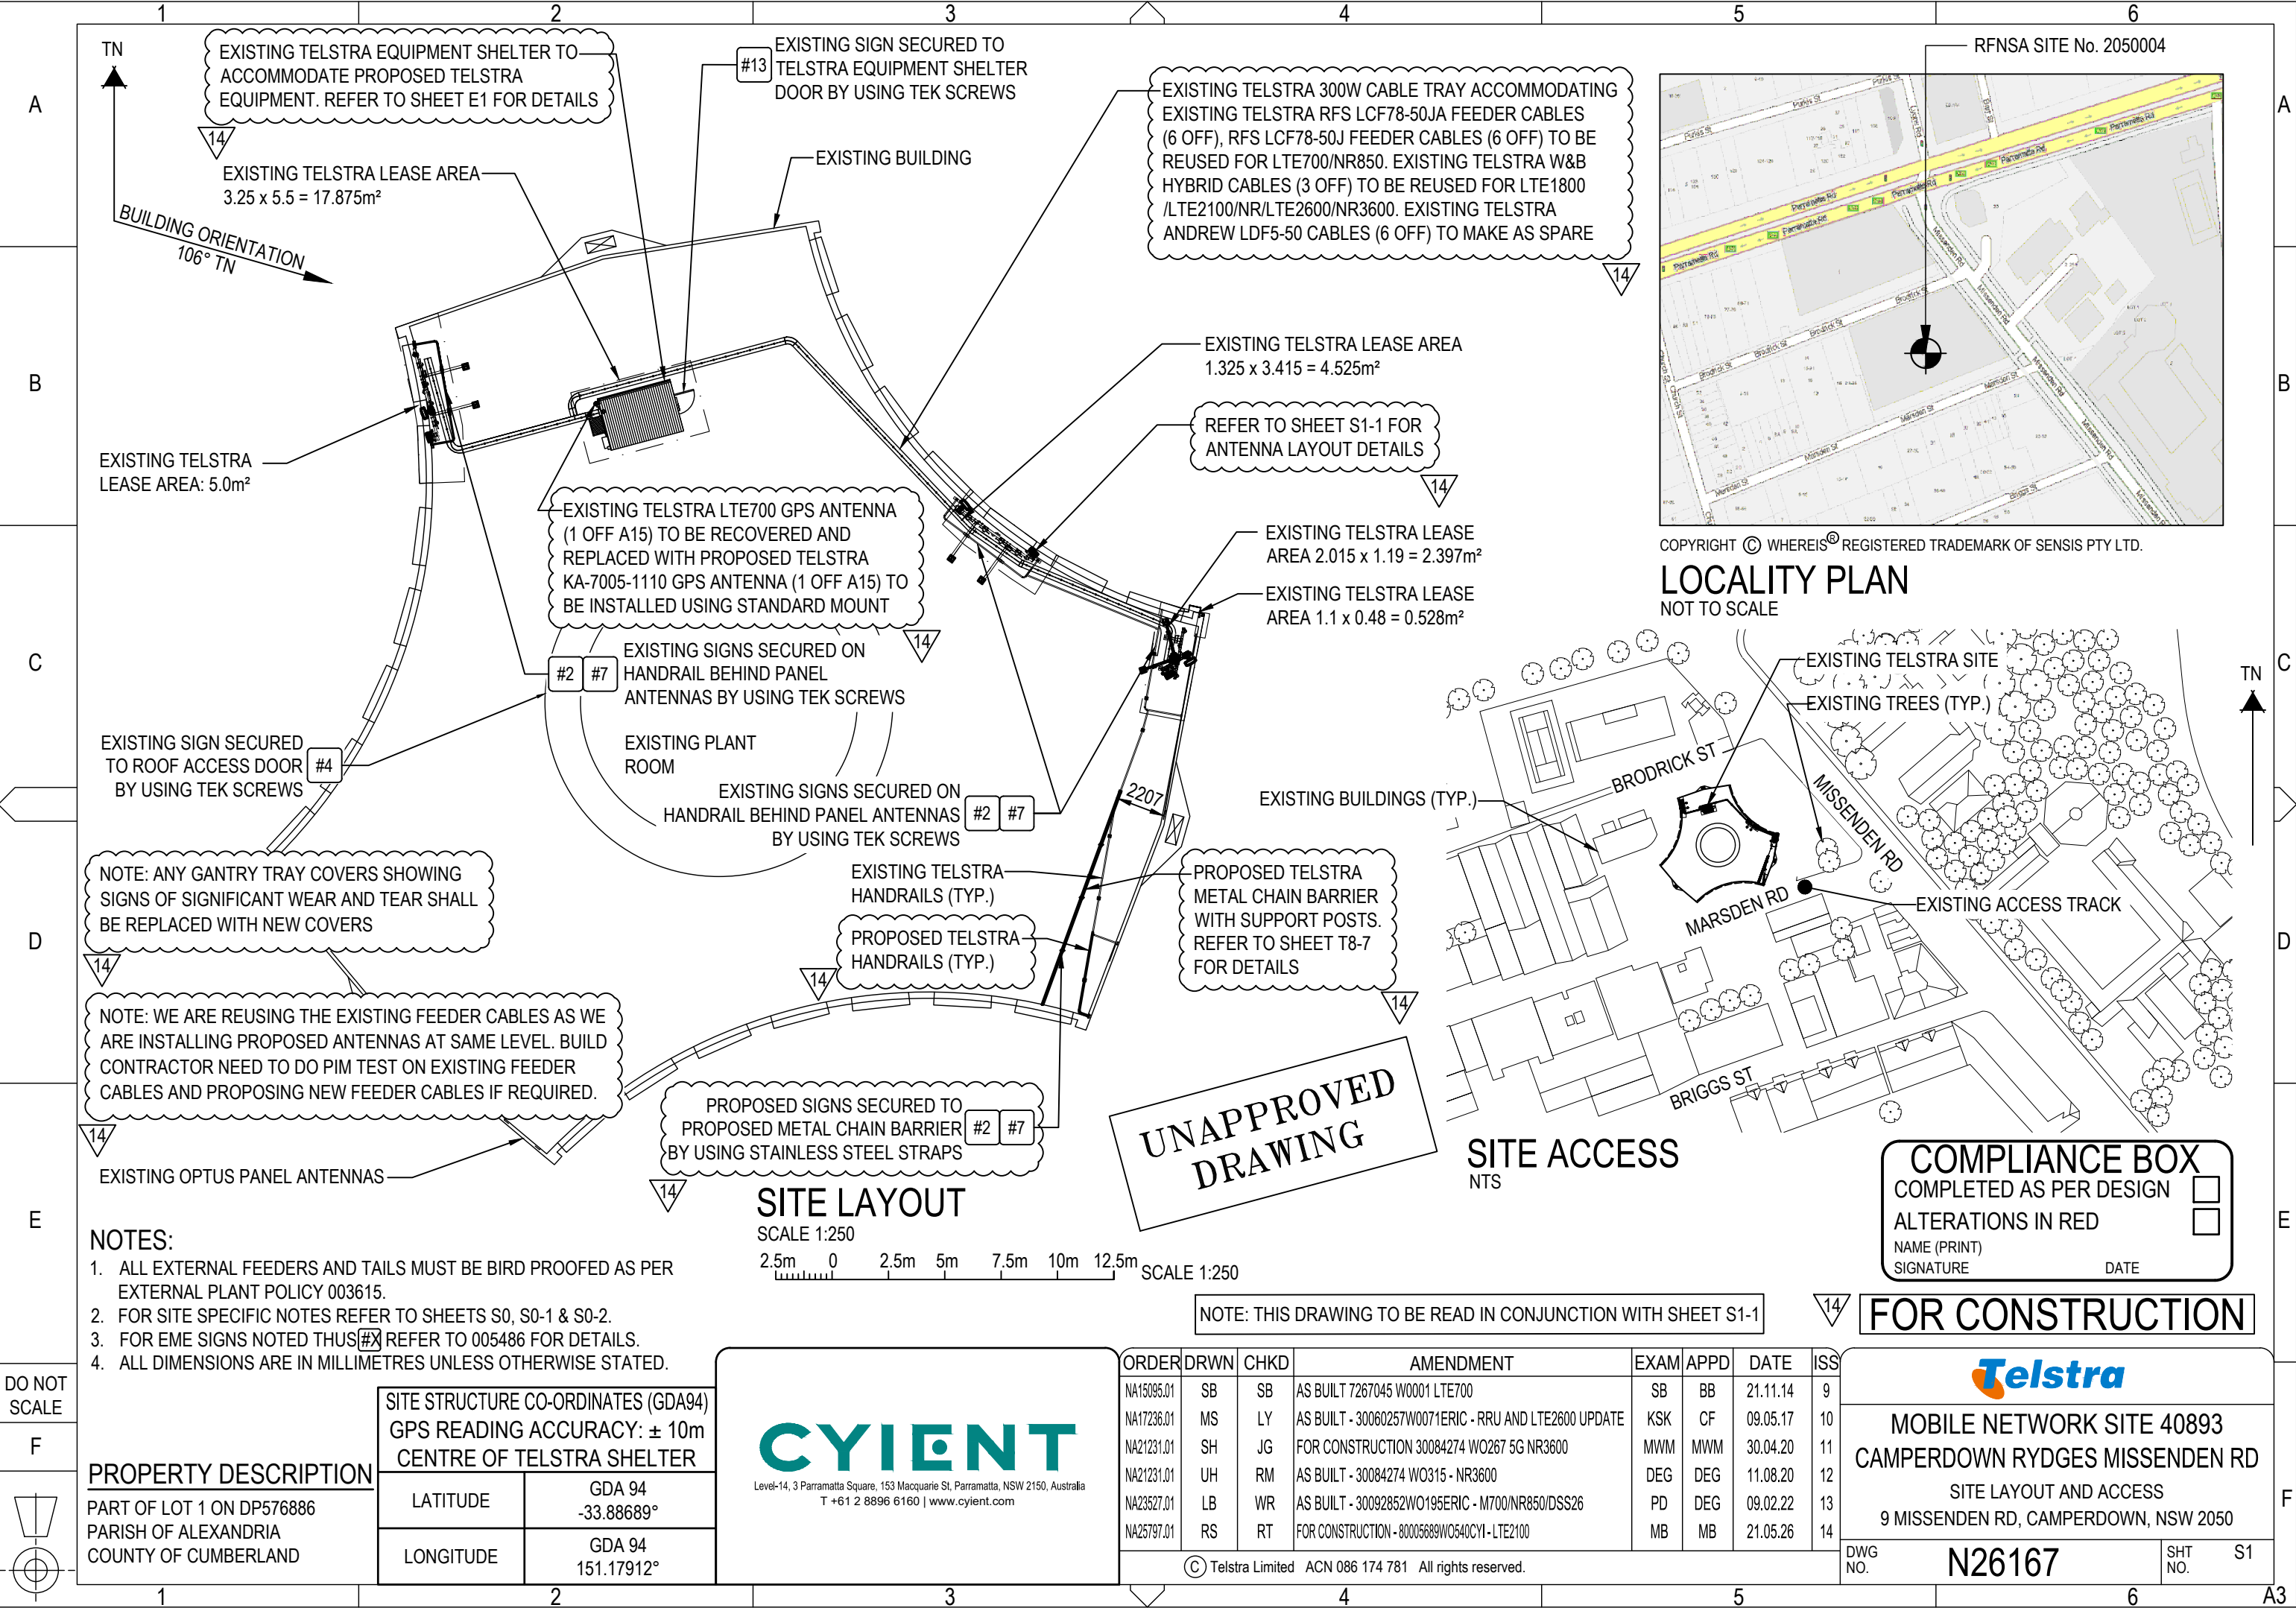

COMPLIANCE BOX

COMPLETED AS PER DESIGN ☐

ALTERATIONS IN RED ☐

NAME (PRINT) _____

SIGNATURE _____

DATE _____

- NOTES:**
1. ALL EXTERNAL FEEDERS AND TAILS MUST BE BIRD PROOFED AS PER EXTERNAL PLANT POLICY 003615.
 2. FOR SITE SPECIFIC NOTES REFER TO SHEETS S0, S0-1 & S0-2.
 3. FOR EME SIGNS NOTED THUS (#) REFER TO 005486 FOR DETAILS.
 4. ALL DIMENSIONS ARE IN MILLIMETRES UNLESS OTHERWISE STATED.

PROPERTY DESCRIPTION

PART OF LOT 1 ON DP576886
PARISH OF ALEXANDRIA
COUNTY OF CUMBERLAND

SITE STRUCTURE CO-ORDINATES (GDA94)
GPS READING ACCURACY: ± 10m
CENTRE OF TELSTRA SHELTER

LATITUDE	GDA 94 -33.88689°
LONGITUDE	GDA 94 151.17912°

CYIENT

Level-14, 3 Parramatta Square, 153 Macquarie St, Parramatta, NSW 2150, Australia
T +61 2 8896 6160 | www.cyient.com

NOTE: THIS DRAWING TO BE READ IN CONJUNCTION WITH SHEET S1-1

ORDER	DRWN	CHKD	AMENDMENT	EXAM	APPD	DATE	ISS
NA15095.01	SB	SB	AS BUILT 7267045 W0001 LTE700	SB	BB	21.11.14	9
NA17236.01	MS	LY	AS BUILT - 30060257W0071ERIC - RRU AND LTE2600 UPDATE	KSK	CF	09.05.17	10
NA21231.01	SH	JG	FOR CONSTRUCTION 30084274 W0267 5G NR3600	MWM	MWM	30.04.20	11
NA21231.01	UH	RM	AS BUILT - 30084274 W0315 - NR3600	DEG	DEG	11.08.20	12
NA23527.01	LB	WR	AS BUILT - 30092852W0195ERIC - M700/NR850/DSS26	PD	DEG	09.02.22	13
NA25797.01	RS	RT	FOR CONSTRUCTION - 80005689W0540CYI - LTE2100	MB	MB	21.05.26	14


© Telstra Limited ACN 086 174 781 All rights reserved.

FOR CONSTRUCTION



MOBILE NETWORK SITE 40893
CAMPERDOWN RYDGES MISSENDEN RD
SITE LAYOUT AND ACCESS
9 MISSENDEN RD, CAMPERDOWN, NSW 2050

DWG NO. **N26167** SHT NO. **S1**

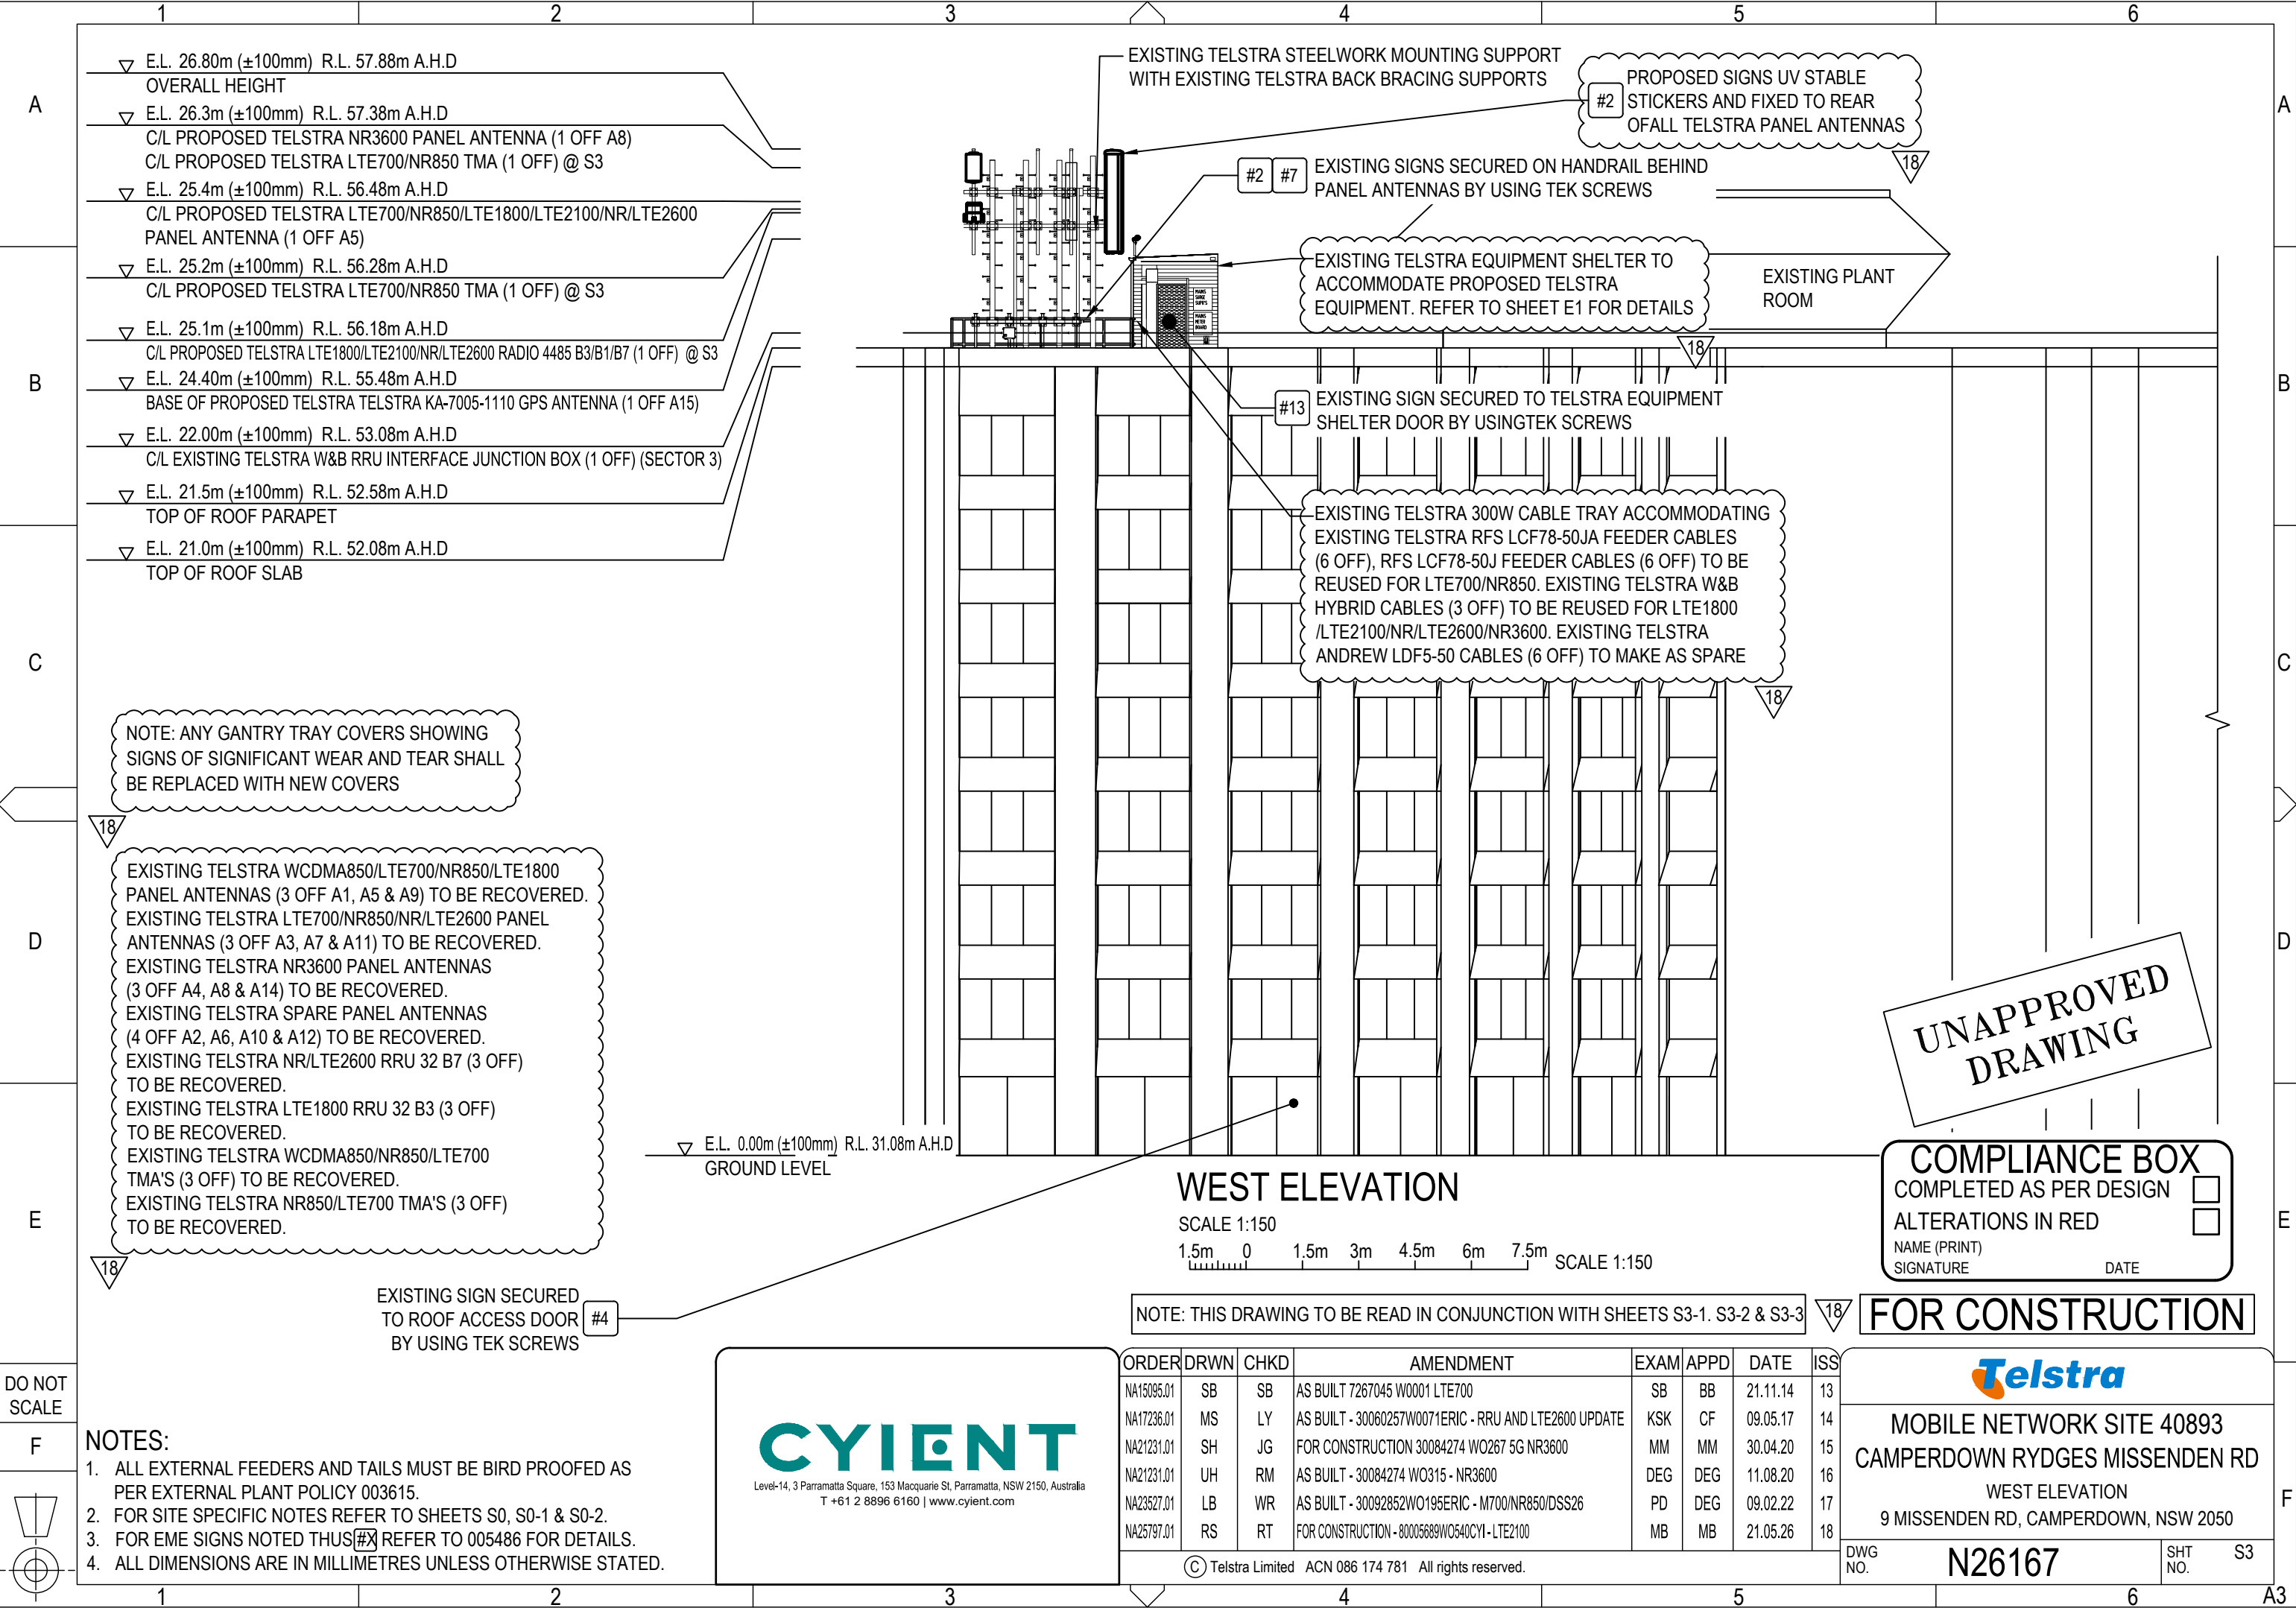

NOTE: ANY GANTRY TRAY COVERS SHOWING SIGNS OF SIGNIFICANT WEAR AND TEAR SHALL BE REPLACED WITH NEW COVERS

EXISTING TELSTRA WCDMA850/LTE700/NR850/LTE1800 PANEL ANTENNAS (3 OFF A1, A5 & A9) TO BE RECOVERED.
EXISTING TELSTRA LTE700/NR850/NR/LTE2600 PANEL ANTENNAS (3 OFF A3, A7 & A11) TO BE RECOVERED.
EXISTING TELSTRA NR3600 PANEL ANTENNAS (3 OFF A4, A8 & A14) TO BE RECOVERED.
EXISTING TELSTRA SPARE PANEL ANTENNAS (4 OFF A2, A6, A10 & A12) TO BE RECOVERED.
EXISTING TELSTRA NR/LTE2600 RRU 32 B7 (3 OFF) TO BE RECOVERED.
EXISTING TELSTRA LTE1800 RRU 32 B3 (3 OFF) TO BE RECOVERED.
EXISTING TELSTRA WCDMA850/NR850/LTE700 TMA'S (3 OFF) TO BE RECOVERED.
EXISTING TELSTRA NR850/LTE700 TMA'S (3 OFF) TO BE RECOVERED.

EXISTING SIGN SECURED TO ROOF ACCESS DOOR BY USING TEK SCREWS

WEST ELEVATION

SCALE 1:150
1.5m 0 1.5m 3m 4.5m 6m 7.5m SCALE 1:150

NOTE: THIS DRAWING TO BE READ IN CONJUNCTION WITH SHEETS S3-1, S3-2 & S3-3

UNAPPROVED
DRAWING

COMPLIANCE BOX
COMPLETED AS PER DESIGN ☐
ALTERATIONS IN RED ☐
NAME (PRINT) _____
SIGNATURE _____ DATE _____

FOR CONSTRUCTION

DO NOT
SCALE

F

- NOTES:
- ALL EXTERNAL FEEDERS AND TAILS MUST BE BIRD PROOFED AS PER EXTERNAL PLANT POLICY 003615.
 - FOR SITE SPECIFIC NOTES REFER TO SHEETS S0, S0-1 & S0-2.
 - FOR EME SIGNS NOTED THUS (#X) REFER TO 005486 FOR DETAILS.
 - ALL DIMENSIONS ARE IN MILLIMETRES UNLESS OTHERWISE STATED.

CYIENT
Level-14, 3 Parramatta Square, 153 Macquarie St, Parramatta, NSW 2150, Australia
T +61 2 8896 6160 | www.cyient.com


ORDER	DRWN	CHKD	AMENDMENT	EXAM	APPD	DATE	ISS
NA15095.01	SB	SB	AS BUILT 7267045 W0001 LTE700	SB	BB	21.11.14	13
NA17236.01	MS	LY	AS BUILT - 30060257W0071ERIC - RRU AND LTE2600 UPDATE	KSK	CF	09.05.17	14
NA21231.01	SH	JG	FOR CONSTRUCTION 30084274 W0267 5G NR3600	MM	MM	30.04.20	15
NA21231.01	UH	RM	AS BUILT - 30084274 W0315 - NR3600	DEG	DEG	11.08.20	16
NA23527.01	LB	WR	AS BUILT - 30092852W0195ERIC - M700/NR850/DSS26	PD	DEG	09.02.22	17
NA25797.01	RS	RT	FOR CONSTRUCTION - 80005689W0540CYI - LTE2100	MB	MB	21.05.26	18

© Telstra Limited ACN 086 174 781 All rights reserved.

Telstra

MOBILE NETWORK SITE 40893
CAMPERDOWN RYDGES MISSENDEN RD
WEST ELEVATION
9 MISSENDEN RD, CAMPERDOWN, NSW 2050

DWG NO. **N26167** SHT NO. **S3**

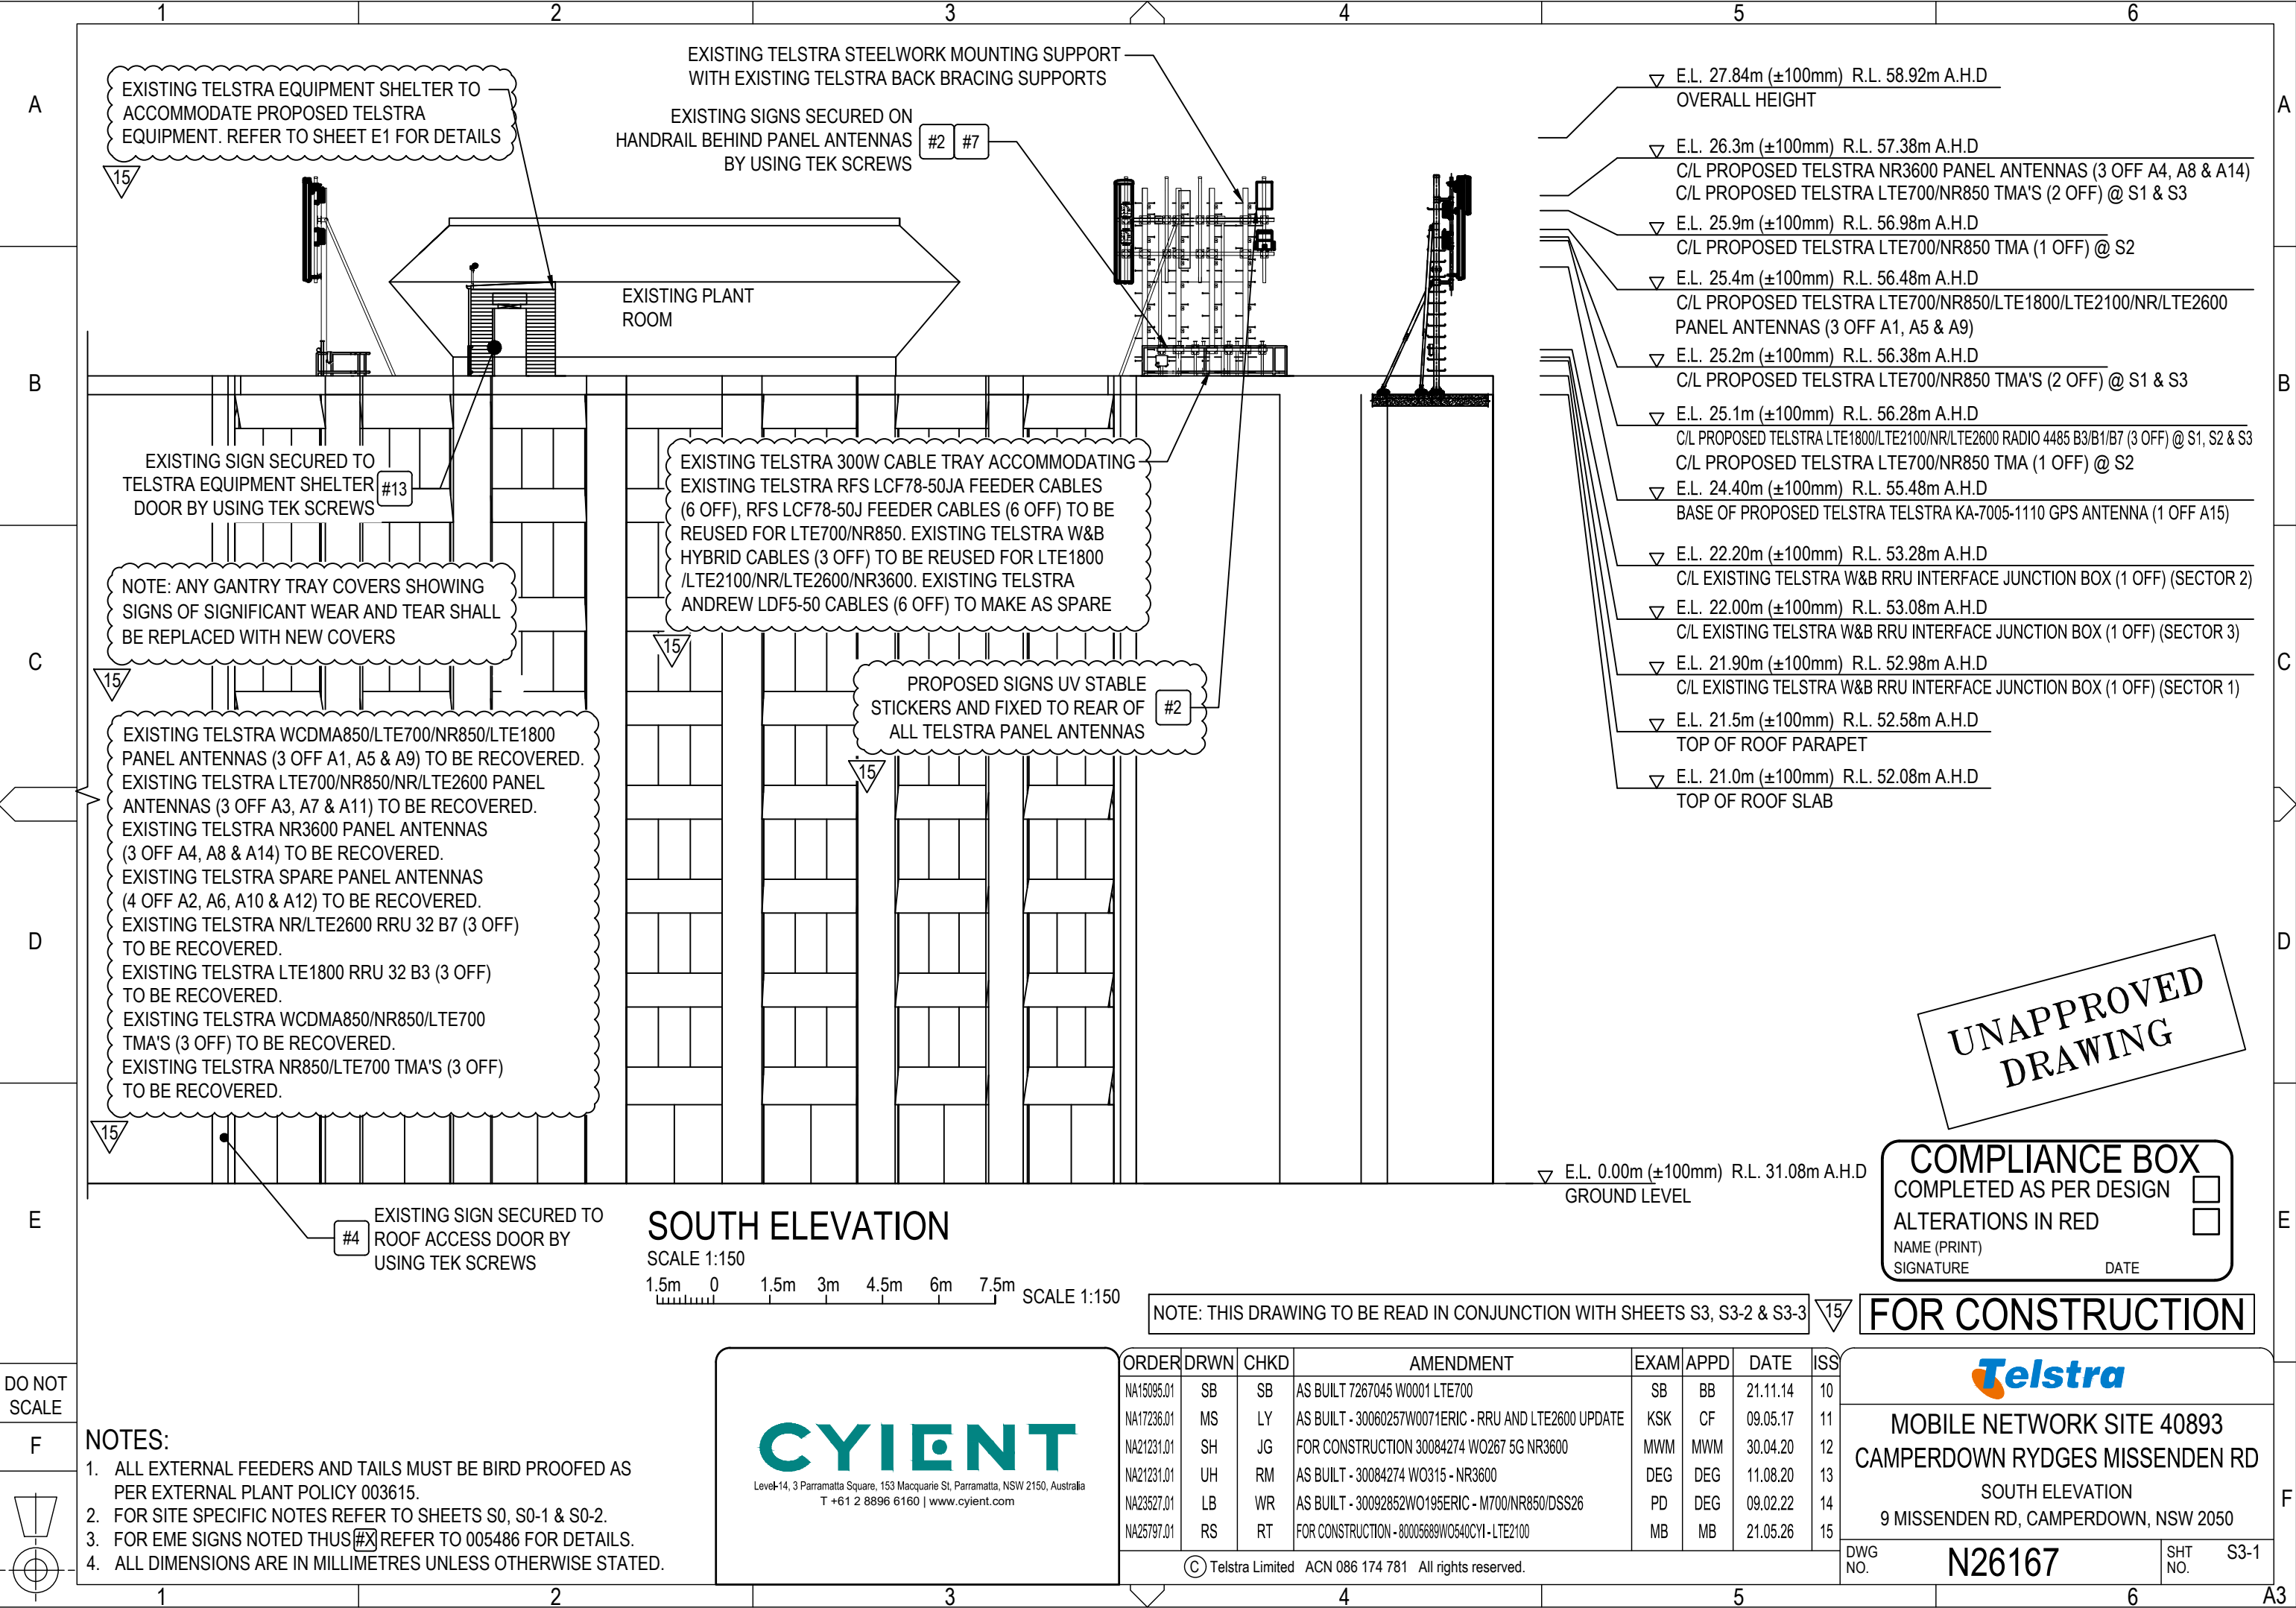

EXISTING TELSTRA EQUIPMENT SHELTER TO ACCOMMODATE PROPOSED TELSTRA EQUIPMENT. REFER TO SHEET E1 FOR DETAILS

EXISTING TELSTRA STEELWORK MOUNTING SUPPORT WITH EXISTING TELSTRA BACK BRACING SUPPORTS
EXISTING SIGNS SECURED ON HANDRAIL BEHIND PANEL ANTENNAS BY USING TEK SCREWS

EXISTING SIGN SECURED TO TELSTRA EQUIPMENT SHELTER DOOR BY USING TEK SCREWS

NOTE: ANY GANTRY TRAY COVERS SHOWING SIGNS OF SIGNIFICANT WEAR AND TEAR SHALL BE REPLACED WITH NEW COVERS

EXISTING TELSTRA WCDMA850/LTE700/NR850/LTE1800 PANEL ANTENNAS (3 OFF A1, A5 & A9) TO BE RECOVERED.
EXISTING TELSTRA LTE700/NR850/NR/LTE2600 PANEL ANTENNAS (3 OFF A3, A7 & A11) TO BE RECOVERED.
EXISTING TELSTRA NR3600 PANEL ANTENNAS (3 OFF A4, A8 & A14) TO BE RECOVERED.
EXISTING TELSTRA SPARE PANEL ANTENNAS (4 OFF A2, A6, A10 & A12) TO BE RECOVERED.
EXISTING TELSTRA NR/LTE2600 RRU 32 B7 (3 OFF) TO BE RECOVERED.
EXISTING TELSTRA LTE1800 RRU 32 B3 (3 OFF) TO BE RECOVERED.
EXISTING TELSTRA WCDMA850/NR850/LTE700 TMA'S (3 OFF) TO BE RECOVERED.
EXISTING TELSTRA NR850/LTE700 TMA'S (3 OFF) TO BE RECOVERED.

EXISTING TELSTRA 300W CABLE TRAY ACCOMMODATING EXISTING TELSTRA RFS LCF78-50JA FEEDER CABLES (6 OFF), RFS LCF78-50J FEEDER CABLES (6 OFF) TO BE REUSED FOR LTE700/NR850. EXISTING TELSTRA W&B HYBRID CABLES (3 OFF) TO BE REUSED FOR LTE1800 /LTE2100/NR/LTE2600/NR3600. EXISTING TELSTRA ANDREW LDF5-50 CABLES (6 OFF) TO MAKE AS SPARE

PROPOSED SIGNS UV STABLE STICKERS AND FIXED TO REAR OF ALL TELSTRA PANEL ANTENNAS

- ▽ E.L. 27.84m (±100mm) R.L. 58.92m A.H.D
OVERALL HEIGHT
- ▽ E.L. 26.3m (±100mm) R.L. 57.38m A.H.D
C/L PROPOSED TELSTRA NR3600 PANEL ANTENNAS (3 OFF A4, A8 & A14)
C/L PROPOSED TELSTRA LTE700/NR850 TMA'S (2 OFF) @ S1 & S3
- ▽ E.L. 25.9m (±100mm) R.L. 56.98m A.H.D
C/L PROPOSED TELSTRA LTE700/NR850 TMA (1 OFF) @ S2
- ▽ E.L. 25.4m (±100mm) R.L. 56.48m A.H.D
C/L PROPOSED TELSTRA LTE700/NR850/LTE1800/LTE2100/NR/LTE2600 PANEL ANTENNAS (3 OFF A1, A5 & A9)
- ▽ E.L. 25.2m (±100mm) R.L. 56.38m A.H.D
C/L PROPOSED TELSTRA LTE700/NR850 TMA'S (2 OFF) @ S1 & S3
- ▽ E.L. 25.1m (±100mm) R.L. 56.28m A.H.D
C/L PROPOSED TELSTRA LTE1800/LTE2100/NR/LTE2600 RADIO 4485 B3/B1/B7 (3 OFF) @ S1, S2 & S3
C/L PROPOSED TELSTRA LTE700/NR850 TMA (1 OFF) @ S2
- ▽ E.L. 24.40m (±100mm) R.L. 55.48m A.H.D
BASE OF PROPOSED TELSTRA TELSTRA KA-7005-1110 GPS ANTENNA (1 OFF A15)
- ▽ E.L. 22.20m (±100mm) R.L. 53.28m A.H.D
C/L EXISTING TELSTRA W&B RRU INTERFACE JUNCTION BOX (1 OFF) (SECTOR 2)
- ▽ E.L. 22.00m (±100mm) R.L. 53.08m A.H.D
C/L EXISTING TELSTRA W&B RRU INTERFACE JUNCTION BOX (1 OFF) (SECTOR 3)
- ▽ E.L. 21.90m (±100mm) R.L. 52.98m A.H.D
C/L EXISTING TELSTRA W&B RRU INTERFACE JUNCTION BOX (1 OFF) (SECTOR 1)
- ▽ E.L. 21.5m (±100mm) R.L. 52.58m A.H.D
TOP OF ROOF PARAPET
- ▽ E.L. 21.0m (±100mm) R.L. 52.08m A.H.D
TOP OF ROOF SLAB

UNAPPROVED
DRAWING

COMPLIANCE BOX

COMPLETED AS PER DESIGN

ALTERATIONS IN RED

NAME (PRINT)

SIGNATURE

DATE

SOUTH ELEVATION


SCALE 1:150
1.5m 0 1.5m 3m 4.5m 6m 7.5m SCALE 1:150

NOTE: THIS DRAWING TO BE READ IN CONJUNCTION WITH SHEETS S3, S3-2 & S3-3

FOR CONSTRUCTION

DO NOT
SCALE

F

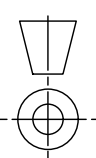

- NOTES:
- ALL EXTERNAL FEEDERS AND TAILS MUST BE BIRD PROOFED AS PER EXTERNAL PLANT POLICY 003615.
 - FOR SITE SPECIFIC NOTES REFER TO SHEETS S0, S0-1 & S0-2.
 - FOR EME SIGNS NOTED THUS (#X) REFER TO 005486 FOR DETAILS.
 - ALL DIMENSIONS ARE IN MILLIMETRES UNLESS OTHERWISE STATED.




ORDER	DRWN	CHKD	AMENDMENT	EXAM	APPD	DATE	ISS
NA15095.01	SB	SB	AS BUILT 7267045 W0001 LTE700	SB	BB	21.11.14	10
NA17236.01	MS	LY	AS BUILT - 30060257W0071ERIC - RRU AND LTE2600 UPDATE	KSK	CF	09.05.17	11
NA21231.01	SH	JG	FOR CONSTRUCTION 30084274 W0267 5G NR3600	MWM	MWM	30.04.20	12
NA21231.01	UH	RM	AS BUILT - 30084274 W0315 - NR3600	DEG	DEG	11.08.20	13
NA23527.01	LB	WR	AS BUILT - 30092852W0195ERIC - M700/NR850/DSS26	PD	DEG	09.02.22	14
NA25797.01	RS	RT	FOR CONSTRUCTION - 80005689W0540CYI - LTE2100	MB	MB	21.05.26	15

© Telstra Limited ACN 086 174 781 All rights reserved.



MOBILE NETWORK SITE 40893
CAMPERDOWN RYDGES MISSENDEN RD
SOUTH ELEVATION
9 MISSENDEN RD, CAMPERDOWN, NSW 2050

DWG NO. N26167 SHT NO. S3-1

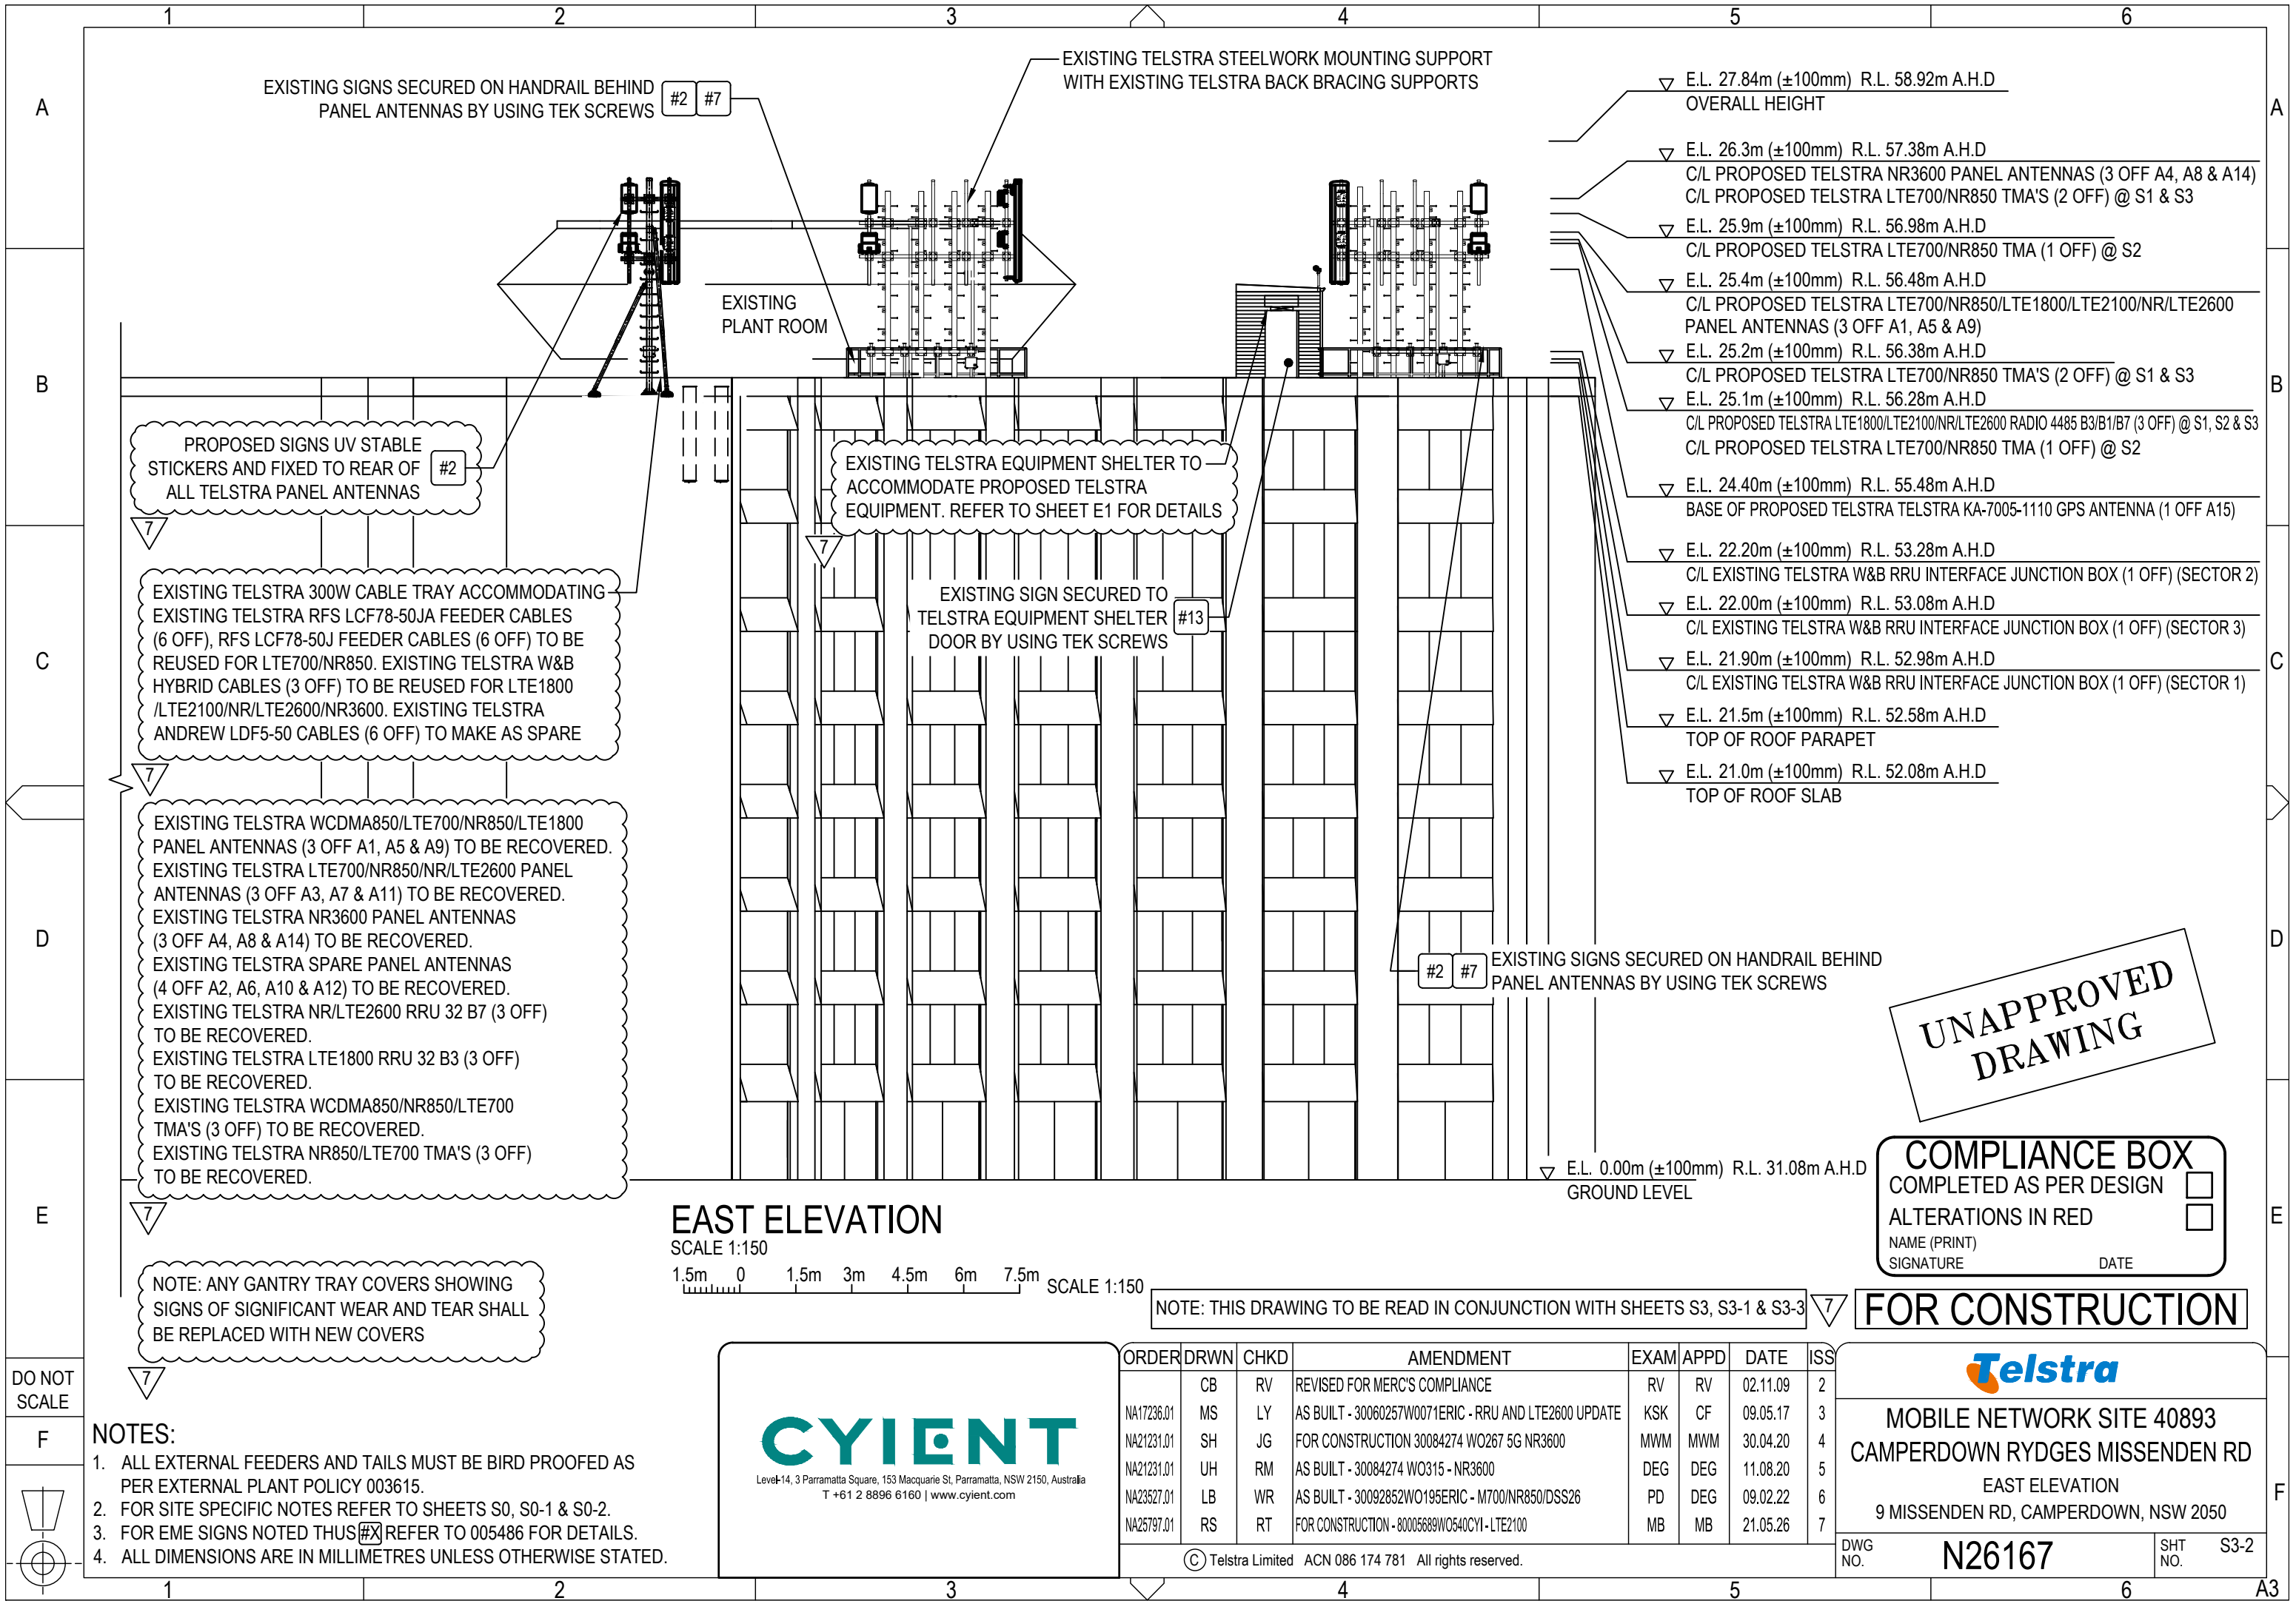

EXISTING SIGNS SECURED ON HANDRAIL BEHIND
PANEL ANTENNAS BY USING TEK SCREWS

EXISTING TELSTRA STEELWORK MOUNTING SUPPORT
WITH EXISTING TELSTRA BACK BRACING SUPPORTS

EXISTING
PLANT ROOM

PROPOSED SIGNS UV STABLE
STICKERS AND FIXED TO REAR OF
ALL TELSTRA PANEL ANTENNAS

EXISTING TELSTRA EQUIPMENT SHELTER TO
ACCOMMODATE PROPOSED TELSTRA
EQUIPMENT. REFER TO SHEET E1 FOR DETAILS

EXISTING TELSTRA 300W CABLE TRAY ACCOMMODATING
EXISTING TELSTRA RFS LCF78-50JA FEEDER CABLES
(6 OFF), RFS LCF78-50J FEEDER CABLES (6 OFF) TO BE
REUSED FOR LTE700/NR850. EXISTING TELSTRA W&B
HYBRID CABLES (3 OFF) TO BE REUSED FOR LTE1800
/LTE2100/NR/LTE2600/NR3600. EXISTING TELSTRA
ANDREW LDF5-50 CABLES (6 OFF) TO MAKE AS SPARE

EXISTING TELSTRA WCDMA850/LTE700/NR850/LTE1800
PANEL ANTENNAS (3 OFF A1, A5 & A9) TO BE RECOVERED.
EXISTING TELSTRA LTE700/NR850/NR/LTE2600 PANEL
ANTENNAS (3 OFF A3, A7 & A11) TO BE RECOVERED.
EXISTING TELSTRA NR3600 PANEL ANTENNAS
(3 OFF A4, A8 & A14) TO BE RECOVERED.
EXISTING TELSTRA SPARE PANEL ANTENNAS
(4 OFF A2, A6, A10 & A12) TO BE RECOVERED.
EXISTING TELSTRA NR/LTE2600 RRU 32 B7 (3 OFF)
TO BE RECOVERED.
EXISTING TELSTRA LTE1800 RRU 32 B3 (3 OFF)
TO BE RECOVERED.
EXISTING TELSTRA WCDMA850/NR850/LTE700
TMA'S (3 OFF) TO BE RECOVERED.
EXISTING TELSTRA NR850/LTE700 TMA'S (3 OFF)
TO BE RECOVERED.

NOTE: ANY GANTRY TRAY COVERS SHOWING
SIGNS OF SIGNIFICANT WEAR AND TEAR SHALL
BE REPLACED WITH NEW COVERS

EXISTING SIGN SECURED TO
TELSTRA EQUIPMENT SHELTER
DOOR BY USING TEK SCREWS

EXISTING SIGNS SECURED ON HANDRAIL BEHIND
PANEL ANTENNAS BY USING TEK SCREWS

- ▽ E.L. 27.84m (±100mm) R.L. 58.92m A.H.D
OVERALL HEIGHT
- ▽ E.L. 26.3m (±100mm) R.L. 57.38m A.H.D
C/L PROPOSED TELSTRA NR3600 PANEL ANTENNAS (3 OFF A4, A8 & A14)
C/L PROPOSED TELSTRA LTE700/NR850 TMA'S (2 OFF) @ S1 & S3
- ▽ E.L. 25.9m (±100mm) R.L. 56.98m A.H.D
C/L PROPOSED TELSTRA LTE700/NR850 TMA (1 OFF) @ S2
- ▽ E.L. 25.4m (±100mm) R.L. 56.48m A.H.D
C/L PROPOSED TELSTRA LTE700/NR850/LTE1800/LTE2100/NR/LTE2600
PANEL ANTENNAS (3 OFF A1, A5 & A9)
- ▽ E.L. 25.2m (±100mm) R.L. 56.38m A.H.D
C/L PROPOSED TELSTRA LTE700/NR850 TMA'S (2 OFF) @ S1 & S3
- ▽ E.L. 25.1m (±100mm) R.L. 56.28m A.H.D
C/L PROPOSED TELSTRA LTE1800/LTE2100/NR/LTE2600 RADIO 4485 B3/B1/B7 (3 OFF) @ S1, S2 & S3
C/L PROPOSED TELSTRA LTE700/NR850 TMA (1 OFF) @ S2
- ▽ E.L. 24.40m (±100mm) R.L. 55.48m A.H.D
BASE OF PROPOSED TELSTRA TELSTRA KA-7005-1110 GPS ANTENNA (1 OFF A15)
- ▽ E.L. 22.20m (±100mm) R.L. 53.28m A.H.D
C/L EXISTING TELSTRA W&B RRU INTERFACE JUNCTION BOX (1 OFF) (SECTOR 2)
- ▽ E.L. 22.00m (±100mm) R.L. 53.08m A.H.D
C/L EXISTING TELSTRA W&B RRU INTERFACE JUNCTION BOX (1 OFF) (SECTOR 3)
- ▽ E.L. 21.90m (±100mm) R.L. 52.98m A.H.D
C/L EXISTING TELSTRA W&B RRU INTERFACE JUNCTION BOX (1 OFF) (SECTOR 1)
- ▽ E.L. 21.5m (±100mm) R.L. 52.58m A.H.D
TOP OF ROOF PARAPET
- ▽ E.L. 21.0m (±100mm) R.L. 52.08m A.H.D
TOP OF ROOF SLAB

▽ E.L. 0.00m (±100mm) R.L. 31.08m A.H.D
GROUND LEVEL

EAST ELEVATION

SCALE 1:150
1.5m 0 1.5m 3m 4.5m 6m 7.5m SCALE 1:150

NOTE: THIS DRAWING TO BE READ IN CONJUNCTION WITH SHEETS S3, S3-1 & S3-3

UNAPPROVED
DRAWING

COMPLIANCE BOX
COMPLETED AS PER DESIGN ☐
ALTERATIONS IN RED ☐
NAME (PRINT) _____
SIGNATURE _____ DATE _____

FOR CONSTRUCTION

DO NOT
SCALE

- NOTES:
- ALL EXTERNAL FEEDERS AND TAILS MUST BE BIRD PROOFED AS PER EXTERNAL PLANT POLICY 003615.
 - FOR SITE SPECIFIC NOTES REFER TO SHEETS S0, S0-1 & S0-2.
 - FOR EME SIGNS NOTED THUS (#X) REFER TO 005486 FOR DETAILS.
 - ALL DIMENSIONS ARE IN MILLIMETRES UNLESS OTHERWISE STATED.




ORDER	DRWN	CHKD	AMENDMENT	EXAM	APPD	DATE	ISS
NA17236.01	CB	RV	REVISED FOR MERC'S COMPLIANCE	RV	RV	02.11.09	2
NA21231.01	MS	LY	AS BUILT - 30060257W0071ERIC - RRU AND LTE2600 UPDATE	KSK	CF	09.05.17	3
NA21231.01	SH	JG	FOR CONSTRUCTION 30084274 WO267 5G NR3600	MWM	MWM	30.04.20	4
NA21231.01	UH	RM	AS BUILT - 30084274 WO315 - NR3600	DEG	DEG	11.08.20	5
NA23527.01	LB	WR	AS BUILT - 30092852WO195ERIC - M700/NR850/DSS26	PD	DEG	09.02.22	6
NA25797.01	RS	RT	FOR CONSTRUCTION - 80005689W0540CYI - LTE2100	MB	MB	21.05.26	7

© Telstra Limited ACN 086 174 781 All rights reserved.



MOBILE NETWORK SITE 40893
CAMPERDOWN RYDGES MISSENDEN RD
EAST ELEVATION
9 MISSENDEN RD, CAMPERDOWN, NSW 2050

DWG NO. N26167 SHT NO. S3-2

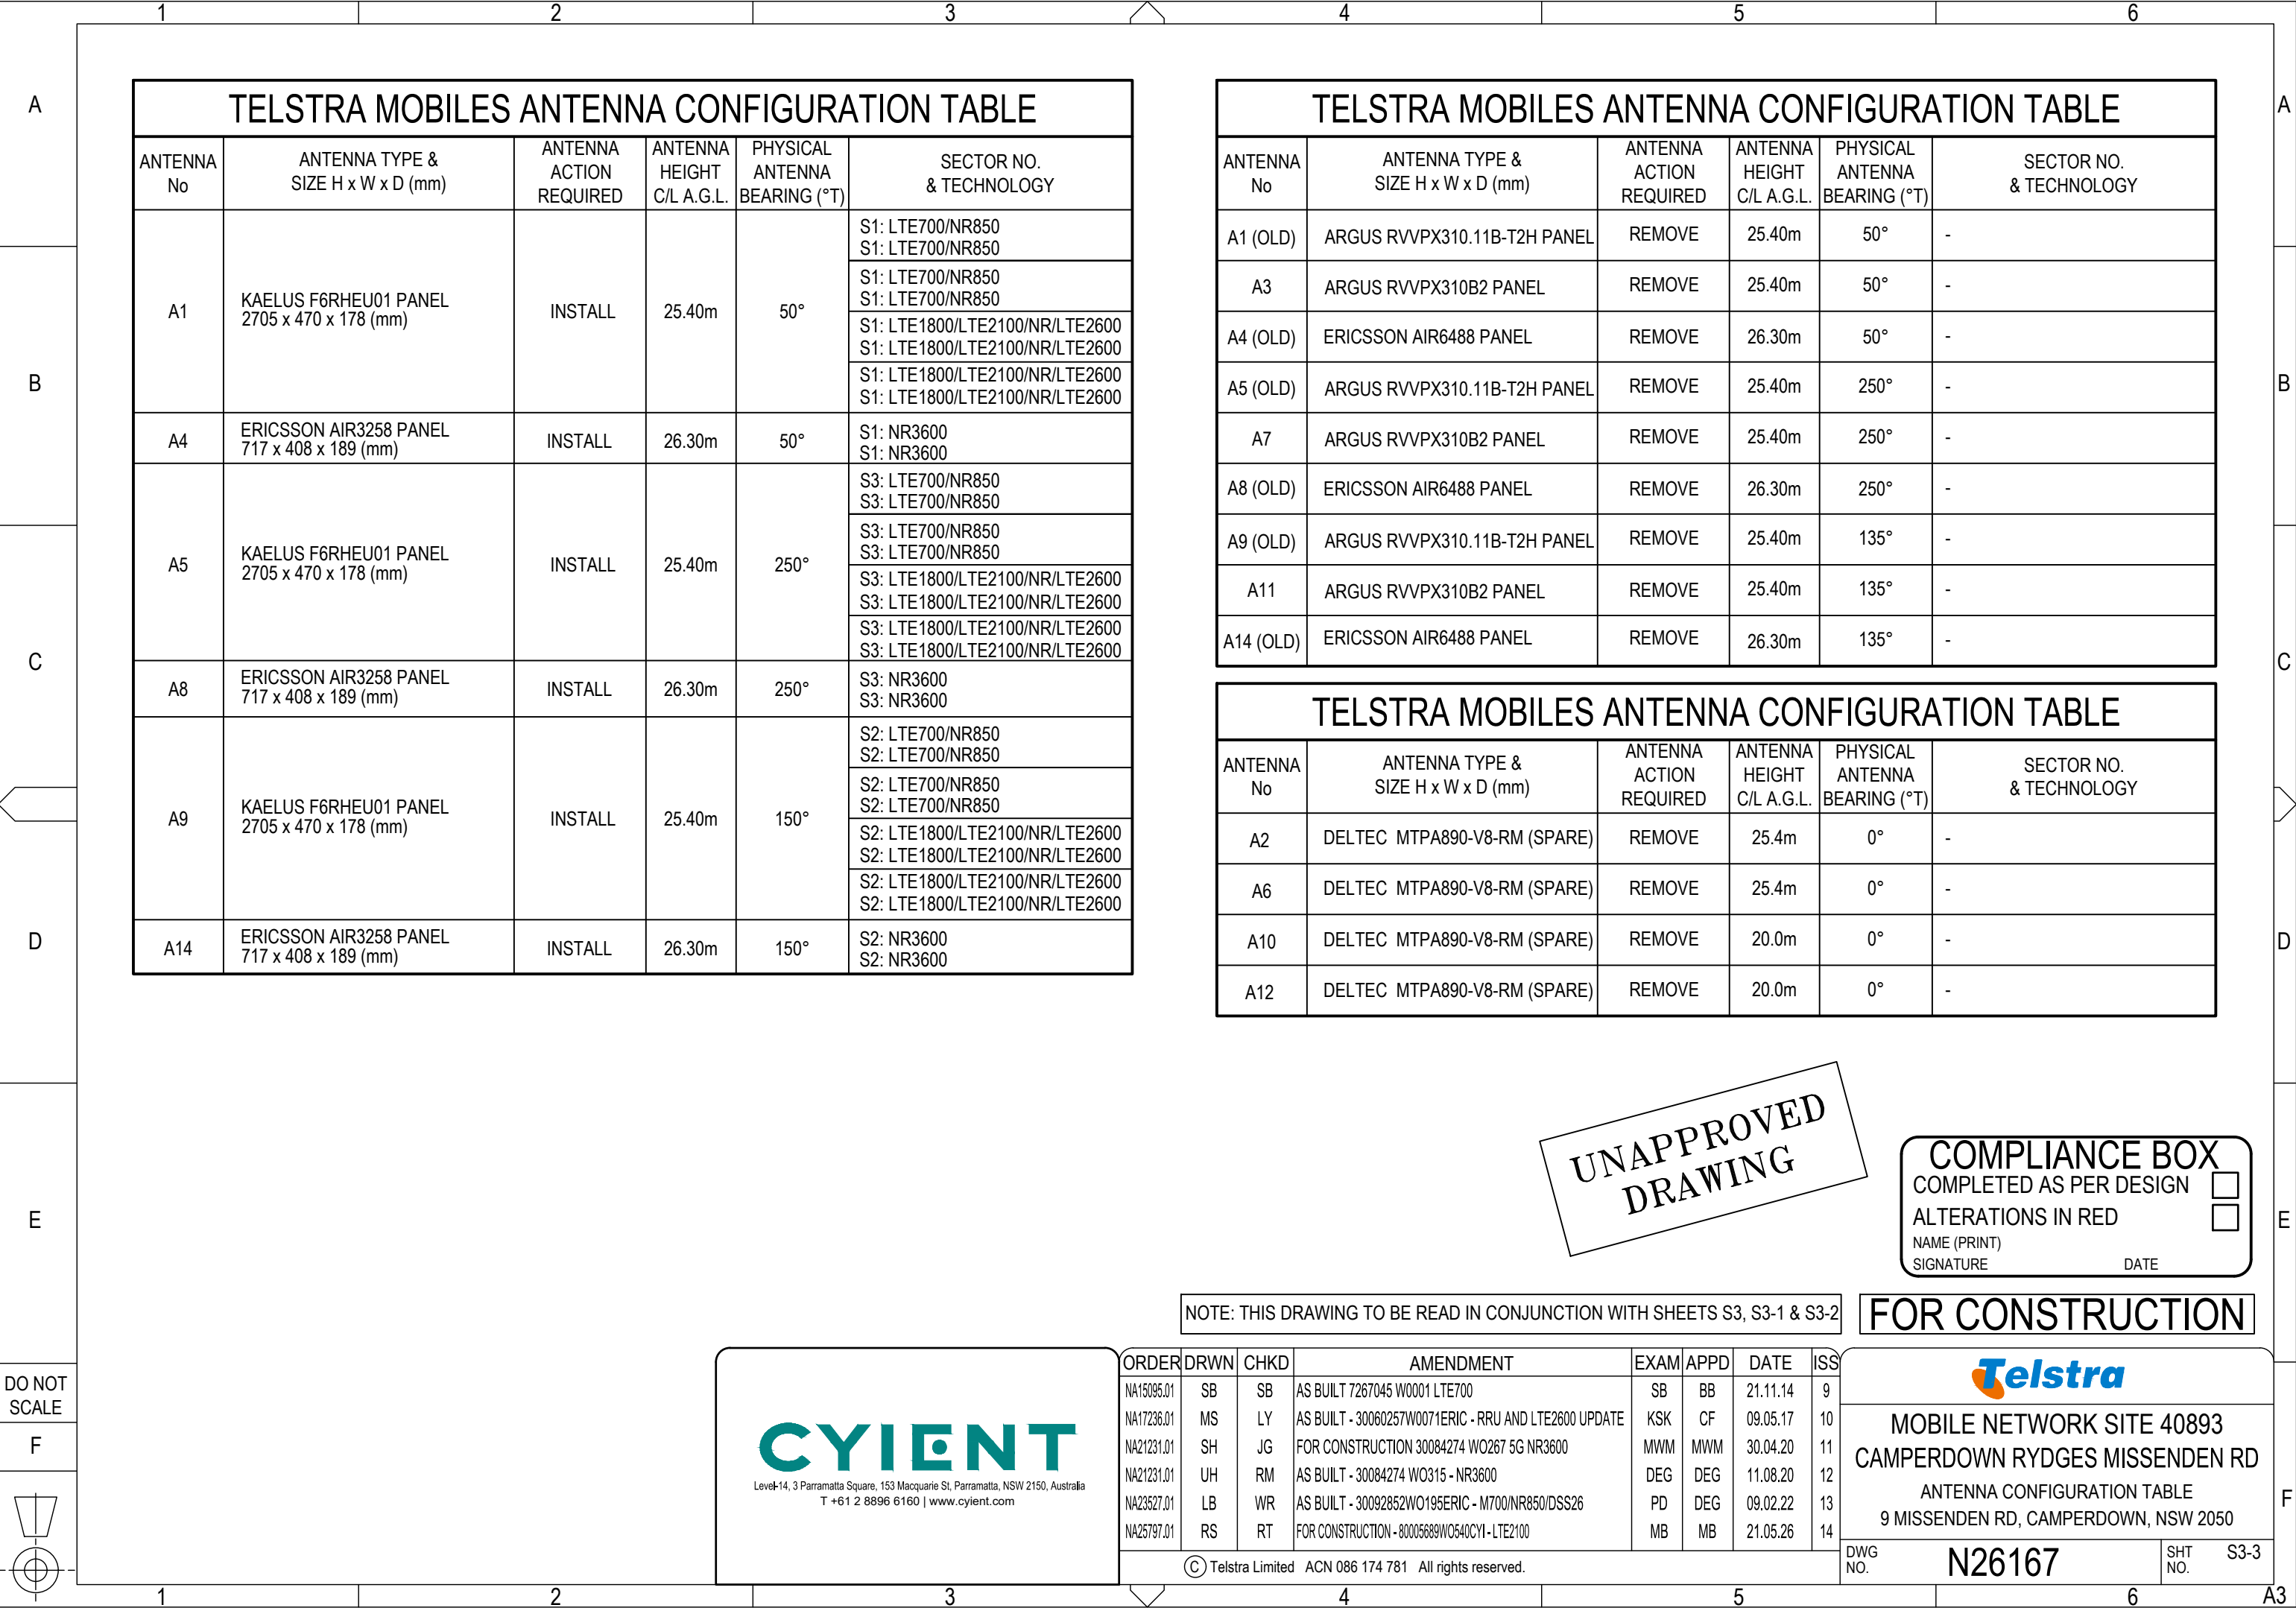

TELSTRA MOBILES ANTENNA CONFIGURATION TABLE

ANTENNA No	ANTENNA TYPE & SIZE H x W x D (mm)	ANTENNA ACTION REQUIRED	ANTENNA HEIGHT C/L A.G.L.	PHYSICAL ANTENNA BEARING (°T)	SECTOR NO. & TECHNOLOGY
A1	KAELUS F6RHEU01 PANEL 2705 x 470 x 178 (mm)	INSTALL	25.40m	50°	S1: LTE700/NR850
					S1: LTE700/NR850
					S1: LTE1800/LTE2100/NR/LTE2600
					S1: LTE1800/LTE2100/NR/LTE2600
A4	ERICSSON AIR3258 PANEL 717 x 408 x 189 (mm)	INSTALL	26.30m	50°	S1: NR3600
A5	KAELUS F6RHEU01 PANEL 2705 x 470 x 178 (mm)	INSTALL	25.40m	250°	S3: LTE700/NR850
					S3: LTE700/NR850
					S3: LTE1800/LTE2100/NR/LTE2600
					S3: LTE1800/LTE2100/NR/LTE2600
A8	ERICSSON AIR3258 PANEL 717 x 408 x 189 (mm)	INSTALL	26.30m	250°	S3: NR3600
A9	KAELUS F6RHEU01 PANEL 2705 x 470 x 178 (mm)	INSTALL	25.40m	150°	S2: LTE700/NR850
					S2: LTE700/NR850
					S2: LTE1800/LTE2100/NR/LTE2600
					S2: LTE1800/LTE2100/NR/LTE2600
A14	ERICSSON AIR3258 PANEL 717 x 408 x 189 (mm)	INSTALL	26.30m	150°	S2: NR3600

TELSTRA MOBILES ANTENNA CONFIGURATION TABLE

ANTENNA No	ANTENNA TYPE & SIZE H x W x D (mm)	ANTENNA ACTION REQUIRED	ANTENNA HEIGHT C/L A.G.L.	PHYSICAL ANTENNA BEARING (°T)	SECTOR NO. & TECHNOLOGY
A1 (OLD)	ARGUS RVVPX310.11B-T2H PANEL	REMOVE	25.40m	50°	-
A3	ARGUS RVVPX310B2 PANEL	REMOVE	25.40m	50°	-
A4 (OLD)	ERICSSON AIR6488 PANEL	REMOVE	26.30m	50°	-
A5 (OLD)	ARGUS RVVPX310.11B-T2H PANEL	REMOVE	25.40m	250°	-
A7	ARGUS RVVPX310B2 PANEL	REMOVE	25.40m	250°	-
A8 (OLD)	ERICSSON AIR6488 PANEL	REMOVE	26.30m	250°	-
A9 (OLD)	ARGUS RVVPX310.11B-T2H PANEL	REMOVE	25.40m	135°	-
A11	ARGUS RVVPX310B2 PANEL	REMOVE	25.40m	135°	-
A14 (OLD)	ERICSSON AIR6488 PANEL	REMOVE	26.30m	135°	-

TELSTRA MOBILES ANTENNA CONFIGURATION TABLE

ANTENNA No	ANTENNA TYPE & SIZE H x W x D (mm)	ANTENNA ACTION REQUIRED	ANTENNA HEIGHT C/L A.G.L.	PHYSICAL ANTENNA BEARING (°T)	SECTOR NO. & TECHNOLOGY
A2	DELTEC MTPA890-V8-RM (SPARE)	REMOVE	25.4m	0°	-
A6	DELTEC MTPA890-V8-RM (SPARE)	REMOVE	25.4m	0°	-
A10	DELTEC MTPA890-V8-RM (SPARE)	REMOVE	20.0m	0°	-
A12	DELTEC MTPA890-V8-RM (SPARE)	REMOVE	20.0m	0°	-

UNAPPROVED
DRAWING

COMPLIANCE BOX

COMPLETED AS PER DESIGN ☐

ALTERATIONS IN RED ☐

NAME (PRINT) _____

SIGNATURE _____ DATE _____

NOTE: THIS DRAWING TO BE READ IN CONJUNCTION WITH SHEETS S3, S3-1 & S3-2

FOR CONSTRUCTION

CYIENT

Level 14, 3 Parramatta Square, 153 Macquarie St, Parramatta, NSW 2150, Australia
T +61 2 8896 6160 | www.cyient.com

ORDER	DRWN	CHKD	AMENDMENT	EXAM	APPD	DATE	ISS
NA15095.01	SB	SB	AS BUILT 7267045 W0001 LTE700	SB	BB	21.11.14	9
NA17236.01	MS	LY	AS BUILT - 30060257W0071ERIC - RRU AND LTE2600 UPDATE	KSK	CF	09.05.17	10
NA21231.01	SH	JG	FOR CONSTRUCTION 30084274 W0267 5G NR3600	MWM	MWM	30.04.20	11
NA21231.01	UH	RM	AS BUILT - 30084274 W0315 - NR3600	DEG	DEG	11.08.20	12
NA23527.01	LB	WR	AS BUILT - 30092852W0195ERIC - M700/NR850/DSS26	PD	DEG	09.02.22	13
NA25797.01	RS	RT	FOR CONSTRUCTION - 80005689W0540CYI - LTE2100	MB	MB	21.05.26	14

© Telstra Limited ACN 086 174 781 All rights reserved.




MOBILE NETWORK SITE 40893
CAMPERDOWN RYDGES MISSENDEN RD
ANTENNA CONFIGURATION TABLE
9 MISSENDEN RD, CAMPERDOWN, NSW 2050

DWG NO.

N26167

SHT NO.

S3-3

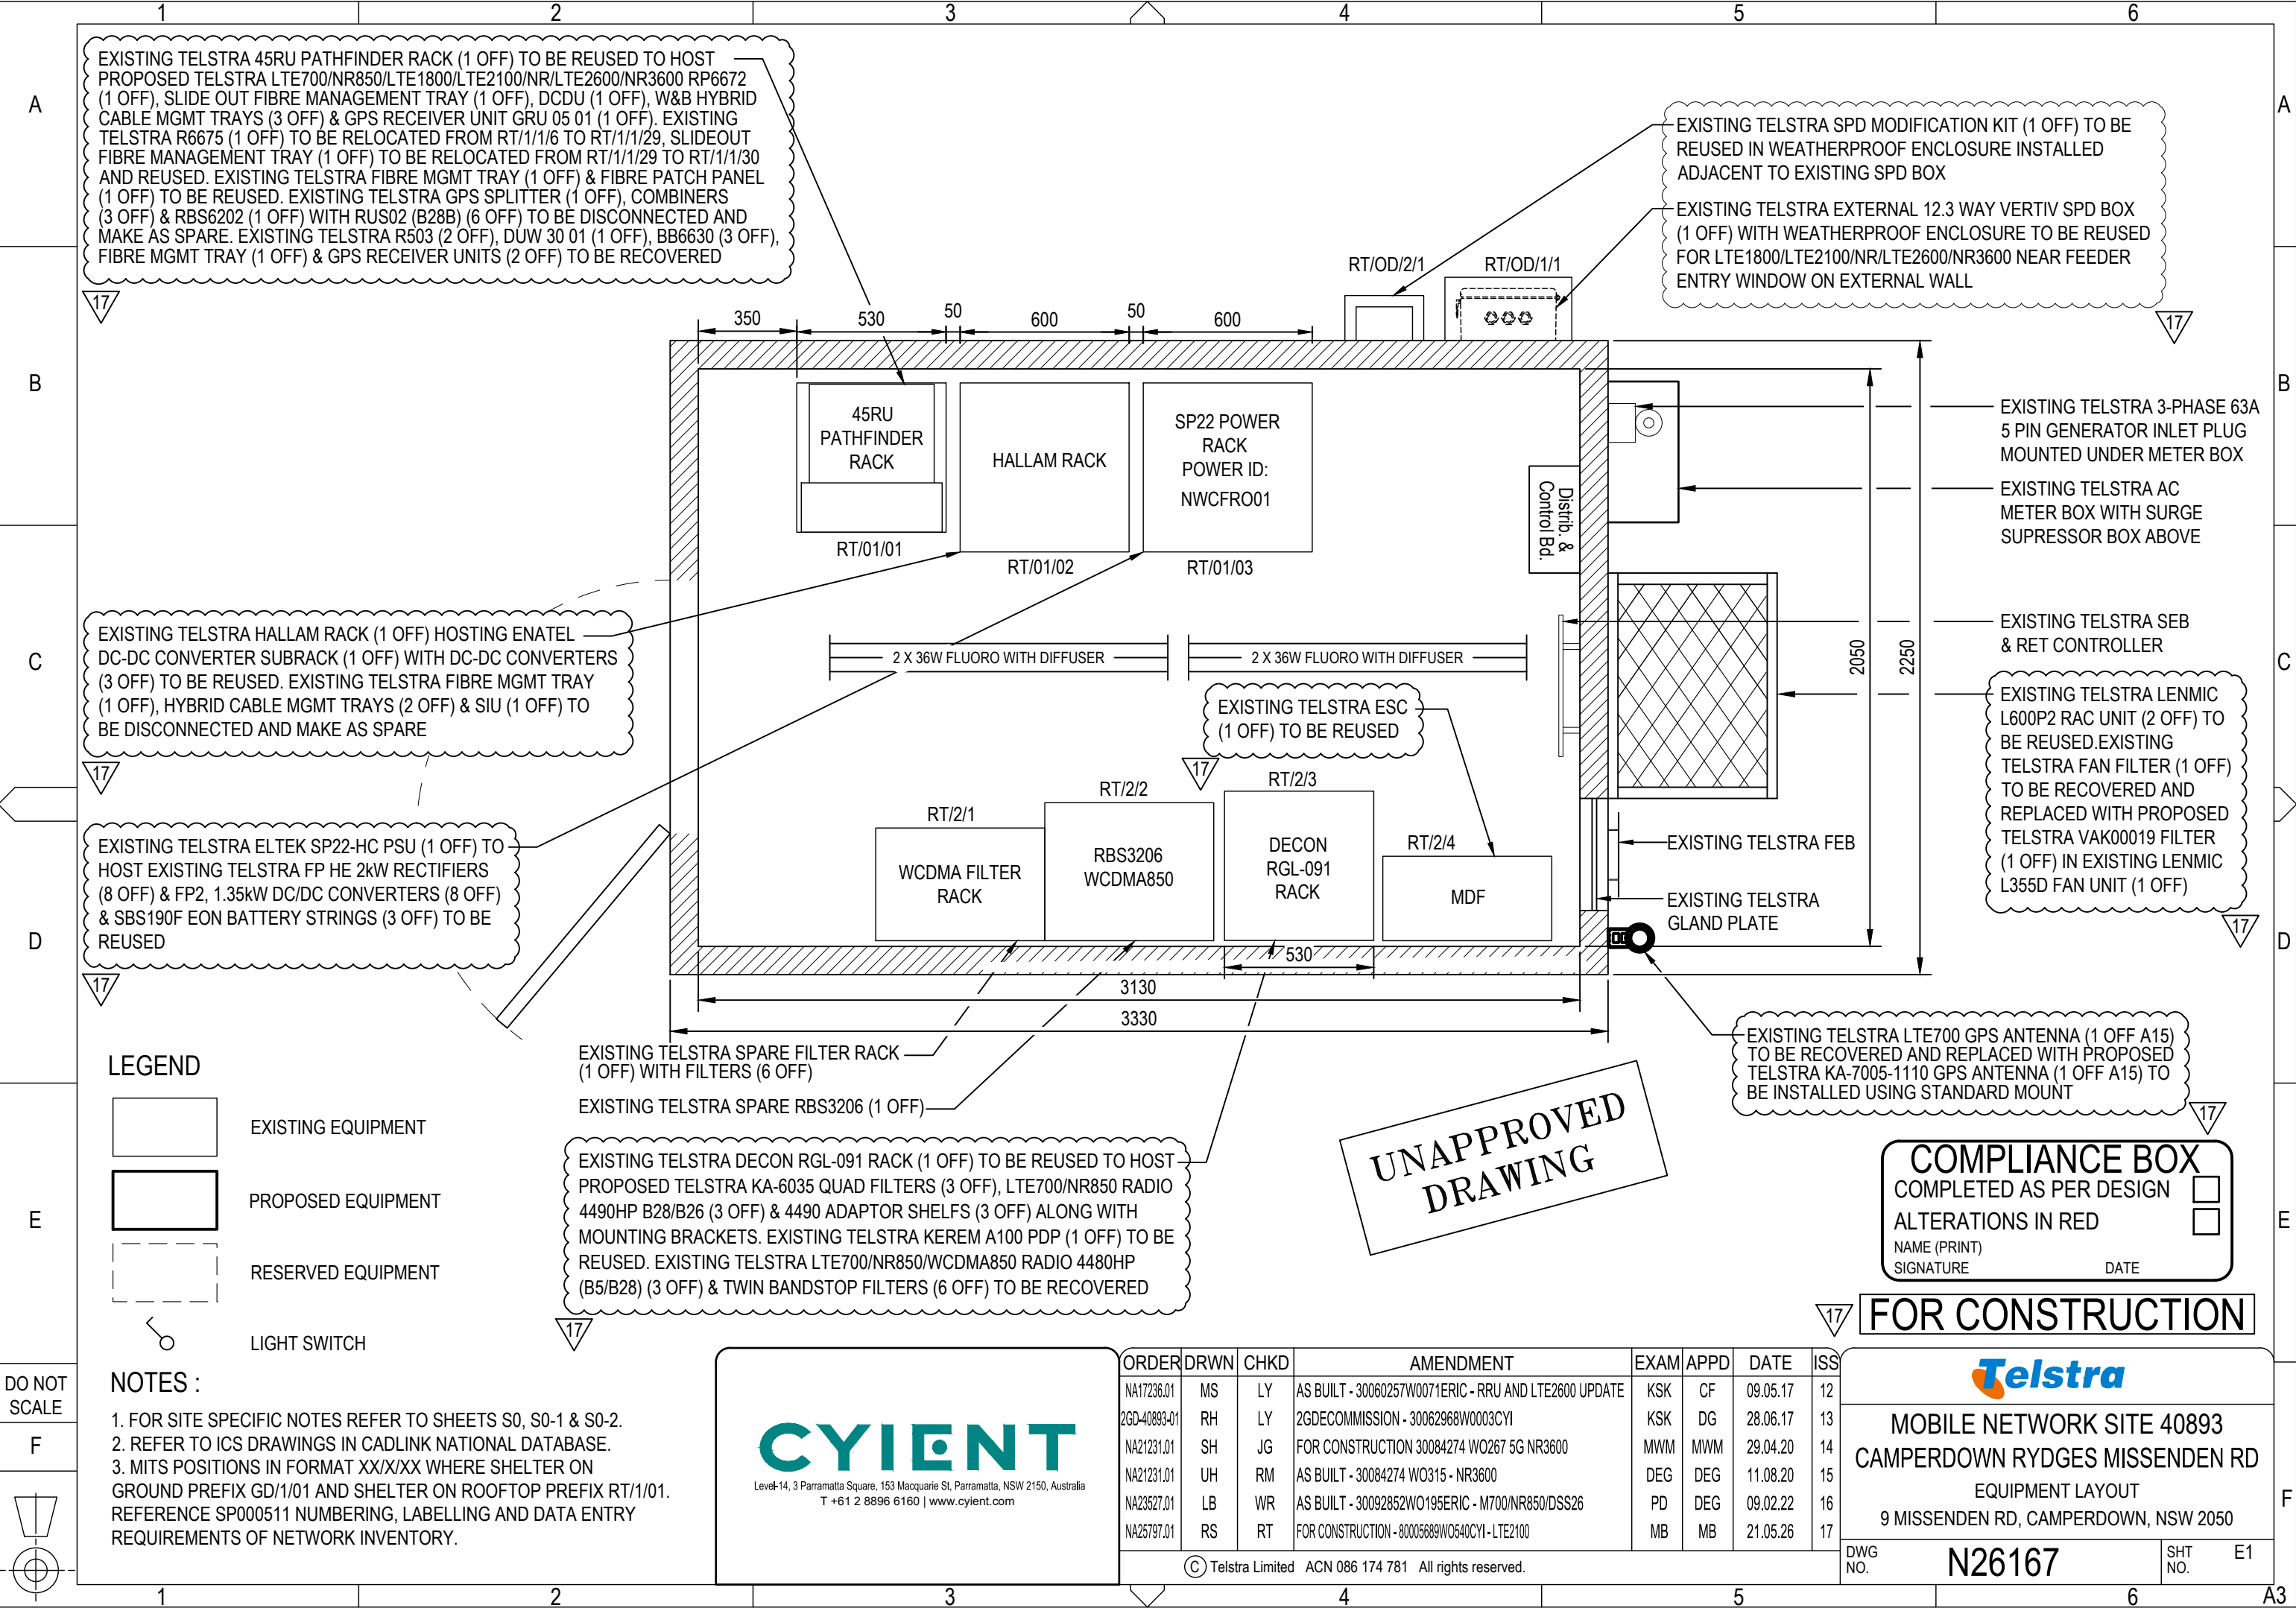

EXISTING TELSTRA 45RU PATHFINDER RACK (1 OFF) TO BE REUSED TO HOST PROPOSED TELSTRA LTE700/NR850/LTE1800/LTE2100/NR/LTE2600/NR3600 RP6672 (1 OFF), SLIDE OUT FIBRE MANAGEMENT TRAY (1 OFF), DCDU (1 OFF), W&B HYBRID CABLE MGMT TRAYS (3 OFF) & GPS RECEIVER UNIT GRU 05 01 (1 OFF). EXISTING TELSTRA R6675 (1 OFF) TO BE RELOCATED FROM RT/1/1/6 TO RT/1/1/29, SLIDEOUT FIBRE MANAGEMENT TRAY (1 OFF) TO BE RELOCATED FROM RT/1/1/29 TO RT/1/1/30 AND REUSED. EXISTING TELSTRA FIBRE MGMT TRAY (1 OFF) & FIBRE PATCH PANEL (1 OFF) TO BE REUSED. EXISTING TELSTRA GPS SPLITTER (1 OFF), COMBINERS (3 OFF) & RBS6202 (1 OFF) WITH RUS02 (B28B) (6 OFF) TO BE DISCONNECTED AND MAKE AS SPARE. EXISTING TELSTRA R503 (2 OFF), DUW 30 01 (1 OFF), BB6630 (3 OFF), FIBRE MGMT TRAY (1 OFF) & GPS RECEIVER UNITS (2 OFF) TO BE RECOVERED

EXISTING TELSTRA SPD MODIFICATION KIT (1 OFF) TO BE REUSED IN WEATHERPROOF ENCLOSURE INSTALLED ADJACENT TO EXISTING SPD BOX
EXISTING TELSTRA EXTERNAL 12.3 WAY VERTIV SPD BOX (1 OFF) WITH WEATHERPROOF ENCLOSURE TO BE REUSED FOR LTE1800/LTE2100/NR/LTE2600/NR3600 NEAR FEEDER ENTRY WINDOW ON EXTERNAL WALL

EXISTING TELSTRA HALLAM RACK (1 OFF) HOSTING ENATEL DC-DC CONVERTER SUBRACK (1 OFF) WITH DC-DC CONVERTERS (3 OFF) TO BE REUSED. EXISTING TELSTRA FIBRE MGMT TRAY (1 OFF), HYBRID CABLE MGMT TRAYS (2 OFF) & SIU (1 OFF) TO BE DISCONNECTED AND MAKE AS SPARE

EXISTING TELSTRA ELTEK SP22-HC PSU (1 OFF) TO HOST EXISTING TELSTRA FP HE 2kW RECTIFIERS (8 OFF) & FP2, 1.35kW DC/DC CONVERTERS (8 OFF) & SBS190F EON BATTERY STRINGS (3 OFF) TO BE REUSED

EXISTING TELSTRA 3-PHASE 63A 5 PIN GENERATOR INLET PLUG MOUNTED UNDER METER BOX
EXISTING TELSTRA AC METER BOX WITH SURGE SUPPRESSOR BOX ABOVE
EXISTING TELSTRA SEB & RET CONTROLLER
EXISTING TELSTRA LENMIC L600P2 RAC UNIT (2 OFF) TO BE REUSED. EXISTING TELSTRA FAN FILTER (1 OFF) TO BE RECOVERED AND REPLACED WITH PROPOSED TELSTRA VAK00019 FILTER (1 OFF) IN EXISTING LENMIC L355D FAN UNIT (1 OFF)

EXISTING TELSTRA LTE700 GPS ANTENNA (1 OFF A15) TO BE RECOVERED AND REPLACED WITH PROPOSED TELSTRA KA-7005-1110 GPS ANTENNA (1 OFF A15) TO BE INSTALLED USING STANDARD MOUNT

EXISTING TELSTRA SPARE FILTER RACK (1 OFF) WITH FILTERS (6 OFF)
EXISTING TELSTRA SPARE RBS3206 (1 OFF)

EXISTING TELSTRA DECON RGL-091 RACK (1 OFF) TO BE REUSED TO HOST PROPOSED TELSTRA KA-6035 QUAD FILTERS (3 OFF), LTE700/NR850 RADIO 4490HP B28/B26 (3 OFF) & 4490 ADAPTOR SHELF (3 OFF) ALONG WITH MOUNTING BRACKETS. EXISTING TELSTRA KEREM A100 PDP (1 OFF) TO BE REUSED. EXISTING TELSTRA LTE700/NR850/WCDMA850 RADIO 4480HP (B5/B28) (3 OFF) & TWIN BANDSTOP FILTERS (6 OFF) TO BE RECOVERED

UNAPPROVED
DRAWING

COMPLIANCE BOX

COMPLETED AS PER DESIGN

ALTERATIONS IN RED

NAME (PRINT)

SIGNATURE

DATE

FOR CONSTRUCTION

LEGEND

EXISTING EQUIPMENT

PROPOSED EQUIPMENT

RESERVED EQUIPMENT

LIGHT SWITCH

NOTES :

1. FOR SITE SPECIFIC NOTES REFER TO SHEETS S0, S0-1 & S0-2.

2. REFER TO ICS DRAWINGS IN CADLINK NATIONAL DATABASE.

3. MITS POSITIONS IN FORMAT XX/X/XX WHERE SHELTER ON GROUND PREFIX GD/1/01 AND SHELTER ON ROOFTOP PREFIX RT/1/01. REFERENCE SP000511 NUMBERING, LABELLING AND DATA ENTRY REQUIREMENTS OF NETWORK INVENTORY.

CYIENT

Level 14, 3 Parramatta Square, 153 Macquarie St, Parramatta, NSW 2150, Australia

T +61 2 8896 6160 | www.cyient.com

ORDER	DRWN	CHKD	AMENDMENT	EXAM	APPD	DATE	ISS
NA17236.01	MS	LY	AS BUILT - 30060257W0071ERIC - RRU AND LTE2600 UPDATE	KSK	CF	09.05.17	12
2GD-40893-01	RH	LY	2GDECOMMISSION - 30062968W0003CYI	KSK	DG	28.06.17	13
NA21231.01	SH	JG	FOR CONSTRUCTION 30084274 WO267 5G NR3600	MWM	MWM	29.04.20	14
NA21231.01	UH	RM	AS BUILT - 30084274 WO315 - NR3600	DEG	DEG	11.08.20	15
NA23527.01	LB	WR	AS BUILT - 30092852WO195ERIC - M700/NR850/DSS26	PD	DEG	09.02.22	16
NA25797.01	RS	RT	FOR CONSTRUCTION - 800056889W0540CYI - LTE2100	MB	MB	21.05.26	17

© Telstra Limited ACN 086 174 781 All rights reserved.

Telstra

MOBILE NETWORK SITE 40893


CAMPERDOWN RYDGES MISSENDEN RD

EQUIPMENT LAYOUT


9 MISSENDEN RD, CAMPERDOWN, NSW 2050

DWG NO. N26167

SHT NO. E1

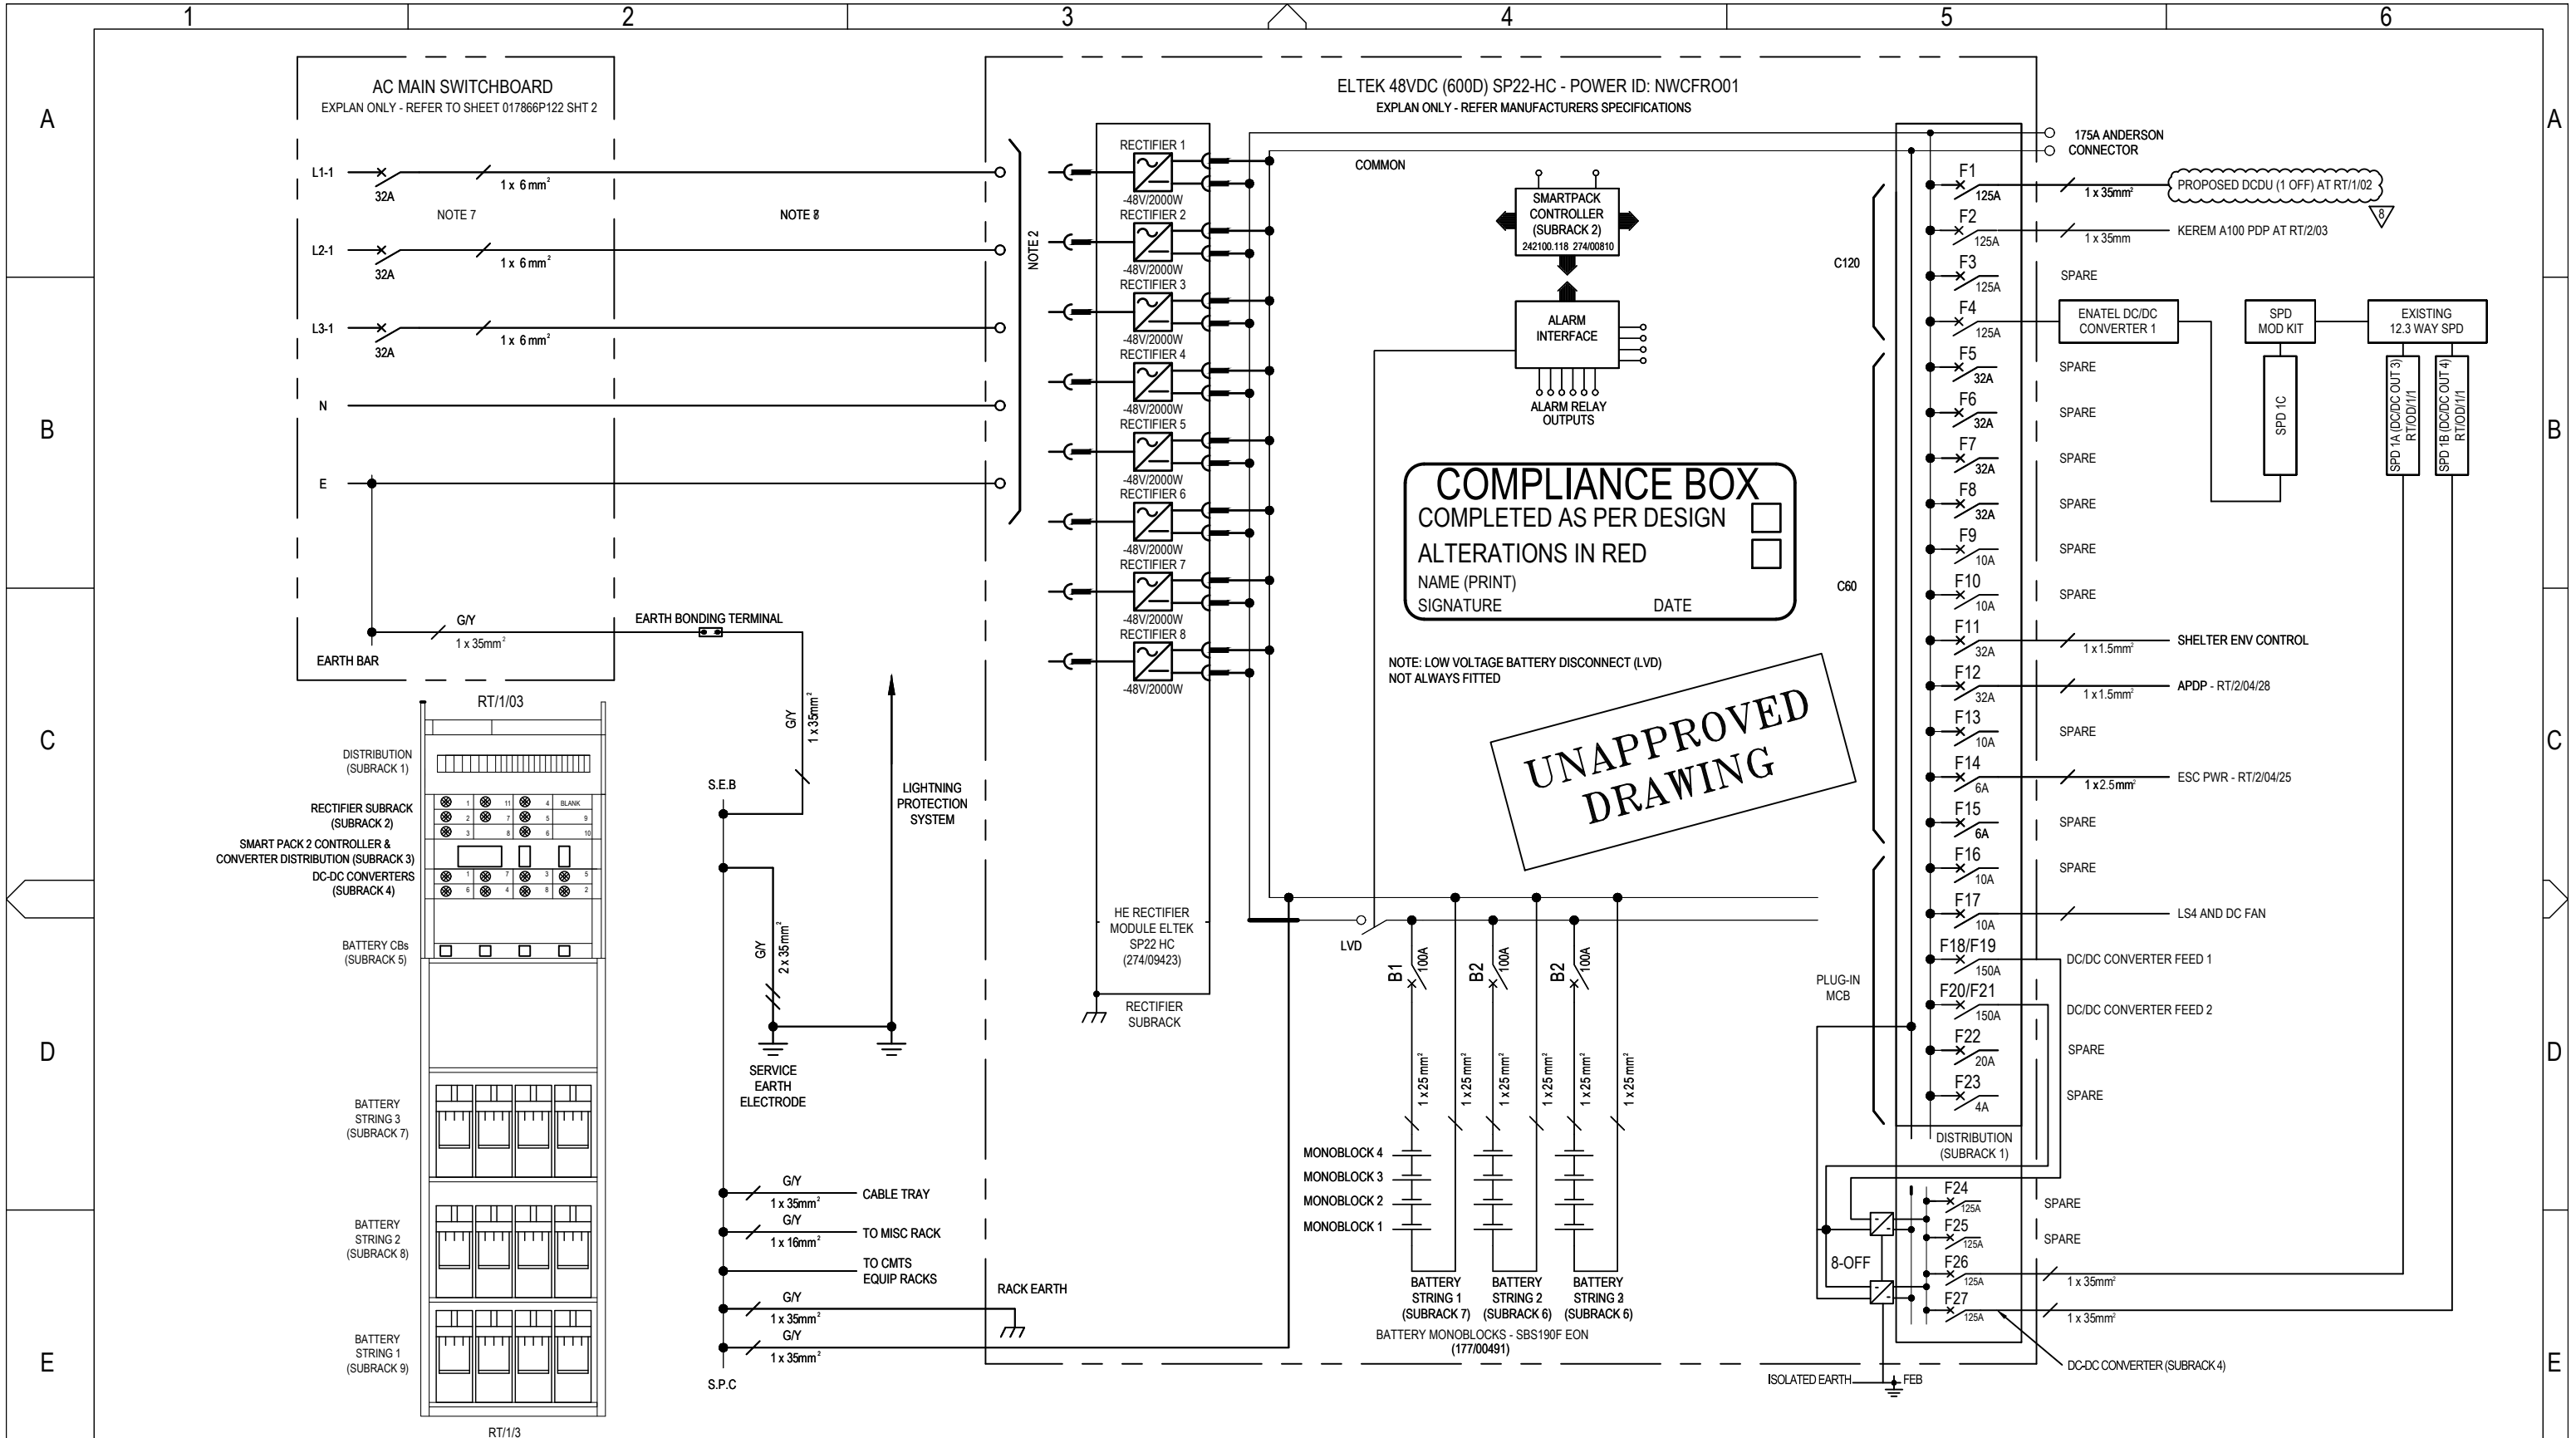

NOTES:										8 FOR CONSTRUCTION																																																																																																			
DO NOT SCALE F  12345678										 Level-14, 3 Parramatta Square, 153 Macquarie St, Parramatta, NSW 2150, Australia T +61 2 8896 6160 www.cyient.com										ORDER										DRWN										CHKD										AMENDMENT										EXAM										APPD										DATE										ISS										 MOBILE NETWORK SITE 40893 CAMPERDOWN RYDGES MISSENDEN RD DC POWER LINE DIAGRAM 9 MISSENDEN RD, CAMPERDOWN, NSW 2050 DWG NO. N26167 SHT NO. E4									
																				NA17236.01										MS										LY										AS BUILT - 30060257W0071ERIC - RRU AND LTE2600 UPDATE										KSK										CF										09.05.17										3																			
																				2GD-40893-01										RH										LY										2GDECOMMISSION - 30062968W0003CYI										KSK										DG										28.06.17										4																			
																				NA21231.01										SH										JG										FOR CONSTRUCTION 30084274 WO267 5G NR3600										MWM										MWM										30.04.20										5																			
																				NA21231.01										UH										RM										AS BUILT - 30084274 WO315 - NR3600										DEG										DEG										11.08.20										6																			
																				NA23527.01										LB										WR										AS BUILT - 30092852WO195ERIC - M700/NR850/DSS26										PD										DEG										09.02.22										7																			
																				NA25797.01										RS										RT										FOR CONSTRUCTION - 80005689W0540CYI - LTE2100										MB										MB										21.05.26										8																			
																				© Telstra Limited ACN 086 174 781 All rights reserved.																																																																																									

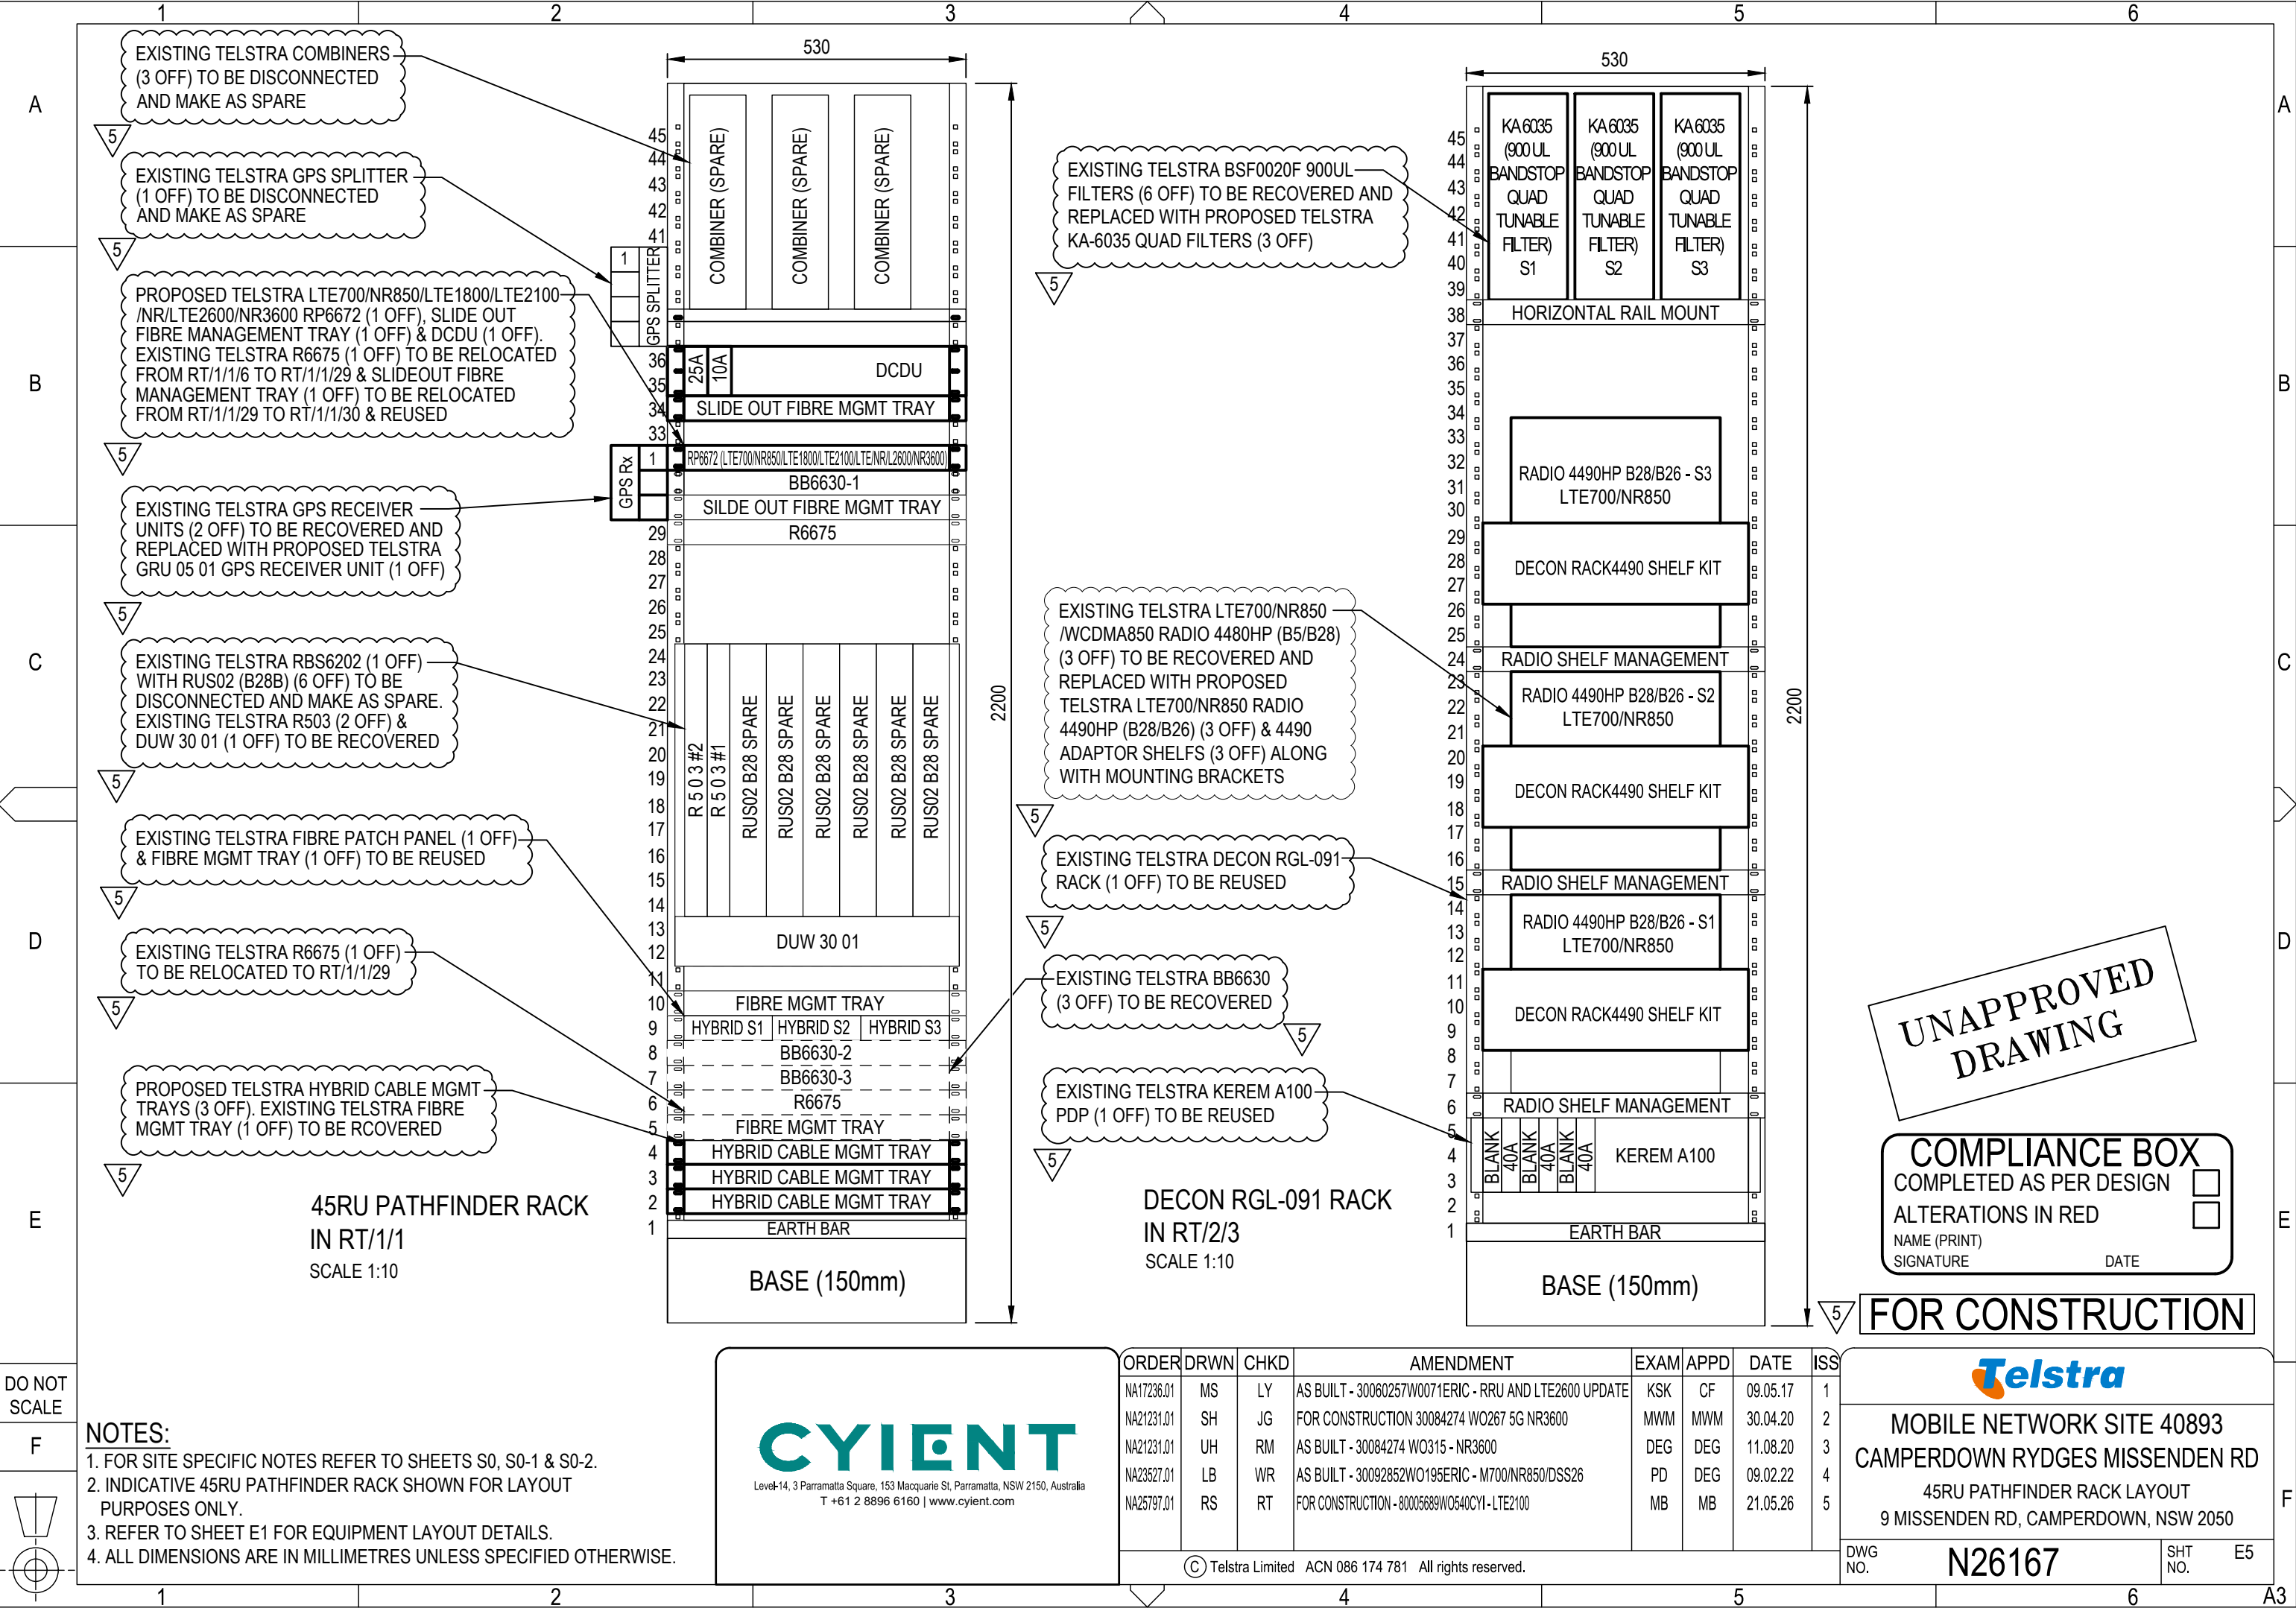

DO NOT
SCALE

F

NOTES:
1. FOR SITE SPECIFIC NOTES REFER TO SHEETS S0, S0-1 & S0-2.
2. INDICATIVE 45RU PATHFINDER RACK SHOWN FOR LAYOUT PURPOSES ONLY.
3. REFER TO SHEET E1 FOR EQUIPMENT LAYOUT DETAILS.
4. ALL DIMENSIONS ARE IN MILLIMETRES UNLESS SPECIFIED OTHERWISE.



Level 14, 3 Parramatta Square, 153 Macquarie St, Parramatta, NSW 2150, Australia
T +61 2 8896 6160 | www.cyient.com



ORDER	DRWN	CHKD	AMENDMENT	EXAM	APPD	DATE	ISS
NA17236.01	MS	LY	AS BUILT - 30060257W0071ERIC - RRU AND LTE2600 UPDATE	KSK	CF	09.05.17	1
NA21231.01	SH	JG	FOR CONSTRUCTION 30084274 W0267 5G NR3600	MWM	MWM	30.04.20	2
NA21231.01	UH	RM	AS BUILT - 30084274 W0315 - NR3600	DEG	DEG	11.08.20	3
NA23527.01	LB	WR	AS BUILT - 30092852W0195ERIC - M700/NR850/DSS26	PD	DEG	09.02.22	4
NA25797.01	RS	RT	FOR CONSTRUCTION - 80005689W0540CYI - LTE2100	MB	MB	21.05.26	5

© Telstra Limited ACN 086 174 781 All rights reserved.



MOBILE NETWORK SITE 40893
CAMPERDOWN RYDGES MISSENDEN RD
45RU PATHFINDER RACK LAYOUT
9 MISSENDEN RD, CAMPERDOWN, NSW 2050

DWG NO. **N26167** SHT NO. **E5**

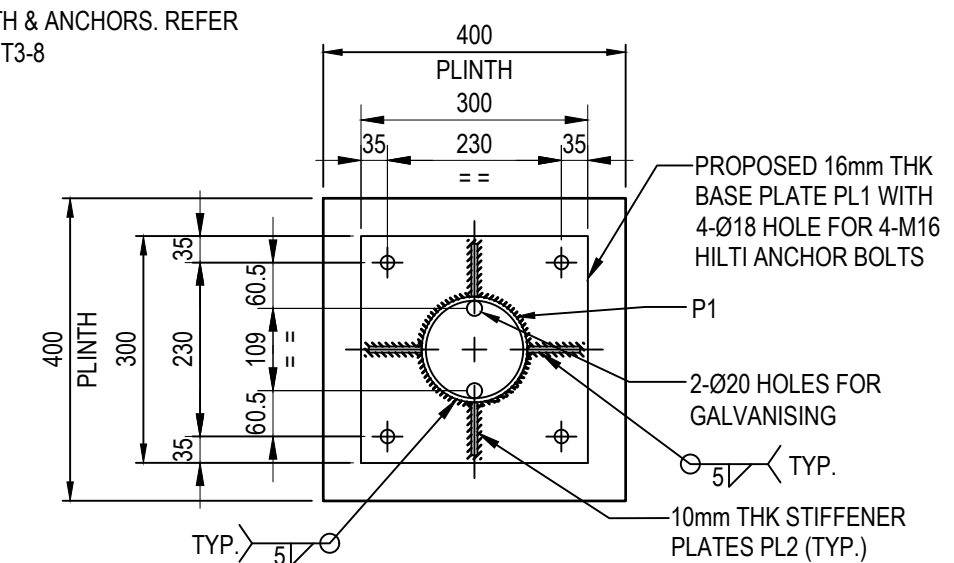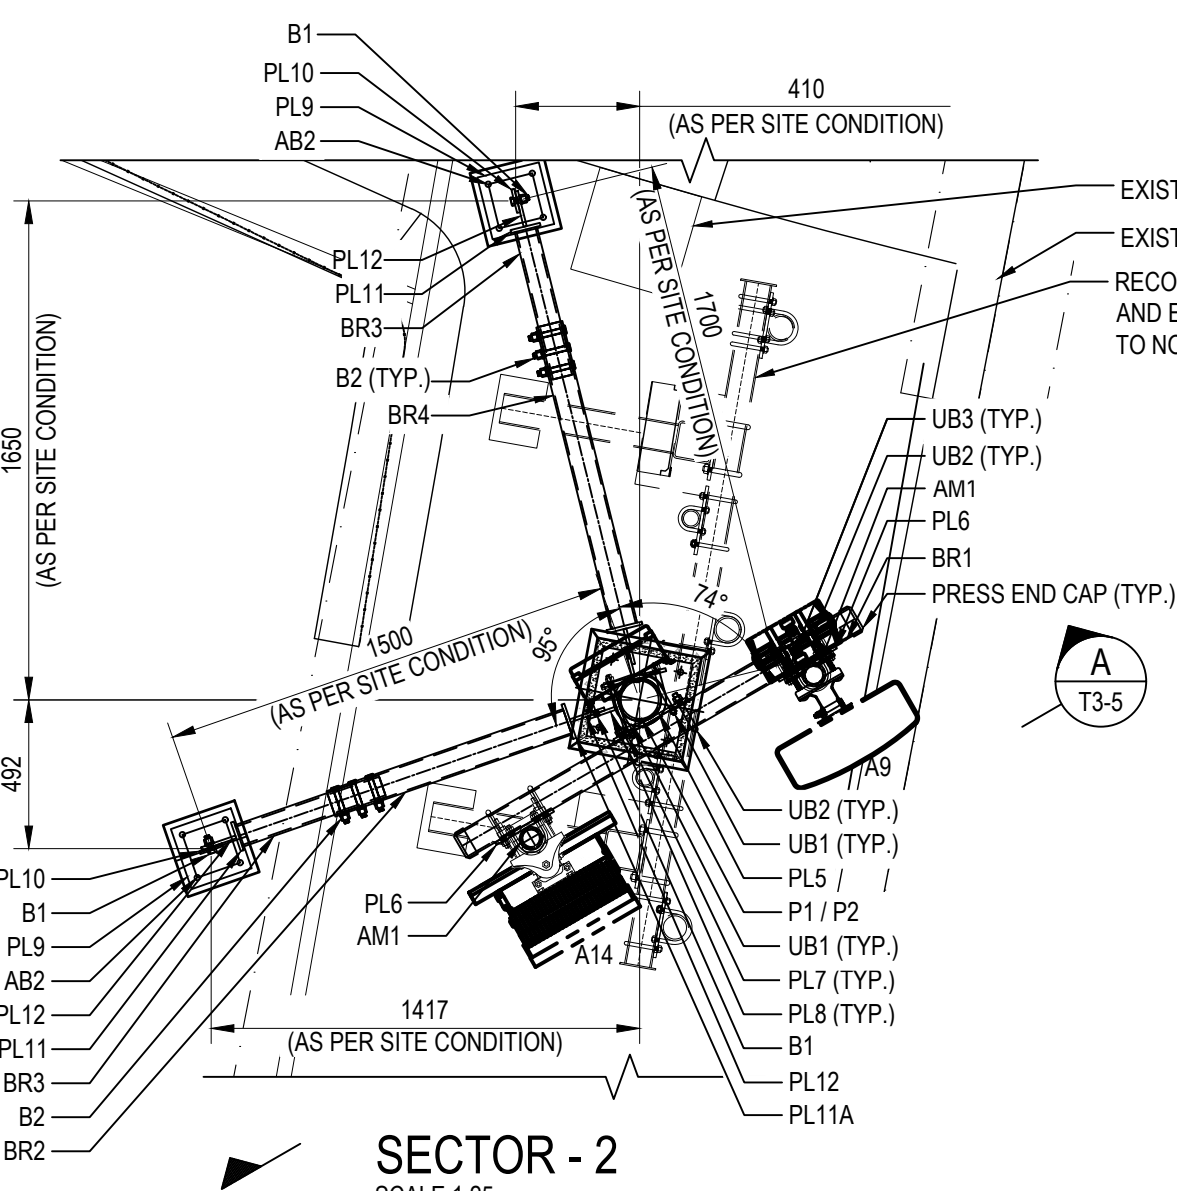

SECTOR - 2
SCALE 1:25

ANTENNA MOUNTING PLAN AT E.L. 25.40m & 26.30m

- NOTES:**
- 1.FOR STANDARD CONSTRUCTION NOTES REFER TO TELSTRA STANDARD DRAWING 017866P05.
 2. ALL DIMENSIONS ARE IN MILLIMETERS UNLESS SPECIFIED OTHERWISE.
 3. HIGH STRENGTH BOLTS AND ALL SPRING WASHERS TO AS 1252.1 (2016) GRADE /S U.N.O.
 4. ALL BOLTS INCLUDING U-BOLTS TO BE SUPPLIED WITH CORRESPONDING NUTS, SPRING WASHERS AND LOCKNUTS. REFER STANDARD DRAWING 017866P70 SHEET 4 ISSUE 4 FOR DETAILS.
 5. ALL HOLLOW SECTIONS TO AS 1163 (2016) GRADE C250LO U.N.O. ALL HOT ROLLED STEEL TO AS 3678 (2016) & AS 3679 (2016) GRADE 300 U.N.O.
 6. ALL STEELWORK TO BE IN ACCORDANCE WITH AS 4100 & AS 1163.
 7. ALL WELDING TO BE CATEGORY SP TO AS 1554 (2014) ALL WELDS TO BE 6mm CONTINUOUS FILLET WELDS U.N.O.
 8. ALL STEELWORK TO BE HOT DIP GALVANIZED TO AS 4680, AS 1559 & AS 1214.
 9. APPLY 2 COATS OF ZINC RICH PAINT TO ALL FRESHLY CUT, WELDED OR DRILLED STEEL ON SITE, REMOVE ALL SWARF, BURRS & SHARP EDGES.

NOTE:
RECOVER EXISTING STRUCTURE AND INSTALL PROPOSED NEW POLE FOR A9 & A14 ANTENNA

NOTE FOR MANUFACTURER & INSTALLER:
TRIAL ASSEMBLE PRIOR TO GALVANISING AND DELIVERY TO SITE TO ENSURE CORRECT FIT AND NUMBER OF PARTS

CYIENT
Level-14, 3 Parramatta Square, 153 Macquarie St, Parramatta, NSW 2150, Australia
T +61 2 8896 6160 | www.cyient.com

**UNAPPROVED
DRAWING**

COMPLIANCE BOX

COMPLETED AS PER DESIGN ☐

ALTERATIONS IN RED ☐

NAME (PRINT) _____

SIGNATURE _____ DATE _____


FOR CONSTRUCTION


ORDER	DRWN	CHKD	AMENDMENT	EXAM	APPD	DATE	ISS
NA25797.01	DSS	GNK	FOR CONSTRUCTION - 80005689W0540CYI - LTE2100	MB	MB	21.05.26	1

Telstra

MOBILE NETWORK SITE 40893
CAMPERDOWN RYDGES MISSENDEN RD
ANTENNA MOUNTING DETAILS - SHEET 1 OF 9
9 MISSENDEN RD, CAMPERDOWN, NSW 2050

DWG NO. **N26167** SHT NO. T3-4

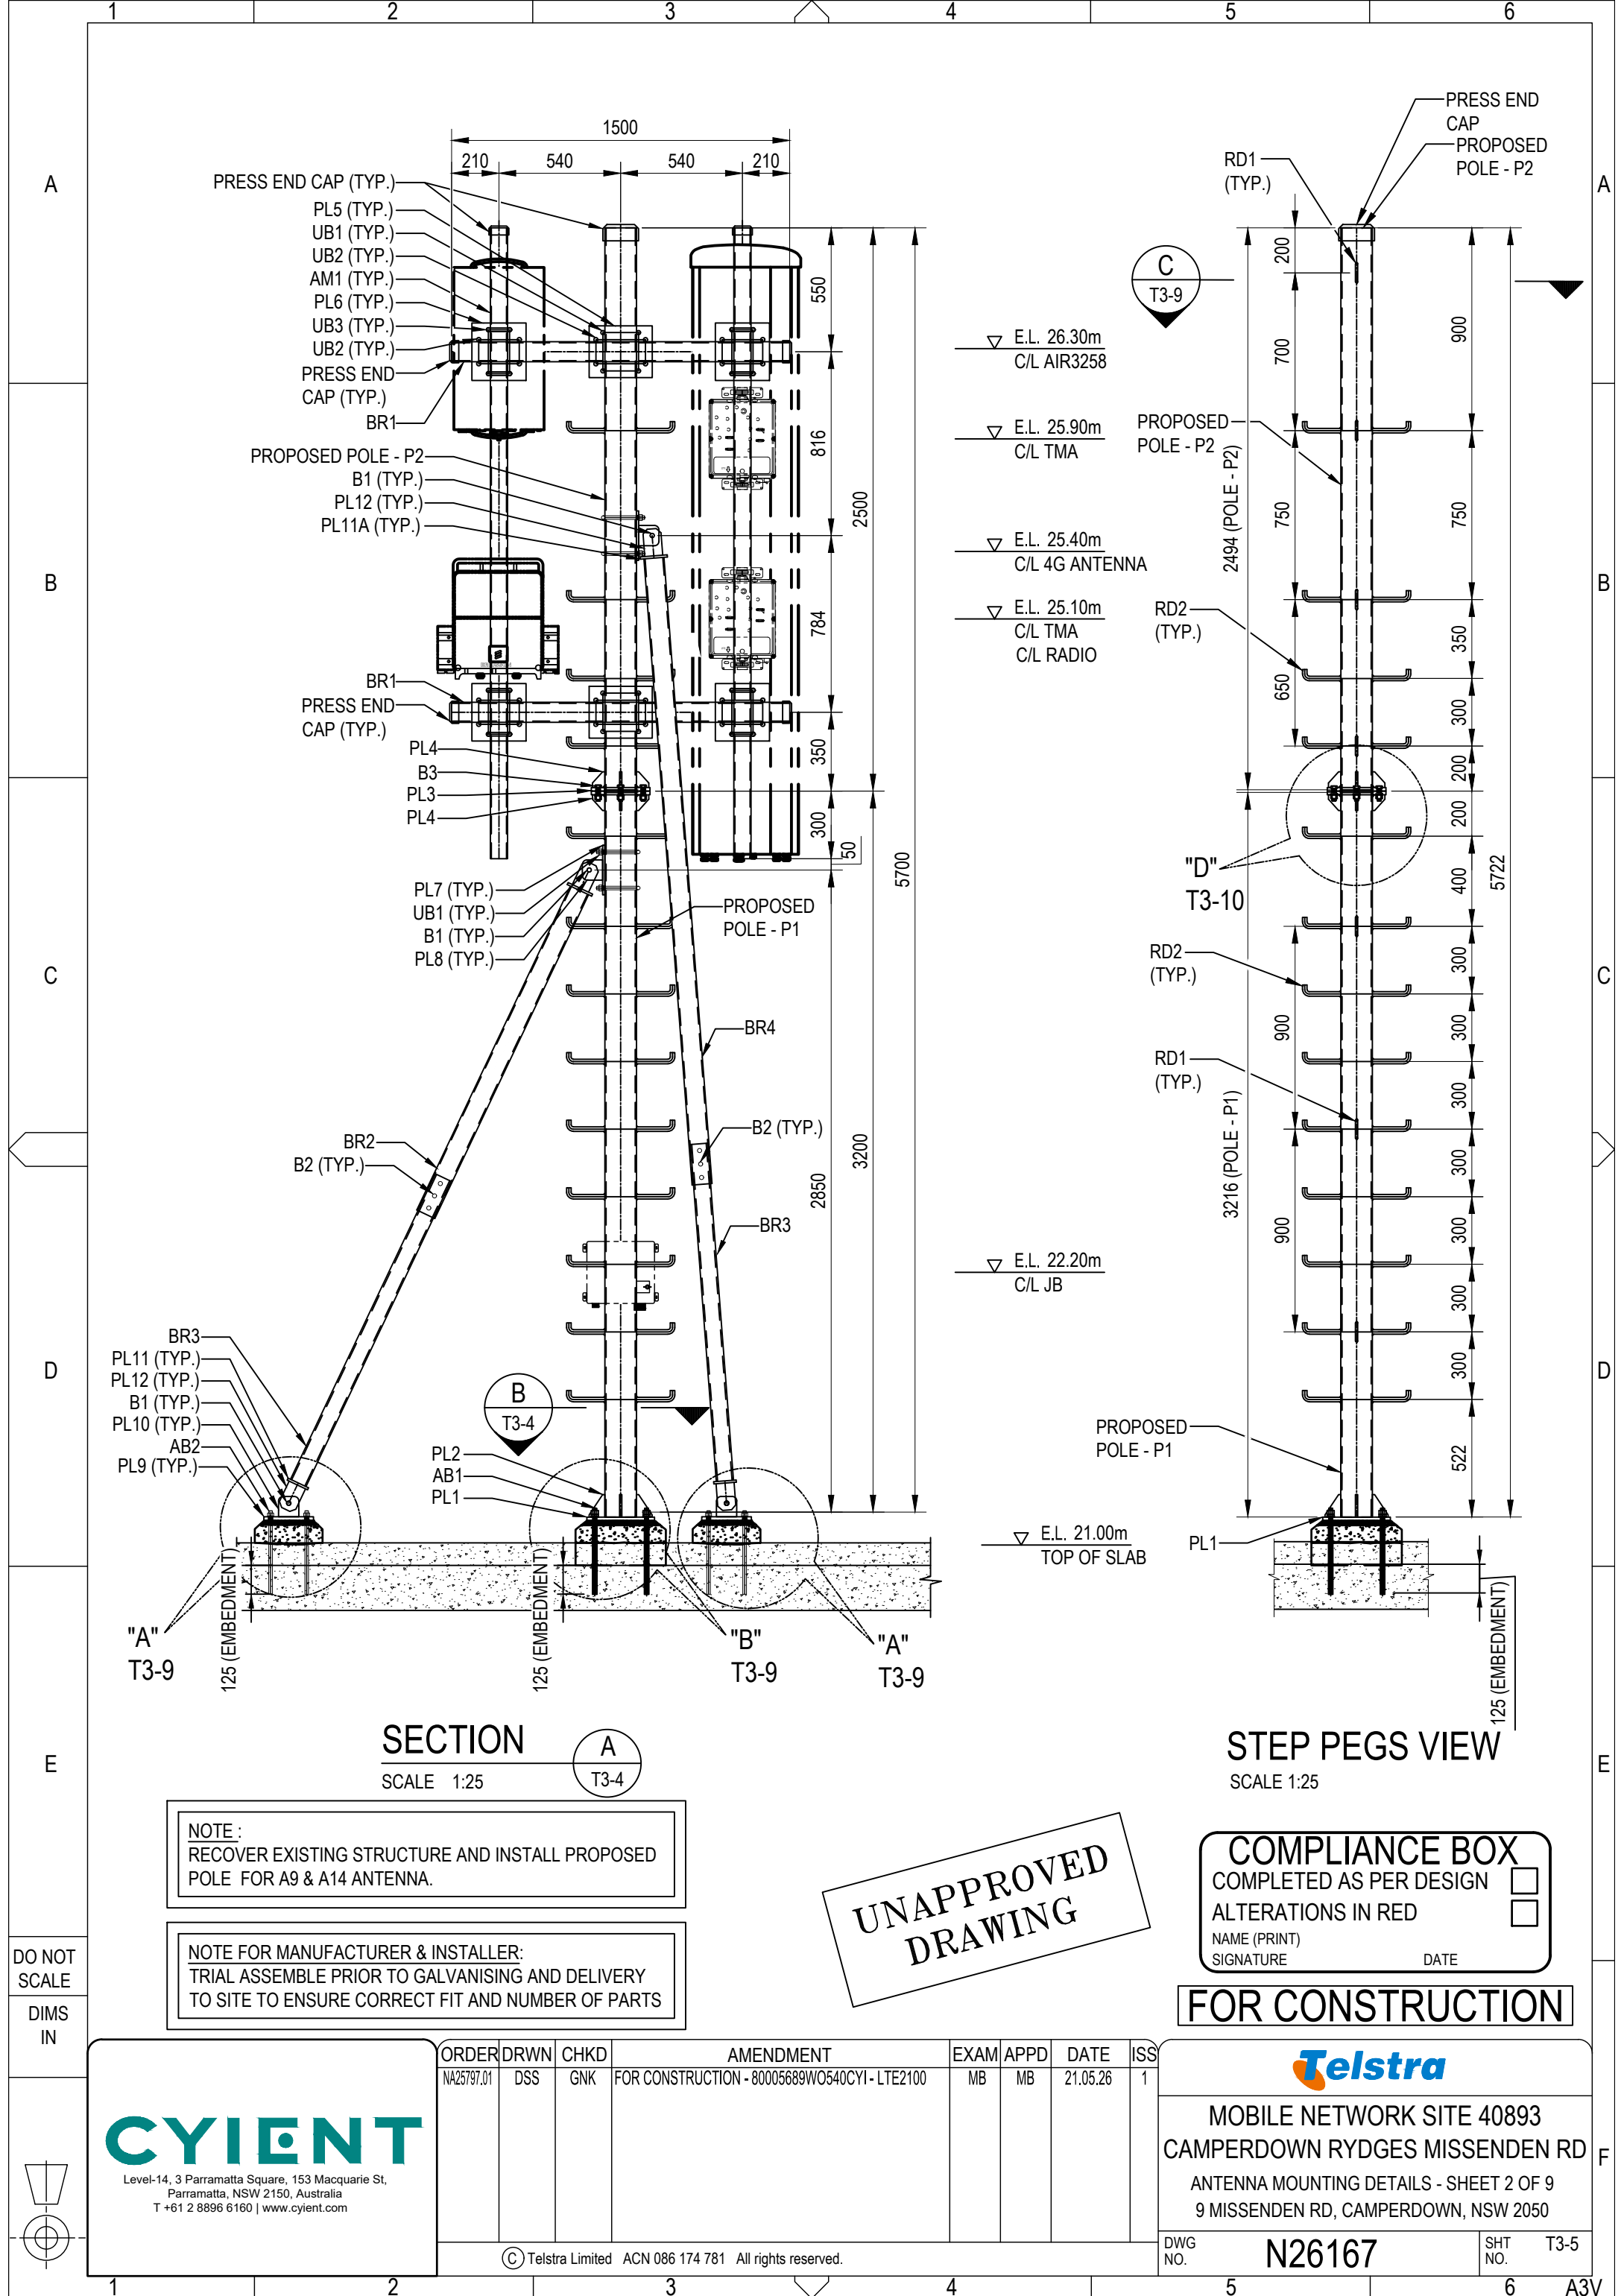

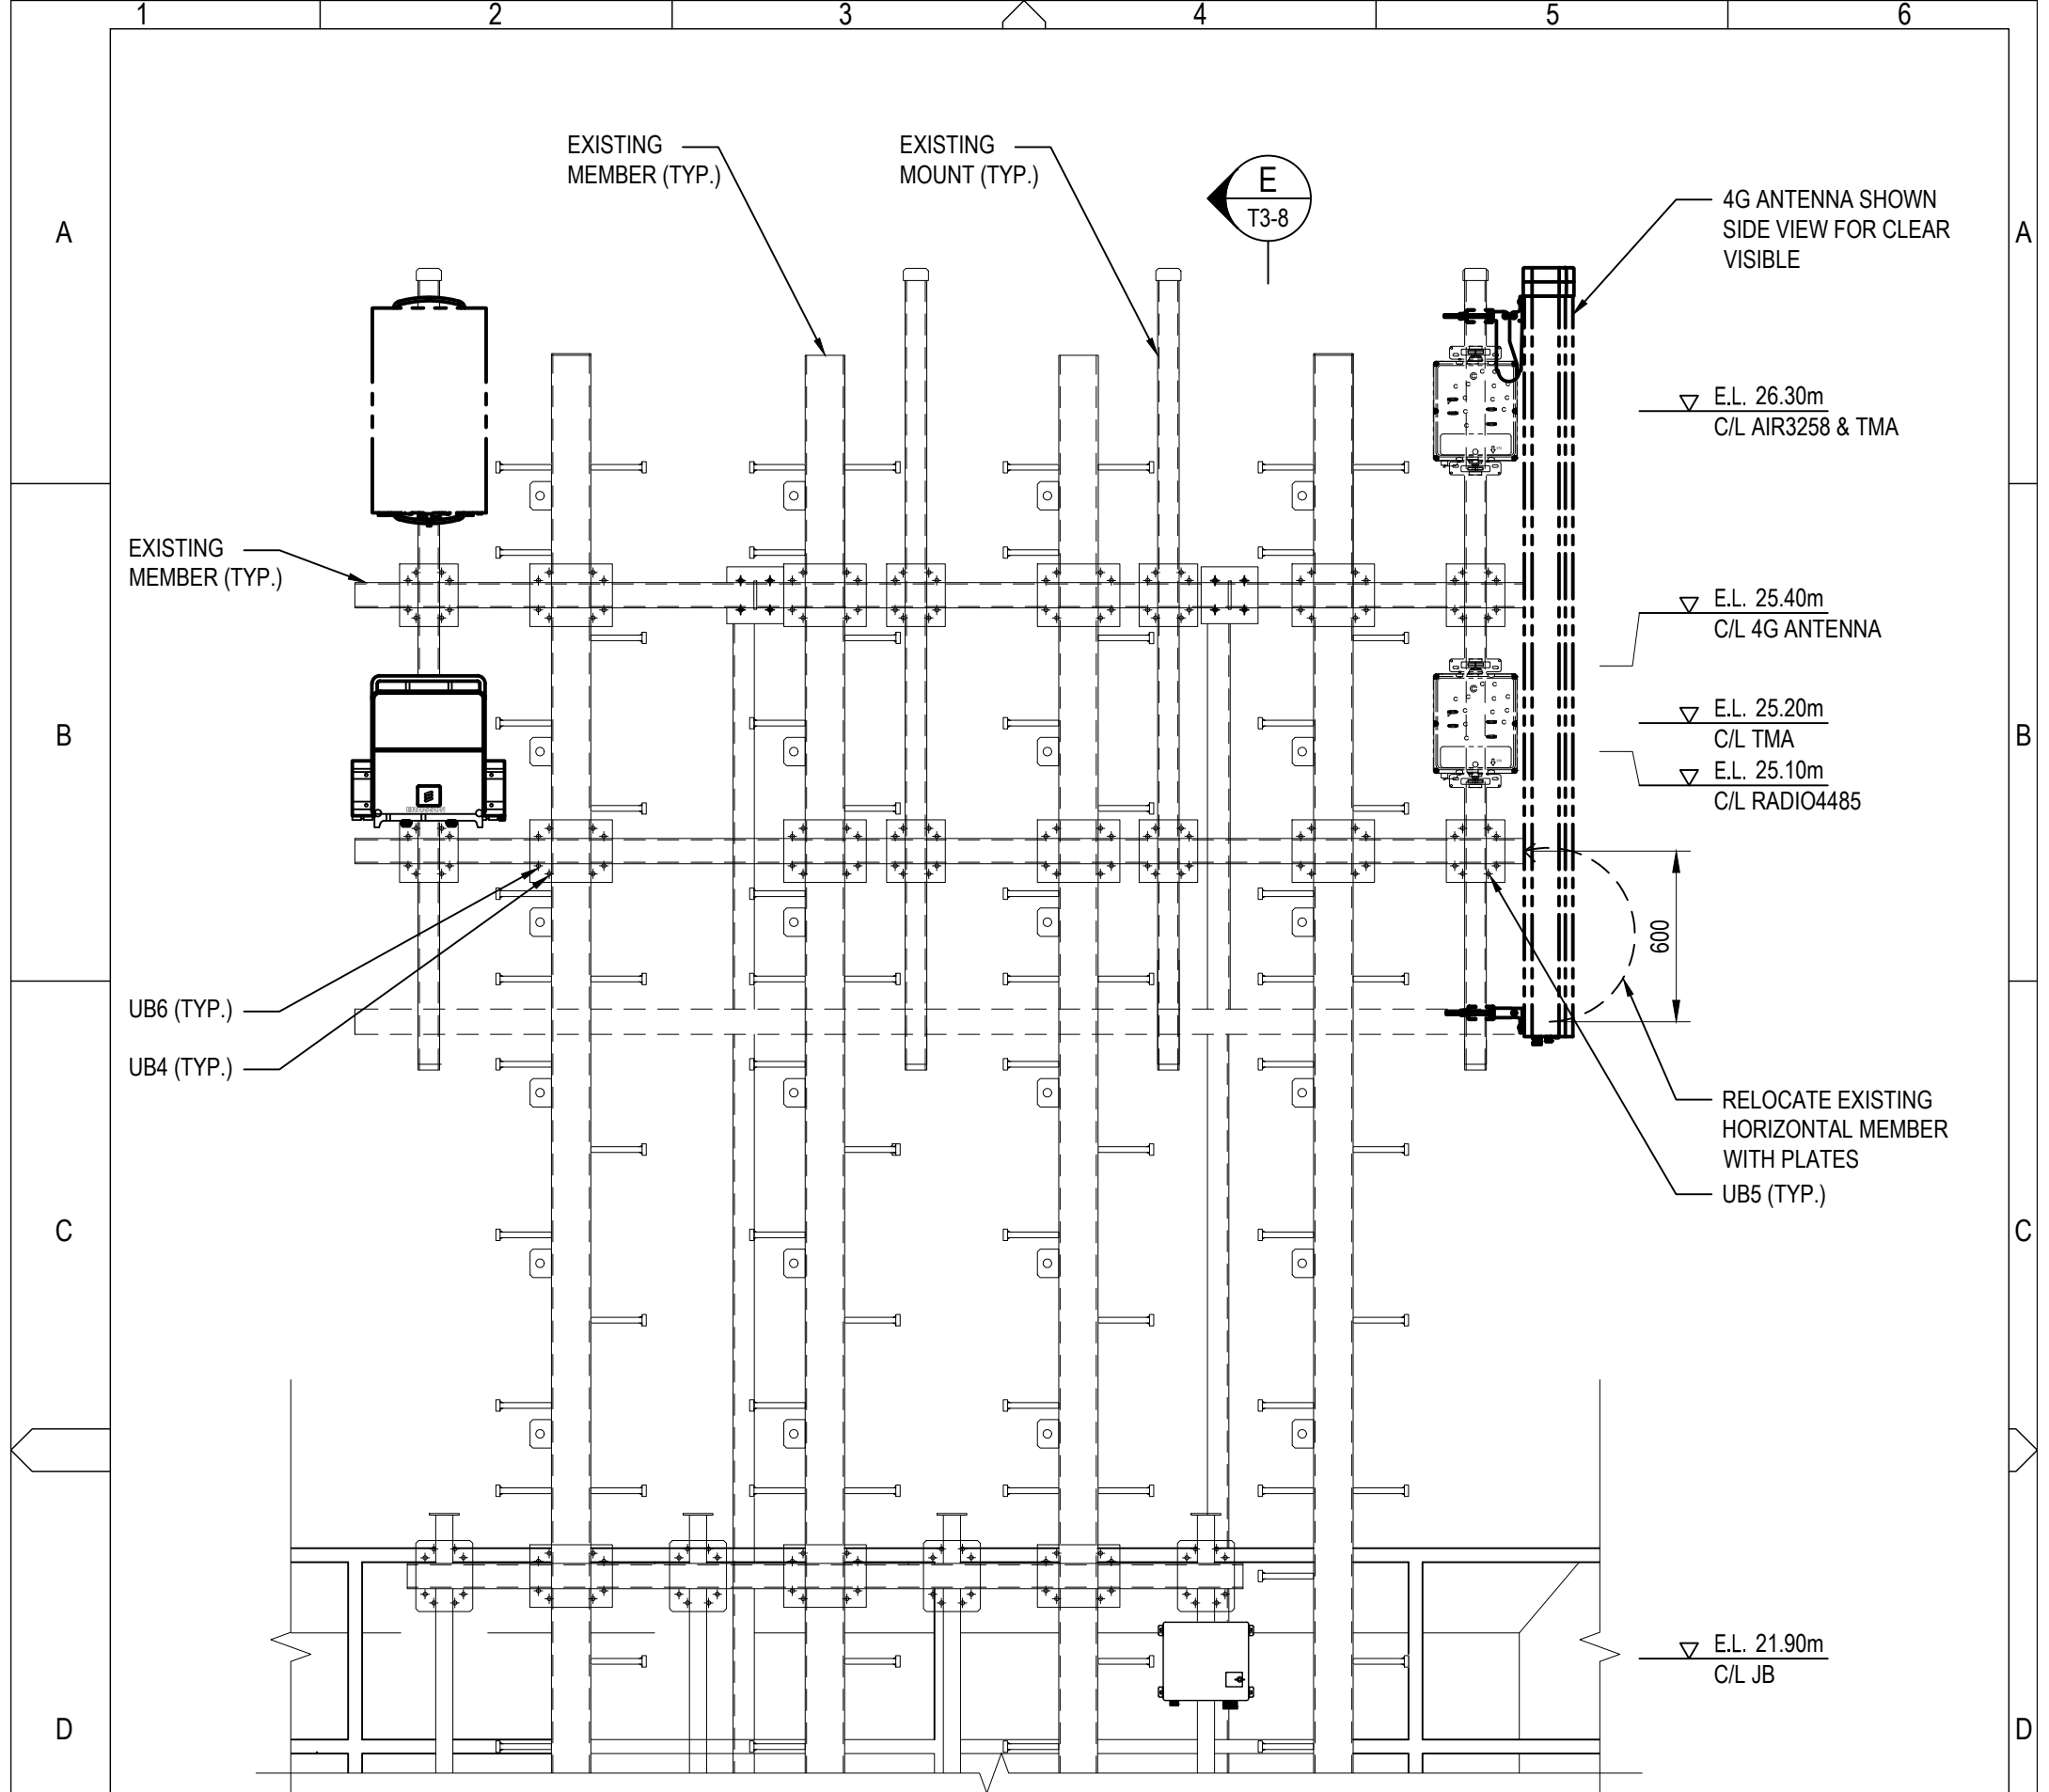

SECTOR - 1 ELEVATION
SCALE 1:25

NOTE FOR MANUFACTURER & INSTALLER:
TRIAL ASSEMBLE PRIOR TO GALVANISING AND DELIVERY
TO SITE TO ENSURE CORRECT FIT AND NUMBER OF PARTS

UNAPPROVED
DRAWING

COMPLIANCE BOX

COMPLETED AS PER DESIGN

ALTERATIONS IN RED

NAME (PRINT)


SIGNATURE

DATE

FOR CONSTRUCTION

DO NOT
SCALE

DIMS
IN

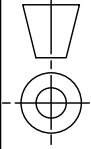

CYIENT
Level-14, 3 Parramatta Square, 153 Macquarie St,
Parramatta, NSW 2150, Australia
T +61 2 8896 6160 | www.cyient.com

ORDER	DRWN	CHKD	AMENDMENT	EXAM	APPD	DATE	ISS
NA25797.01	DSS	GNK	FOR CONSTRUCTION - 80005689WO540CYI - LTE2100	MB	MB	21.05.26	1


© Telstra Limited ACN 086 174 781 All rights reserved.



MOBILE NETWORK SITE 40893
CAMPERDOWN RYDGES MISSENDEN RD
ANTENNA MOUNTING DETAILS - SHEET 3 OF 9
9 MISSENDEN RD, CAMPERDOWN, NSW 2050

DWG NO. N26167

SHT NO. T3-6

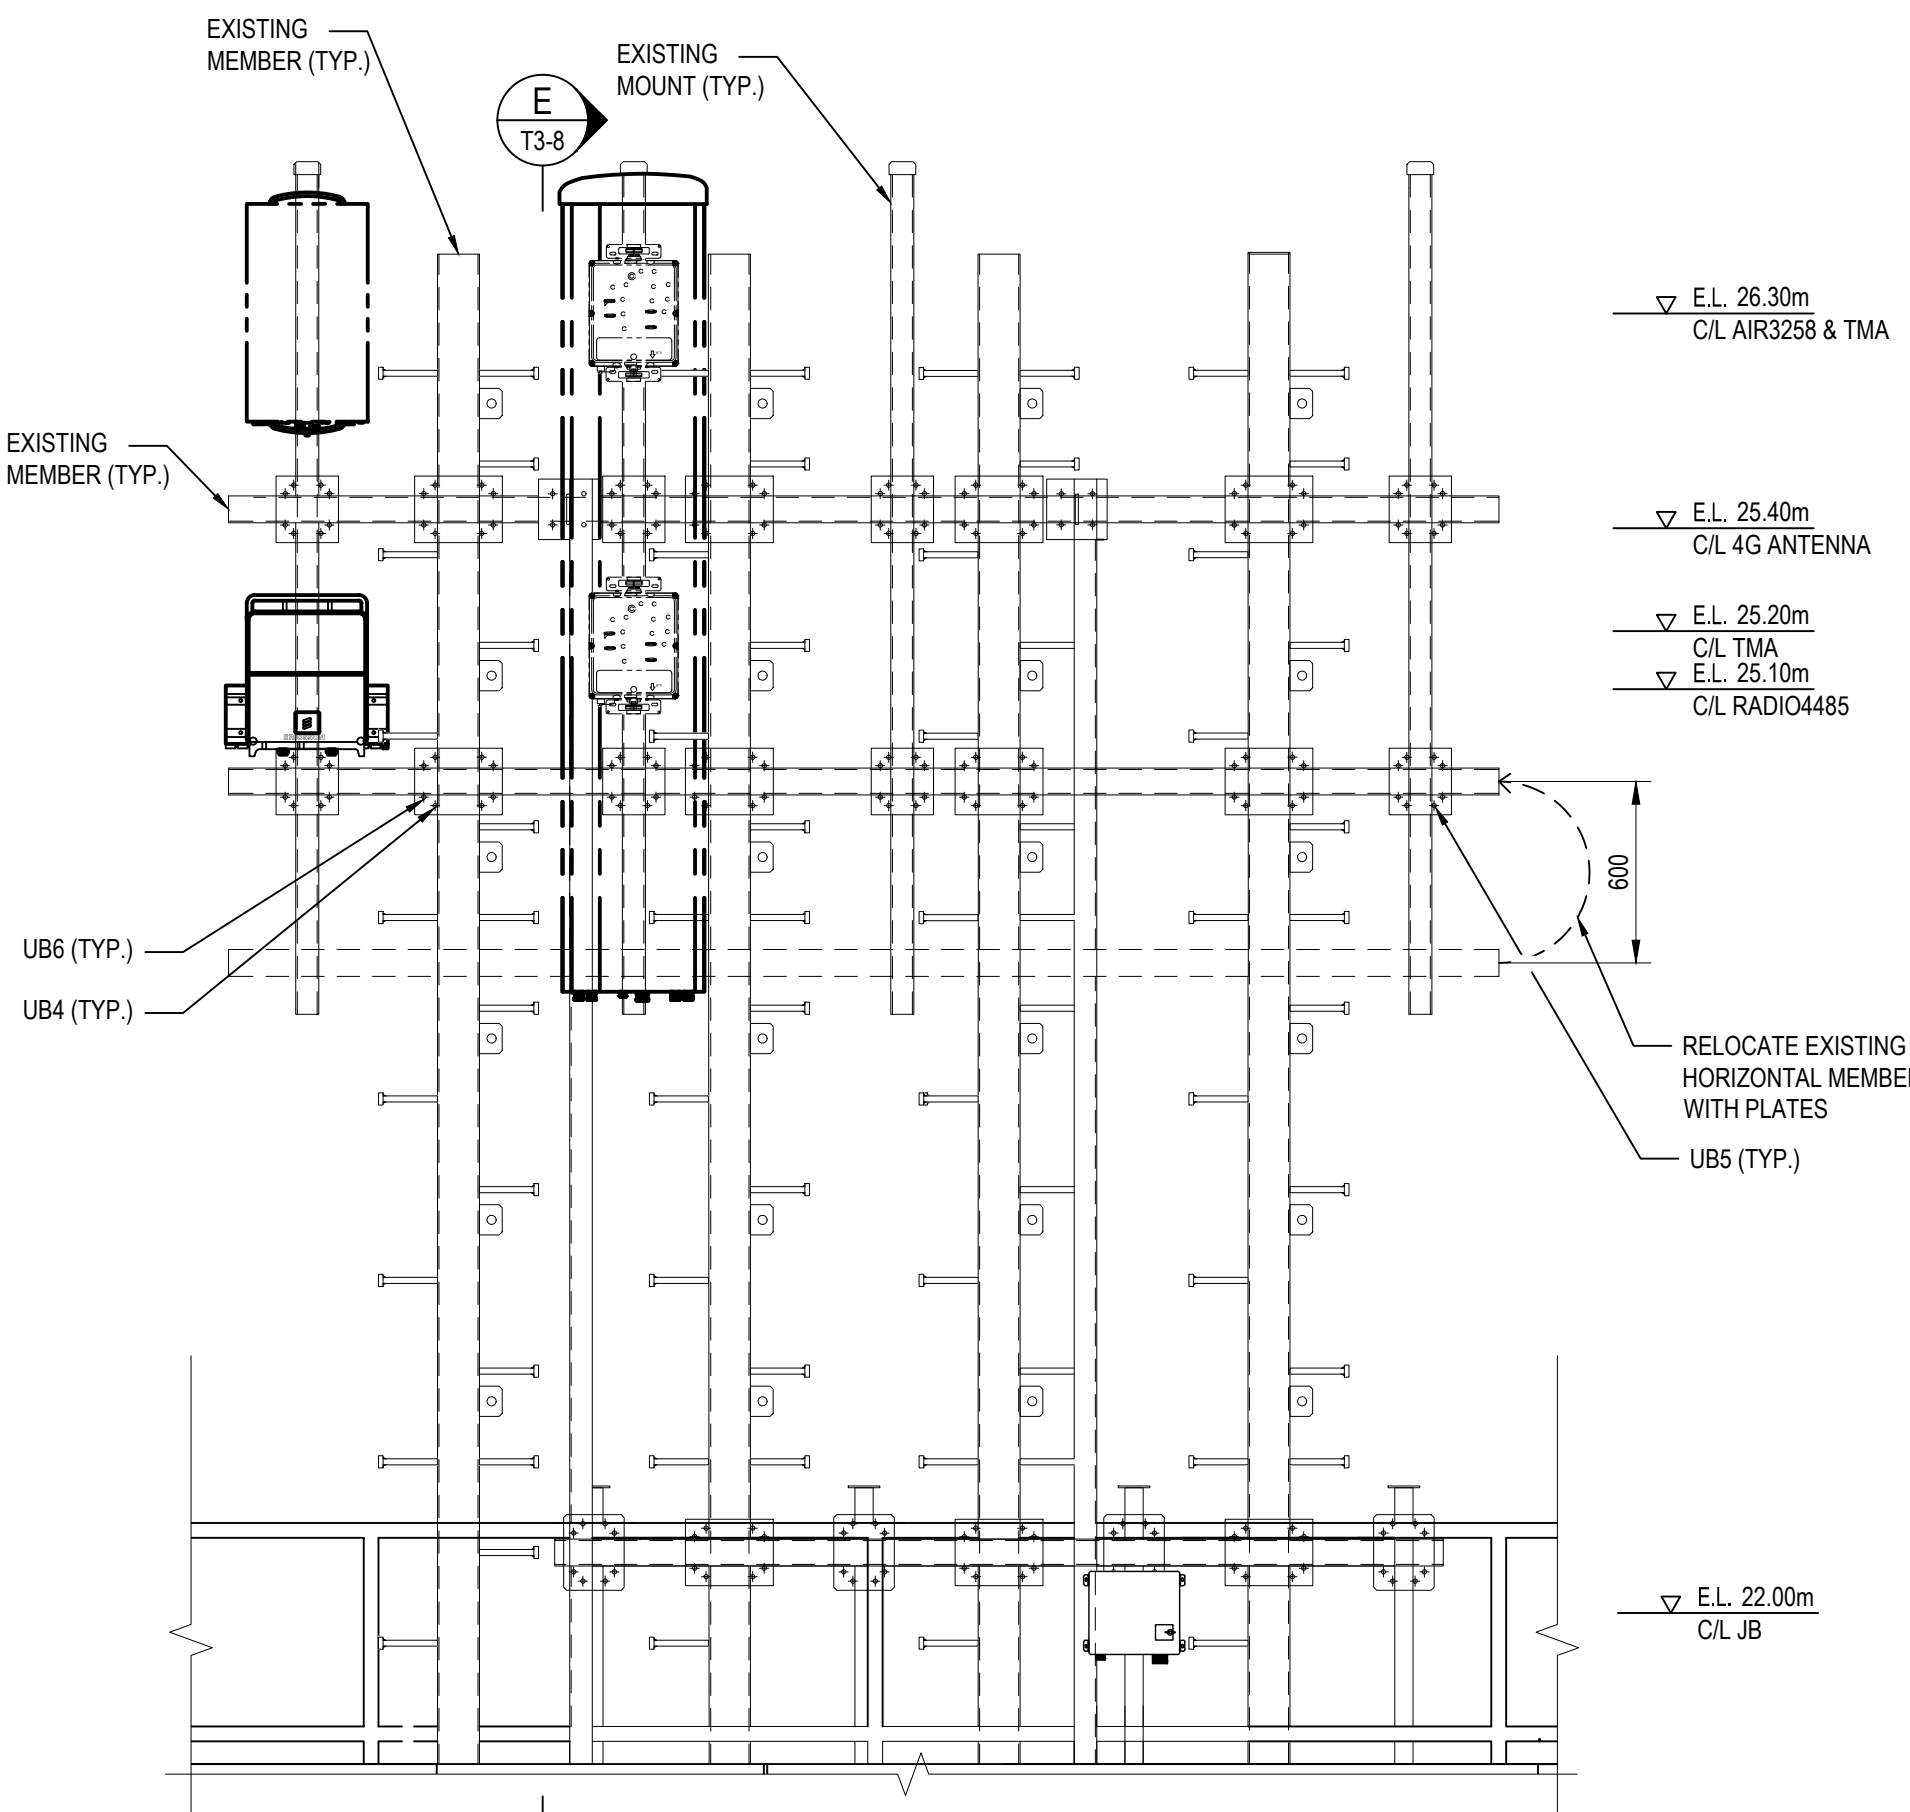

SECTOR - 3 ELEVATION
SCALE 1:25

NOTE FOR MANUFACTURER & INSTALLER:
TRIAL ASSEMBLE PRIOR TO GALVANISING AND DELIVERY
TO SITE TO ENSURE CORRECT FIT AND NUMBER OF PARTS

UNAPPROVED
DRAWING

COMPLIANCE BOX	
COMPLETED AS PER DESIGN	☐
ALTERATIONS IN RED	☐
NAME (PRINT)	
SIGNATURE	DATE

FOR CONSTRUCTION

CYIENT
Level-14, 3 Parramatta Square, 153 Macquarie St,
Parramatta, NSW 2150, Australia
T +61 2 8896 6160 | www.cyient.com


ORDER	DRWN	CHKD	AMENDMENT	EXAM	APPD	DATE	ISS
NA25797.01	DSS	GNK	FOR CONSTRUCTION - 80005689WO540CYI - LTE2100	MB	MB	21.05.26	1

© Telstra Limited ACN 086 174 781 All rights reserved.



MOBILE NETWORK SITE 40893
CAMPERDOWN RYDGES MISSENDEN RD
ANTENNA MOUNTING DETAILS - SHEET 4 OF 9
9 MISSENDEN RD, CAMPERDOWN, NSW 2050

DWG NO.	N26167	SHT NO.	T3-7
---------	--------	---------	------

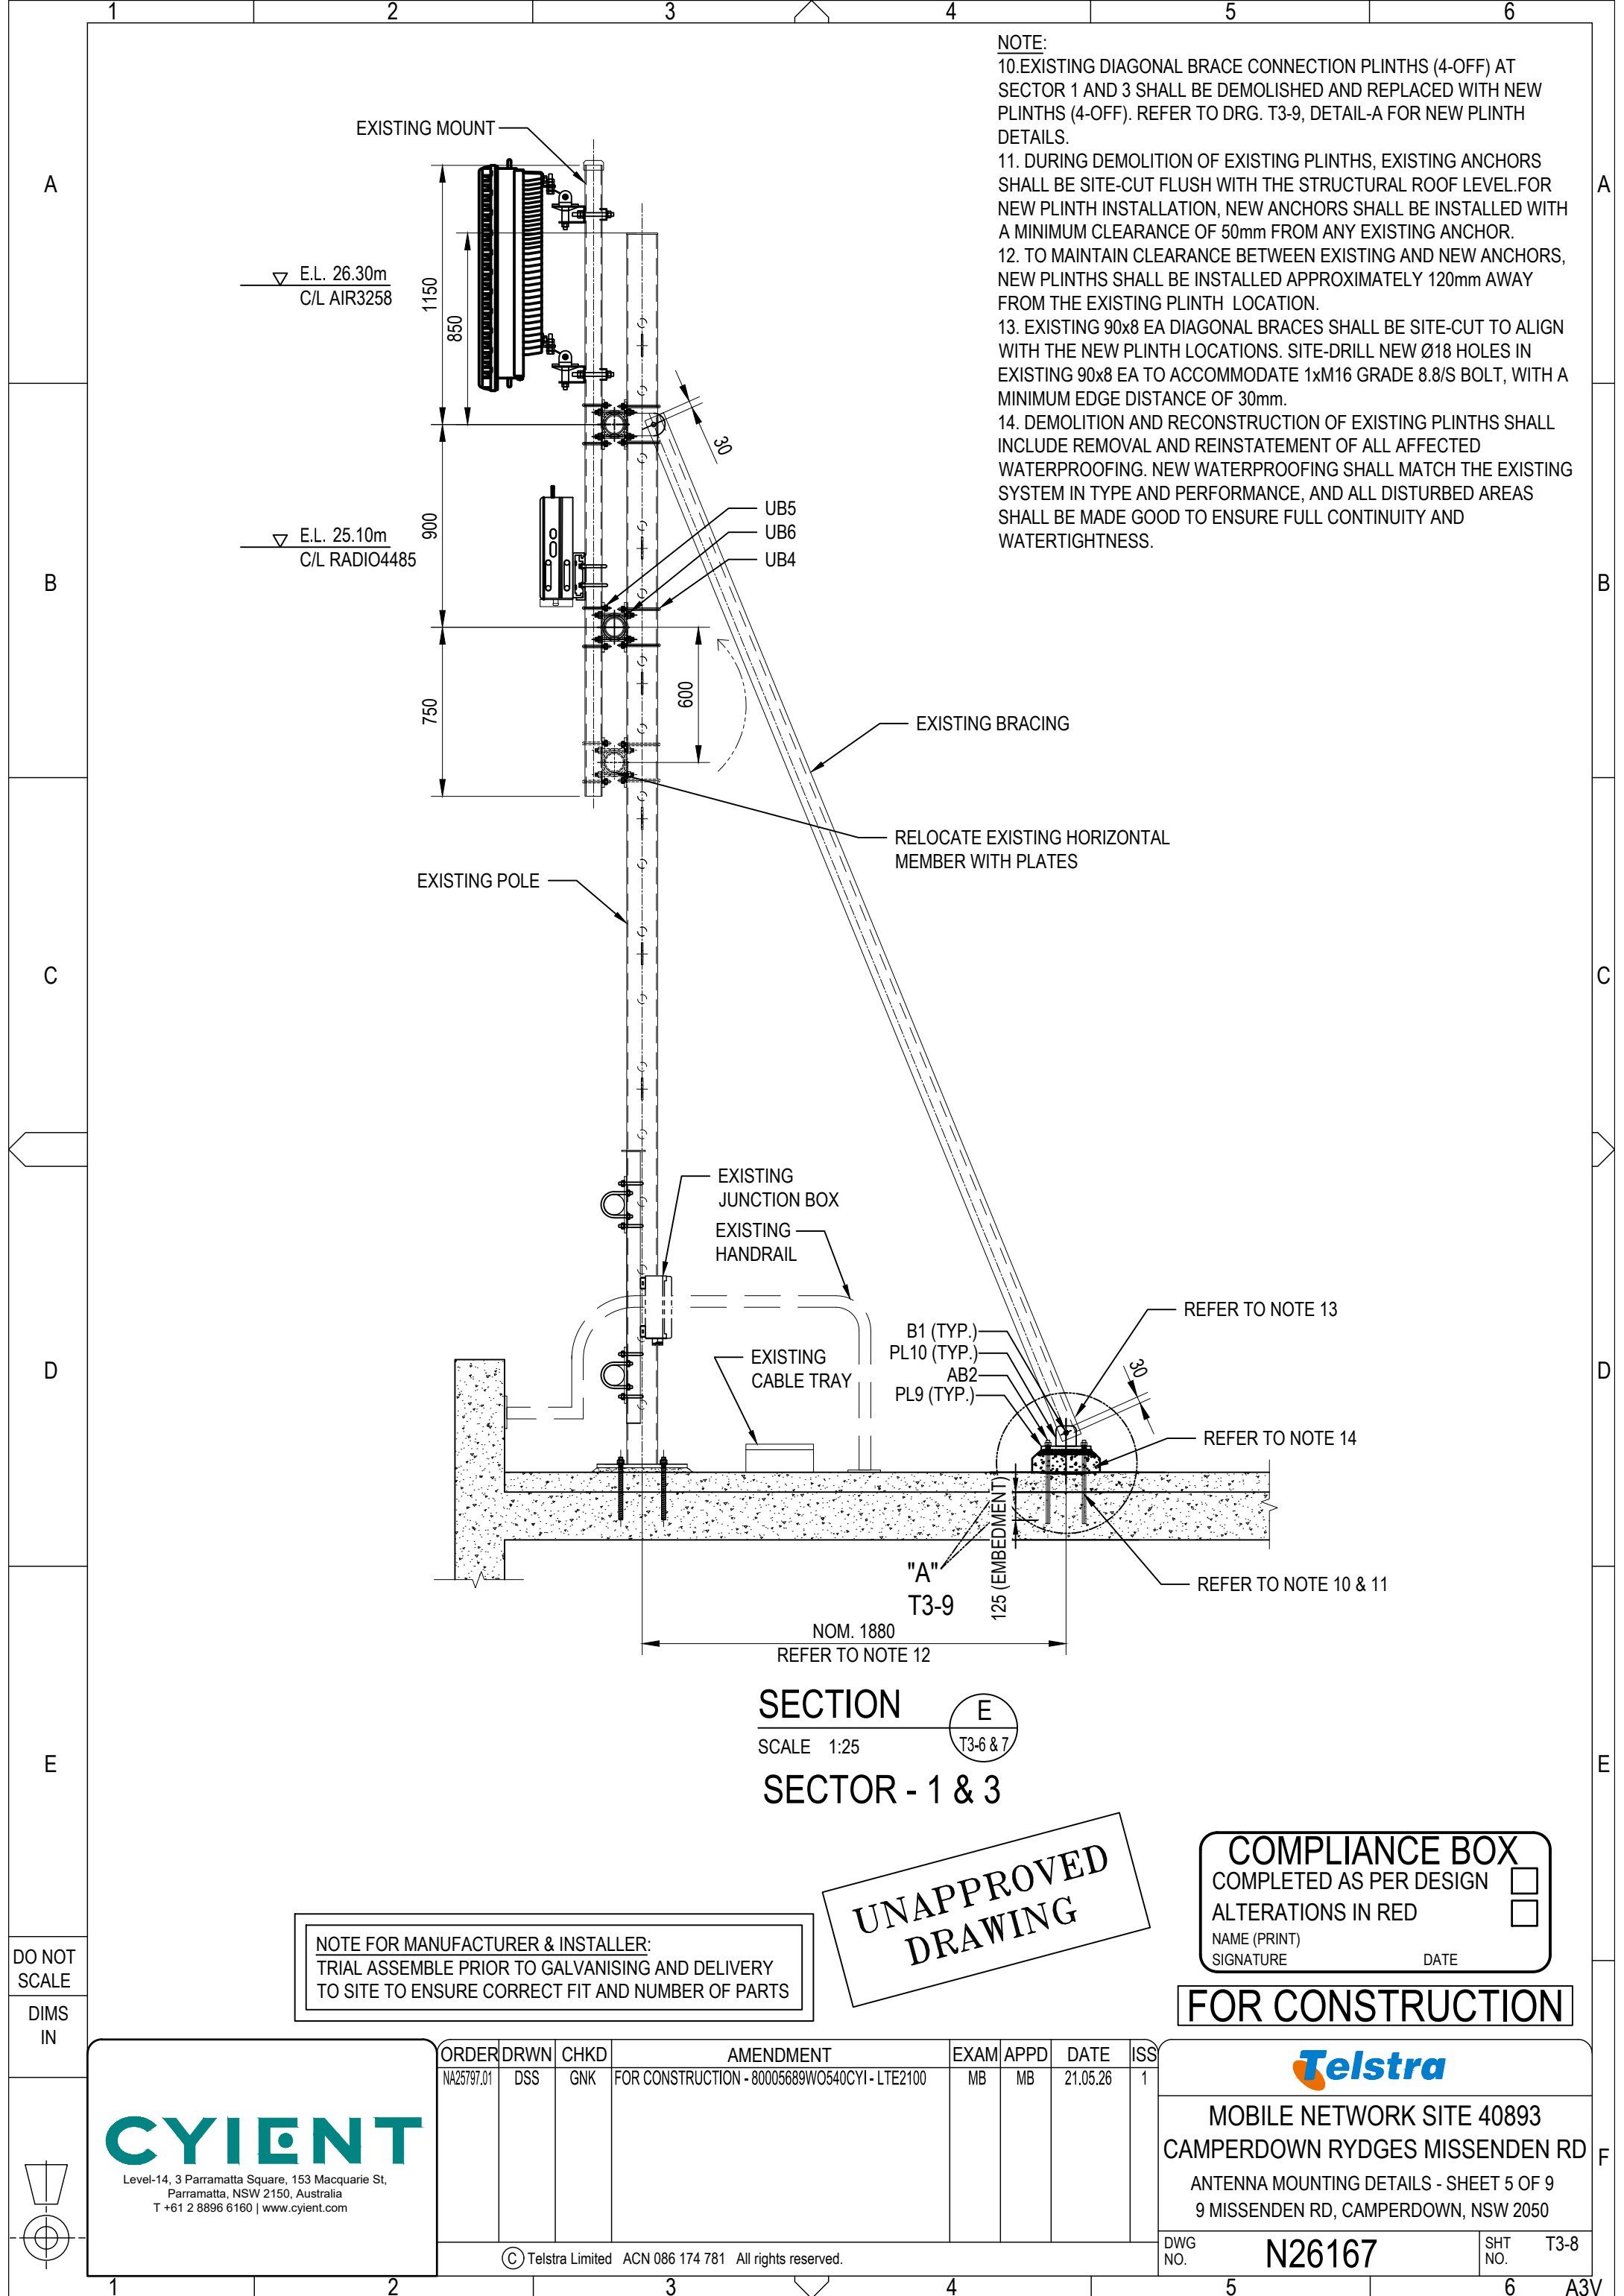

NOTE:
10. EXISTING DIAGONAL BRACE CONNECTION PLINTHS (4-OFF) AT SECTOR 1 AND 3 SHALL BE DEMOLISHED AND REPLACED WITH NEW PLINTHS (4-OFF). REFER TO DRG. T3-9, DETAIL-A FOR NEW PLINTH DETAILS.
11. DURING DEMOLITION OF EXISTING PLINTHS, EXISTING ANCHORS SHALL BE SITE-CUT FLUSH WITH THE STRUCTURAL ROOF LEVEL. FOR NEW PLINTH INSTALLATION, NEW ANCHORS SHALL BE INSTALLED WITH A MINIMUM CLEARANCE OF 50mm FROM ANY EXISTING ANCHOR.
12. TO MAINTAIN CLEARANCE BETWEEN EXISTING AND NEW ANCHORS, NEW PLINTHS SHALL BE INSTALLED APPROXIMATELY 120mm AWAY FROM THE EXISTING PLINTH LOCATION.
13. EXISTING 90x8 EA DIAGONAL BRACES SHALL BE SITE-CUT TO ALIGN WITH THE NEW PLINTH LOCATIONS. SITE-DRILL NEW Ø18 HOLES IN EXISTING 90x8 EA TO ACCOMMODATE 1xM16 GRADE 8.8/S BOLT, WITH A MINIMUM EDGE DISTANCE OF 30mm.
14. DEMOLITION AND RECONSTRUCTION OF EXISTING PLINTHS SHALL INCLUDE REMOVAL AND REINSTATEMENT OF ALL AFFECTED WATERPROOFING. NEW WATERPROOFING SHALL MATCH THE EXISTING SYSTEM IN TYPE AND PERFORMANCE, AND ALL DISTURBED AREAS SHALL BE MADE GOOD TO ENSURE FULL CONTINUITY AND WATERTIGHTNESS.

SECTION E
SCALE 1:25
T3-6 & 7
SECTOR - 1 & 3

NOTE FOR MANUFACTURER & INSTALLER:
TRIAL ASSEMBLE PRIOR TO GALVANISING AND DELIVERY TO SITE TO ENSURE CORRECT FIT AND NUMBER OF PARTS

UNAPPROVED
DRAWING

COMPLIANCE BOX	
COMPLETED AS PER DESIGN	☐
ALTERATIONS IN RED	☐
NAME (PRINT)	
SIGNATURE	DATE

FOR CONSTRUCTION








MOBILE NETWORK SITE 40893
CAMPERDOWN RYDGES MISSENDEN RD
ANTENNA MOUNTING DETAILS - SHEET 5 OF 9
9 MISSENDEN RD, CAMPERDOWN, NSW 2050

DWG NO.	N26167	SHT NO.	T3-8
---------	--------	---------	------

CYIENT
Level-14, 3 Parramatta Square, 153 Macquarie St,
Parramatta, NSW 2150, Australia
T +61 2 8896 6160 | www.cyient.com

© Telstra Limited ACN 086 174 781 All rights reserved.

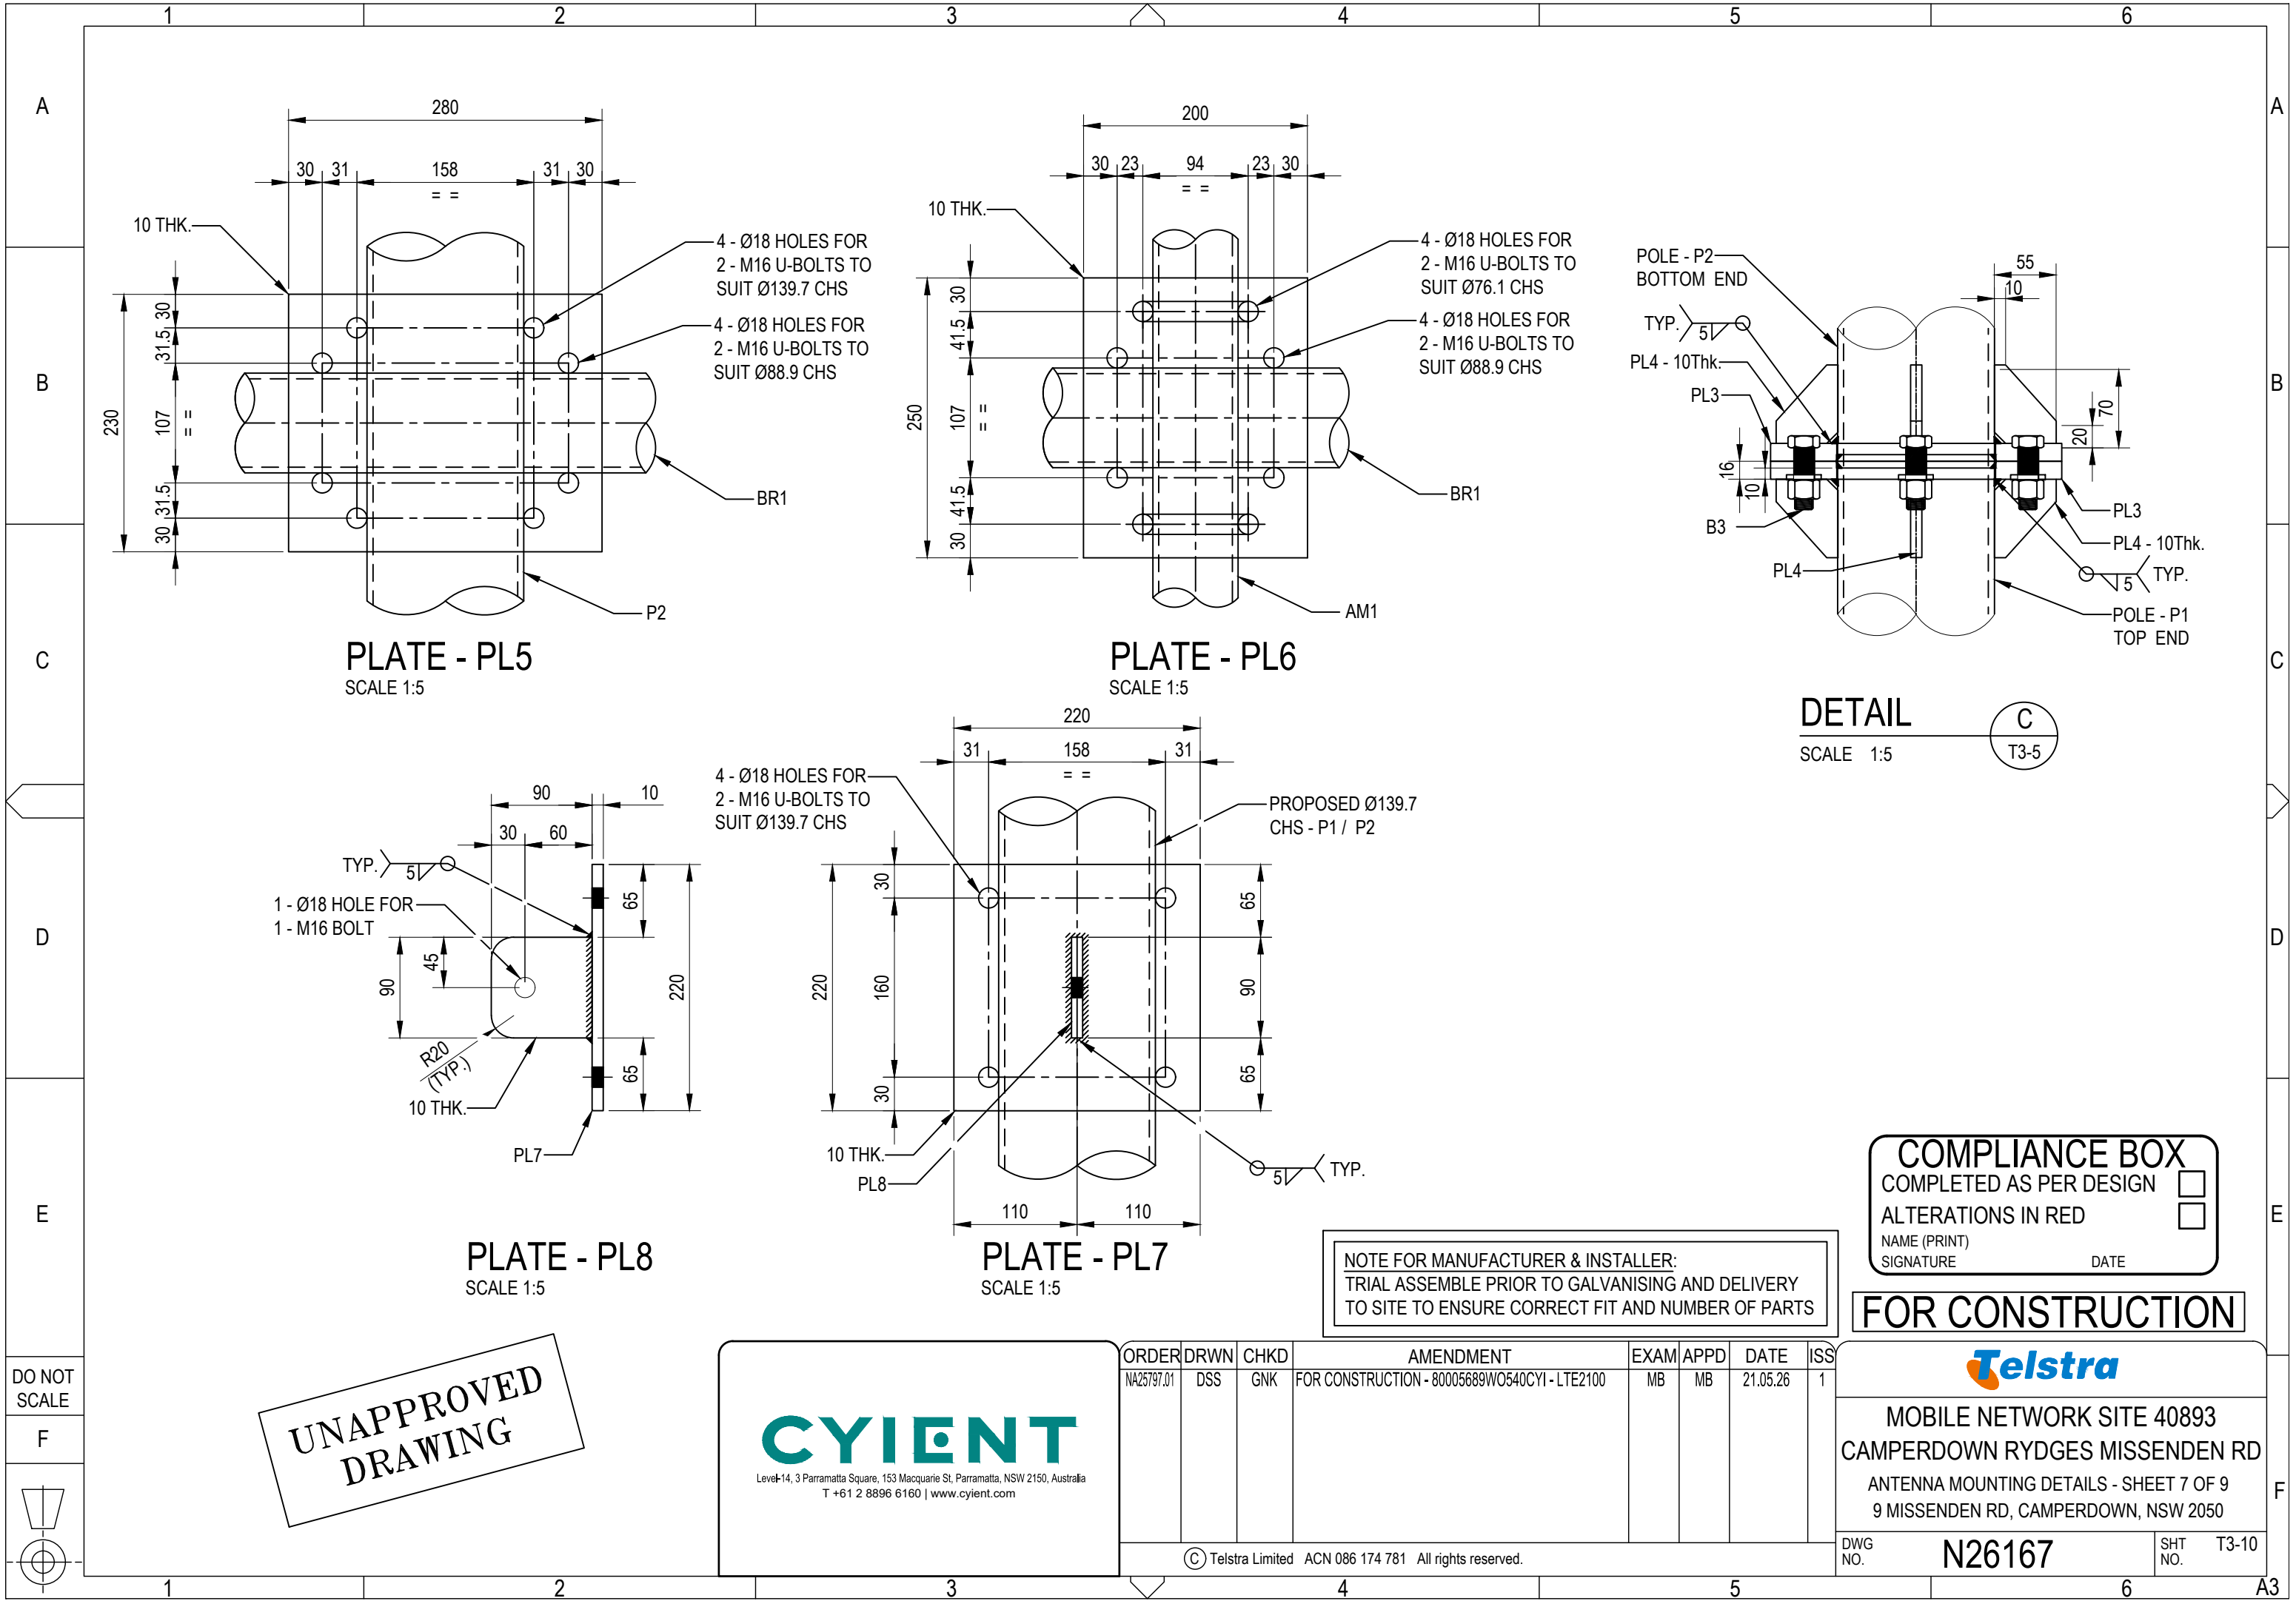

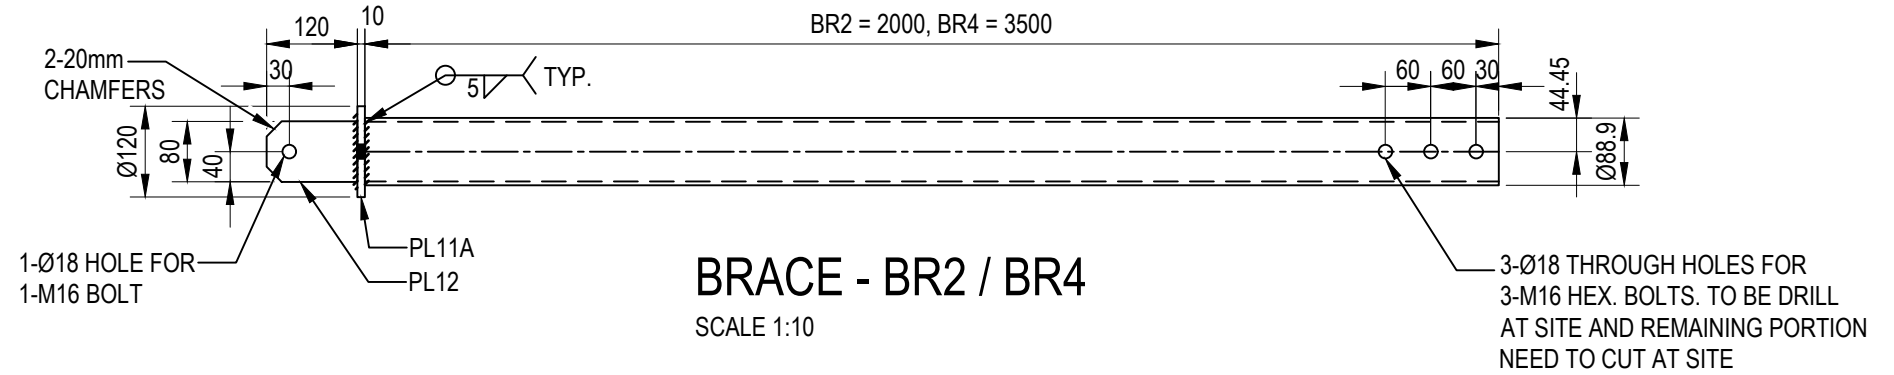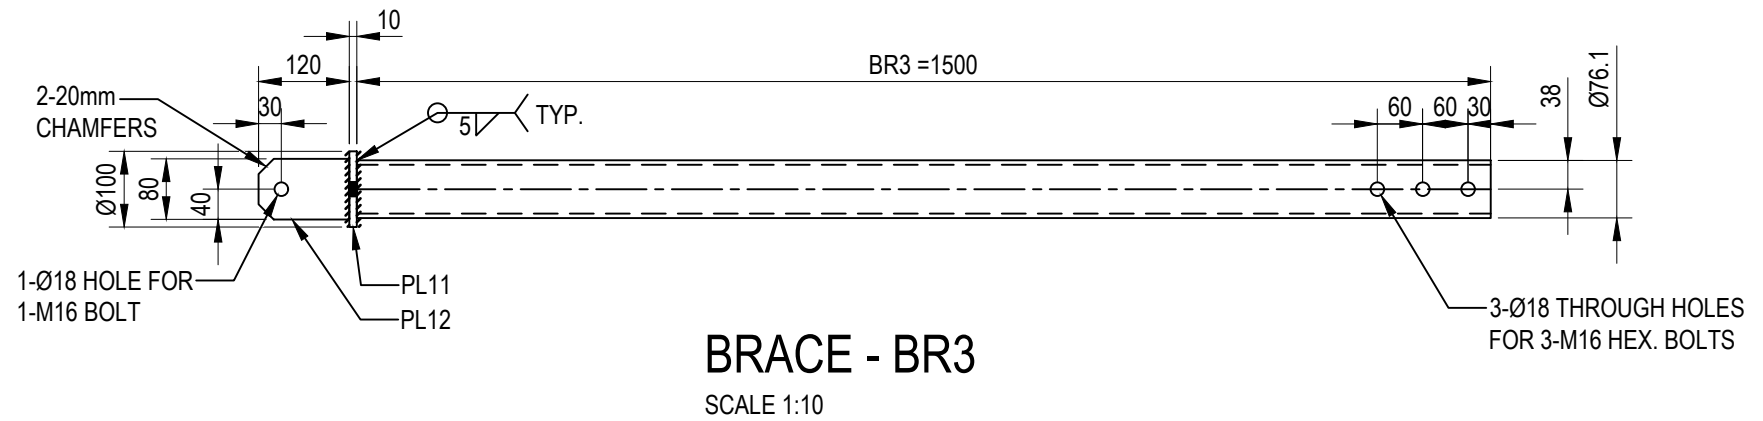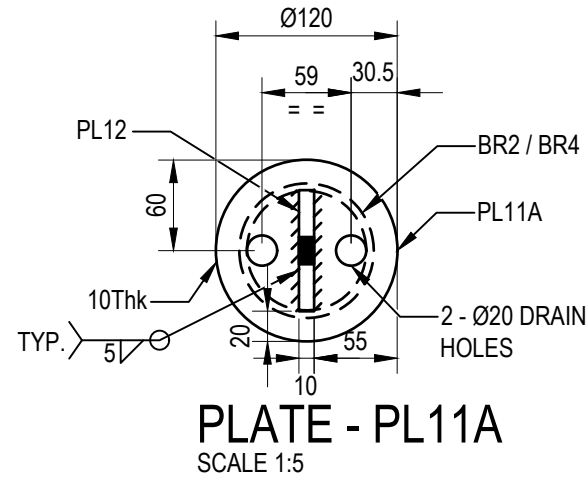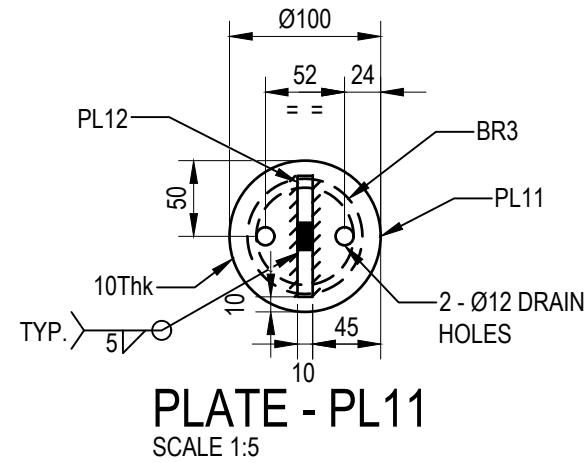

NOTE: THROUGH HOLES TO BE DRILLED AT SITE AFTER TRIMMING THE EXTRA END LENGTH FOR BR2 & BR4

COMPLIANCE BOX
COMPLETED AS PER DESIGN ☐
ALTERATIONS IN RED ☐
NAME (PRINT) _____
SIGNATURE _____ DATE _____

NOTE FOR MANUFACTURER & INSTALLER:
TRIAL ASSEMBLE PRIOR TO GALVANISING AND DELIVERY
TO SITE TO ENSURE CORRECT FIT AND NUMBER OF PARTS

FOR CONSTRUCTION

**UNAPPROVED
DRAWING**

CYIENT
Level 14, 3 Parramatta Square, 153 Macquarie St, Parramatta, NSW 2150, Australia
T +61 2 8896 6160 | www.cyient.com


ORDER	DRWN	CHKD	AMENDMENT	EXAM	APPD	DATE	ISS
NA25797.01	DSS	GNK	FOR CONSTRUCTION - 80005689WQ540CYI - LTE2100	MB	MB	21.05.26	1


© Telstra Limited ACN 086 174 781 All rights reserved.

Telstra
MOBILE NETWORK SITE 40893
CAMPERDOWN RYDGES MISSENDEN RD
ANTENNA MOUNTING DETAILS - SHEET 8 OF 9
9 MISSENDEN RD, CAMPERDOWN, NSW 2050
DWG NO. **N26167** SHT NO. T3-11

DO NOT
SCALE

F

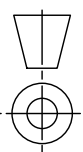

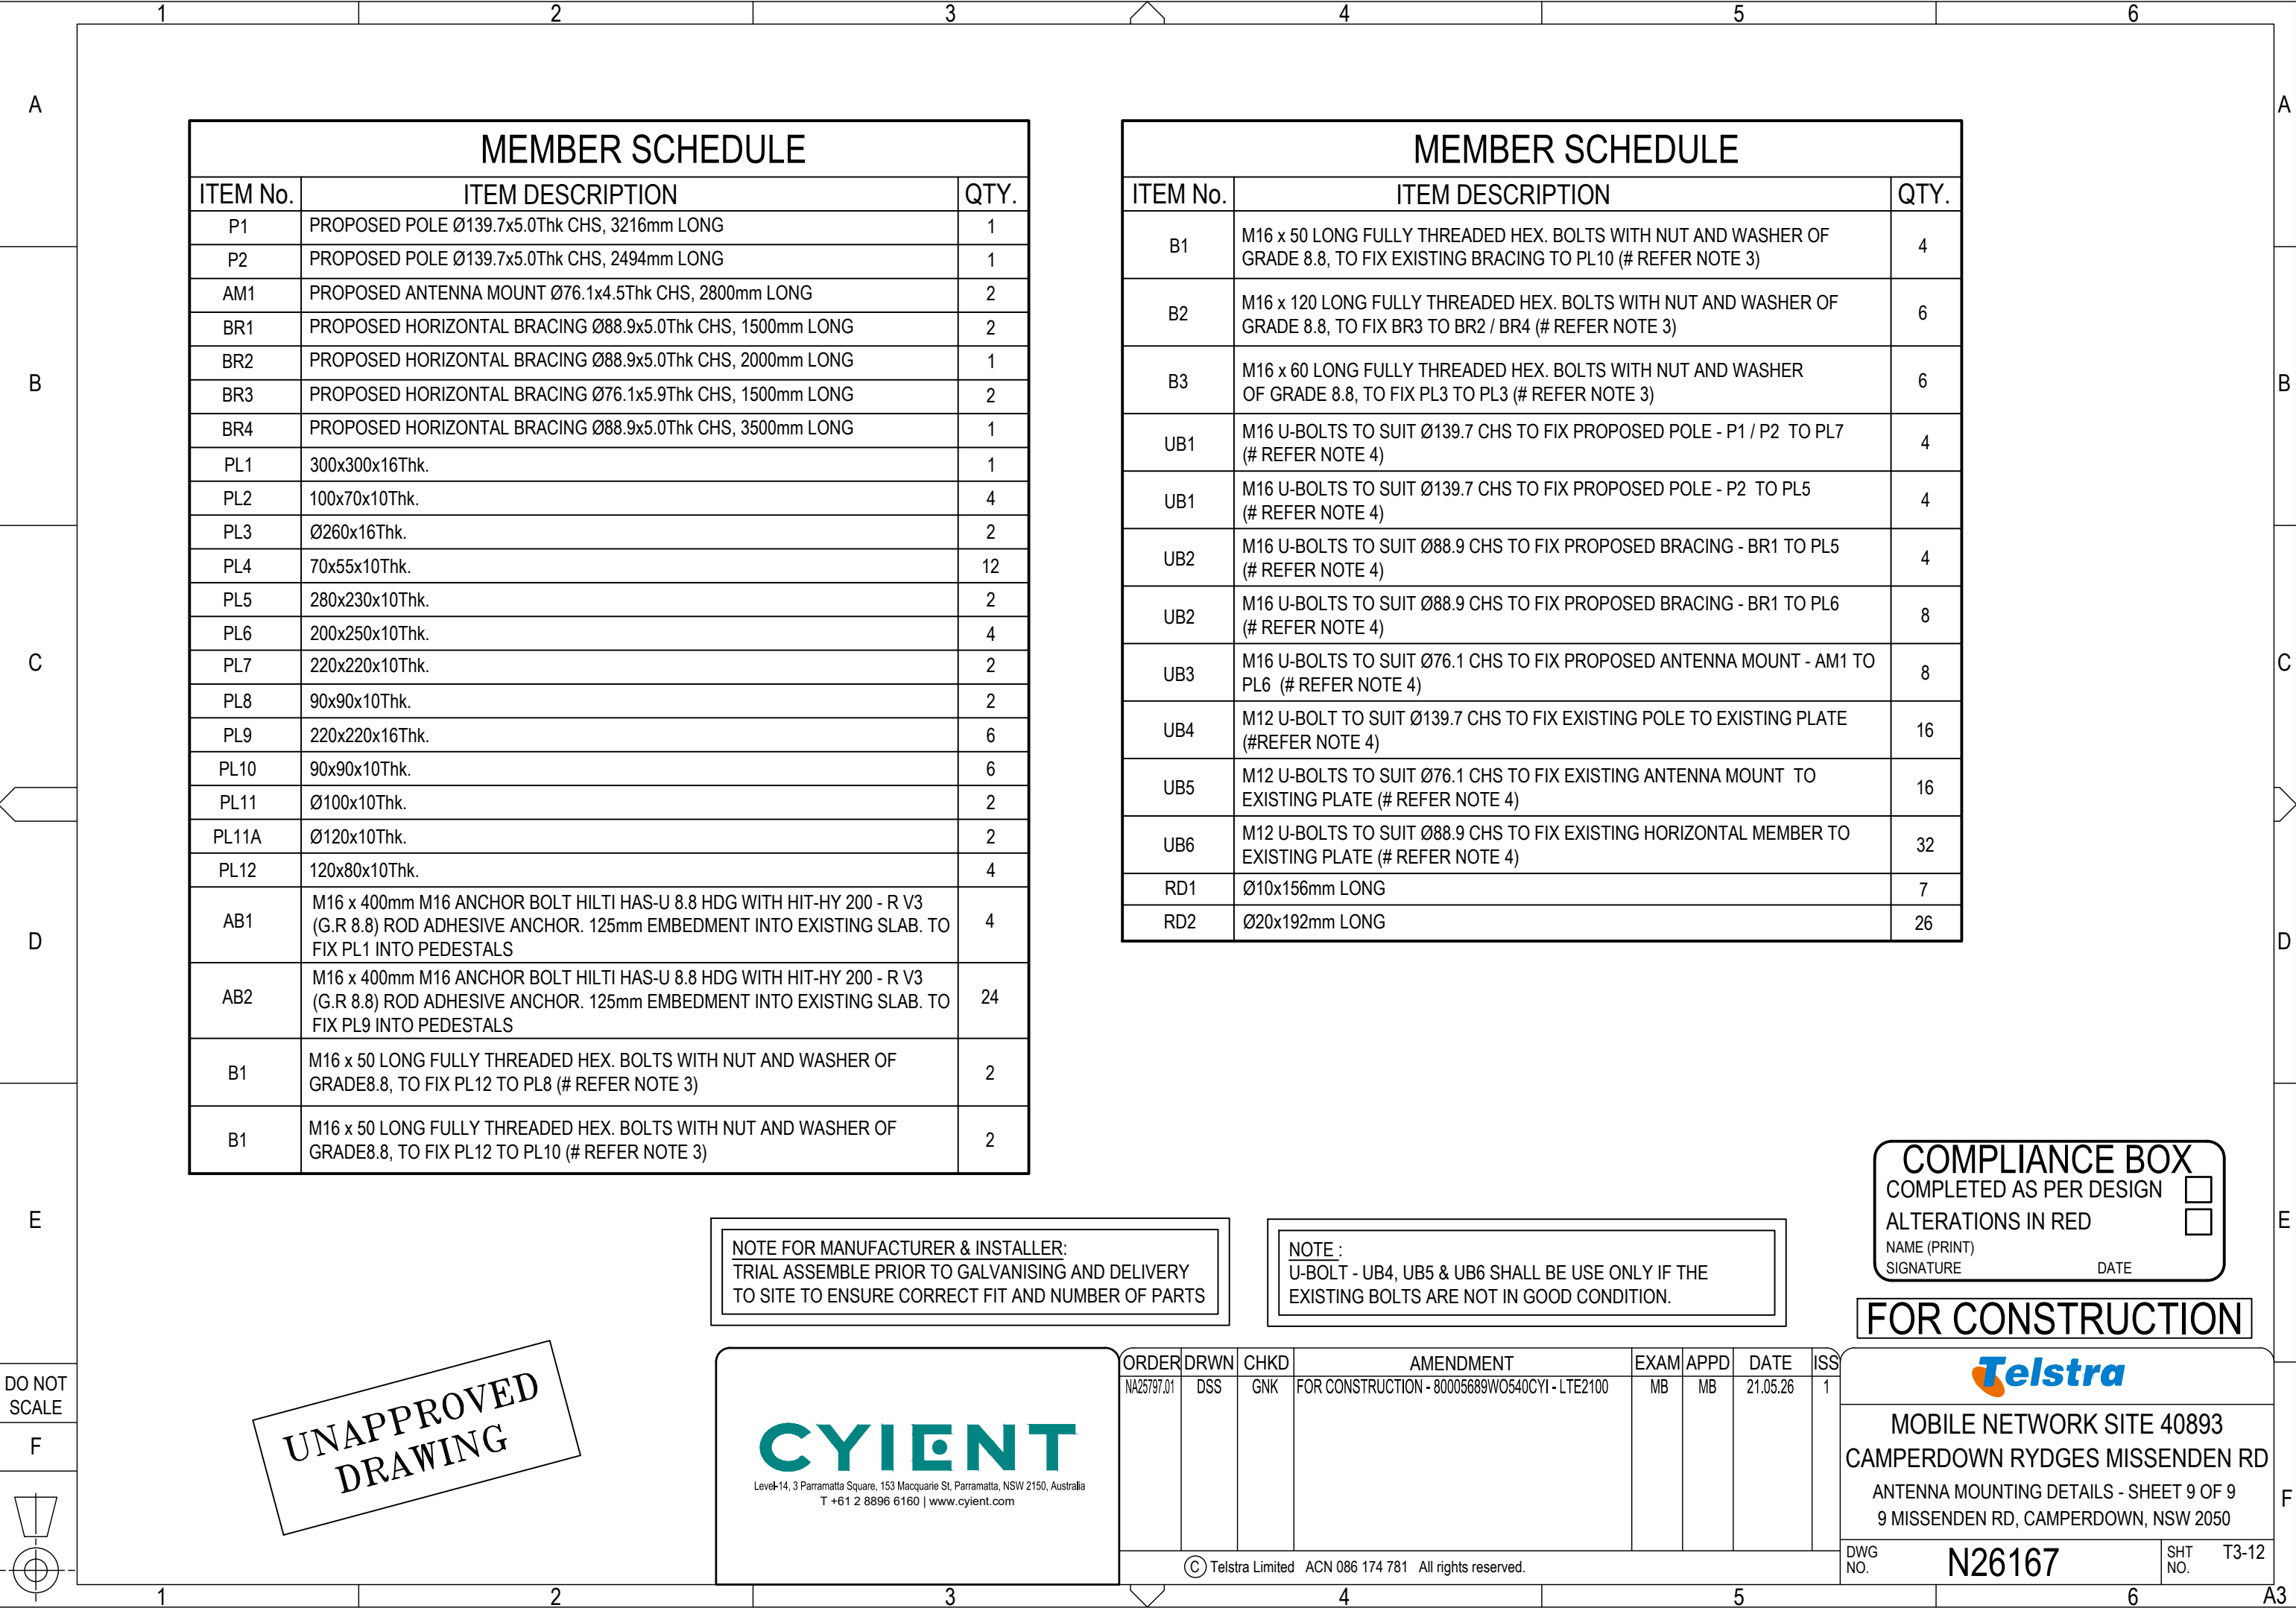

MEMBER SCHEDULE		
ITEM No.	ITEM DESCRIPTION	QTY.
P1	PROPOSED POLE Ø139.7x5.0Thk CHS, 3216mm LONG	1
P2	PROPOSED POLE Ø139.7x5.0Thk CHS, 2494mm LONG	1
AM1	PROPOSED ANTENNA MOUNT Ø76.1x4.5Thk CHS, 2800mm LONG	2
BR1	PROPOSED HORIZONTAL BRACING Ø88.9x5.0Thk CHS, 1500mm LONG	2
BR2	PROPOSED HORIZONTAL BRACING Ø88.9x5.0Thk CHS, 2000mm LONG	1
BR3	PROPOSED HORIZONTAL BRACING Ø76.1x5.9Thk CHS, 1500mm LONG	2
BR4	PROPOSED HORIZONTAL BRACING Ø88.9x5.0Thk CHS, 3500mm LONG	1
PL1	300x300x16Thk.	1
PL2	100x70x10Thk.	4
PL3	Ø260x16Thk.	2
PL4	70x55x10Thk.	12
PL5	280x230x10Thk.	2
PL6	200x250x10Thk.	4
PL7	220x220x10Thk.	2
PL8	90x90x10Thk.	2
PL9	220x220x16Thk.	6
PL10	90x90x10Thk.	6
PL11	Ø100x10Thk.	2
PL11A	Ø120x10Thk.	2
PL12	120x80x10Thk.	4
AB1	M16 x 400mm M16 ANCHOR BOLT HILTI HAS-U 8.8 HDG WITH HIT-HY 200 - R V3 (G.R 8.8) ROD ADHESIVE ANCHOR. 125mm EMBEDMENT INTO EXISTING SLAB. TO FIX PL1 INTO PEDESTALS	4
AB2	M16 x 400mm M16 ANCHOR BOLT HILTI HAS-U 8.8 HDG WITH HIT-HY 200 - R V3 (G.R 8.8) ROD ADHESIVE ANCHOR. 125mm EMBEDMENT INTO EXISTING SLAB. TO FIX PL9 INTO PEDESTALS	24
B1	M16 x 50 LONG FULLY THREADED HEX. BOLTS WITH NUT AND WASHER OF GRADE8.8, TO FIX PL12 TO PL8 (# REFER NOTE 3)	2
B1	M16 x 50 LONG FULLY THREADED HEX. BOLTS WITH NUT AND WASHER OF GRADE8.8, TO FIX PL12 TO PL10 (# REFER NOTE 3)	2

MEMBER SCHEDULE		
ITEM No.	ITEM DESCRIPTION	QTY.
B1	M16 x 50 LONG FULLY THREADED HEX. BOLTS WITH NUT AND WASHER OF GRADE 8.8, TO FIX EXISTING BRACING TO PL10 (# REFER NOTE 3)	4
B2	M16 x 120 LONG FULLY THREADED HEX. BOLTS WITH NUT AND WASHER OF GRADE 8.8, TO FIX BR3 TO BR2 / BR4 (# REFER NOTE 3)	6
B3	M16 x 60 LONG FULLY THREADED HEX. BOLTS WITH NUT AND WASHER OF GRADE 8.8, TO FIX PL3 TO PL3 (# REFER NOTE 3)	6
UB1	M16 U-BOLTS TO SUIT Ø139.7 CHS TO FIX PROPOSED POLE - P1 / P2 TO PL7 (# REFER NOTE 4)	4
UB1	M16 U-BOLTS TO SUIT Ø139.7 CHS TO FIX PROPOSED POLE - P2 TO PL5 (# REFER NOTE 4)	4
UB2	M16 U-BOLTS TO SUIT Ø88.9 CHS TO FIX PROPOSED BRACING - BR1 TO PL5 (# REFER NOTE 4)	4
UB2	M16 U-BOLTS TO SUIT Ø88.9 CHS TO FIX PROPOSED BRACING - BR1 TO PL6 (# REFER NOTE 4)	8
UB3	M16 U-BOLTS TO SUIT Ø76.1 CHS TO FIX PROPOSED ANTENNA MOUNT - AM1 TO PL6 (# REFER NOTE 4)	8
UB4	M12 U-BOLT TO SUIT Ø139.7 CHS TO FIX EXISTING POLE TO EXISTING PLATE (#REFER NOTE 4)	16
UB5	M12 U-BOLTS TO SUIT Ø76.1 CHS TO FIX EXISTING ANTENNA MOUNT TO EXISTING PLATE (# REFER NOTE 4)	16
UB6	M12 U-BOLTS TO SUIT Ø88.9 CHS TO FIX EXISTING HORIZONTAL MEMBER TO EXISTING PLATE (# REFER NOTE 4)	32
RD1	Ø10x156mm LONG	7
RD2	Ø20x192mm LONG	26

NOTE FOR MANUFACTURER & INSTALLER:
TRIAL ASSEMBLE PRIOR TO GALVANISING AND DELIVERY
TO SITE TO ENSURE CORRECT FIT AND NUMBER OF PARTS

NOTE :
U-BOLT - UB4, UB5 & UB6 SHALL BE USE ONLY IF THE
EXISTING BOLTS ARE NOT IN GOOD CONDITION.

COMPLIANCE BOX

COMPLETED AS PER DESIGN

ALTERATIONS IN RED

NAME (PRINT)

SIGNATURE

DATE

FOR CONSTRUCTION



MOBILE NETWORK SITE 40893
CAMPERDOWN RYDGES MISSENDEN RD
ANTENNA MOUNTING DETAILS - SHEET 9 OF 9
9 MISSENDEN RD, CAMPERDOWN, NSW 2050

DWG
NO.

N26167

SHT
NO.

T3-12

© Telstra Limited ACN 086 174 781 All rights reserved.


CYIENT

Level 14, 3 Parramatta Square, 153 Macquarie St, Parramatta, NSW 2150, Australia
T +61 2 8896 6160 | www.cyient.com


UNAPPROVED
DRAWING

DO NOT
SCALE

F

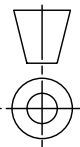


A3

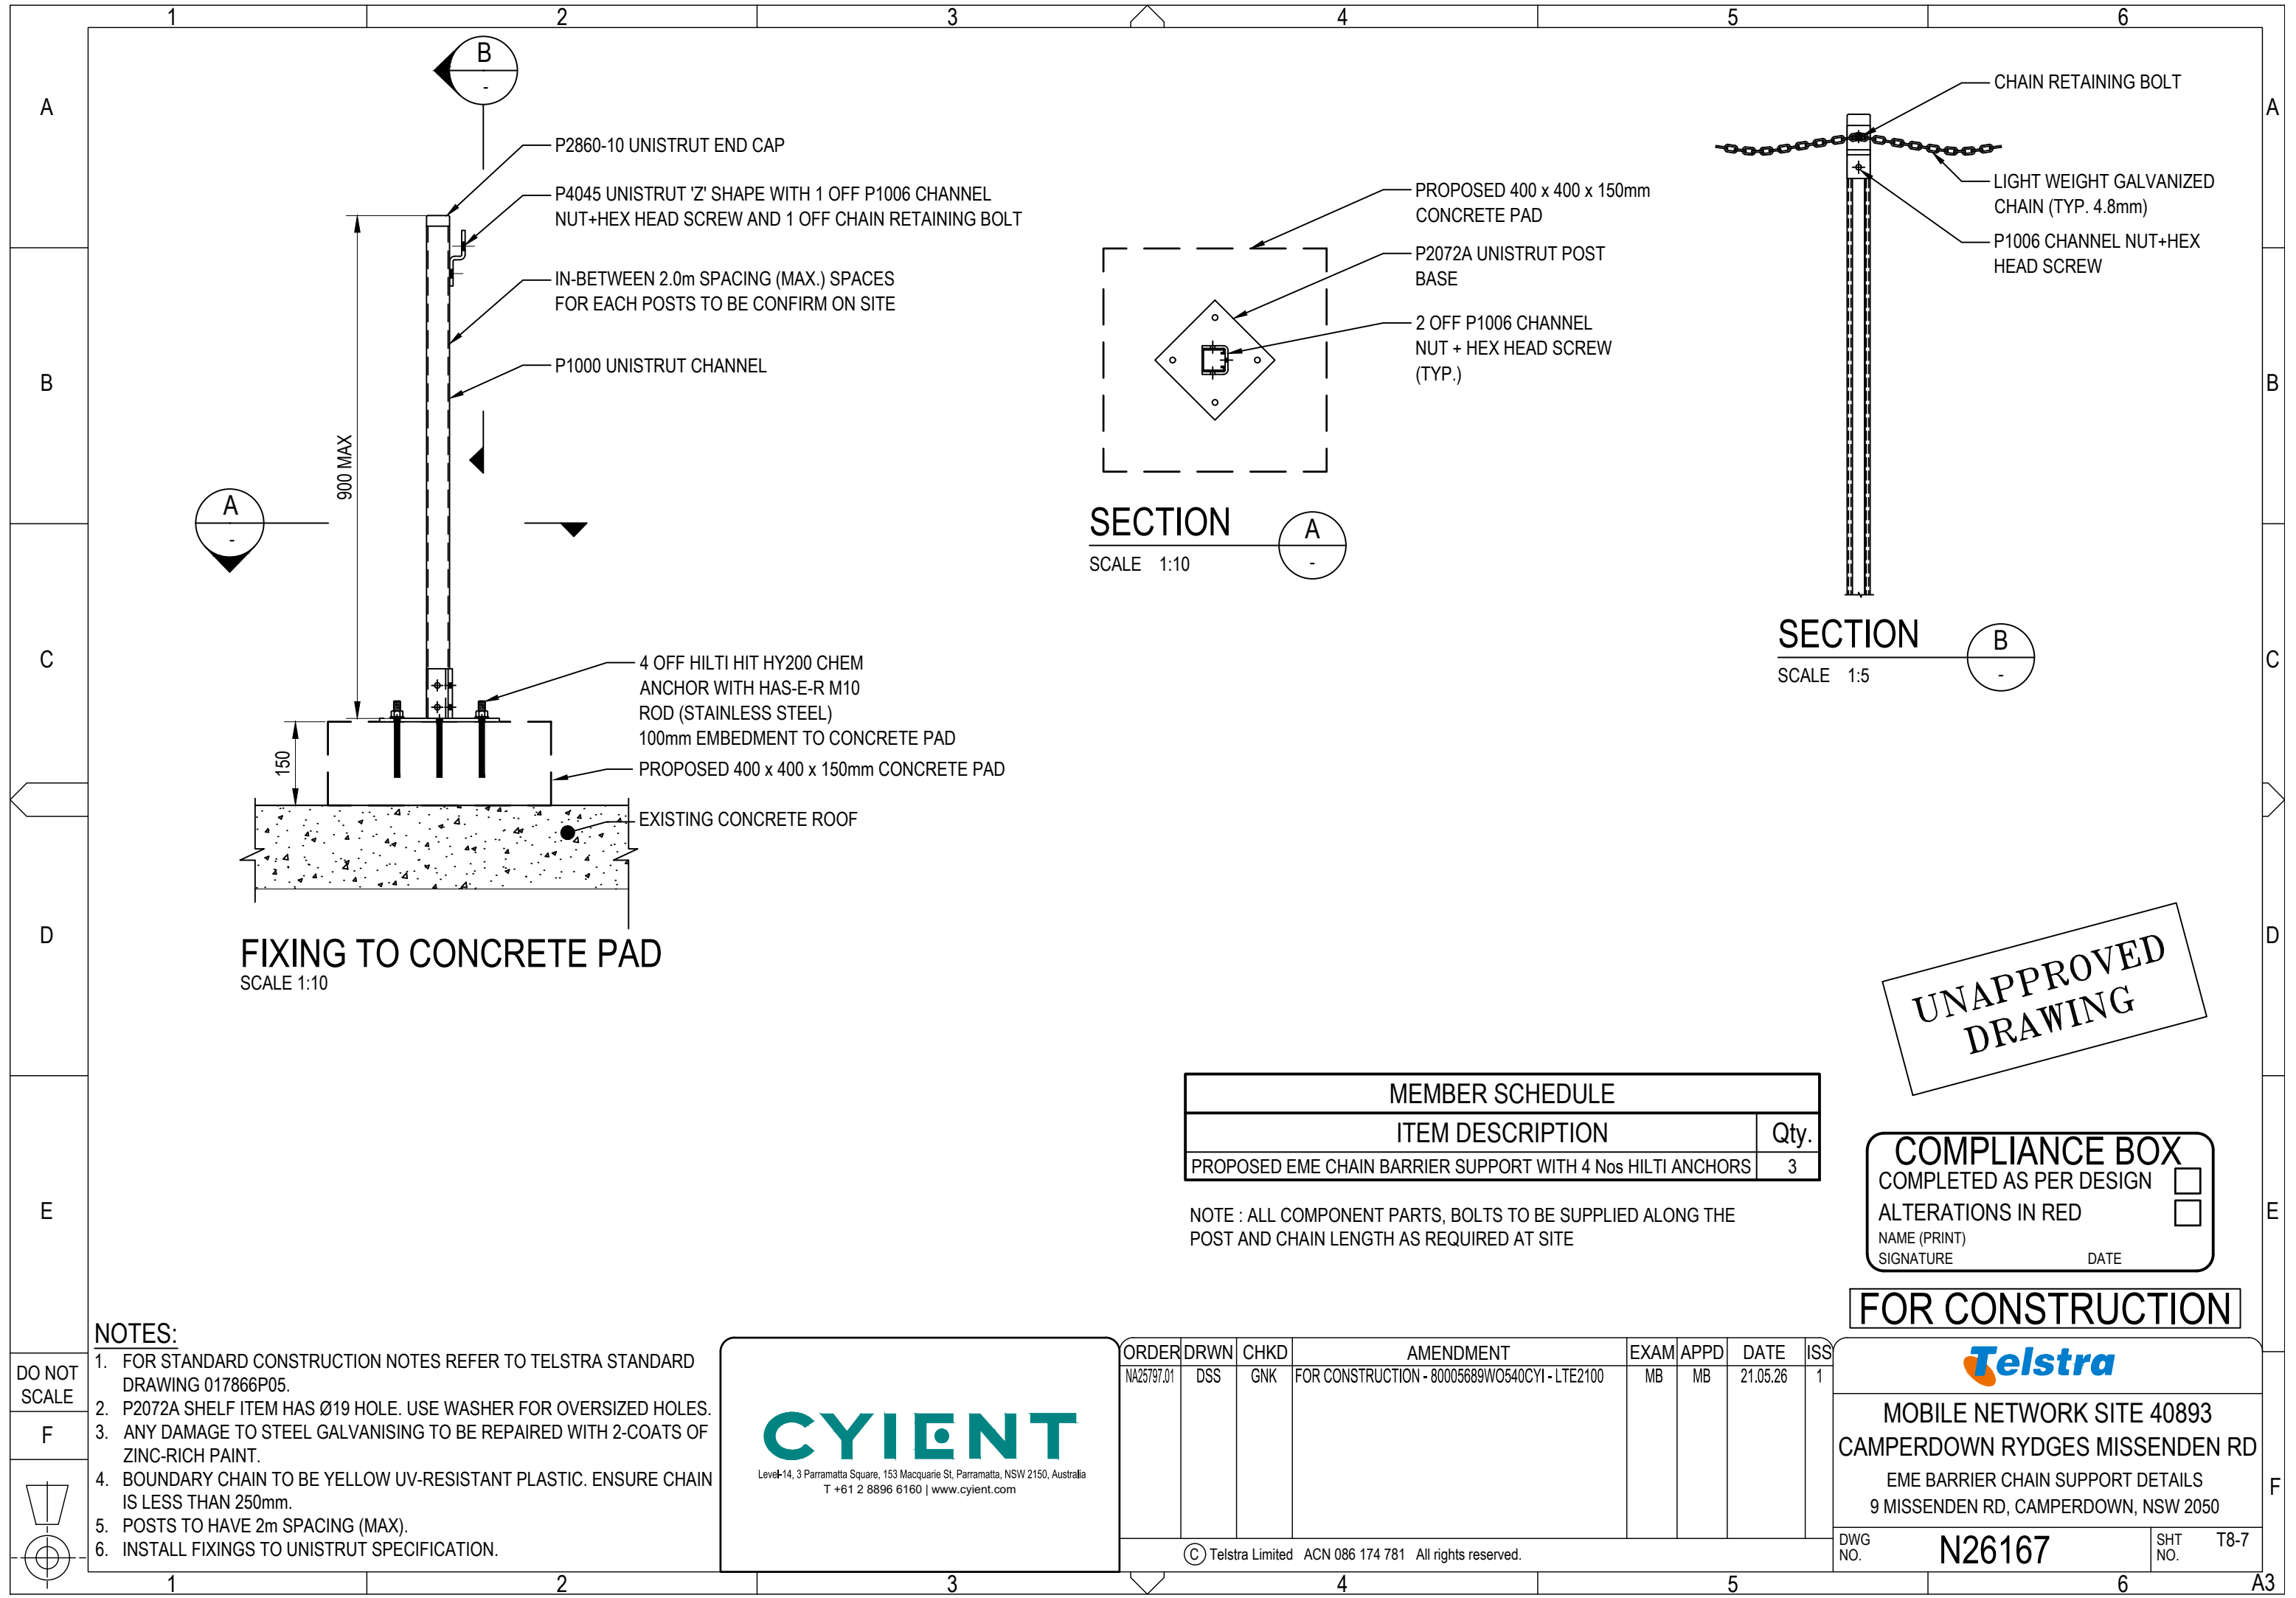

DO NOT
SCALE

F

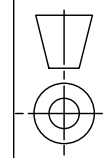

- NOTES:**
- FOR STANDARD CONSTRUCTION NOTES REFER TO TELSTRA STANDARD DRAWING 017866P05.
 - P2072A SHELF ITEM HAS Ø19 HOLE. USE WASHER FOR OVERSIZED HOLES.
 - ANY DAMAGE TO STEEL GALVANISING TO BE REPAIRED WITH 2-COATS OF ZINC-RICH PAINT.
 - BOUNDARY CHAIN TO BE YELLOW UV-RESISTANT PLASTIC. ENSURE CHAIN IS LESS THAN 250mm.
 - POSTS TO HAVE 2m SPACING (MAX).
 - INSTALL FIXINGS TO UNISTRUT SPECIFICATION.

CYIENT
Level 14, 3 Parramatta Square, 153 Macquarie St, Parramatta, NSW 2150, Australia
T +61 2 8896 6160 | www.cyient.com

ORDER	DRWN	CHKD	AMENDMENT	EXAM	APPD	DATE	ISS
NA25797.01	DSS	GNK	FOR CONSTRUCTION - 80005689W0540CYI - LTE2100	MB	MB	21.05.26	1
© Telstra Limited ACN 086 174 781 All rights reserved.							

COMPLIANCE BOX	
COMPLETED AS PER DESIGN	☐
ALTERATIONS IN RED	☐
NAME (PRINT)	
SIGNATURE	DATE

FOR CONSTRUCTION

Telstra	
MOBILE NETWORK SITE 40893	
CAMPERDOWN RYDGES MISSENDEN RD	
EME BARRIER CHAIN SUPPORT DETAILS	
9 MISSENDEN RD, CAMPERDOWN, NSW 2050	
DWG NO.	N26167
SHT NO.	T8-7