

A

B

C

D

E

DO NOT SCALE

F

1

2

3

4

5

6

DRAWING DESCRIPTION	DRAWING NUMBER	SHEET NO.	ISSUE NO.	ISSUE DATE	DRAWING STATUS				
					CANCELLED	PRELIMINARY	FOR CONSTRUCTION	AS BUILT	REFERENCE ONLY
SITE SPECIFIC NOTES - SHEET 1 OF 3	N109732	S0	9	12/08/26			✓		
SITE SPECIFIC NOTES - SHEET 2 OF 3	N109732	S0-1	7	12/08/26			✓		
SITE SPECIFIC NOTES - SHEET 3 OF 3	N109732	S0-2	3	12/08/26			✓		
SITE ACCESS AND LOCALITY PLAN	N109732	S1	10	12/08/26			✓		
ANTENNA LAYOUT - SHEET 1 OF 2	N109732	S1-1	10	12/08/26			✓		
ANTENNA LAYOUT - SHEET 2 OF 2	N109732	S1-2	10	12/08/26			✓		
SOUTH WEST ELEVATION	N109732	S3	10	12/08/26			✓		
ANTENNA CONFIGURATION TABLE	N109732	S3-1	10	12/08/26			✓		
SITE TENURE PLAN	N109732	G1	3	30/07/26			✓		
SITE EARTHING PLAN	N109732	G4	2	04/09/13					✓
ELECTRICAL SPECIFICATION	N109732	E0	4	22/05/19					✓
EQUIPMENT LAYOUT	N109732	E1	9	12/08/26			✓		
AC POWER - CONNECTION	N109732	E2	2	04/09/13					✓
DC POWER LINE DIAGRAM - SHEET 1 OF 2	N109732	E4	7	12/08/26			✓		
DC POWER LINE DIAGRAM - SHEET 2 OF 2	N109732	E4-1	3	12/08/26			✓		
45RU PATHFINDER RACK LAYOUT	N109732	E5	5	12/08/26			✓		
EQUIPMENT SHELTER FOOTINGS - SHEET 1 OF 2	N109732	H1	2	04/09/13					✓
EQUIPMENT SHELTER FOOTINGS - SHEET 2 OF 2	N109732	H1-1	2	04/09/13					✓
SECTOR 1 ANTENNA MOUNT DETAIL - SHEET 1 OF 4	N109732	T3	2	04/09/13					✓
SECTOR 1 ANTENNA MOUNT DETAIL - SHEET 2 OF 4	N109732	T3-1	2	04/09/13					✓
SECTOR 1 ANTENNA MOUNT DETAIL - SHEET 3 OF 4	N109732	T3-2	2	04/09/13					✓
SECTOR 1 ANTENNA MOUNT DETAIL - SHEET 4 OF 4	N109732	T3-3	2	04/09/13					✓
SECTOR 2 ANTENNA MOUNT DETAIL - SHEET 1 OF 2	N109732	T3-4	2	04/09/13					✓
SECTOR 2 ANTENNA MOUNT DETAIL - SHEET 2 OF 2	N109732	T3-5	2	04/09/13					✓
SECTOR 3 ANTENNA MOUNT DETAIL - SHEET 1 OF 3	N109732	T3-6	2	04/09/13					✓
SECTOR 3 ANTENNA MOUNT DETAIL - SHEET 2 OF 3	N109732	T3-7	2	04/09/13					✓
SECTOR 3 ANTENNA MOUNT DETAIL - SHEET 3 OF 3	N109732	T3-8	2	04/09/13					✓
RRU MOUNTING DETAILS - SHEET 1 OF 4	N109732	T3-9	3	22/01/19					✓
RRU MOUNTING DETAILS - SHEET 2 OF 4	N109732	T3-10	3	22/01/19					✓
RRU MOUNTING DETAILS - SHEET 3 OF 4	N109732	T3-11	3	22/01/19					✓
RRU MOUNTING DETAILS - SHEET 4 OF 4	N109732	T3-12	2	25/03/14					✓
EME BARRIER DETAILS	N109732	T3-13	2	22/09/20					✓
ANTENNA MOUNTING DETAILS - SHEET 1 OF 4	N109732	T3-14	1	12/08/26			✓		
ANTENNA MOUNTING DETAILS - SHEET 2 OF 4	N109732	T3-15	1	12/08/26			✓		

1

2

3

4

5

6

A

B

C

D

E

F



BELLA VISTA 29-31 LEXINGTON DR

NODE MANAGER ADDRESS ID: 288399

ADDRESS: 29-31 LEXINGTON DRIVE
BELLA VISTA
NSW 2153



Level-14, 333 Collins Street, Melbourne, Victoria 3000 Australia
T +61 3 8605 4815 | www.cyient.com

UNAPPROVED
DRAWING

ORDER	DRWN	CHKD	AMENDMENT	EXAM	APPD	DATE	ISS
NA13832.01	ES	ES	72204548-LTE1800-AS BUILT-WO1-ERIC	ES	BDB	25.03.14	5
NA15604.01	MH	AK	AS BUILT - 30051137W0029TELSTRA - LTE700	LY	CG	22.01.16	6
NA18834.01	MT	BJ	AS BUILT - 30069071W0430SSNC - LTE2100 / LTE2600	KV	DG	29.01.19	7
NA21224.01	KA	GM	FOR CONSTRUCTION - 30084105W0105CYI - NR3600	MB	JY	16.04.20	8
NA21224.01	CU	SK	AS BUILT - 30084105W0149CYI - NR3600	KSK	DG	22.09.20	9
NA28642.01	TE	MB	FOR CONSTRUCTION - 80005689W0224CYI - NR850/NR2600/NR3600	XX	XX	12.08.26	10

© Telstra Limited ACN 086 174 781 All rights reserved.



MOBILE NETWORK SITE 288399
BELLA VISTA 29-31 LEXINGTON DR


DRAWING INDEX AND DOCUMENT CONTROL - SHEET 1 OF 3
29-31 LEXINGTON DRIVE, BELLA VISTA, NSW 2153

DWG NO.

N109732

SHT NO.

DC

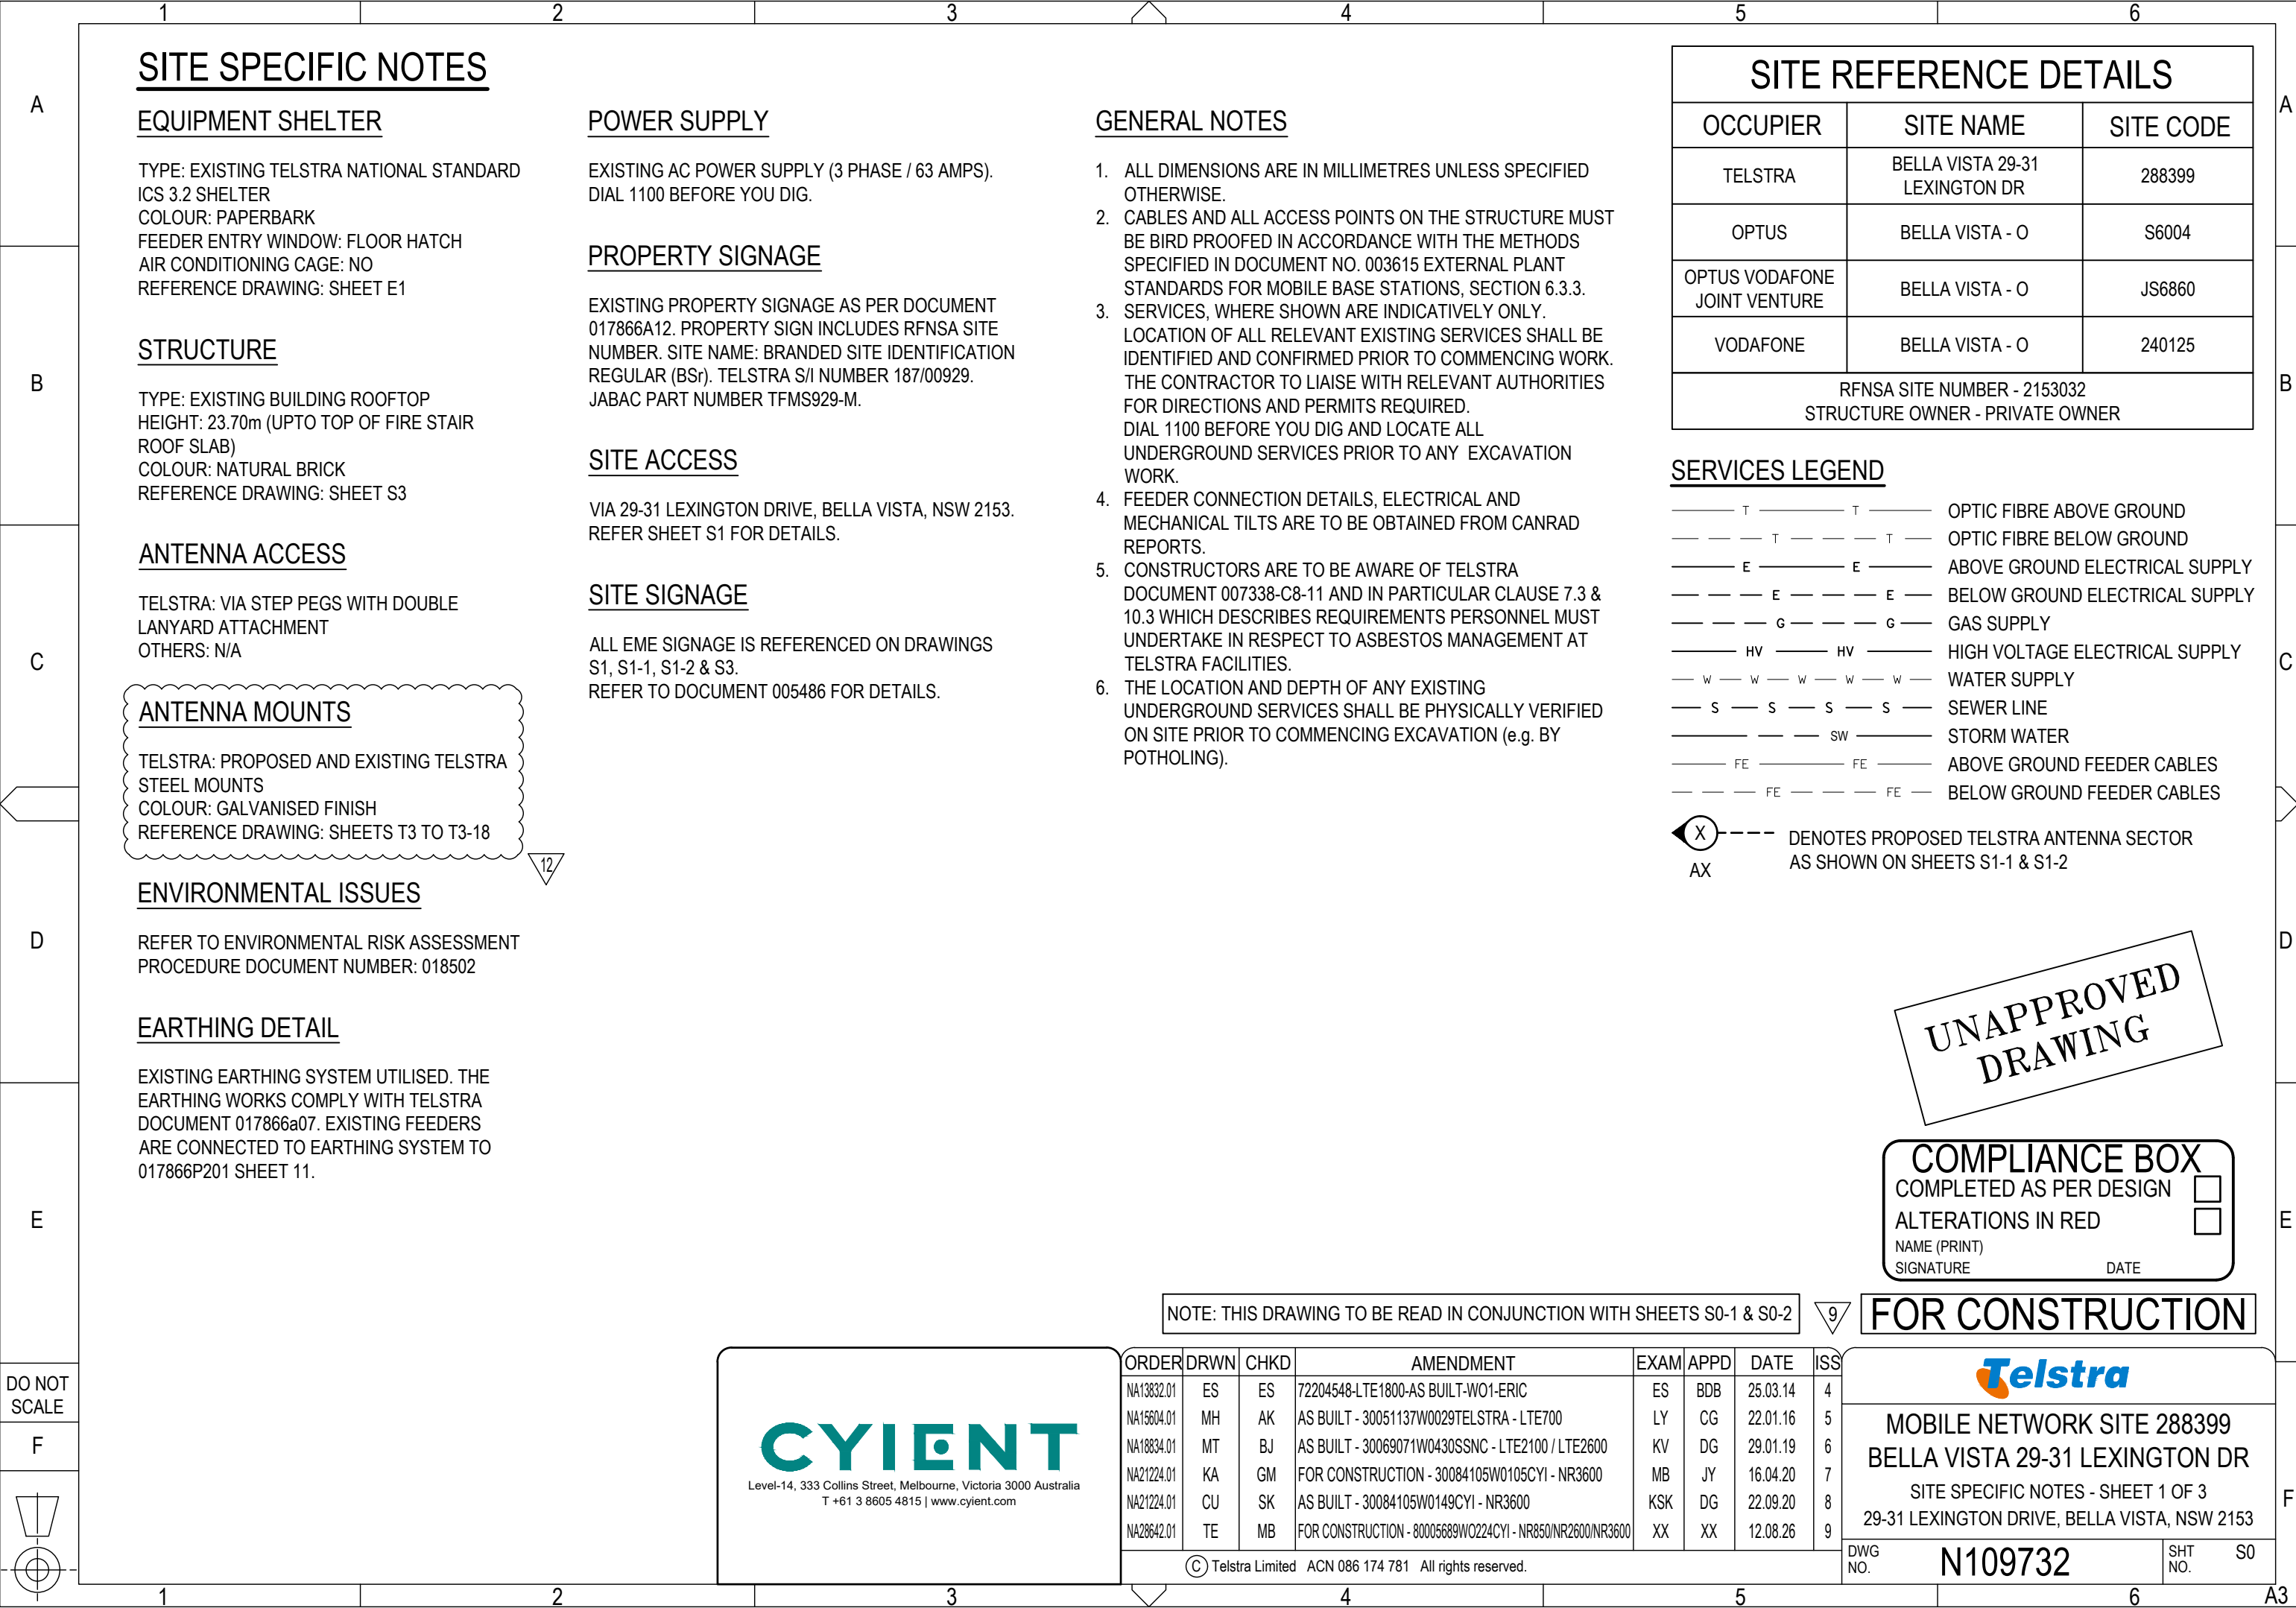

	1	2	3	4	5	6					
A	EQUIPMENT NOTES - PROJECT NO. NA28642.01										
B	ITEM	EQUIPMENT	EQUIPMENT DETAILS	EXISTING	PROPOSED	TOTAL	REFERENCE DWG				
	1	45RU PATHFINDER RACK	530 x 530 x 2200mm (W,D,H)	2	-1	1	SHEETS E1 & E5				
	2	DECON RACK FOR RADIO 4490HP	600 x 600 x 2200mm (W,D,H)	0	1	1	SHEETS E1 & E5				
	3	ELTEK SP18-HC (PSU)	600 x 600 x 2200mm (W,D,H)	1	0	1	SHEETS E1 & E4				
	4	ELTEK SP18-HC RECTIFIERS	FP2 HE 2kW	4	0	4	SHEETS E1 & E4				
	5	ELTEK SP18-HC BATTERY STRINGS	YUASA FHX190-12S, BATTERY RESERVE TIME 1 HR	1	0	1	SHEETS E1 & E4				
	6	ELTEK SP18-RRU (PSU)	600 x 600 x 2201mm (W,D,H)	1	0	1	SHEETS E1 & E4-1				
	7	ELTEK SP18-RRU RECTIFIERS	FP2 HE 2kW	5	0	5	SHEETS E1 & E4-1				
	8	ELTEK SP18-RRU BATTERY STRINGS	YUASA FHX190-12S, BATTERY RESERVE TIME 1 HR	2	0	2	SHEETS E1 & E4-1				
	9	ENATEL DC-DC UNIT	325 x 483 x 133mm (W,D,H)	1	0	1	SHEET E1				
C	10	ENATEL DC-DC CONVERTER	CM1748-48 MODULES	4	0	4	SHEET E1				
	11	ERICSSON DCDU	TO BE INSTALLED IN 45RU PATHFINDER RACK RT/2/2	0	1	1	SHEETS E1 & E5				
	12	KEREM A100 PDP	TO BE INSTALLED IN DECON RACK RT/2/4	0	1	1	SHEETS E1 & E5				
	13	KEREM A100 CB 40A	KT-APX-50KA-MTRS-40A	0	3	3	SHEETS E1 & E5				
	14	ERICSSON RBS6202	500 x 525 x 568mm (W,D,H)	2	-1, 1 (SPARE)	1	SHEETS E1 & E5				
	15	ERICSSON RP6672 (LTE700/LTE850/NR850/LTE1800/LTE2100/LTE2600	TO BE INSTALLED IN 45RU PATHFINDER RACK RT/2/2	0	1	1	SHEETS E1 & E5				
	16	ERICSSON BB6630	INSTALLED IN 45RU PATHFINDER RACK RT/2/2	1	-1	0	SHEETS E1 & E5				
	17	ERICSSON R503 DIGITAL UNIT	INSTALLED IN 45RU PATHFINDER RACK RT/2/2	2	-2	0	SHEETS E1 & E5				
	18	ERICSSON ROUTER 6675	INSTALLED IN 45RU PATHFINDER RACK RT/2/2	1	0	1	SHEETS E1 & E5				
	19	ERICSSON RBS6601	INSTALLED IN 45RU PATHFINDER RACKS	1	-1	0	SHEET E1				
D	20	BB5216	INSTALLED IN RBS6202	1	-1	0	SHEET E5				
	21	ERICSSON SITE INTEGRATION UNIT (SIU)	INSTALLED IN 45RU PATHFINDER RACK	1	0	1	SHEET E1				
	22	ERICSSON DUW 30 01	INSTALLED IN RBS6601	1	-1	0	SHEET E1				
	23	FIBRE PATCH PANEL	INSTALLED IN 45RU PATHFINDER RACK RT/2/2	1	0	1	SHEETS E1 & E5				
	24	CABLE GUIDE	INSTALLED IN 45RU PATHFINDER RACK RT/2/2	4	0	4	SHEETS E1 & E5				
	25	FIBRE MANAGEMENT TRAY	INSTALLED IN 45RU PATHFINDER RACK RT/2/2	1	0	1	SHEETS E1 & E5				
	26	SLIDE OUT FIBRE MANAGEMENT TRAY	TO BE INSTALLED IN 45RU PATHFINDER RACK RT/2/2	0	2	2	SHEETS E1 & E5				
	27	4490 ADAPTOR SHELVES	TO BE INSTALLED IN DECON RGL-091 RACK AT RT/2/4	0	3	3	SHEETS E1 & E5				
	28	ELTEK INTERNAL SURGE PROTECTION DEVICE (12.2 WAY)	IN EQUIPMENT SHELTER AT RT/1/4 WALL MOUNTED	1	-1	0	SHEET E1				
	29	VERTIV 12.3 WAY EXTERNAL SPD BOX	600 x 200 x 600mm (W,D,H) WALL MOUNTED	1	0	1	SHEET E1				
E	30	RRU INTERFACE JUNCTION BOX	4P16F	3	-3	0	SHEETS S1-2 & S3				
	31	W&B RRU INTERFACE JUNCTION BOX	W&B 8P24F (TC4039 MOBILE 08)	3	0	3	SHEETS S1-2 & S3				
	32	ERICSSON RADIO 4443 (B1 B3) LTE2100 / LTE1800	335 x 284 x 380mm (W,D,H) NATURAL PRODUCT COLOUR	3	-3	0	SHEETS S1-2 & S3				
NOTE: THIS DRAWING TO BE READ IN CONJUNCTION WITH SHEETS S0 & S0-2											
DO NOT SCALE	CYIENT Level-14, 333 Collins Street, Melbourne, Victoria 3000 Australia T +61 3 8605 4815 www.cyient.com		ORDER	DRWN	CHKD	AMENDMENT	EXAM	APPD	DATE	ISS	
NA13832.01			ES	ES	72204548-LTE1800-AS BUILT-WO1-ERIC	ES	BDB	25.03.14	2		
NA15604.01			MH	AK	AS BUILT - 30051137W0029TELSTRA - LTE700	LY	CG	22.01.16	3		
NA18834.01			MT	BJ	AS BUILT - 30069071W0430SSNC - LTE2100 / LTE2600	KV	DG	29.01.19	4		
NA21224.01			KA	GM	FOR CONSTRUCTION - 30084105W0105CYI - NR3600	MB	JY	16.04.20	5		
F			NA21224.01	CU	SK	AS BUILT - 30084105W0149CYI - NR3600	KSK	DG	22.09.20	6	
NA28642.01			TE	MB	FOR CONSTRUCTION - 80005689W0224CYI - NR850/NR2600/NR3600	XX	XX	12.08.26	7		
© Telstra Limited ACN 086 174 781 All rights reserved.											
							UNAPPROVED DRAWING				
							COMPLIANCE BOX COMPLETED AS PER DESIGN ☐ ALTERATIONS IN RED ☐ NAME (PRINT) _____ SIGNATURE _____ DATE _____				
							FOR CONSTRUCTION				
							Telstra				
							MOBILE NETWORK SITE 288399 BELLA VISTA 29-31 LEXINGTON DR SITE SPECIFIC NOTES - SHEET 2 OF 3 29-31 LEXINGTON DRIVE, BELLA VISTA, NSW 2153				
							DWG NO.	N109732		SHT NO.	S0-1
							A3				

1

2

3

4

5

6

A

B

C

D

E

F

EQUIPMENT NOTES - PROJECT NO. NA28642.01

ITEM	EQUIPMENT	EQUIPMENT DETAILS	EXISTING	PROPOSED	TOTAL	REFERENCE DWG
33	ERICSSON RRUS-32 B7 (LTE2600)	306 x 178 x 690mm (W,D,H) NATURAL PRODUCT COLOUR	3	-3	0	SHEETS S1-1 & S3
34	ERICSSON RADIO 4485 (B3/B1/B7) LTE1800/LTE2100/NR/LTE2600	533 x 398 x 145mm (W,D,H) NATURAL PRODUCT COLOUR	0	3	3	SHEETS S1-2 & S3
35	ERICSSON RADIO 4490HP (B28/B26) (LTE700/LTE850/NR850)	397 x 165 x 522mm (W,D,H) NATURAL COLOUR	0	3	3	SHEETS E1 & E5
36	RUS02 B28	INSTALLED IN RBS6202 RT/2/2	6	6 (SPARE)	6	SHEETS E1 & E5
37	RUS02 B5	INSTALLED IN RBS6202 RT/2/4	3	-3	0	SHEET E1
38	KAEUS COMBINER	DBC0086F1V1-1 INSTALLED WITHIN PATHFINDER RACK AT RT/2/2	3	3 (SPARE)	3	SHEETS E1 & E5
39	TRIASX DUAL DUPLEX FILTER (WCDMA850)	DDF0035F1V1	3	3 (SPARE)	3	SHEET E1
40	KAEUS KA-6035 FILTER	TO BE INSTALLED WITHIN PROPOSED DECON RACK AT RT/2/3	0	3	3	SHEETS E1 & E5
41	KAEUS TOWER MOUNTED AMPLIFIER LTE700	TMA2094F01V2-1	3	-3	0	SHEETS S1-1 & S3
42	KAEUS TOWER MOUNTED AMPLIFIER (LTE700/NR850)	KA-1031	0	6	6	SHEETS S1-2 & S3
43	RFS HYBRIFLEX 7/8" (8P16F)	S1 (80m), S2 (25m) & S3 (40m) LENGTH	3	3 (SPARE)	3	SHEETS S1-2 & S3
44	W&B HYBRID CABLE 7/8" (8P24F)	S1 (80m), S2 (25m) & S3 (40m) LENGTH	3	0	3	SHEETS S1-2 & S3
45	RFS LCF114-50J	S1 (70m) LENGTH	2	0	2	SHEETS S1-1 & S3
46	RFS LCF78-50JA	S2 & S3 (30m) LENGTH	4	0	4	SHEETS S1-2 & S3
47	GPS SPLITTER	INSTALLED IN 45RU PATHFINDER RACK GD/2/3	1	1 (SPARE)	1	SHEETS E1 & E5
48	GPS RECEIVER	INSTALLED IN 45RU PATHFINDER RACK GD/2/3	1	-1	0	SHEETS E1 & E5
49	GPS ANTENNA (LTE)	ERICSSON GPS KRE 101 2082 1 OMNI	1	-1	0	SHEETS S1 & S3
50	GPS RECEIVER UNIT	ERICSSON GRU 05 01 RECEIVER NCD90189/1	0	1	1	SHEETS E1 & E5
51	KAEUS, DUAL BAND GNSS GPS ACTIVE ANTE	KA-7005-1110	0	1	1	SHEETS S1 & S3
52	RF JUMPER 1_5M N F TO SMA M	TSR951339/1500	0	1	1	-
53	GPS WBT TOD CABLE	WBT R6000 TOD CABLE - 3M	0	1	1	-
54	GPS SYNC CABLE	RPM1136127/2000	0	1	1	-
55	EQUIPMENT SHELTER AIR CONDITIONER	SPLIT TYPE	2	0	2	SHEET E1

DO NOT SCALE

CYIENT

Level-14, 333 Collins Street, Melbourne, Victoria 3000 Australia
T +61 3 8605 4815 | www.cyient.com

ORDER

DRWN

CHKD

AMENDMENT

EXAM

APPD

DATE

ISS

NA21224.01

KA

GM

FOR CONSTRUCTION - 30084105W0105CYI - NR3600

MB

JY

16.04.20

1

NA21224.01

CU

SK

AS BUILT - 30084105W0149CYI - NR3600

KSK

DG

22.09.20

2

NA28642.01

TE

MB

FOR CONSTRUCTION - 80005689W0224CYI - NR850/NR2600/NR3600

XX

XX

12.08.26

3

© Telstra Limited

ACN 086 174 781

All rights reserved.

Telstra

MOBILE NETWORK SITE 288399

BELLA VISTA 29-31 LEXINGTON DR

SITE SPECIFIC NOTES - SHEET 3 OF 3

29-31 LEXINGTON DRIVE, BELLA VISTA, NSW 2153

DWG NO.

N109732

SHT NO.

S0-2

UNAPPROVED DRAWING

COMPLIANCE BOX

COMPLETED AS PER DESIGN

ALTERATIONS IN RED

NAME (PRINT)

SIGNATURE

DATE

FOR CONSTRUCTION

1

2


3

4

5

6

A3

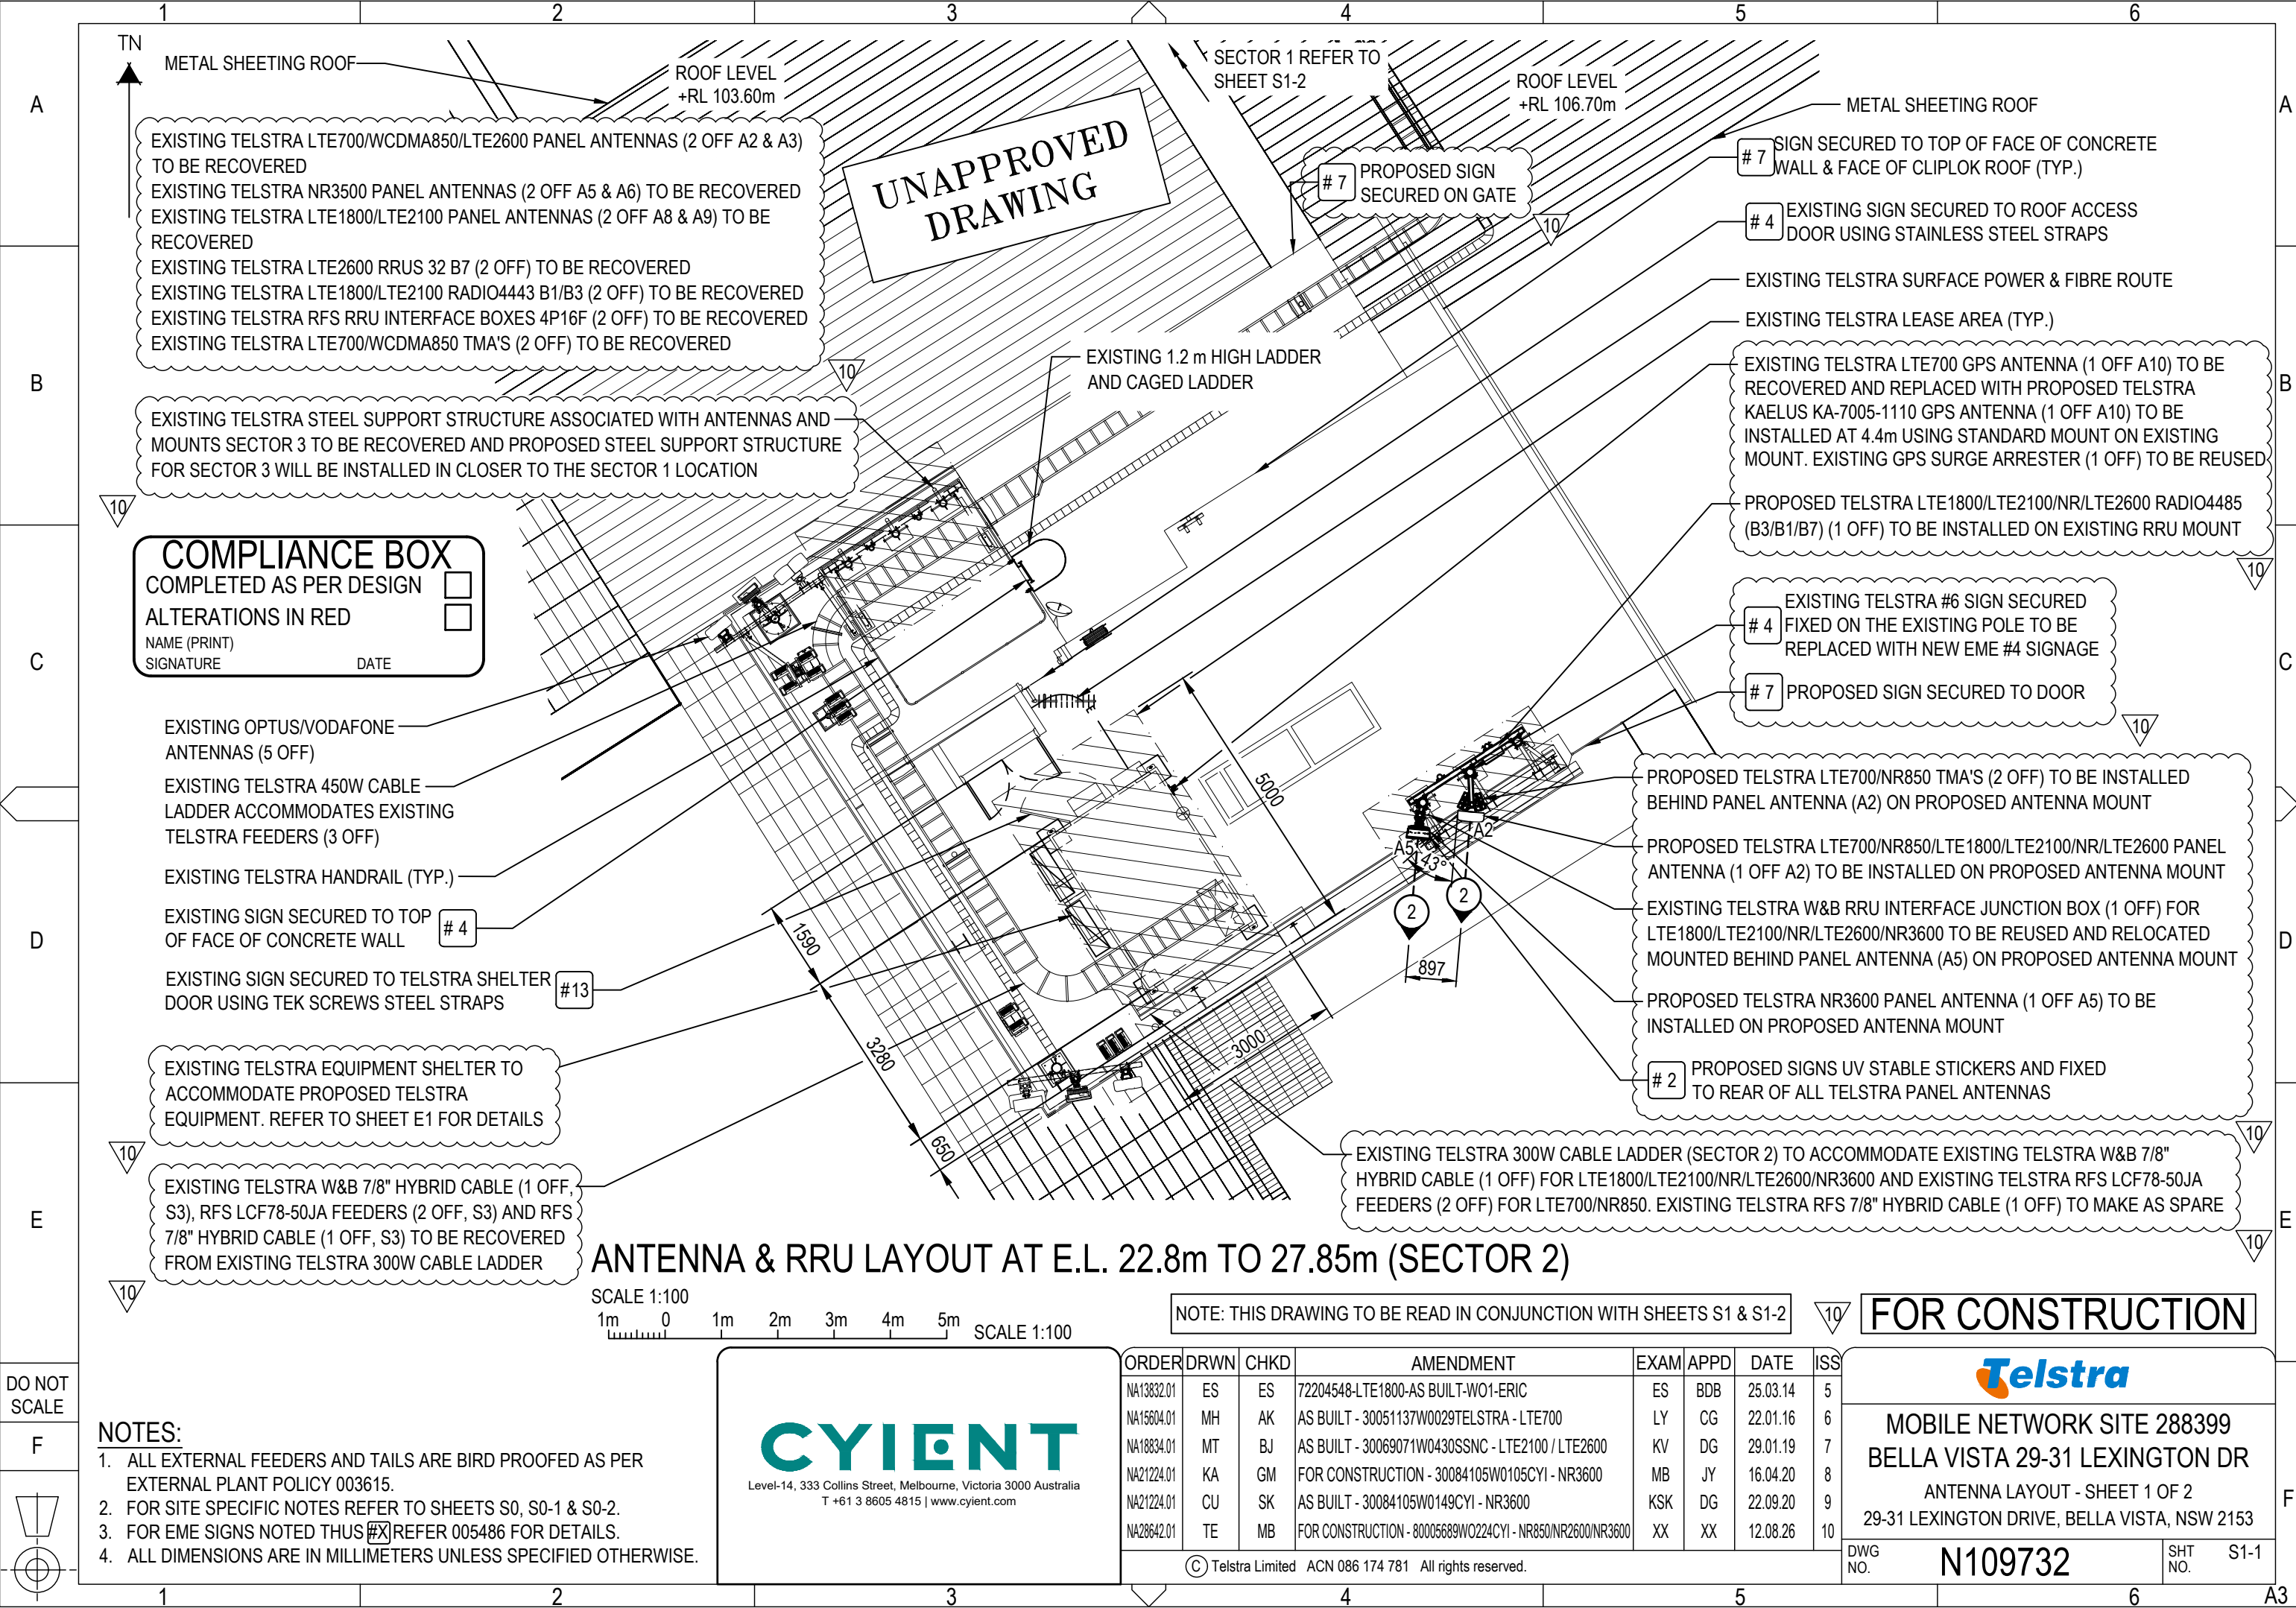

EXISTING TELSTRA LTE700/WCDMA850/LTE2600 PANEL ANTENNAS (2 OFF A2 & A3) TO BE RECOVERED
EXISTING TELSTRA NR3500 PANEL ANTENNAS (2 OFF A5 & A6) TO BE RECOVERED
EXISTING TELSTRA LTE1800/LTE2100 PANEL ANTENNAS (2 OFF A8 & A9) TO BE RECOVERED
EXISTING TELSTRA LTE2600 RRUS 32 B7 (2 OFF) TO BE RECOVERED
EXISTING TELSTRA LTE1800/LTE2100 RADIO4443 B1/B3 (2 OFF) TO BE RECOVERED
EXISTING TELSTRA RFS RRU INTERFACE BOXES 4P16F (2 OFF) TO BE RECOVERED
EXISTING TELSTRA LTE700/WCDMA850 TMA'S (2 OFF) TO BE RECOVERED

EXISTING TELSTRA STEEL SUPPORT STRUCTURE ASSOCIATED WITH ANTENNAS AND MOUNTS SECTOR 3 TO BE RECOVERED AND PROPOSED STEEL SUPPORT STRUCTURE FOR SECTOR 3 WILL BE INSTALLED IN CLOSER TO THE SECTOR 1 LOCATION

COMPLIANCE BOX

COMPLETED AS PER DESIGN

ALTERATIONS IN RED

NAME (PRINT)

SIGNATURE

DATE

EXISTING OPTUS/VODAFONE ANTENNAS (5 OFF)

EXISTING TELSTRA 450W CABLE LADDER ACCOMMODATES EXISTING TELSTRA FEEDERS (3 OFF)

EXISTING TELSTRA HANDRAIL (TYP.)


EXISTING SIGN SECURED TO TOP OF FACE OF CONCRETE WALL

EXISTING SIGN SECURED TO TELSTRA SHELTER DOOR USING TEK SCREWS STEEL STRAPS

EXISTING TELSTRA EQUIPMENT SHELTER TO ACCOMMODATE PROPOSED TELSTRA EQUIPMENT. REFER TO SHEET E1 FOR DETAILS

EXISTING TELSTRA W&B 7/8" HYBRID CABLE (1 OFF, S3), RFS LCF78-50JA FEEDERS (2 OFF, S3) AND RFS 7/8" HYBRID CABLE (1 OFF, S3) TO BE RECOVERED FROM EXISTING TELSTRA 300W CABLE LADDER

ANTENNA & RRU LAYOUT AT E.L. 22.8m TO 27.85m (SECTOR 2)

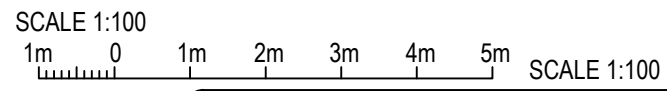

NOTE: THIS DRAWING TO BE READ IN CONJUNCTION WITH SHEETS S1 & S1-2

FOR CONSTRUCTION

- NOTES:
- ALL EXTERNAL FEEDERS AND TAILS ARE BIRD PROOFED AS PER EXTERNAL PLANT POLICY 003615.
 - FOR SITE SPECIFIC NOTES REFER TO SHEETS S0, S0-1 & S0-2.
 - FOR EME SIGNS NOTED THUS [X] REFER 005486 FOR DETAILS.
 - ALL DIMENSIONS ARE IN MILLIMETERS UNLESS SPECIFIED OTHERWISE.



ORDER	DRWN	CHKD	AMENDMENT	EXAM	APPD	DATE	ISS
NA13832.01	ES	ES	72204548-LTE1800-AS BUILT-WO1-ERIC	ES	BDB	25.03.14	5
NA15604.01	MH	AK	AS BUILT - 30051137W0029TELSTRA - LTE700	LY	CG	22.01.16	6
NA18834.01	MT	BJ	AS BUILT - 30069071W0430SSNC - LTE2100 / LTE2600	KV	DG	29.01.19	7
NA21224.01	KA	GM	FOR CONSTRUCTION - 30084105W0105CYI - NR3600	MB	JY	16.04.20	8
NA21224.01	CU	SK	AS BUILT - 30084105W0149CYI - NR3600	KSK	DG	22.09.20	9
NA28642.01	TE	MB	FOR CONSTRUCTION - 80005689W0224CYI - NR850/NR2600/NR3600	XX	XX	12.08.26	10

© Telstra Limited ACN 086 174 781 All rights reserved.

MOBILE NETWORK SITE 288399

BELLA VISTA 29-31 LEXINGTON DR


ANTENNA LAYOUT - SHEET 1 OF 2


29-31 LEXINGTON DRIVE, BELLA VISTA, NSW 2153

DWG NO. N109732

SHT NO. S1-1

DO NOT SCALE

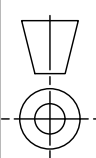

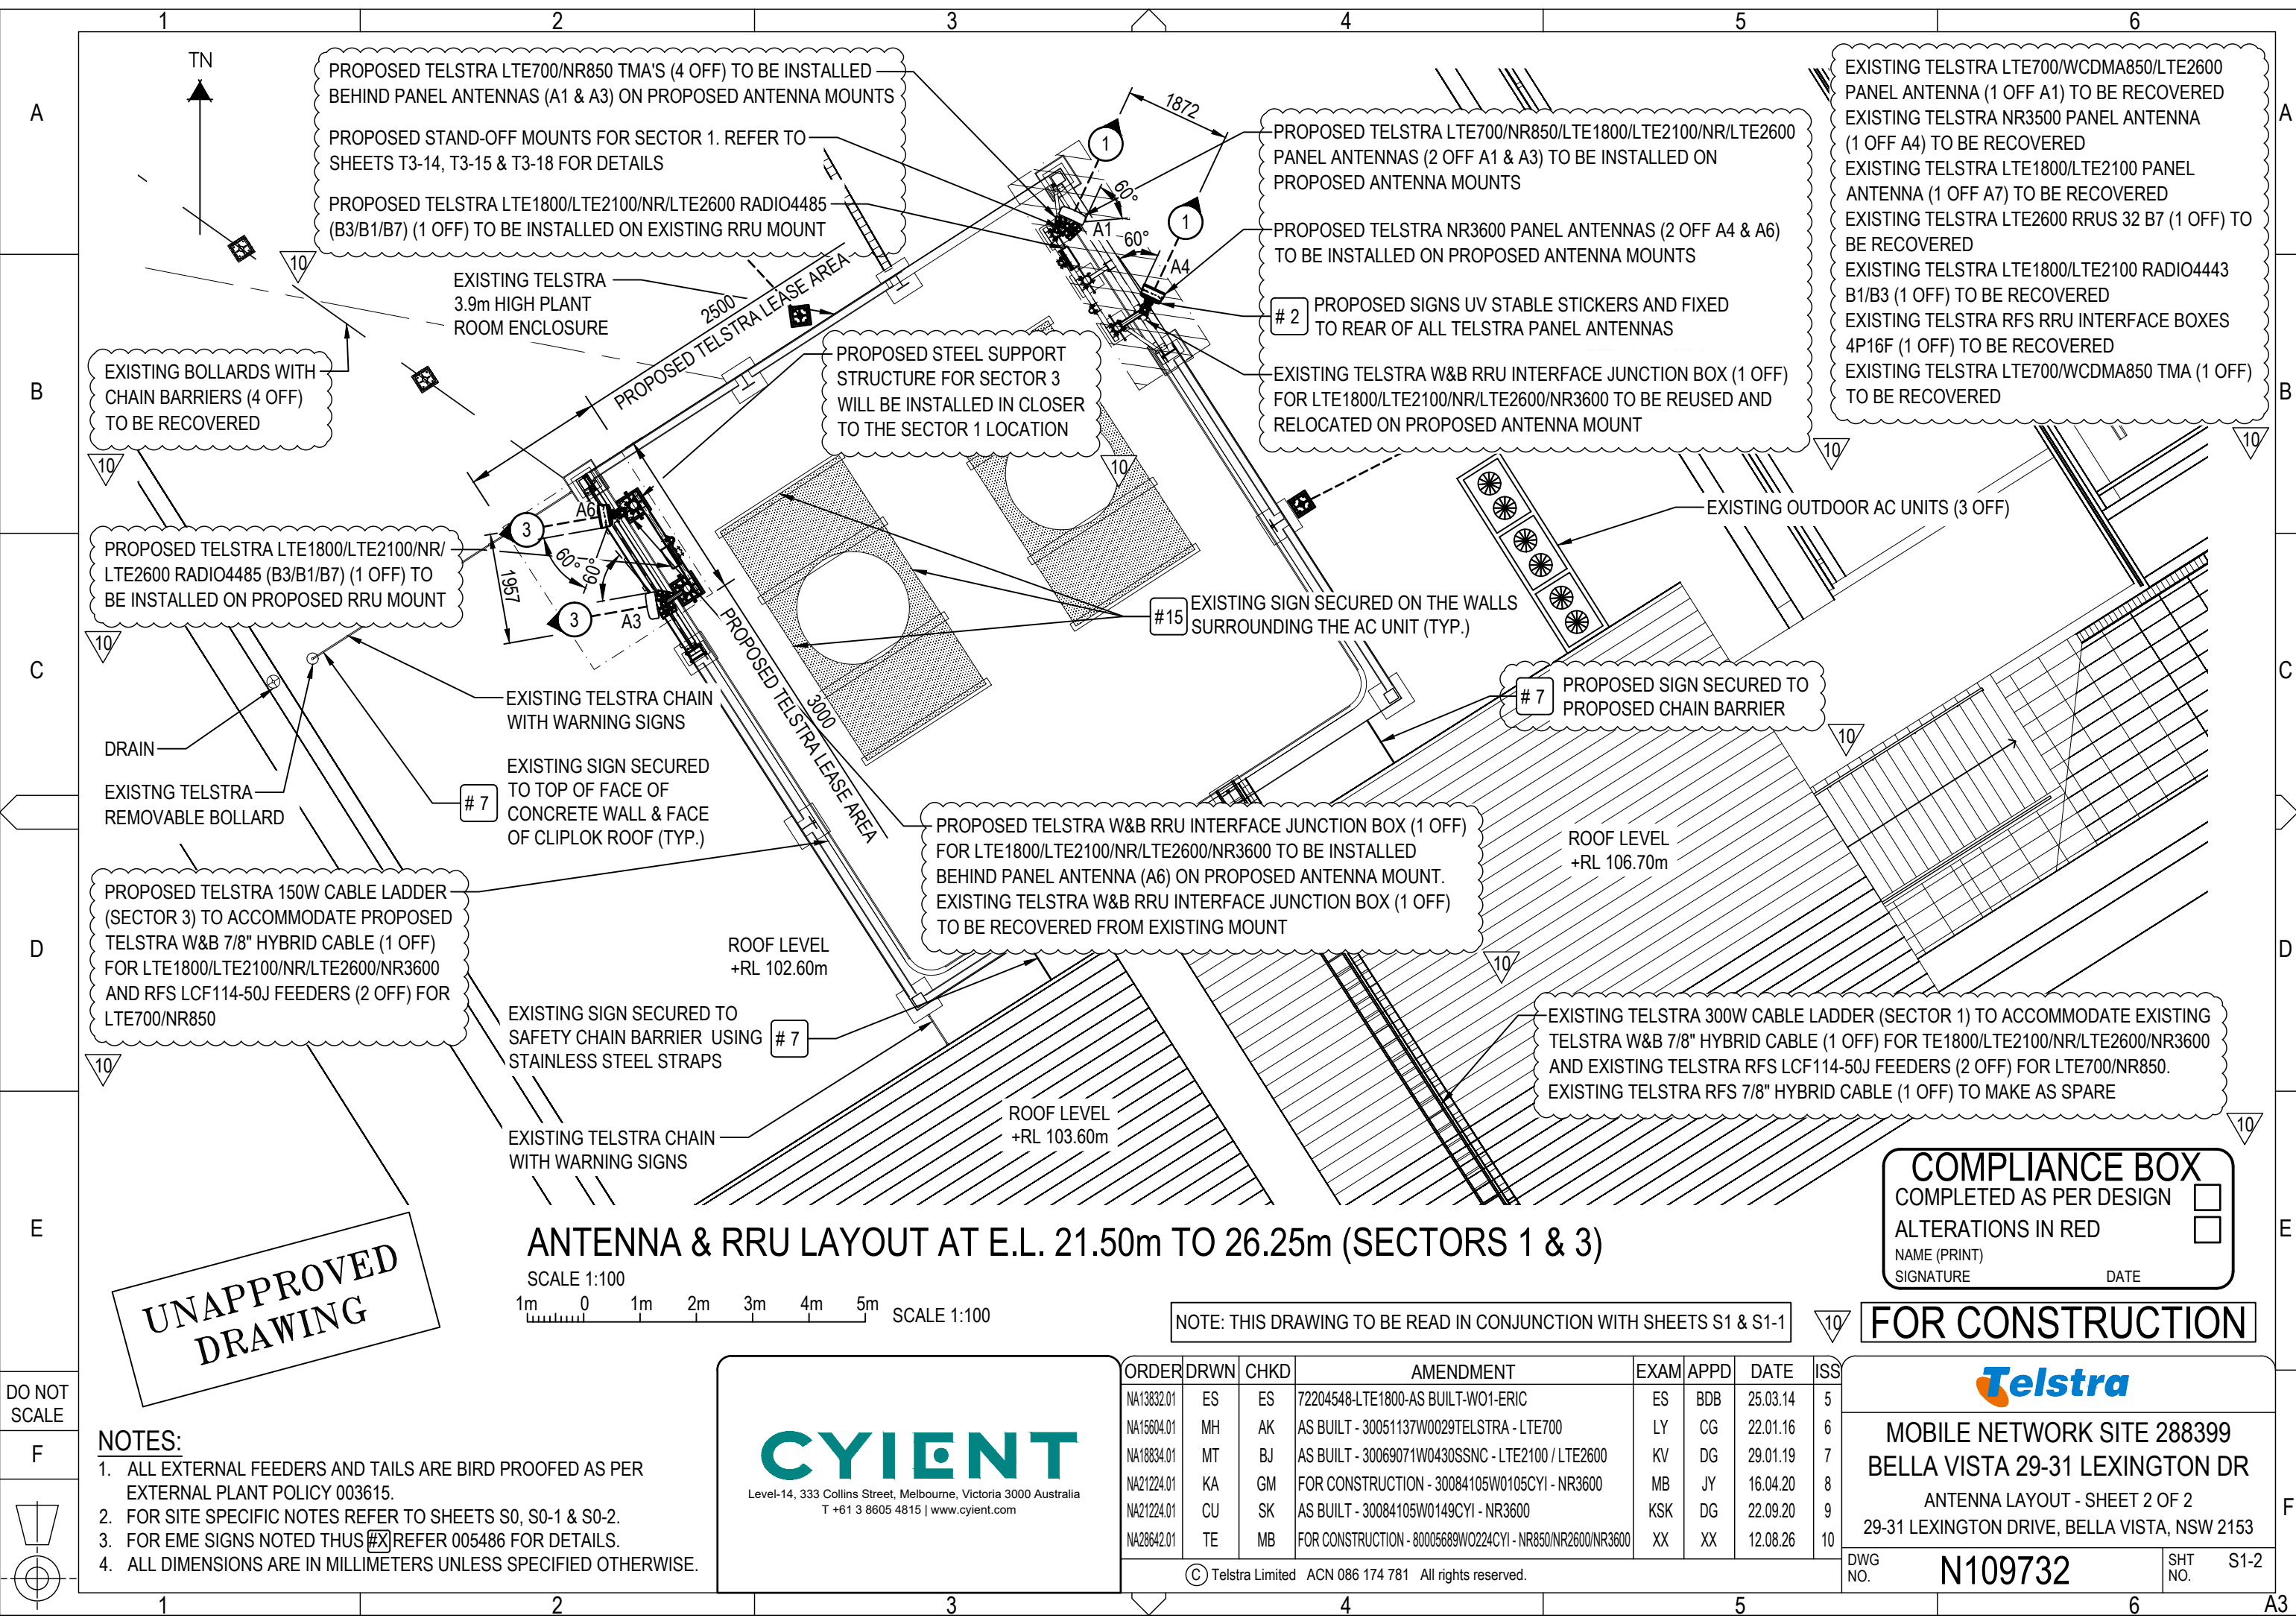

COMPLIANCE BOX
COMPLETED AS PER DESIGN
ALTERATIONS IN RED
NAME (PRINT)
SIGNATURE
DATE

UNAPPROVED
DRAWING

- ▽ E.L. 26.15m (±100mm) R.L. 108.6m AHD
C/L PROPOSED TELSTRA NR3600 PANEL ANTENNAS (2 OFF A4 & A6)
C/L EXISTING TELSTRA W/B RRU INTERFACE JUNCTION BOXES (2 OFF)
- ▽ E.L. 25.2m (±100mm) R.L. 107.95m AHD
C/L PROPOSED TELSTRA LTE700/NR850/LTE1800/
LTE2100NR/LTE2600 PANEL ANTENNAS (2 OFF A1 & A3)
- ▽ E.L. 25.1m (±100mm) R.L. 107.85m AHD
C/L PROPOSED TELSTRA LTE700/NR850 TMA (2 OFF)
- ▽ E.L. 24.35m (±100mm) R.L. 107.10m AHD
C/L PROPOSED TELSTRA LTE700/NR850 TMA (2 OFF)
- ▽ E.L. 23.10m (±100mm) R.L. 105.55m AHD
TOP OF PLANT ROOM ENCLOSURE
- ▽ E.L. 21.5m (±100mm) R.L. 103.95m AHD
C/L PROPOSED TELSTRA LTE1800/LTE2100/NR/LTE2600
RADIO4485 (B3/B1/B7) (2 OFF)

▽ E.L. 19.20m (±100mm) R.L. 101.65m AHD
TOP OF ROOF LEVEL

EXISTING TELSTRA
3.9m HIGH PLANT
ROOM ENCLOSURE

1.5m ARL
(TYP.)

EXISTING TELSTRA 300W CABLE LADDER
TO ACCOMMODATE EXISTING TELSTRA
W&B 7/8" HYBRID CABLE (1 OFF) FOR
LTE1800/LTE2100/NR/LTE2600/NR3600
AND EXISTING TELSTRA RFS LCF114-50J
FEEDERS (2 OFF) FOR LTE700/NR850.
EXISTING TELSTRA RFS 7/8" HYBRID
CABLE (1 OFF) TO MAKE AS SPARE

EXISTING TELSTRA 450W CABLE LADDER (SECTOR 2) TO
ACCOMMODATE EXISTING TELSTRA W&B 7/8" HYBRID
CABLE (1 OFF) FOR LTE1800/LTE2100/NR/LTE2600/NR3600
AND EXISTING TELSTRA RFS LCF78-50JA FEEDERS (2 OFF)
FOR LTE700/NR850. EXISTING TELSTRA RFS 7/8" HYBRID
CABLE (1 OFF) TO MAKE AS SPARE

PROPOSED TELSTRA 150mm WIDE CABLE
TRAY FOR SECTOR 3 TO ACCOMMODATE
PROPOSED TELSTRA W&B 7/8" HYBRID
CABLE (1 OFF) FOR LTE1800/LTE2100/NR/
LTE2600/NR3600 AND RFS LCF114-50J
FEEDERS (2 OFF) FOR LTE700/NR850

PROPOSED SIGNS UV STABLE STICKERS AND FIXED
TO REAR OF ALL TELSTRA PANEL ANTENNAS
EXISTING TELSTRA EQUIPMENT SHELTER TO ACCOMMODATE PROPOSED
TELSTRA EQUIPMENT. REFER TO SHEET E1 FOR DETAILS

EXISTING TELSTRA SECTOR 3 ANTENNAS AND
MOUNTS ARE TO BE RECOVERED AND PROPOSED
STRUCTURE WILL BE INSTALLED BEHIND SECTOR 1

▽ E.L. 25.85m (±100mm) R.L. 108.3m AHD
TOP OF FIRE STAIR ROOF SLAB

4.5m HIGH WALL (CUT-
AWAY FOR CLARITY)

- ▽ E.L. 28.35m (±100mm) R.L. 110.8m AHD
OVERALL HEIGHT
- ▽ E.L. 27.85m (±100mm) R.L. 110.3m AHD
C/L PROPOSED TELSTRA NR3600 PANEL ANTENNA (1 OFF A5)
C/L EXISTING TELSTRA W/B RRU INTERFACE JUNCTION BOX (1 OFF)
- ▽ E.L. 27.2m (±100mm) R.L. 109.65m AHD
C/L PROPOSED TELSTRA LTE700/NR850 TMA (1 OFF)
- ▽ E.L. 26.9m (±100mm) R.L. 109.35m AHD
C/L PROPOSED TELSTRA LTE700/NR850/LTE1800/
LTE2100NR/LTE2600 PANEL ANTENNA (1 OFF A2)
- ▽ E.L. 26.1m (±100mm) R.L. 108.55m AHD
C/L PROPOSED TELSTRA LTE700/NR850 TMA (1 OFF)
- ▽ E.L. 23.7m (±100mm) R.L. 106.15m AHD
TOP OF WALL
- ▽ E.L. 23.00m (±100mm) R.L. 105.45m AHD
BASE OF PROPOSED LTE700 GPS ANTENNA (1 OFF A10)
- ▽ E.L. 22.8m (±100mm) R.L. 105.25m AHD
C/L PROPOSED TELSTRA LTE1800/LTE2100/NR/LTE2600
RADIO4485 (B3/B1/B7) (1 OFF)

- EXISTING TELSTRA LTE700/WCDMA850/LTE2600 PANEL ANTENNAS (3 OFF
A1, A2 & A3) TO BE RECOVERED
EXISTING TELSTRA NR3500 PANEL ANTENNAS (3 OFF A4, A5 & A6) TO BE
RECOVERED
EXISTING TELSTRA LTE1800/LTE2100 PANEL ANTENNAS (3 OFF A7, A8 &
A9) TO BE RECOVERED
EXISTING TELSTRA LTE2600 RRUS 32 B7 (3 OFF) TO BE RECOVERED
EXISTING TELSTRA LTE1800/LTE2100 RADIO4443 B1/B3 (3 OFF) TO BE
RECOVERED
EXISTING TELSTRA RFS RRU INTERFACE BOXES 4P16F (3 OFF) TO BE
RECOVERED
EXISTING TELSTRA LTE700/WCDMA850 TMA'S (3 OFF) TO BE RECOVERED

NOTES:

- ALL EXTERNAL FEEDERS AND TAILS ARE BIRD PROOFED AS PER
EXTERNAL PLANT POLICY 003615.
- FOR SITE SPECIFIC NOTES REFER TO SHEETS S0, S0-1 & S0-2.
- FOR EME SIGNS NOTED THUS [X] REFER 005486 FOR DETAILS.
- ALL DIMENSIONS ARE IN MILLIMETERS UNLESS SPECIFIED OTHERWISE.

SOUTH WEST ELEVATION

SCALE 1:250

5m 0 5m 10m SCALE 1:250

MDF ROOM ON
BASEMENT LEVEL
EXISTING TELSTRA SURFACE
POWER & FIBRE ROUTE

▽ E.L. -03.20m
BASEMENT LEVEL
(R.L. 79.25m AHD)
▽ E.L. 0.00m
GROUND LEVEL
(R.L. 82.45m AHD)

NOTE: THIS DRAWING TO BE READ IN CONJUNCTION WITH SHEET S3-1

FOR CONSTRUCTION

CYIENT

Level-14, 333 Collins Street, Melbourne, Victoria 3000 Australia
T +61 3 8605 4815 | www.cyient.com

ORDER	DRWN	CHKD	AMENDMENT	EXAM	APPD	DATE	ISS
NA13832.01	ES	ES	72204548-LTE1800-AS BUILT-WO1-ERIC	ES	BDB	25.03.14	5
NA15604.01	MH	AK	AS BUILT - 30051137W0029TELSTRA - LTE700	LY	CG	22.01.16	6
NA18834.01	MT	BJ	AS BUILT - 30069071W0430SSNC - LTE2100 / LTE2600	KV	DG	29.01.19	7
NA21224.01	KA	GM	FOR CONSTRUCTION - 30084105W0105CYI - NR3600	MB	JY	16.04.20	8
NA21224.01	CU	SK	AS BUILT - 30084105W0149CYI - NR3600	KSK	DG	22.09.20	9
NA28642.01	TE	MB	FOR CONSTRUCTION - 80005689W0224CYI - NR850/NR2600/NR3600	XX	XX	12.08.26	10

© Telstra Limited ACN 086 174 781 All rights reserved.




MOBILE NETWORK SITE 288399
BELLA VISTA 29-31 LEXINGTON DR
SOUTH WEST ELEVATION
29-31 LEXINGTON DRIVE, BELLA VISTA, NSW 2153

DWG
NO.

N109732

SHT
NO. S3

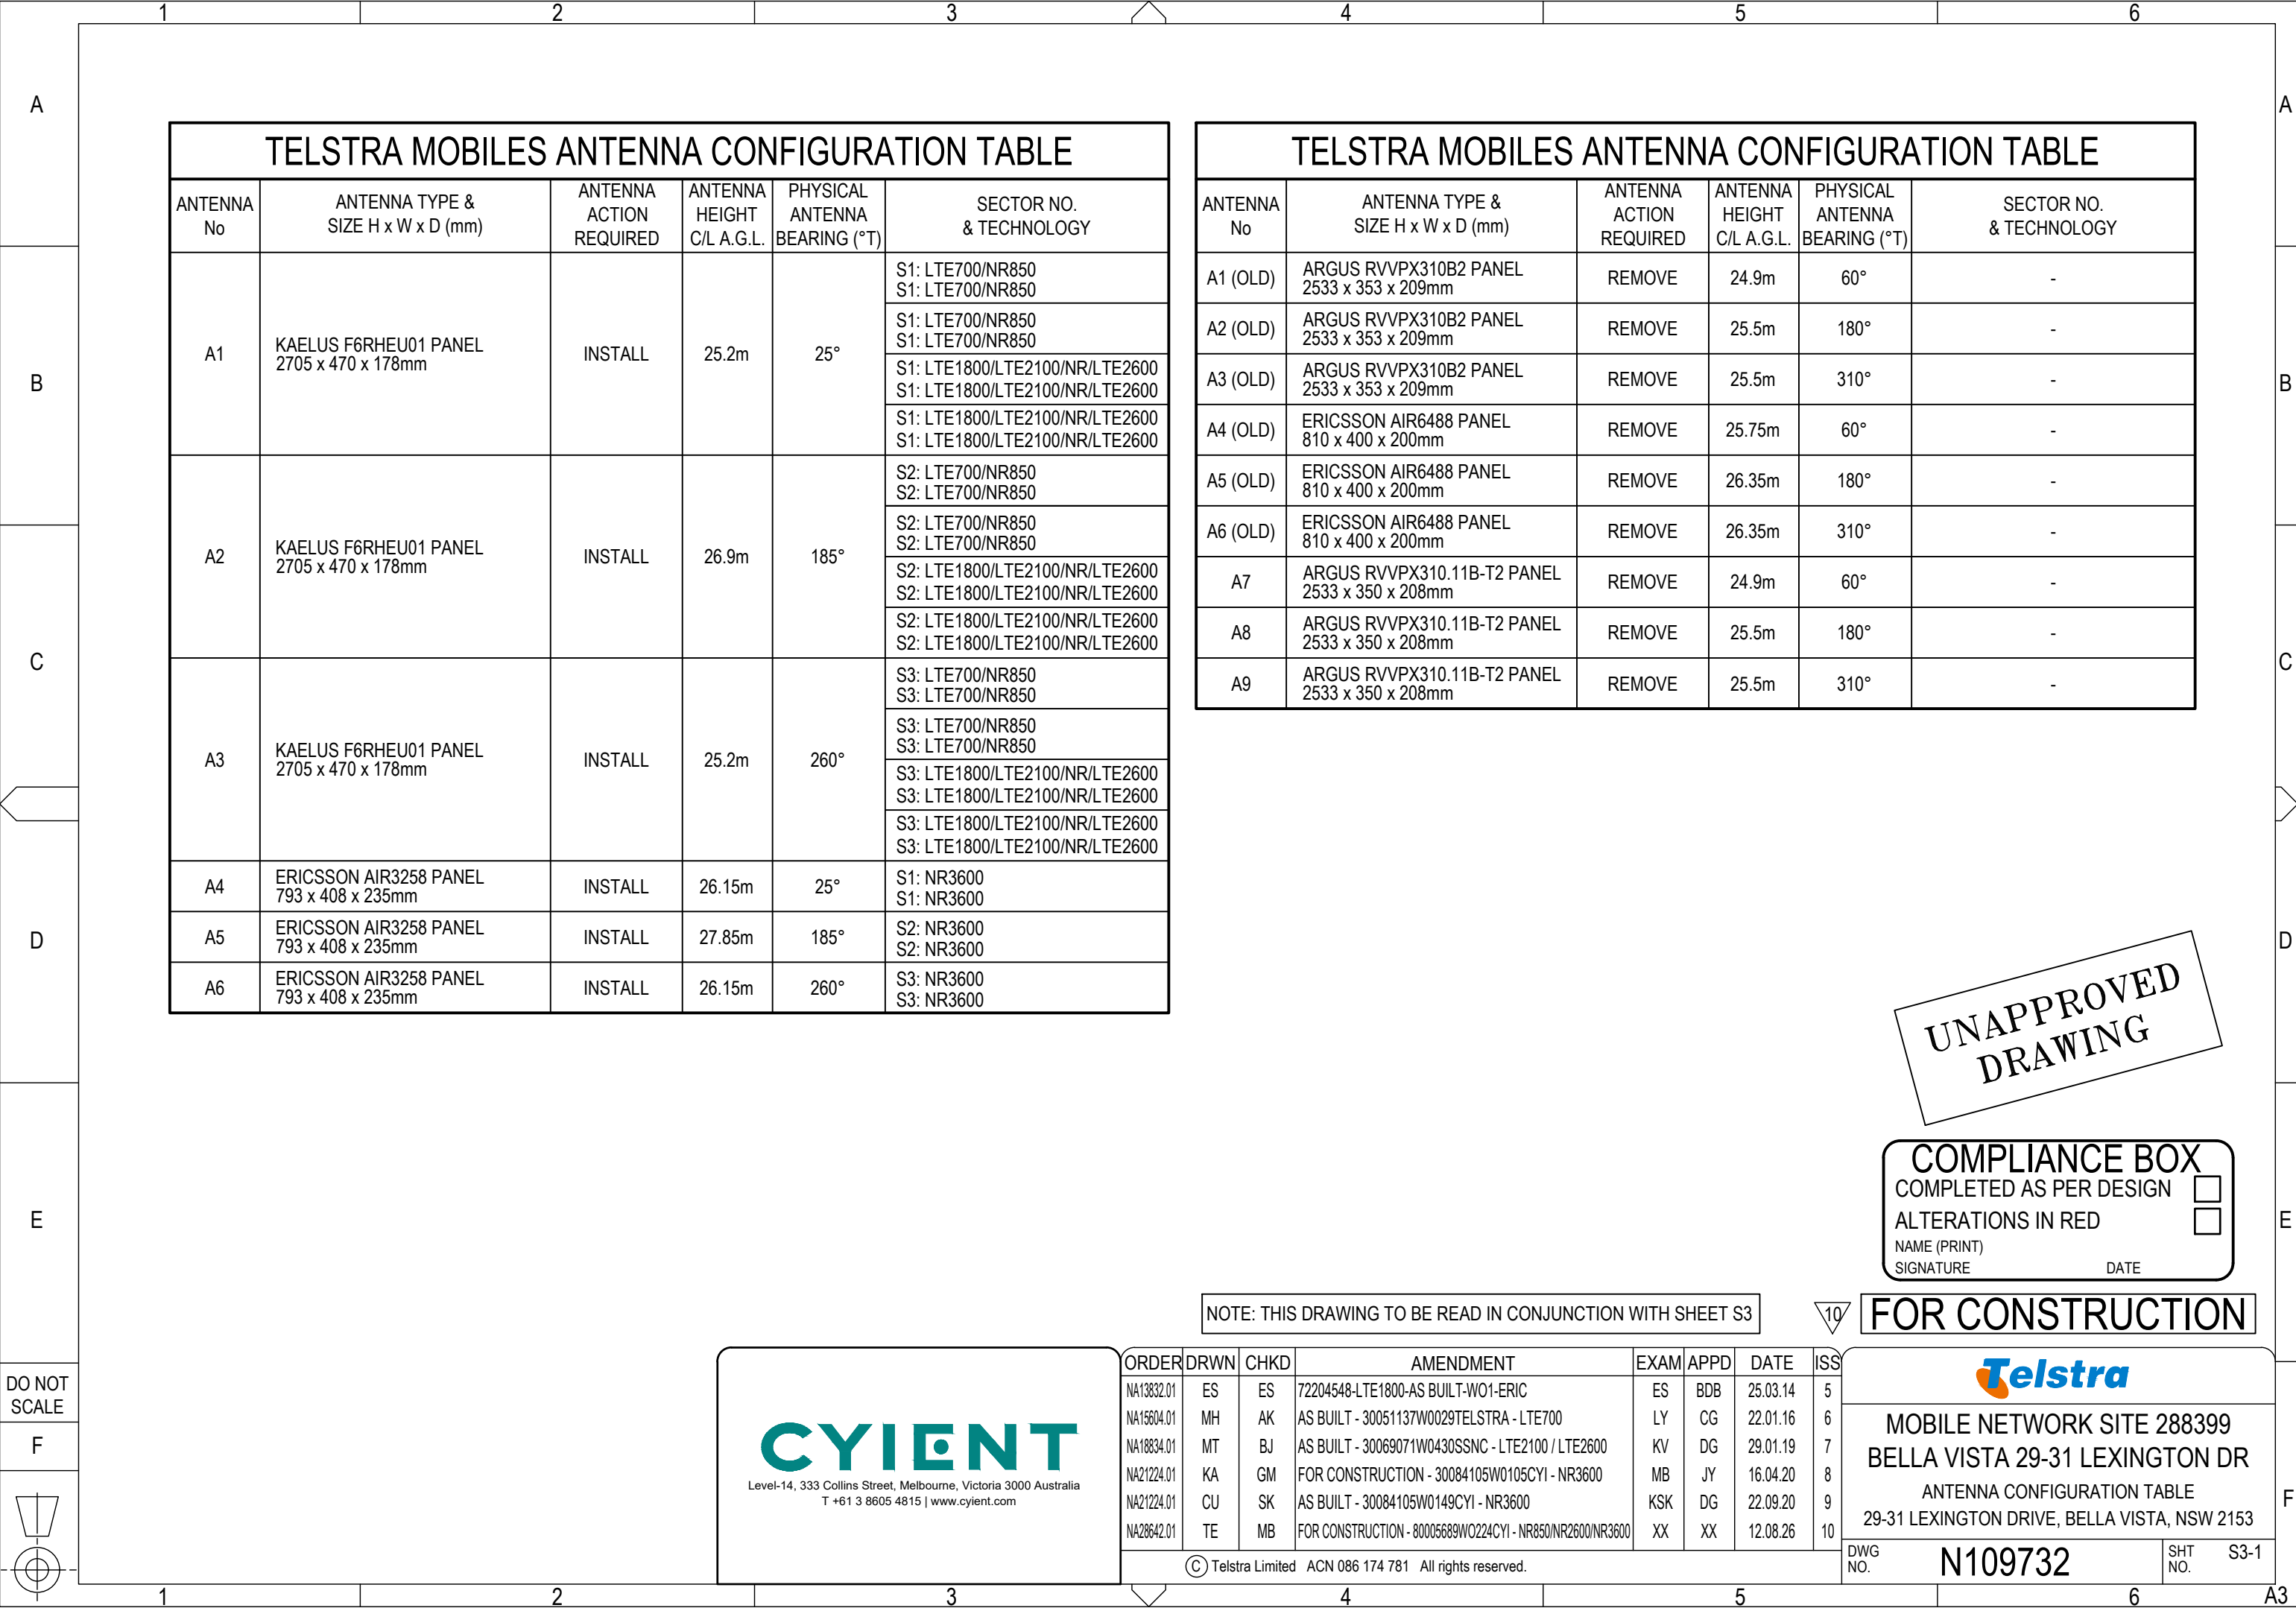

TELSTRA MOBILES ANTENNA CONFIGURATION TABLE

ANTENNA No	ANTENNA TYPE & SIZE H x W x D (mm)	ANTENNA ACTION REQUIRED	ANTENNA HEIGHT C/L A.G.L.	PHYSICAL ANTENNA BEARING (°T)	SECTOR NO. & TECHNOLOGY
A1	KAELUS F6RHEU01 PANEL 2705 x 470 x 178mm	INSTALL	25.2m	25°	S1: LTE700/NR850 S1: LTE700/NR850
					S1: LTE700/NR850 S1: LTE700/NR850
					S1: LTE1800/LTE2100/NR/LTE2600 S1: LTE1800/LTE2100/NR/LTE2600
					S1: LTE1800/LTE2100/NR/LTE2600 S1: LTE1800/LTE2100/NR/LTE2600
A2	KAELUS F6RHEU01 PANEL 2705 x 470 x 178mm	INSTALL	26.9m	185°	S2: LTE700/NR850 S2: LTE700/NR850
					S2: LTE700/NR850 S2: LTE700/NR850
					S2: LTE1800/LTE2100/NR/LTE2600 S2: LTE1800/LTE2100/NR/LTE2600
					S2: LTE1800/LTE2100/NR/LTE2600 S2: LTE1800/LTE2100/NR/LTE2600
A3	KAELUS F6RHEU01 PANEL 2705 x 470 x 178mm	INSTALL	25.2m	260°	S3: LTE700/NR850 S3: LTE700/NR850
					S3: LTE700/NR850 S3: LTE700/NR850
					S3: LTE1800/LTE2100/NR/LTE2600 S3: LTE1800/LTE2100/NR/LTE2600
					S3: LTE1800/LTE2100/NR/LTE2600 S3: LTE1800/LTE2100/NR/LTE2600
A4	ERICSSON AIR3258 PANEL 793 x 408 x 235mm	INSTALL	26.15m	25°	S1: NR3600 S1: NR3600
A5	ERICSSON AIR3258 PANEL 793 x 408 x 235mm	INSTALL	27.85m	185°	S2: NR3600 S2: NR3600
A6	ERICSSON AIR3258 PANEL 793 x 408 x 235mm	INSTALL	26.15m	260°	S3: NR3600 S3: NR3600

TELSTRA MOBILES ANTENNA CONFIGURATION TABLE

ANTENNA No	ANTENNA TYPE & SIZE H x W x D (mm)	ANTENNA ACTION REQUIRED	ANTENNA HEIGHT C/L A.G.L.	PHYSICAL ANTENNA BEARING (°T)	SECTOR NO. & TECHNOLOGY
A1 (OLD)	ARGUS RVVPX310B2 PANEL 2533 x 353 x 209mm	REMOVE	24.9m	60°	-
A2 (OLD)	ARGUS RVVPX310B2 PANEL 2533 x 353 x 209mm	REMOVE	25.5m	180°	-
A3 (OLD)	ARGUS RVVPX310B2 PANEL 2533 x 353 x 209mm	REMOVE	25.5m	310°	-
A4 (OLD)	ERICSSON AIR6488 PANEL 810 x 400 x 200mm	REMOVE	25.75m	60°	-
A5 (OLD)	ERICSSON AIR6488 PANEL 810 x 400 x 200mm	REMOVE	26.35m	180°	-
A6 (OLD)	ERICSSON AIR6488 PANEL 810 x 400 x 200mm	REMOVE	26.35m	310°	-
A7	ARGUS RVVPX310.11B-T2 PANEL 2533 x 350 x 208mm	REMOVE	24.9m	60°	-
A8	ARGUS RVVPX310.11B-T2 PANEL 2533 x 350 x 208mm	REMOVE	25.5m	180°	-
A9	ARGUS RVVPX310.11B-T2 PANEL 2533 x 350 x 208mm	REMOVE	25.5m	310°	-

UNAPPROVED
DRAWING

COMPLIANCE BOX

COMPLETED AS PER DESIGN ☐

ALTERATIONS IN RED ☐

NAME (PRINT)

SIGNATURE

DATE

NOTE: THIS DRAWING TO BE READ IN CONJUNCTION WITH SHEET S3

FOR CONSTRUCTION

CYIENT

Level-14, 333 Collins Street, Melbourne, Victoria 3000 Australia
T +61 3 8605 4815 | www.cyient.com

ORDER	DRWN	CHKD	AMENDMENT	EXAM	APPD	DATE	ISS
NA13832.01	ES	ES	72204548-LTE1800-AS BUILT-WO1-ERIC	ES	BDB	25.03.14	5
NA15604.01	MH	AK	AS BUILT - 30051137W0029TELSTRA - LTE700	LY	CG	22.01.16	6
NA18834.01	MT	BJ	AS BUILT - 30069071W0430SSNC - LTE2100 / LTE2600	KV	DG	29.01.19	7
NA21224.01	KA	GM	FOR CONSTRUCTION - 30084105W0105CYI - NR3600	MB	JY	16.04.20	8
NA21224.01	CU	SK	AS BUILT - 30084105W0149CYI - NR3600	KSK	DG	22.09.20	9
NA28642.01	TE	MB	FOR CONSTRUCTION - 80005689W0224CYI - NR850/NR2600/NR3600	XX	XX	12.08.26	10

© Telstra Limited ACN 086 174 781 All rights reserved.



MOBILE NETWORK SITE 288399
BELLA VISTA 29-31 LEXINGTON DR
ANTENNA CONFIGURATION TABLE
29-31 LEXINGTON DRIVE, BELLA VISTA, NSW 2153

DWG NO.



N109732

SHT NO.

S3-1


Plan forming Annexure " " to Lease
of PREMISES at BELLA VISTA
by
to
dated the Day of

L.G.A.: THE HILLS SHIRE
Locality: BELLA VISTA
Parish: CASTLE HILL
County: CUMBERLAND

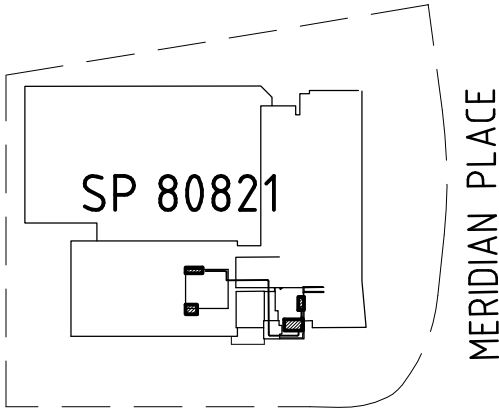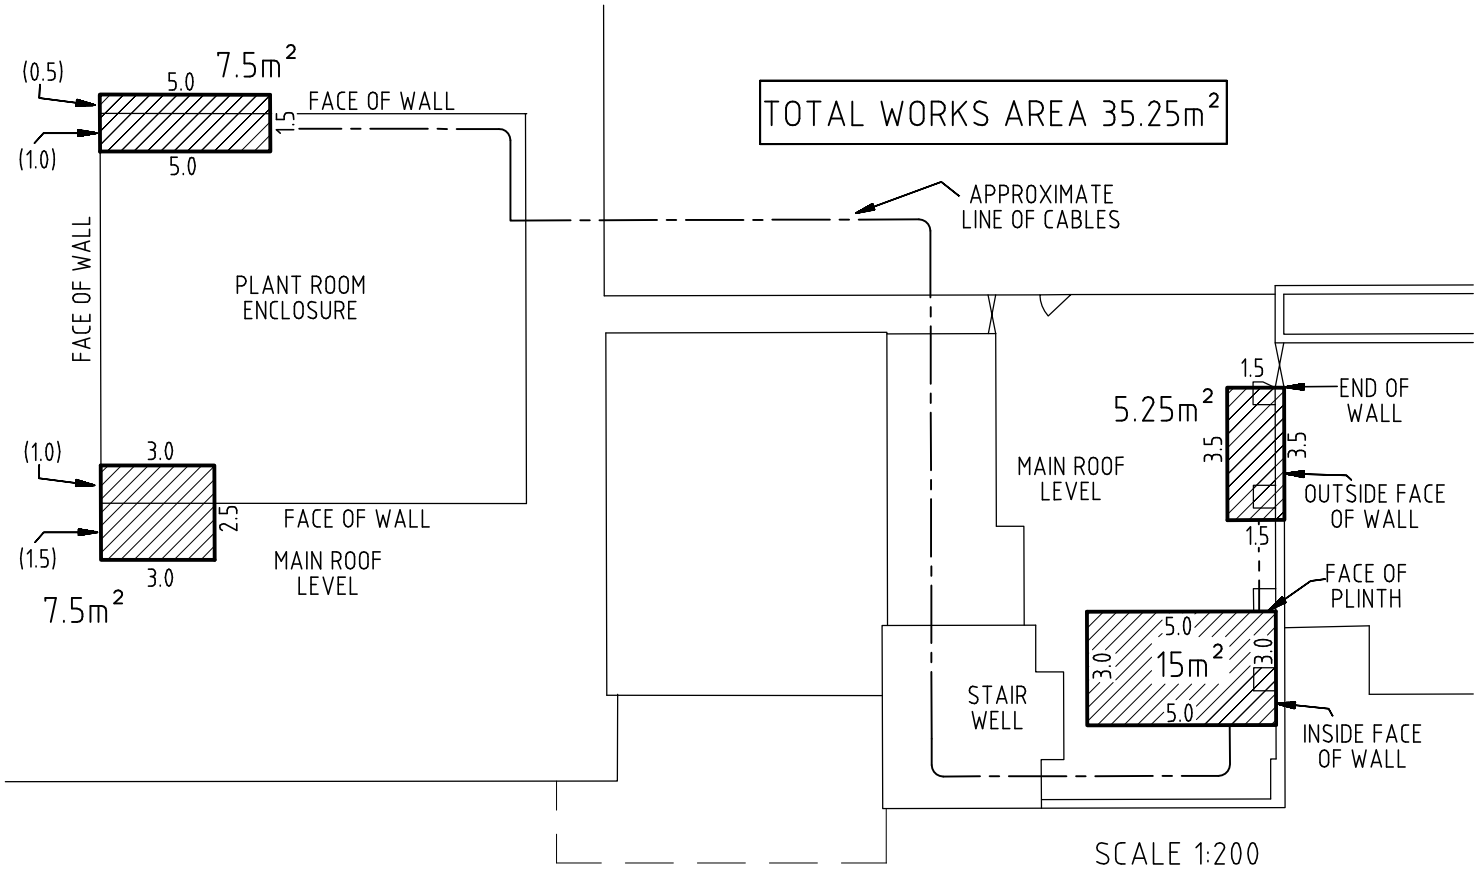

LEXINGTON DRIVE

PROPERTY DIAGRAM
SCALE 1: 2000

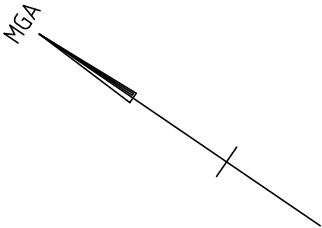

SCALE 1:200

JDE No. ALL DIMENSIONS IN METRES

ORDER	DRAWN	CHKD	AMENDMENT	EXAM	APPD	DATE	ISS
NA13047	KM	CW	Original	GM	GL	6.5.13	1
NA13047	CW	KM	Lease Area Enlarged	GM	GL	25.05.13	2
NA13047	MW	KM	Lease Area Updated	SEJ	MC	30.07.2026	3

TEL (02) 9896 8025
info@suregeo.com.au


CT: CP/SP80821
Owner: STRATA PLAN No 80821
Address: 29 LEXINGTON DRIVE
BELLA VISTA 2153
NOTE: Covenants or Restriction to user
have not been investigated for the
purpose of this plan


© Telstra Corporation Limited ABN 33 051 775 556 All rights reserved.

MOBILE NETWORK SITE 288399
BELLA VISTA 29-31 LEXINGTON DRIVE
SITE TENURE PLAN
29-31 LEXINGTON DRIVE, BELLA VISTA, NSW 2153

DWG NO. N109732

SHT NO. G1 INDEX

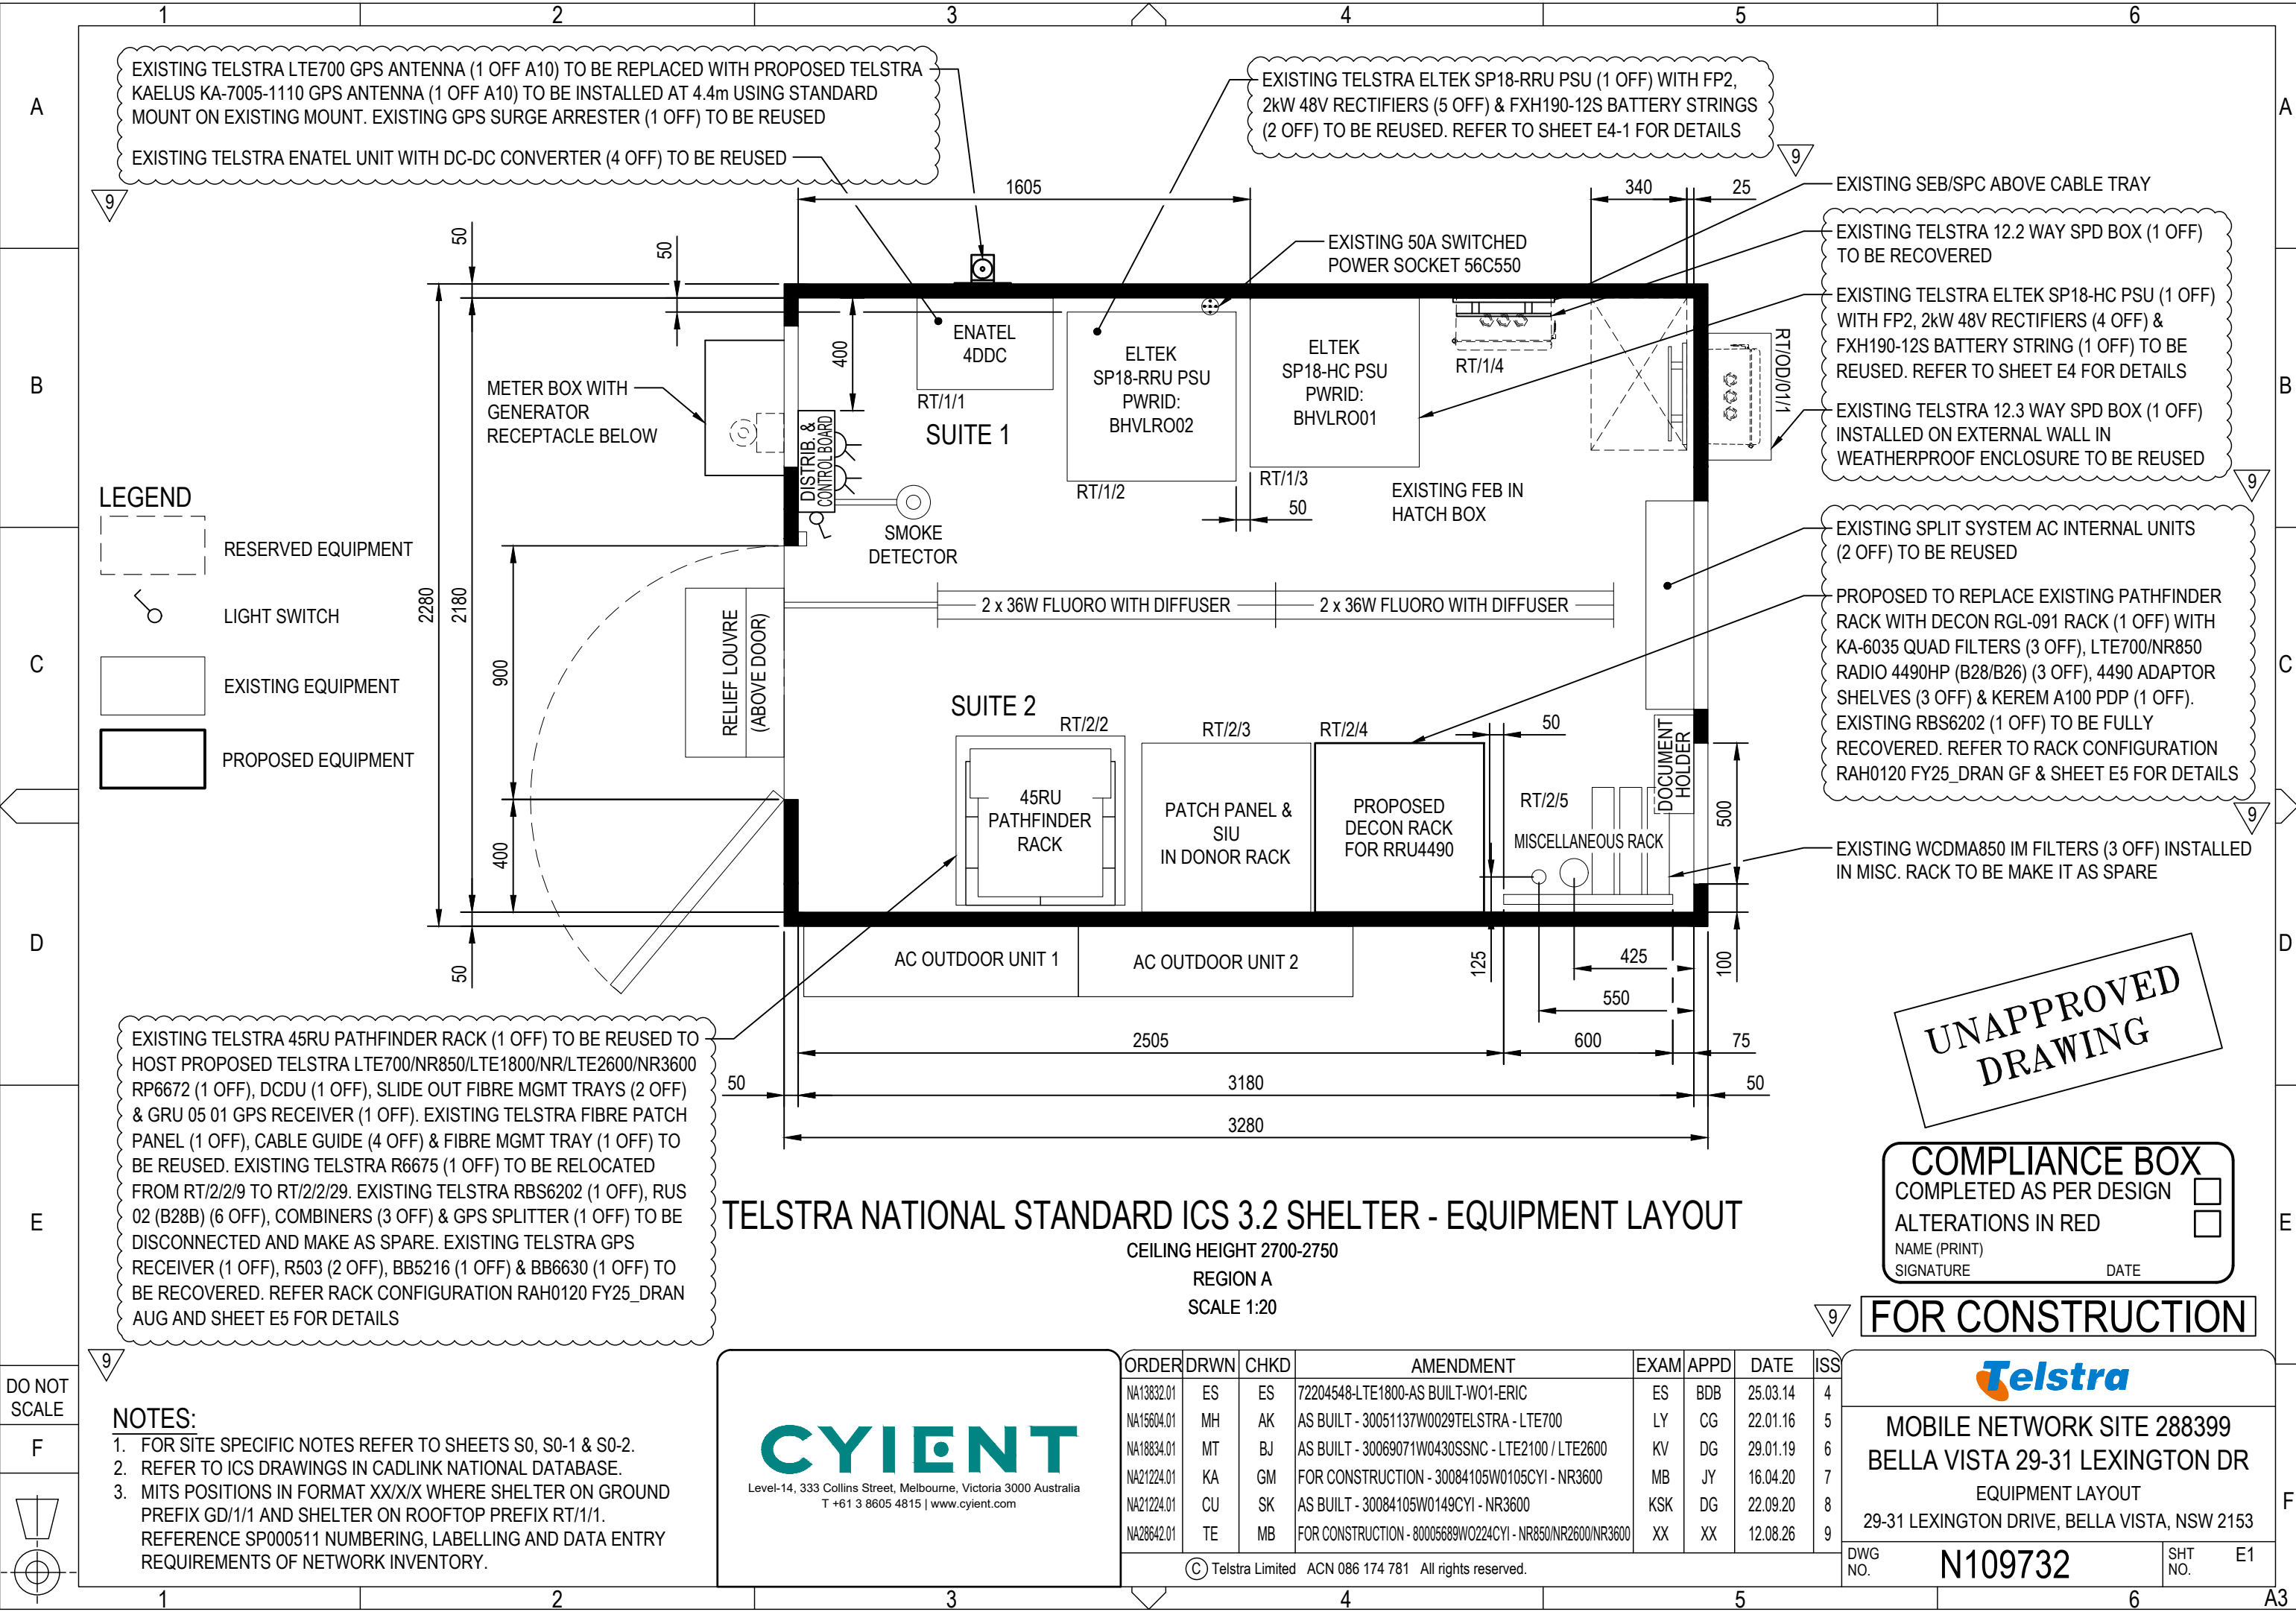

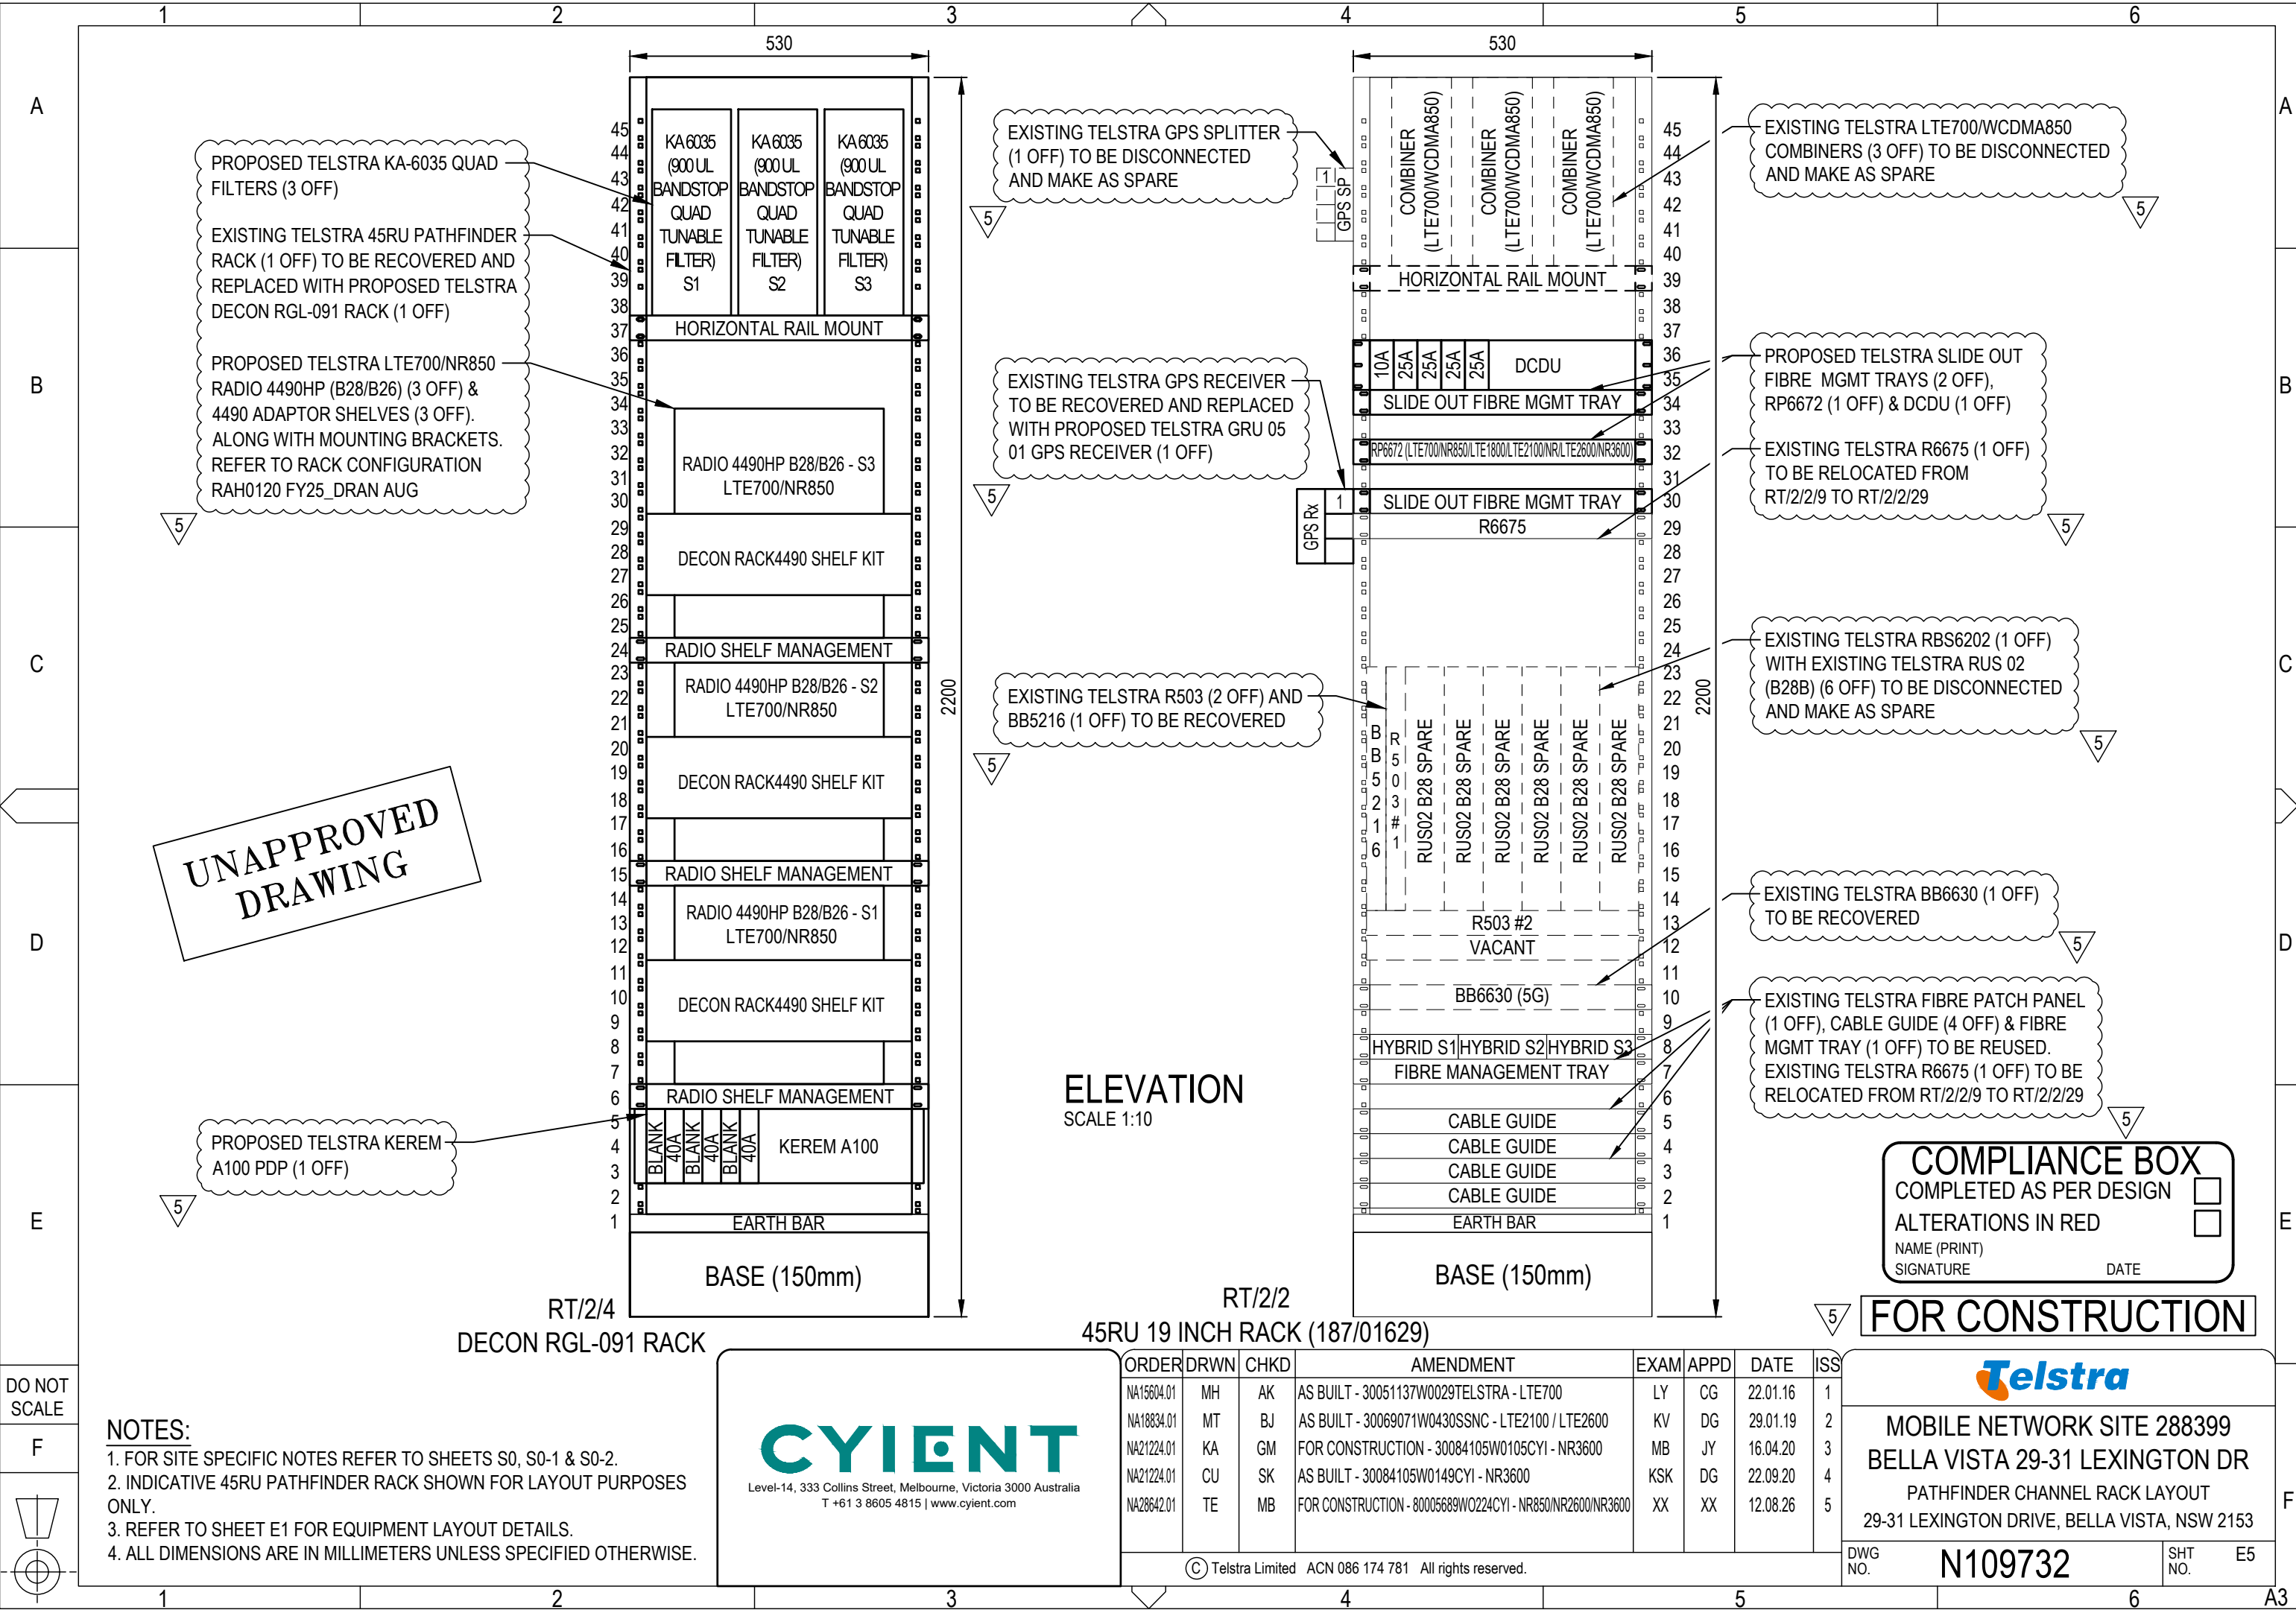

UNAPPROVED
DRAWING

PROPOSED TELSTRA KEREM
A100 PDP (1 OFF)

EXISTING TELSTRA GPS SPLITTER
(1 OFF) TO BE DISCONNECTED
AND MAKE AS SPARE

EXISTING TELSTRA GPS RECEIVER
TO BE RECOVERED AND REPLACED
WITH PROPOSED TELSTRA GRU 05
01 GPS RECEIVER (1 OFF)

EXISTING TELSTRA R503 (2 OFF) AND
BB5216 (1 OFF) TO BE RECOVERED

EXISTING TELSTRA LTE700/WCDMA850
COMBINERS (3 OFF) TO BE DISCONNECTED
AND MAKE AS SPARE

PROPOSED TELSTRA SLIDE OUT
FIBRE MGMT TRAYS (2 OFF),
RP6672 (1 OFF) & DCDU (1 OFF)

EXISTING TELSTRA R6675 (1 OFF)
TO BE RELOCATED FROM
RT/2/2/9 TO RT/2/2/29

EXISTING TELSTRA RBS6202 (1 OFF)
WITH EXISTING TELSTRA RUS 02
(B28B) (6 OFF) TO BE DISCONNECTED
AND MAKE AS SPARE

EXISTING TELSTRA BB6630 (1 OFF)
TO BE RECOVERED

EXISTING TELSTRA FIBRE PATCH PANEL
(1 OFF), CABLE GUIDE (4 OFF) & FIBRE
MGMT TRAY (1 OFF) TO BE REUSED.
EXISTING TELSTRA R6675 (1 OFF) TO BE
RELOCATED FROM RT/2/2/9 TO RT/2/2/29

COMPLIANCE BOX

COMPLETED AS PER DESIGN

ALTERATIONS IN RED

NAME (PRINT)

SIGNATURE

DATE

FOR CONSTRUCTION

- NOTES:
- FOR SITE SPECIFIC NOTES REFER TO SHEETS S0, S0-1 & S0-2.
 - INDICATIVE 45RU PATHFINDER RACK SHOWN FOR LAYOUT PURPOSES ONLY.
 - REFER TO SHEET E1 FOR EQUIPMENT LAYOUT DETAILS.
 - ALL DIMENSIONS ARE IN MILLIMETERS UNLESS SPECIFIED OTHERWISE.

CYIENT

Level-14, 333 Collins Street, Melbourne, Victoria 3000 Australia
T +61 3 8605 4815 | www.cyient.com

ORDER	DRWN	CHKD	AMENDMENT	EXAM	APPD	DATE	ISS
NA15604.01	MH	AK	AS BUILT - 30051137W0029TELSTRA - LTE700	LY	CG	22.01.16	1
NA18834.01	MT	BJ	AS BUILT - 30069071W0430SSNC - LTE2100 / LTE2600	KV	DG	29.01.19	2
NA21224.01	KA	GM	FOR CONSTRUCTION - 30084105W0105CYI - NR3600	MB	JY	16.04.20	3
NA21224.01	CU	SK	AS BUILT - 30084105W0149CYI - NR3600	KSK	DG	22.09.20	4
NA28642.01	TE	MB	FOR CONSTRUCTION - 80005689W0224CYI - NR850/NR2600/NR3600	XX	XX	12.08.26	5

© Telstra Limited ACN 086 174 781 All rights reserved.

MOBILE NETWORK SITE 288399


BELLA VISTA 29-31 LEXINGTON DR

PATHFINDER CHANNEL RACK LAYOUT

29-31 LEXINGTON DRIVE, BELLA VISTA, NSW 2153

DWG NO. N109732

SHT NO. E5

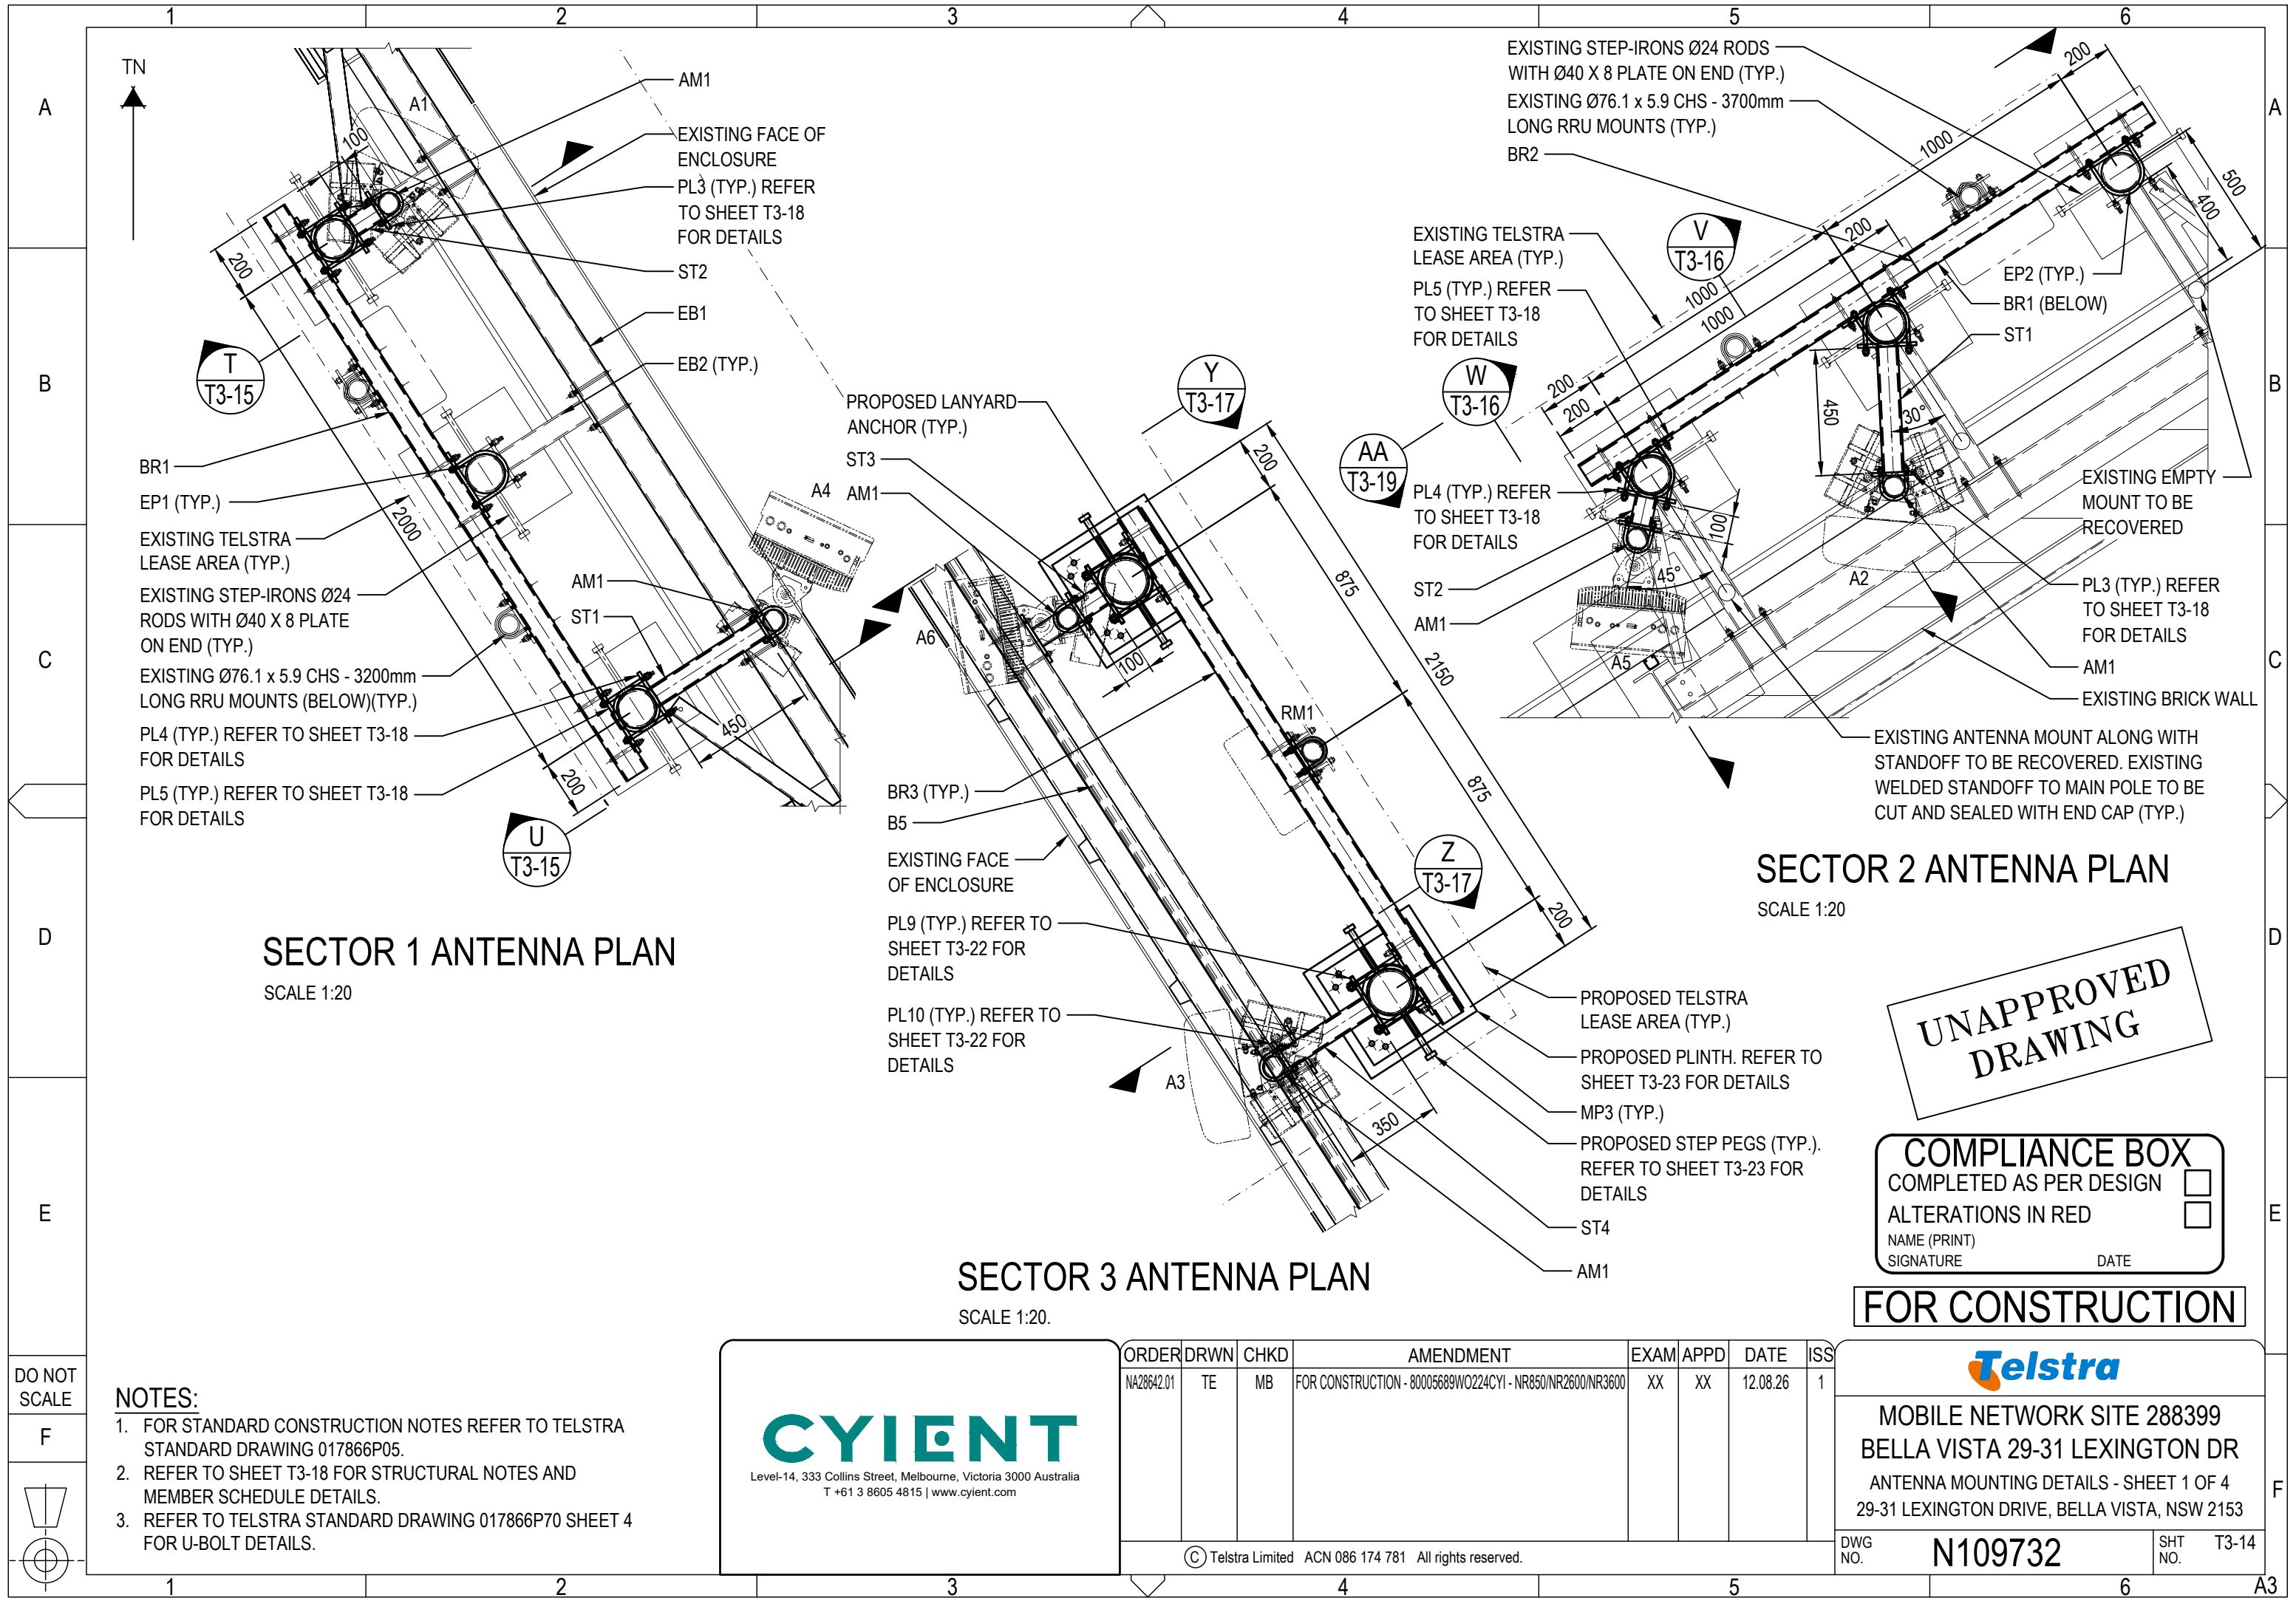

SECTOR 1 ANTENNA PLAN
SCALE 1:20

SECTOR 2 ANTENNA PLAN
SCALE 1:20

SECTOR 3 ANTENNA PLAN
SCALE 1:20.

UNAPPROVED
DRAWING

COMPLIANCE BOX

COMPLETED AS PER DESIGN

ALTERATIONS IN RED

NAME (PRINT)

SIGNATURE

DATE

FOR CONSTRUCTION



MOBILE NETWORK SITE 288399
BELLA VISTA 29-31 LEXINGTON DR
ANTENNA MOUNTING DETAILS - SHEET 1 OF 4
29-31 LEXINGTON DRIVE, BELLA VISTA, NSW 2153

N109732


SHT NO. T3-14


- NOTES:
- FOR STANDARD CONSTRUCTION NOTES REFER TO TELSTRA STANDARD DRAWING 017866P05.
 - REFER TO SHEET T3-18 FOR STRUCTURAL NOTES AND MEMBER SCHEDULE DETAILS.
 - REFER TO TELSTRA STANDARD DRAWING 017866P70 SHEET 4 FOR U-BOLT DETAILS.


CYIENT
Level-14, 333 Collins Street, Melbourne, Victoria 3000 Australia
T +61 3 8605 4815 | www.cyient.com

ORDER	DRWN	CHKD	AMENDMENT	EXAM	APPD	DATE	ISS
NA28642.01	TE	MB	FOR CONSTRUCTION - 80005689WO224CYI - NR850/NR2600/NR3600	XX	XX	12.08.26	1

© Telstra Limited ACN 086 174 781 All rights reserved.

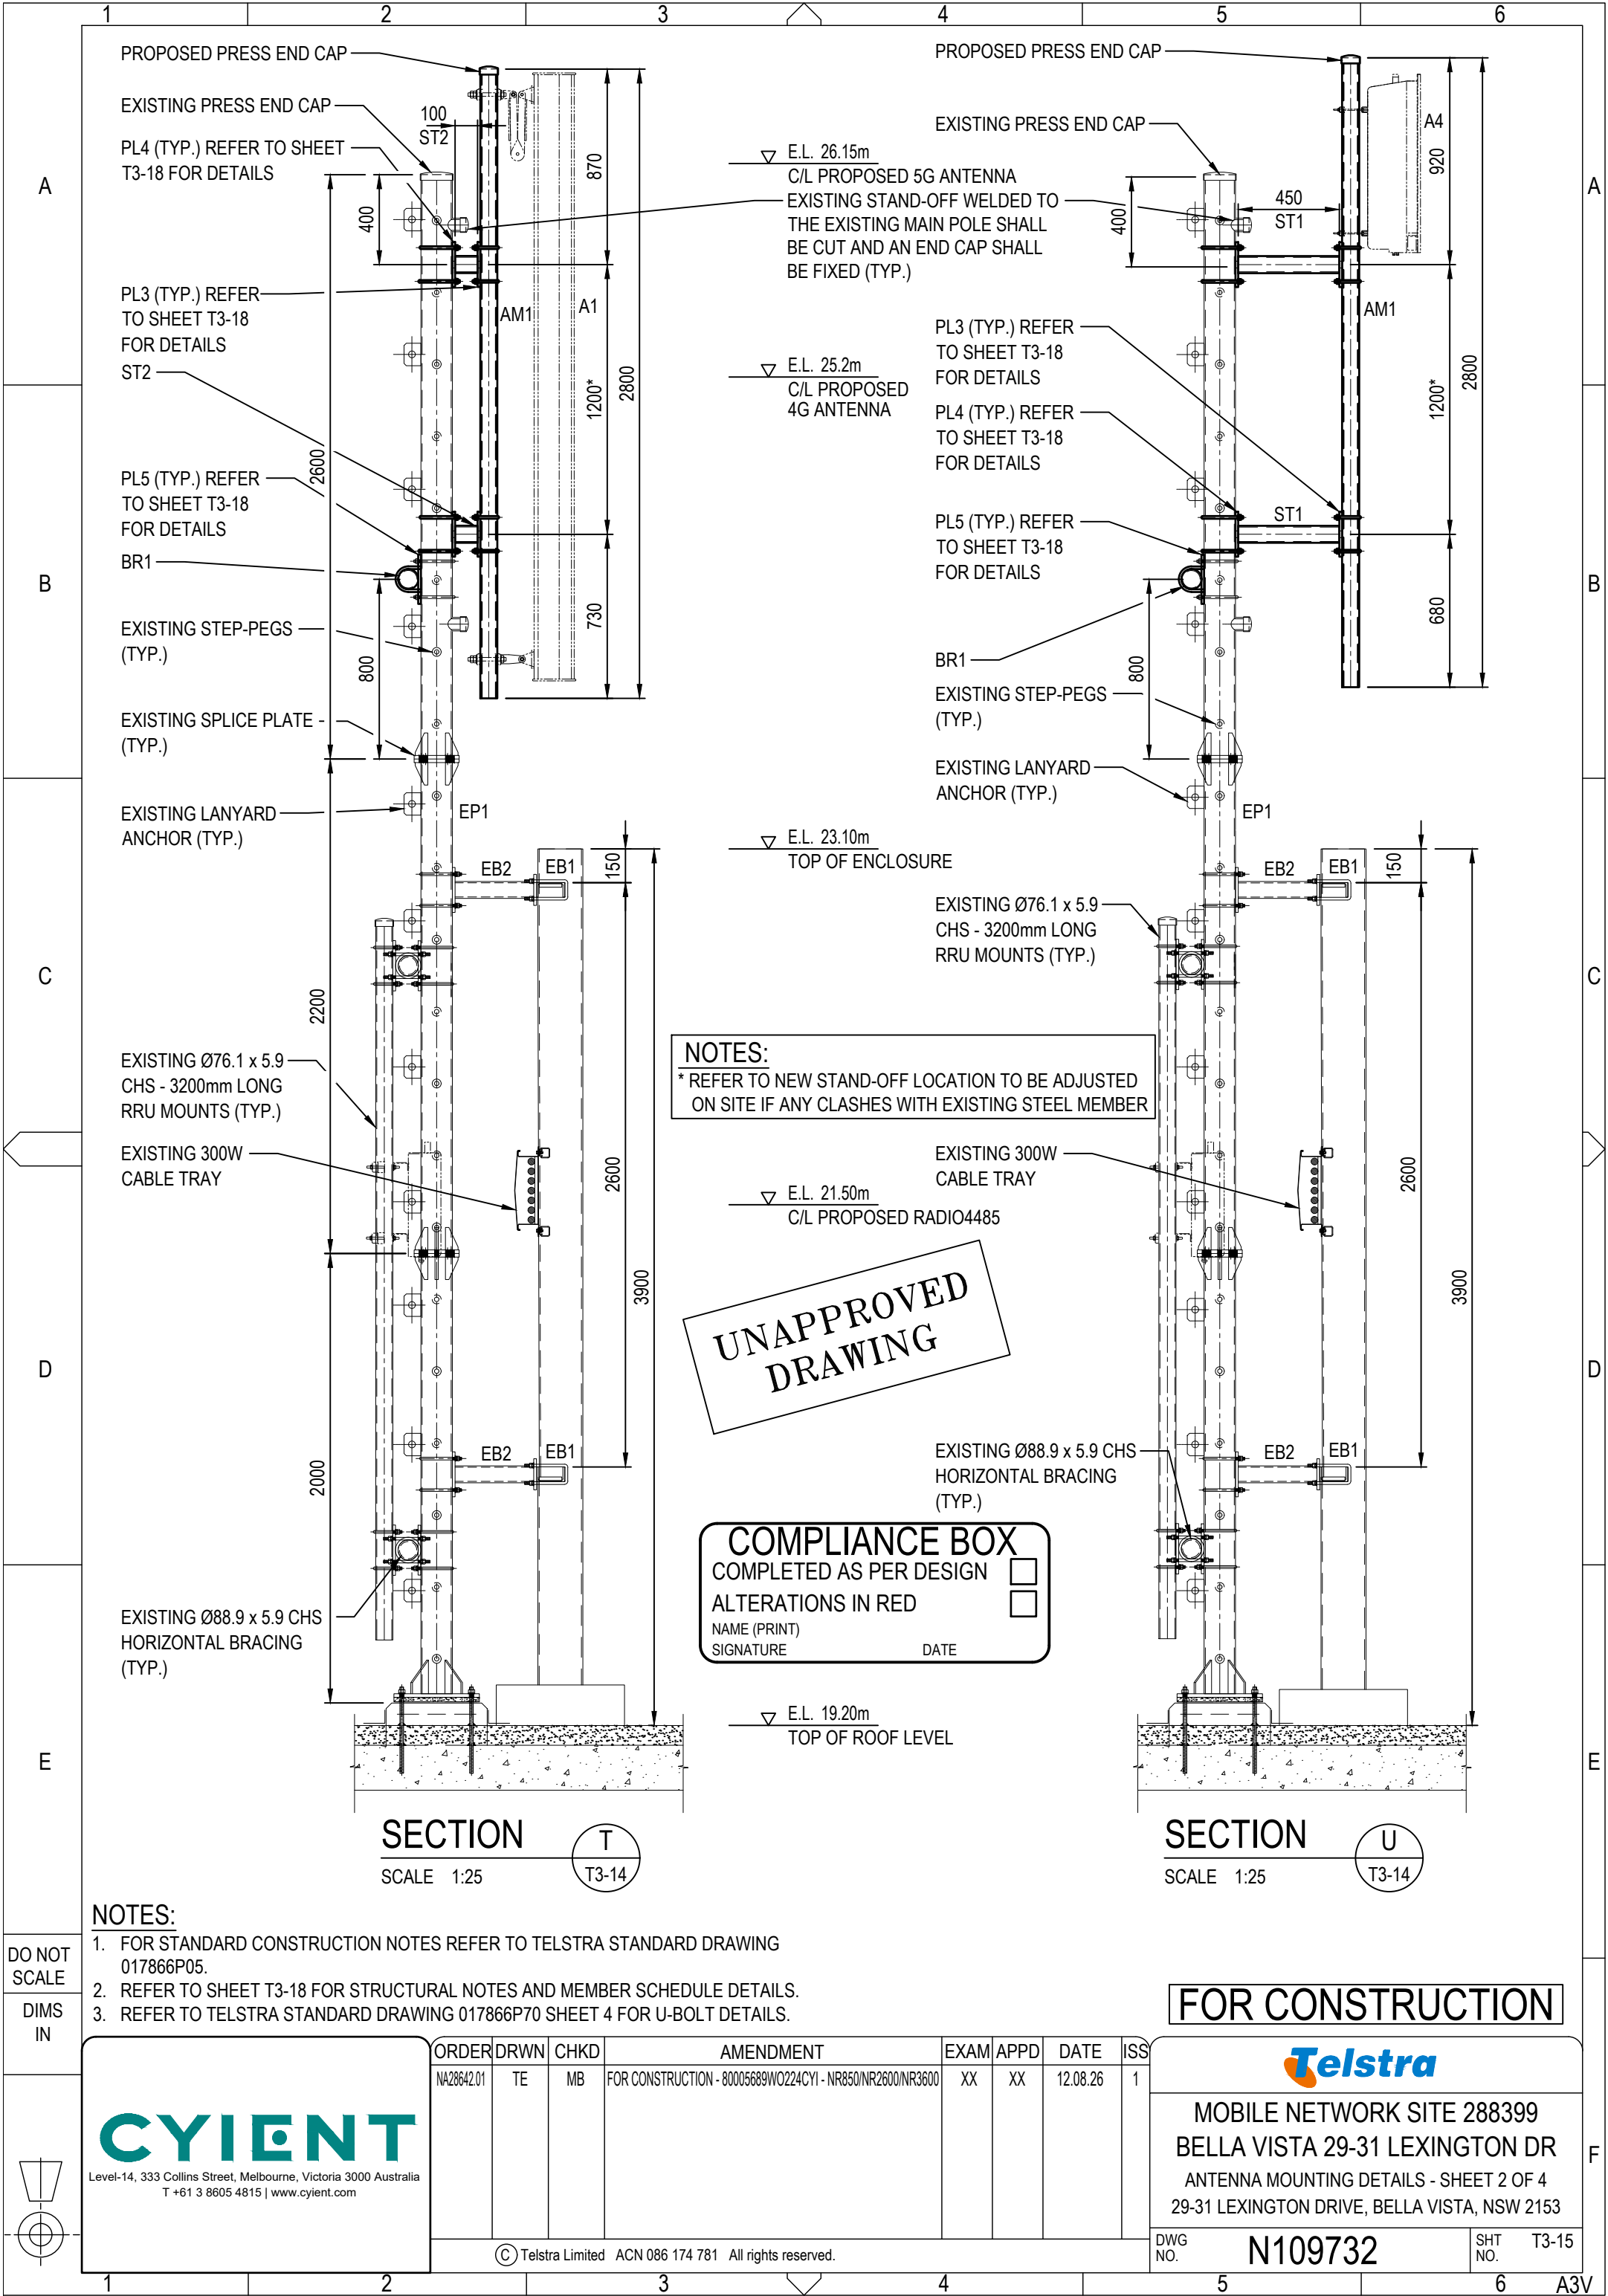

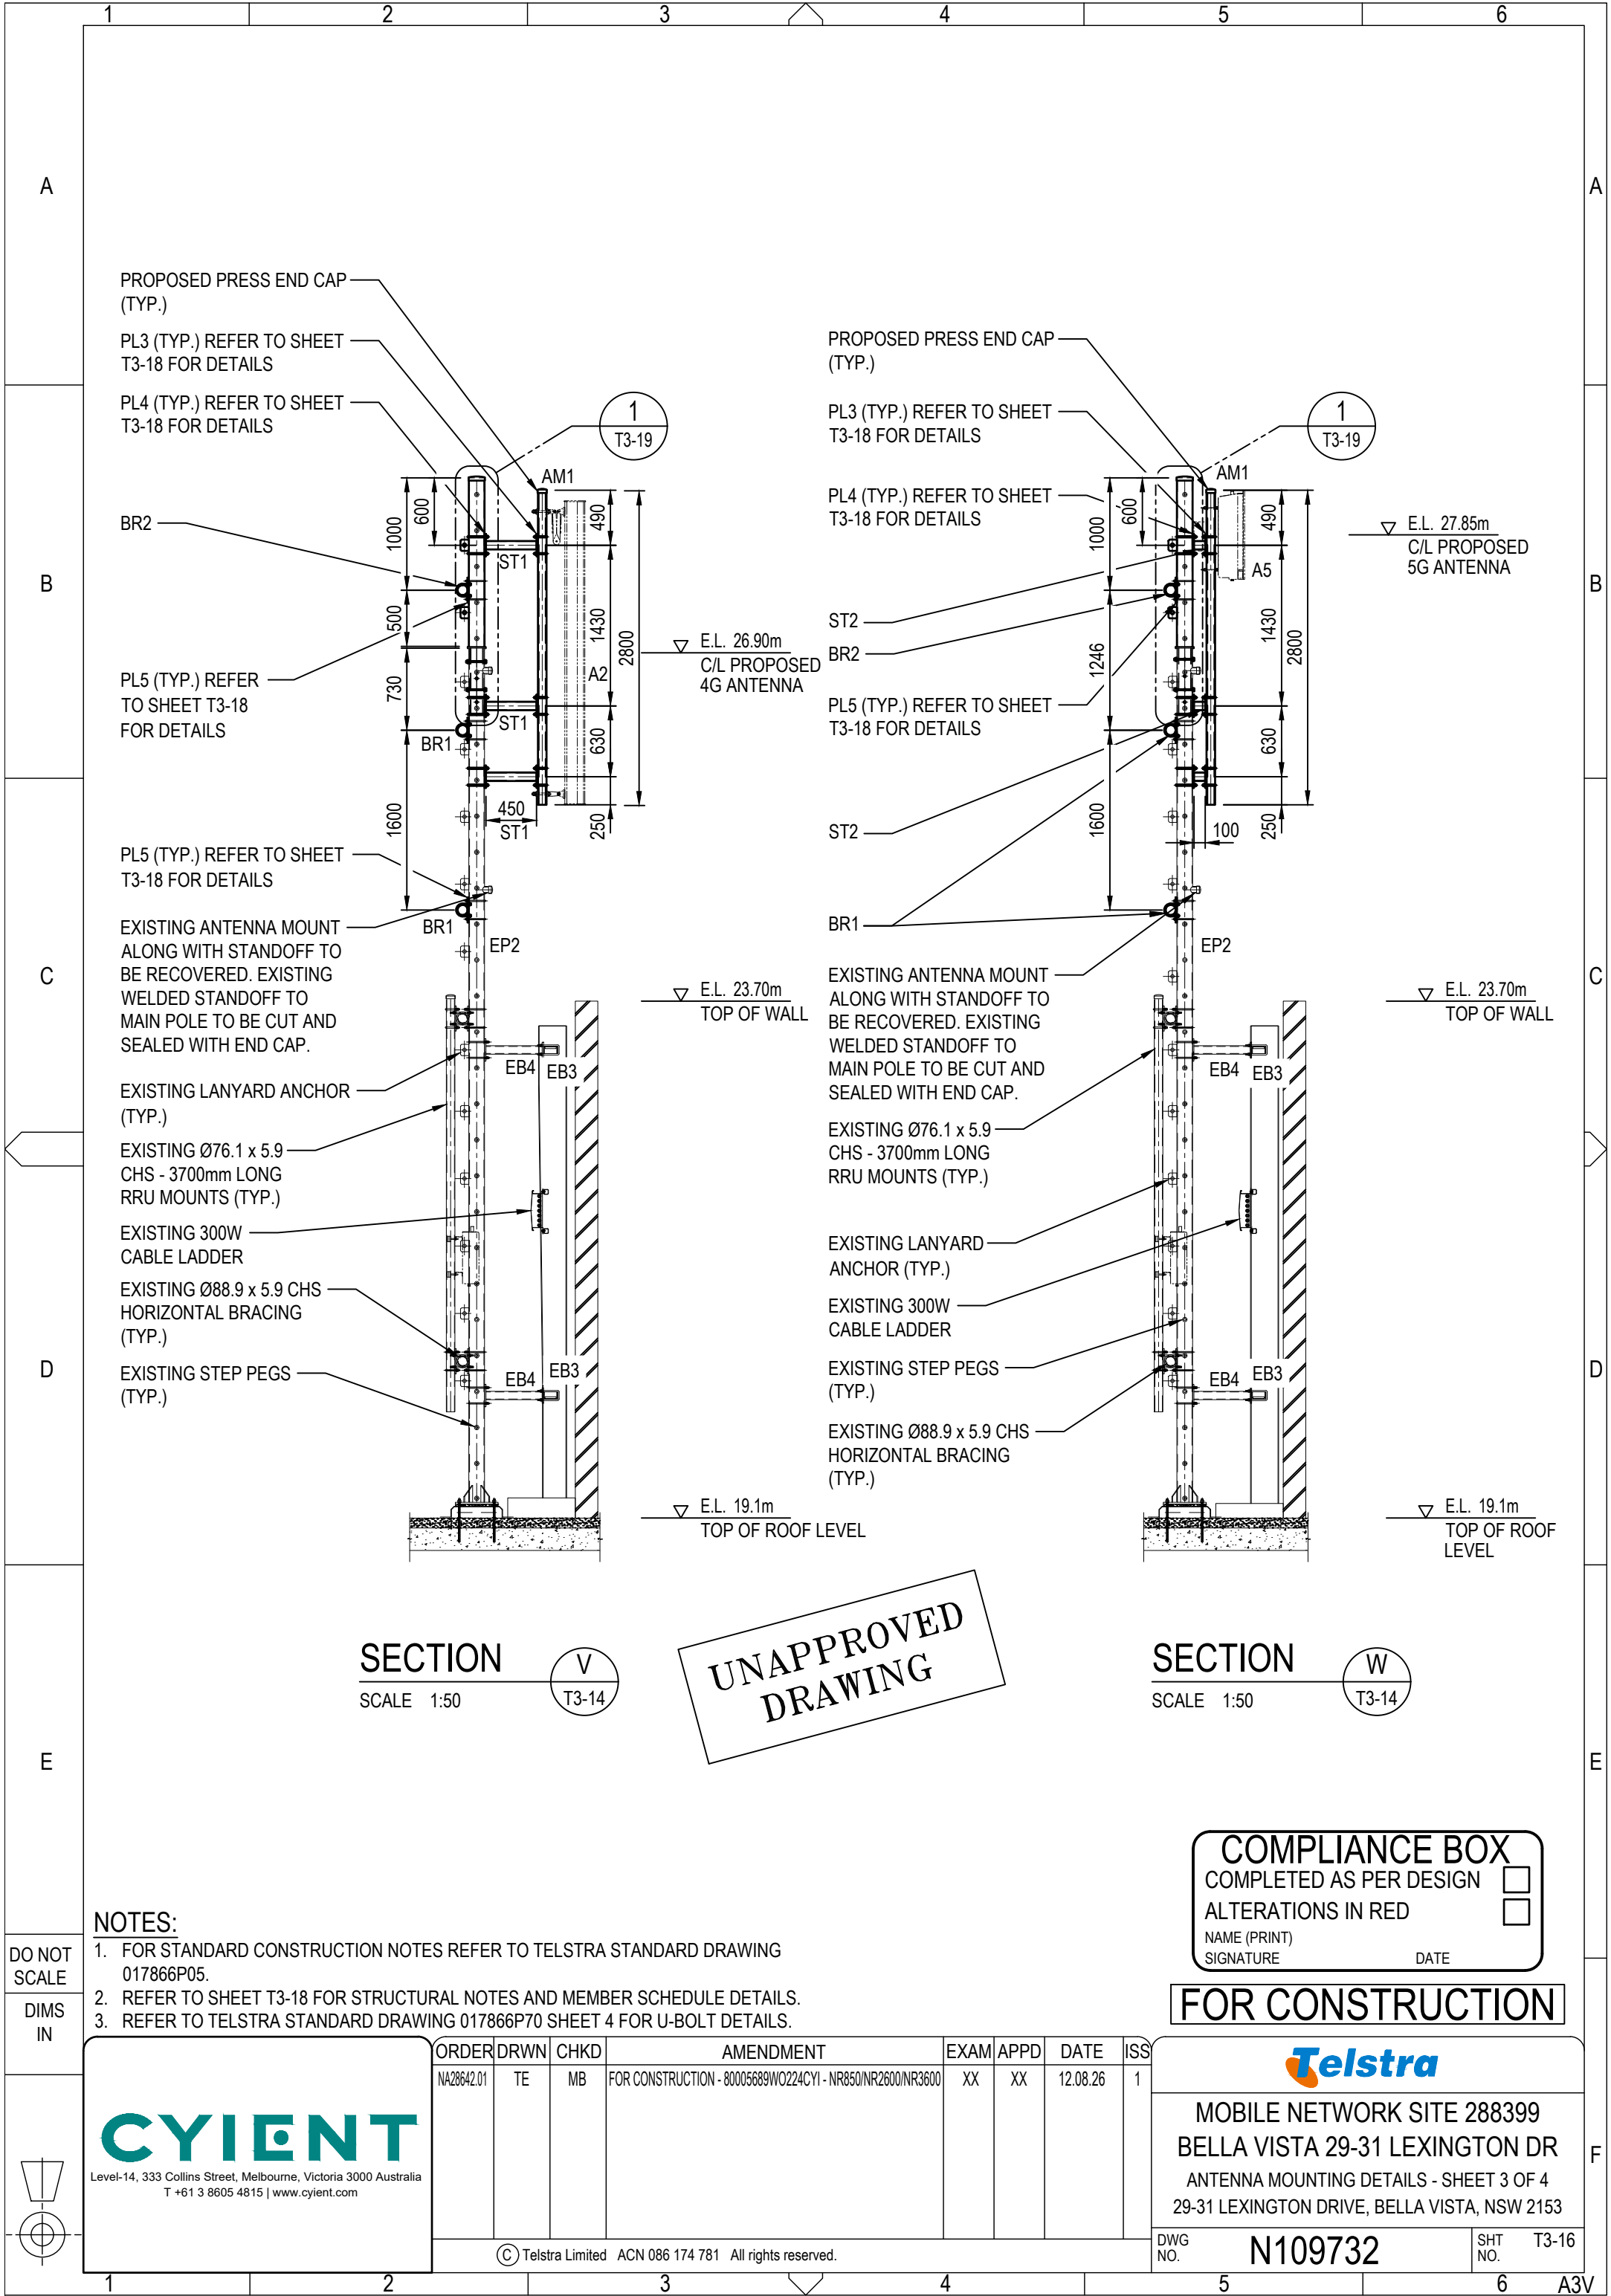

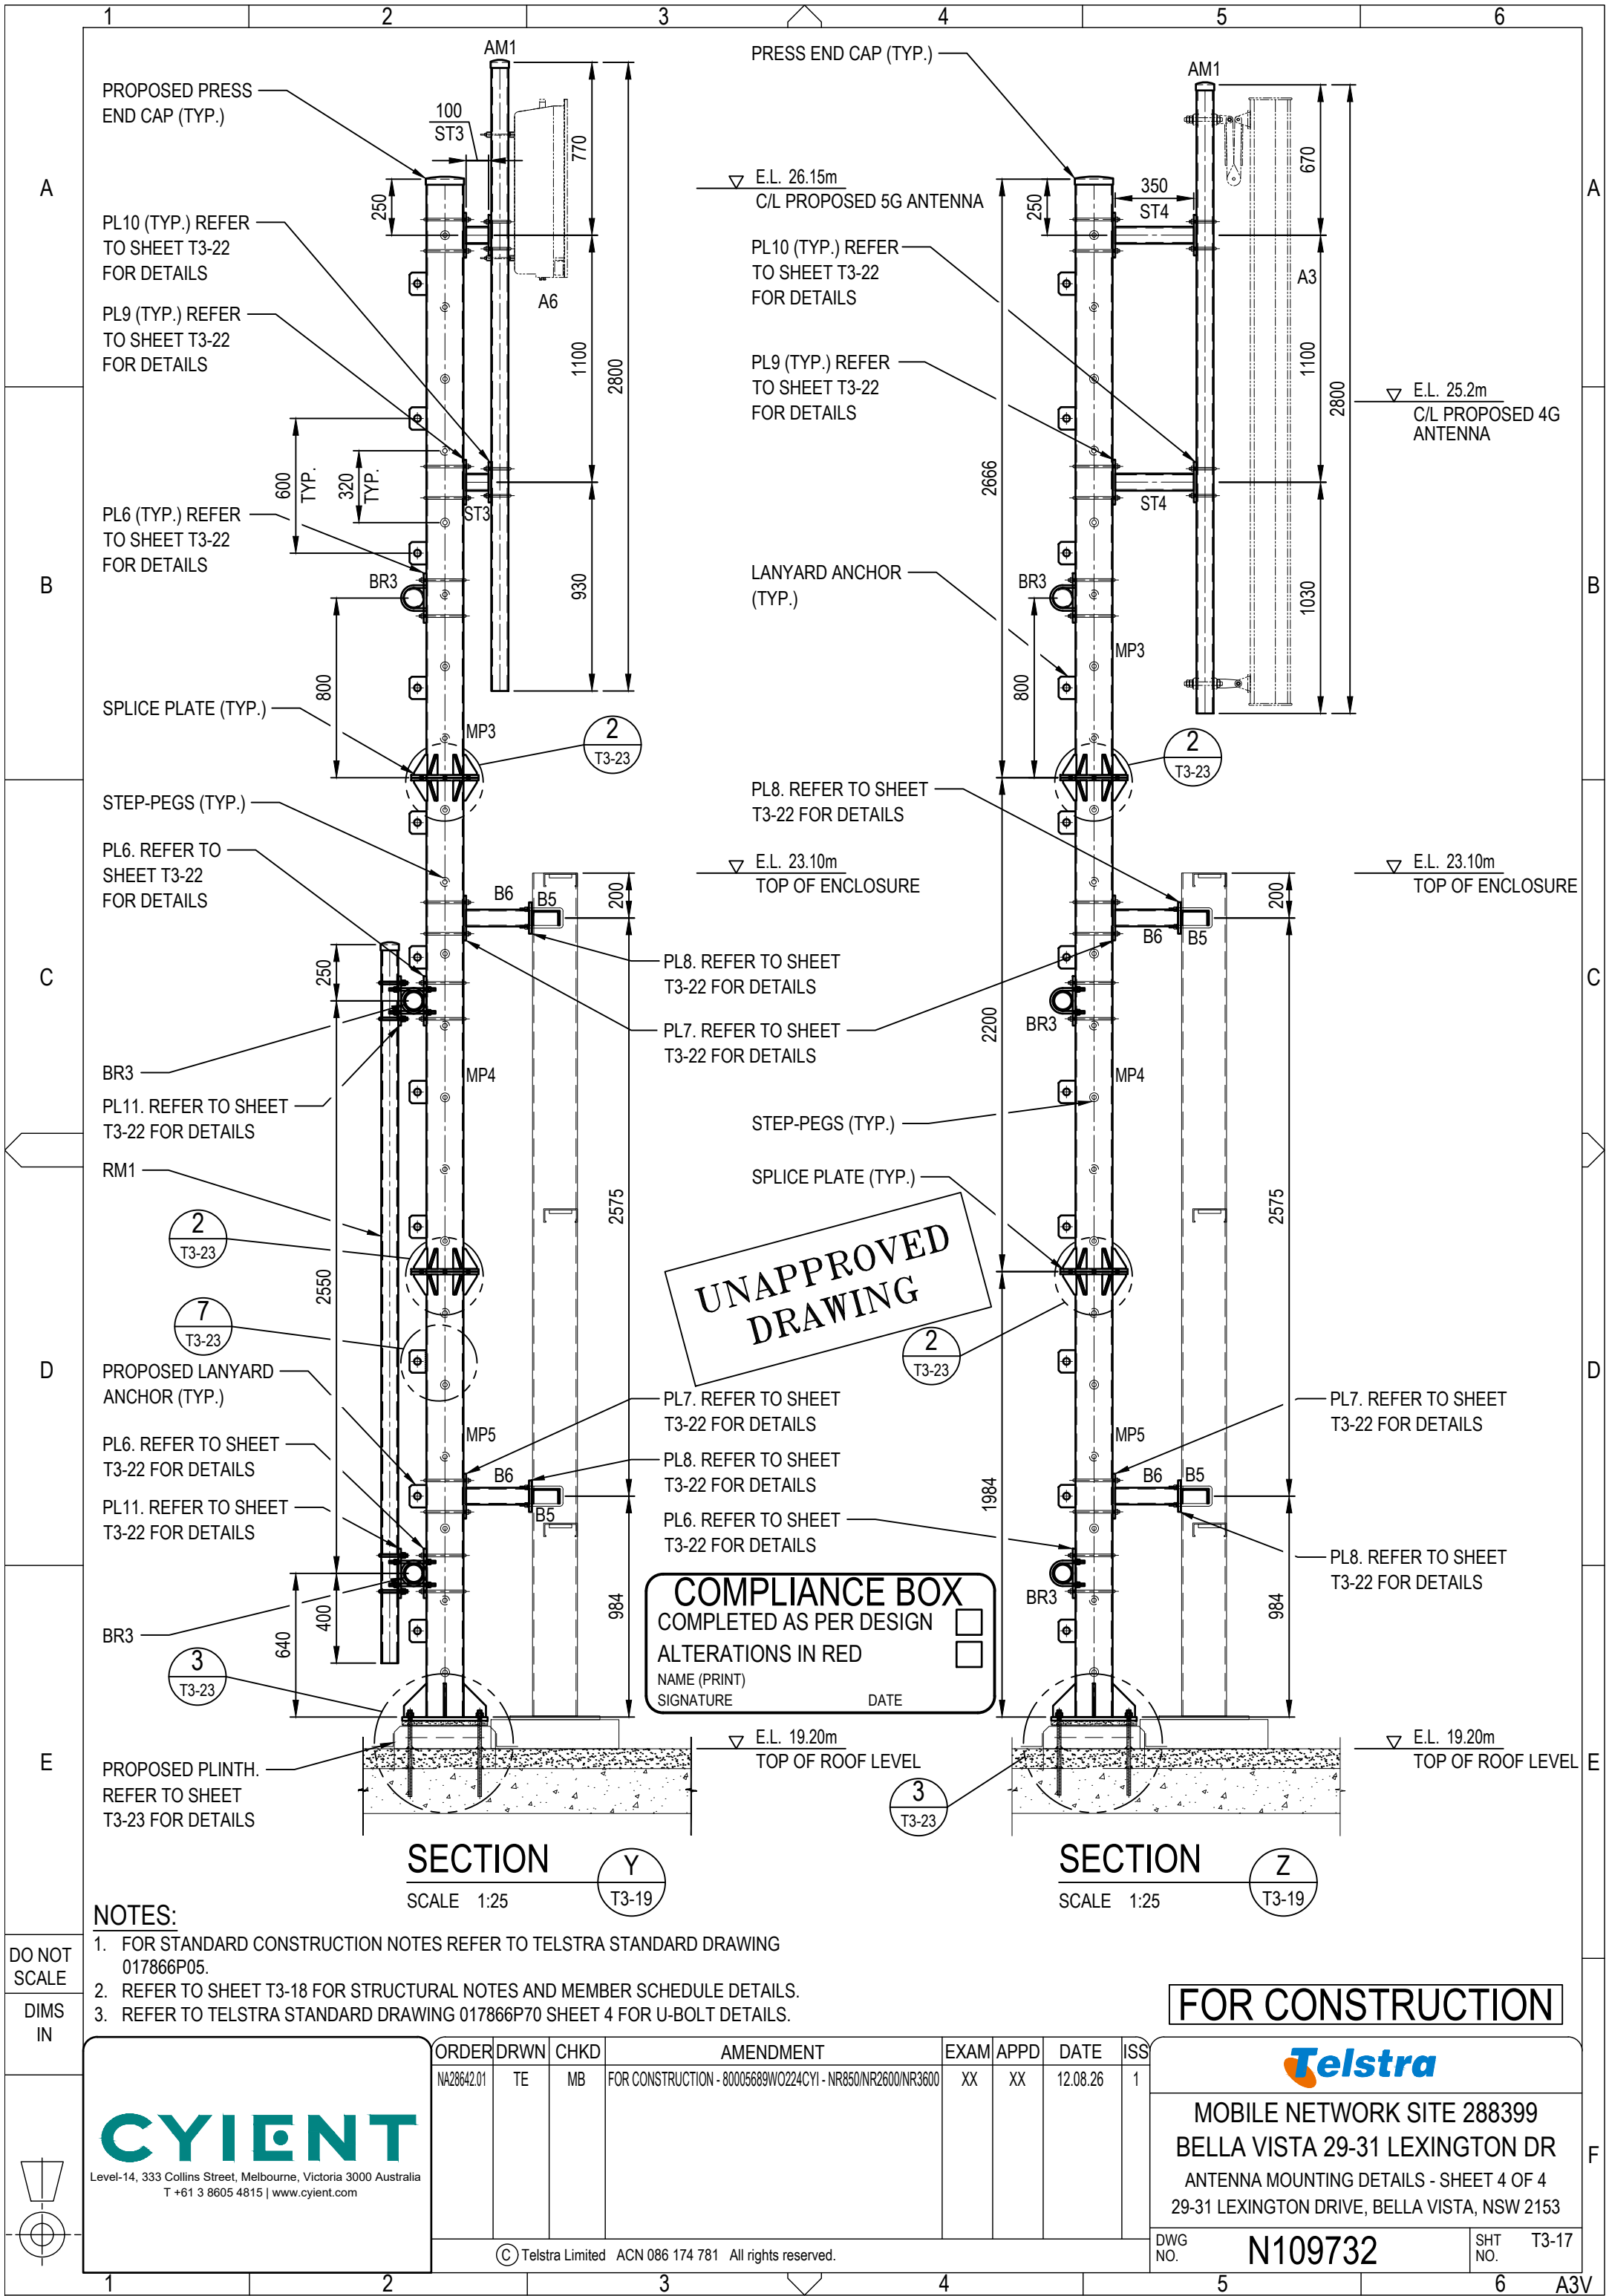

PROPOSED PRESS
END CAP (TYP.)

PL10 (TYP.) REFER
TO SHEET T3-22
FOR DETAILS

PL9 (TYP.) REFER
TO SHEET T3-22
FOR DETAILS

PL6 (TYP.) REFER
TO SHEET T3-22
FOR DETAILS

SPLICE PLATE (TYP.)

STEP-PEGS (TYP.)

PL6. REFER TO
SHEET T3-22
FOR DETAILS

BR3
PL11. REFER TO SHEET
T3-22 FOR DETAILS

RM1

PROPOSED LANYARD
ANCHOR (TYP.)

PL6. REFER TO SHEET
T3-22 FOR DETAILS

PL11. REFER TO SHEET
T3-22 FOR DETAILS

BR3

PROPOSED PLINTH.
REFER TO SHEET
T3-23 FOR DETAILS

SECTION Y

SCALE 1:25

T3-19

PRESS END CAP (TYP.)

E.L. 26.15m
C/L PROPOSED 5G ANTENNA

PL10 (TYP.) REFER
TO SHEET T3-22
FOR DETAILS

PL9 (TYP.) REFER
TO SHEET T3-22
FOR DETAILS

LANYARD ANCHOR
(TYP.)

PL8. REFER TO SHEET
T3-22 FOR DETAILS

E.L. 23.10m
TOP OF ENCLOSURE

PL8. REFER TO SHEET
T3-22 FOR DETAILS

PL7. REFER TO SHEET
T3-22 FOR DETAILS

STEP-PEGS (TYP.)

SPLICE PLATE (TYP.)

UNAPPROVED
DRAWING

PL7. REFER TO SHEET
T3-22 FOR DETAILS

PL8. REFER TO SHEET
T3-22 FOR DETAILS

PL6. REFER TO SHEET
T3-22 FOR DETAILS

COMPLIANCE BOX
COMPLETED AS PER DESIGN
ALTERATIONS IN RED
NAME (PRINT) SIGNATURE DATE

E.L. 19.20m
TOP OF ROOF LEVEL

SECTION Z

SCALE 1:25

T3-19

E.L. 25.2m
C/L PROPOSED 4G
ANTENNA

E.L. 23.10m
TOP OF ENCLOSURE

PL7. REFER TO SHEET
T3-22 FOR DETAILS

PL8. REFER TO SHEET
T3-22 FOR DETAILS

E.L. 19.20m
TOP OF ROOF LEVEL

NOTES:

- FOR STANDARD CONSTRUCTION NOTES REFER TO TELSTRA STANDARD DRAWING 017866P05.
- REFER TO SHEET T3-18 FOR STRUCTURAL NOTES AND MEMBER SCHEDULE DETAILS.
- REFER TO TELSTRA STANDARD DRAWING 017866P70 SHEET 4 FOR U-BOLT DETAILS.

FOR CONSTRUCTION



MOBILE NETWORK SITE 288399
BELLA VISTA 29-31 LEXINGTON DR
ANTENNA MOUNTING DETAILS - SHEET 4 OF 4
29-31 LEXINGTON DRIVE, BELLA VISTA, NSW 2153

DWG
NO.

N109732


SHT
NO.


T3-17

CYIENT

Level-14, 333 Collins Street, Melbourne, Victoria 3000 Australia
T +61 3 8605 4815 | www.cyient.com

© Telstra Limited ACN 086 174 781 All rights reserved.

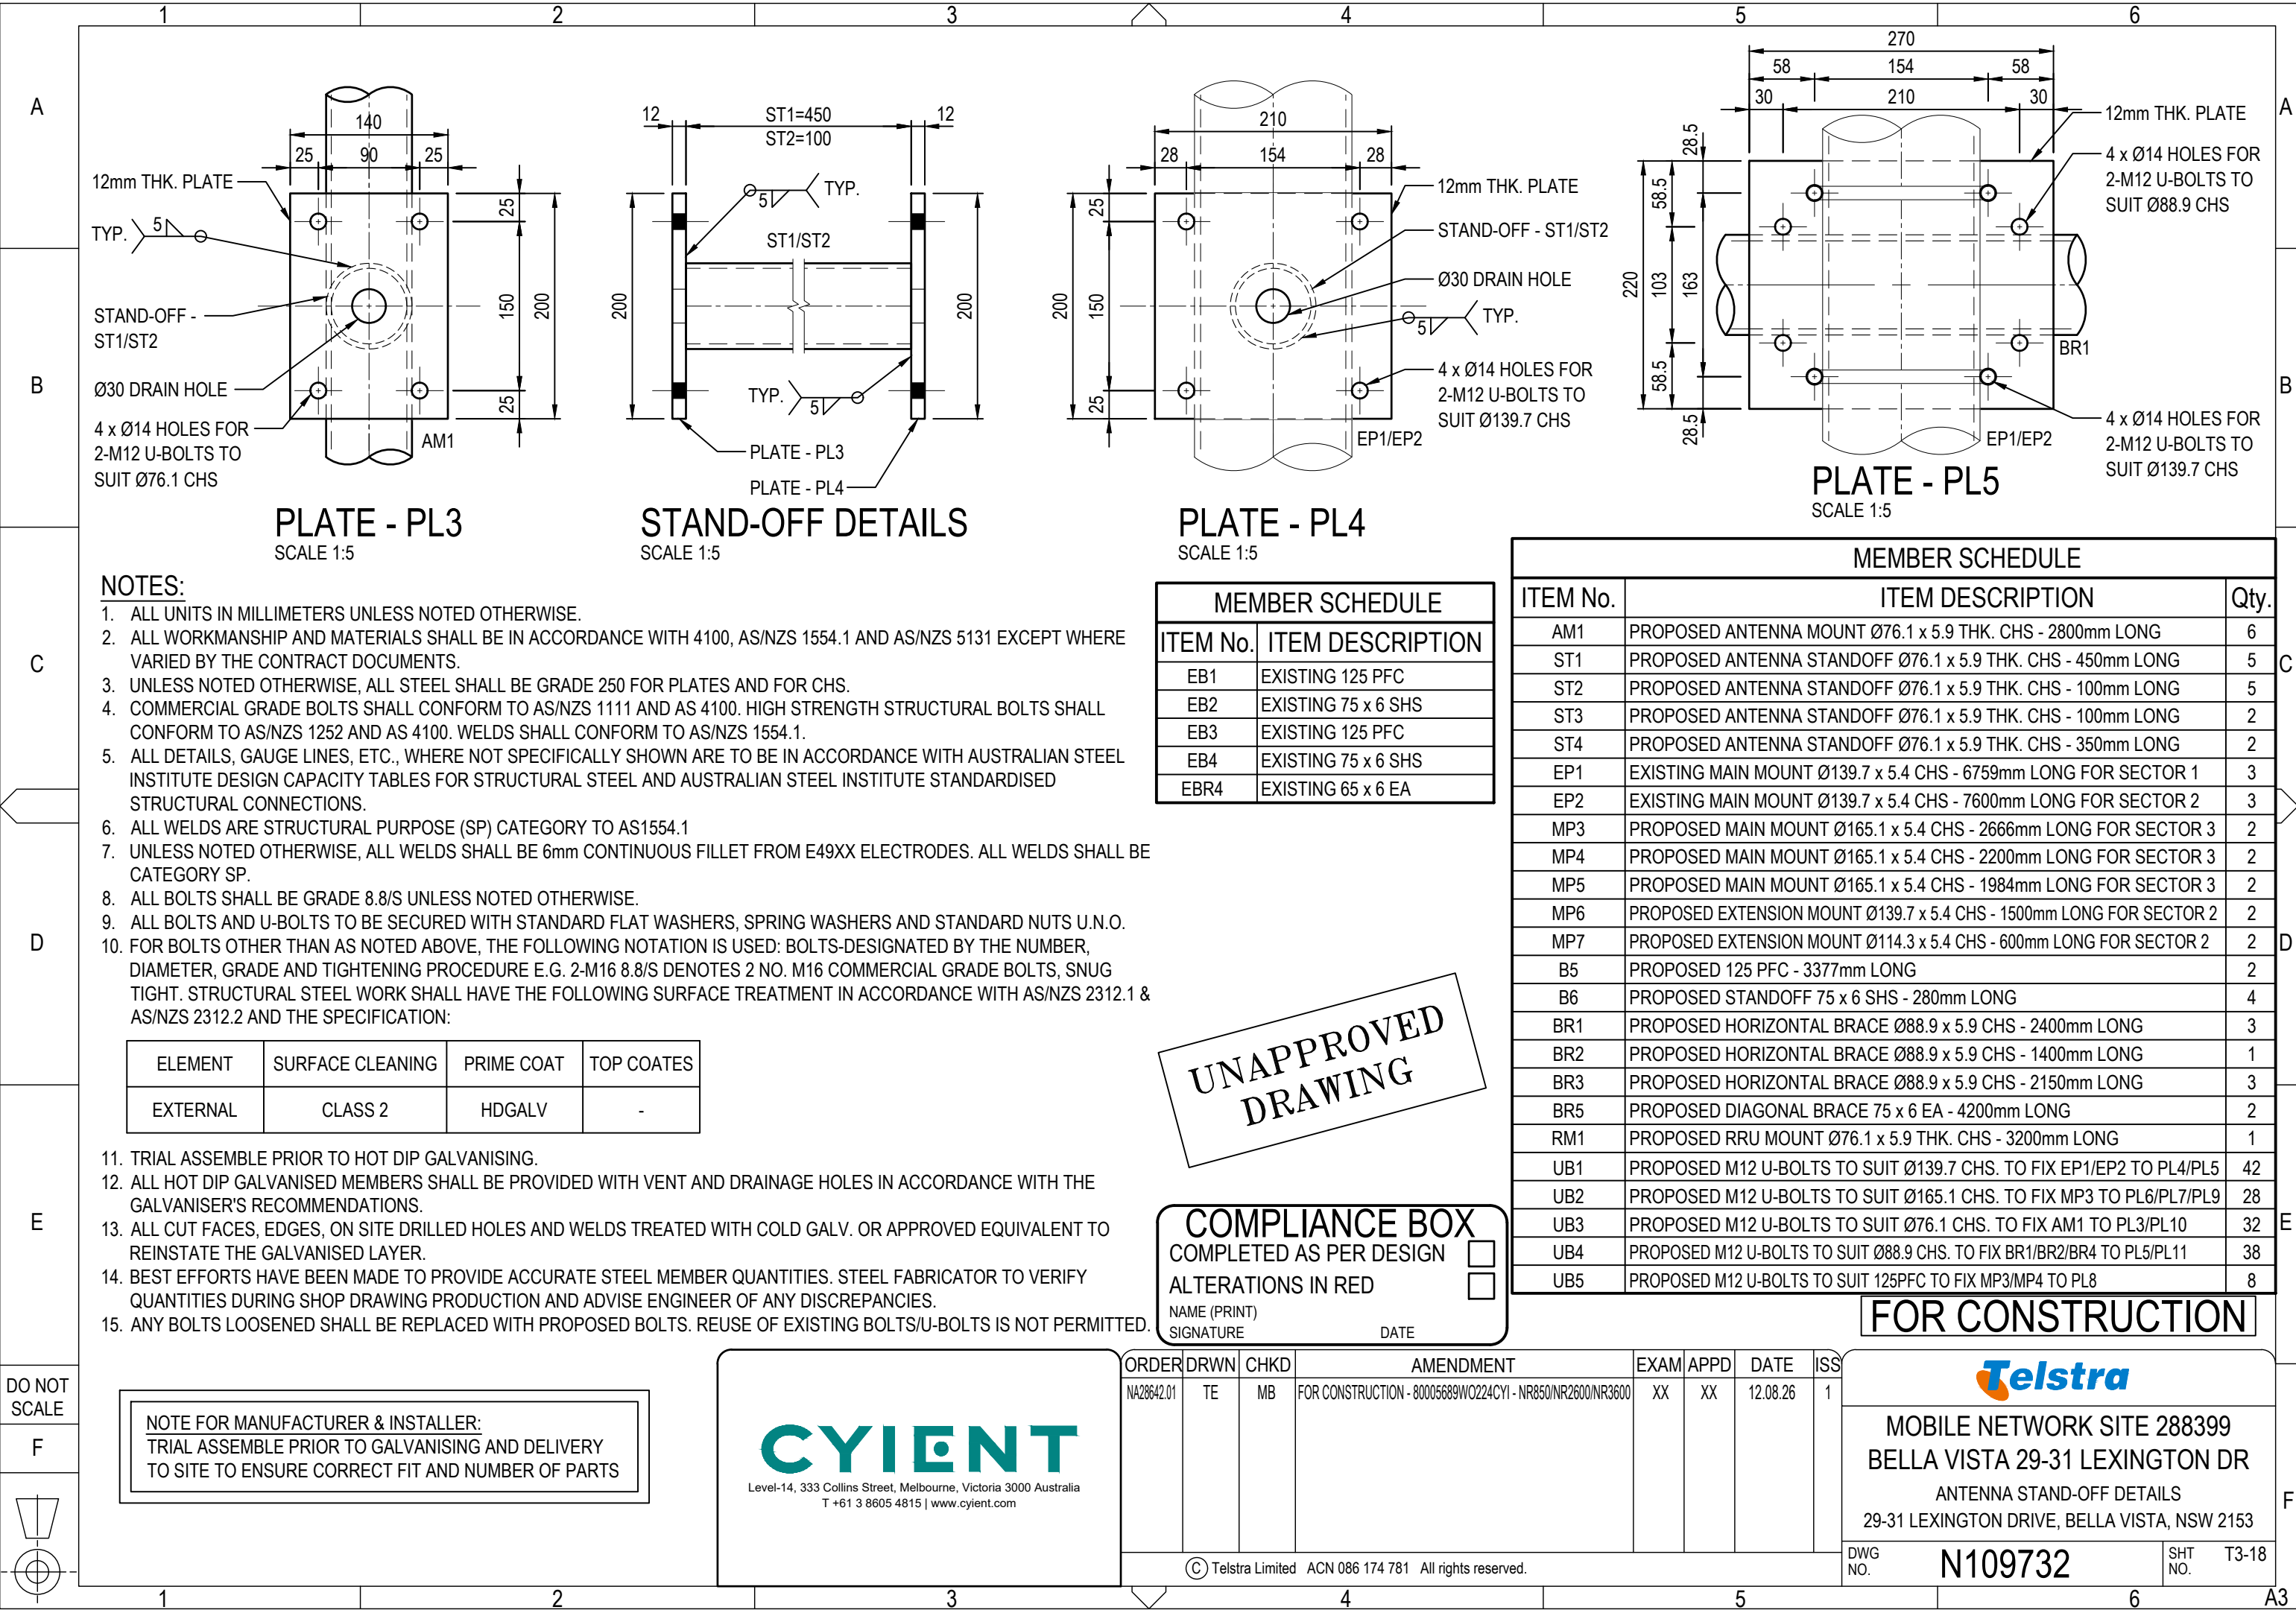


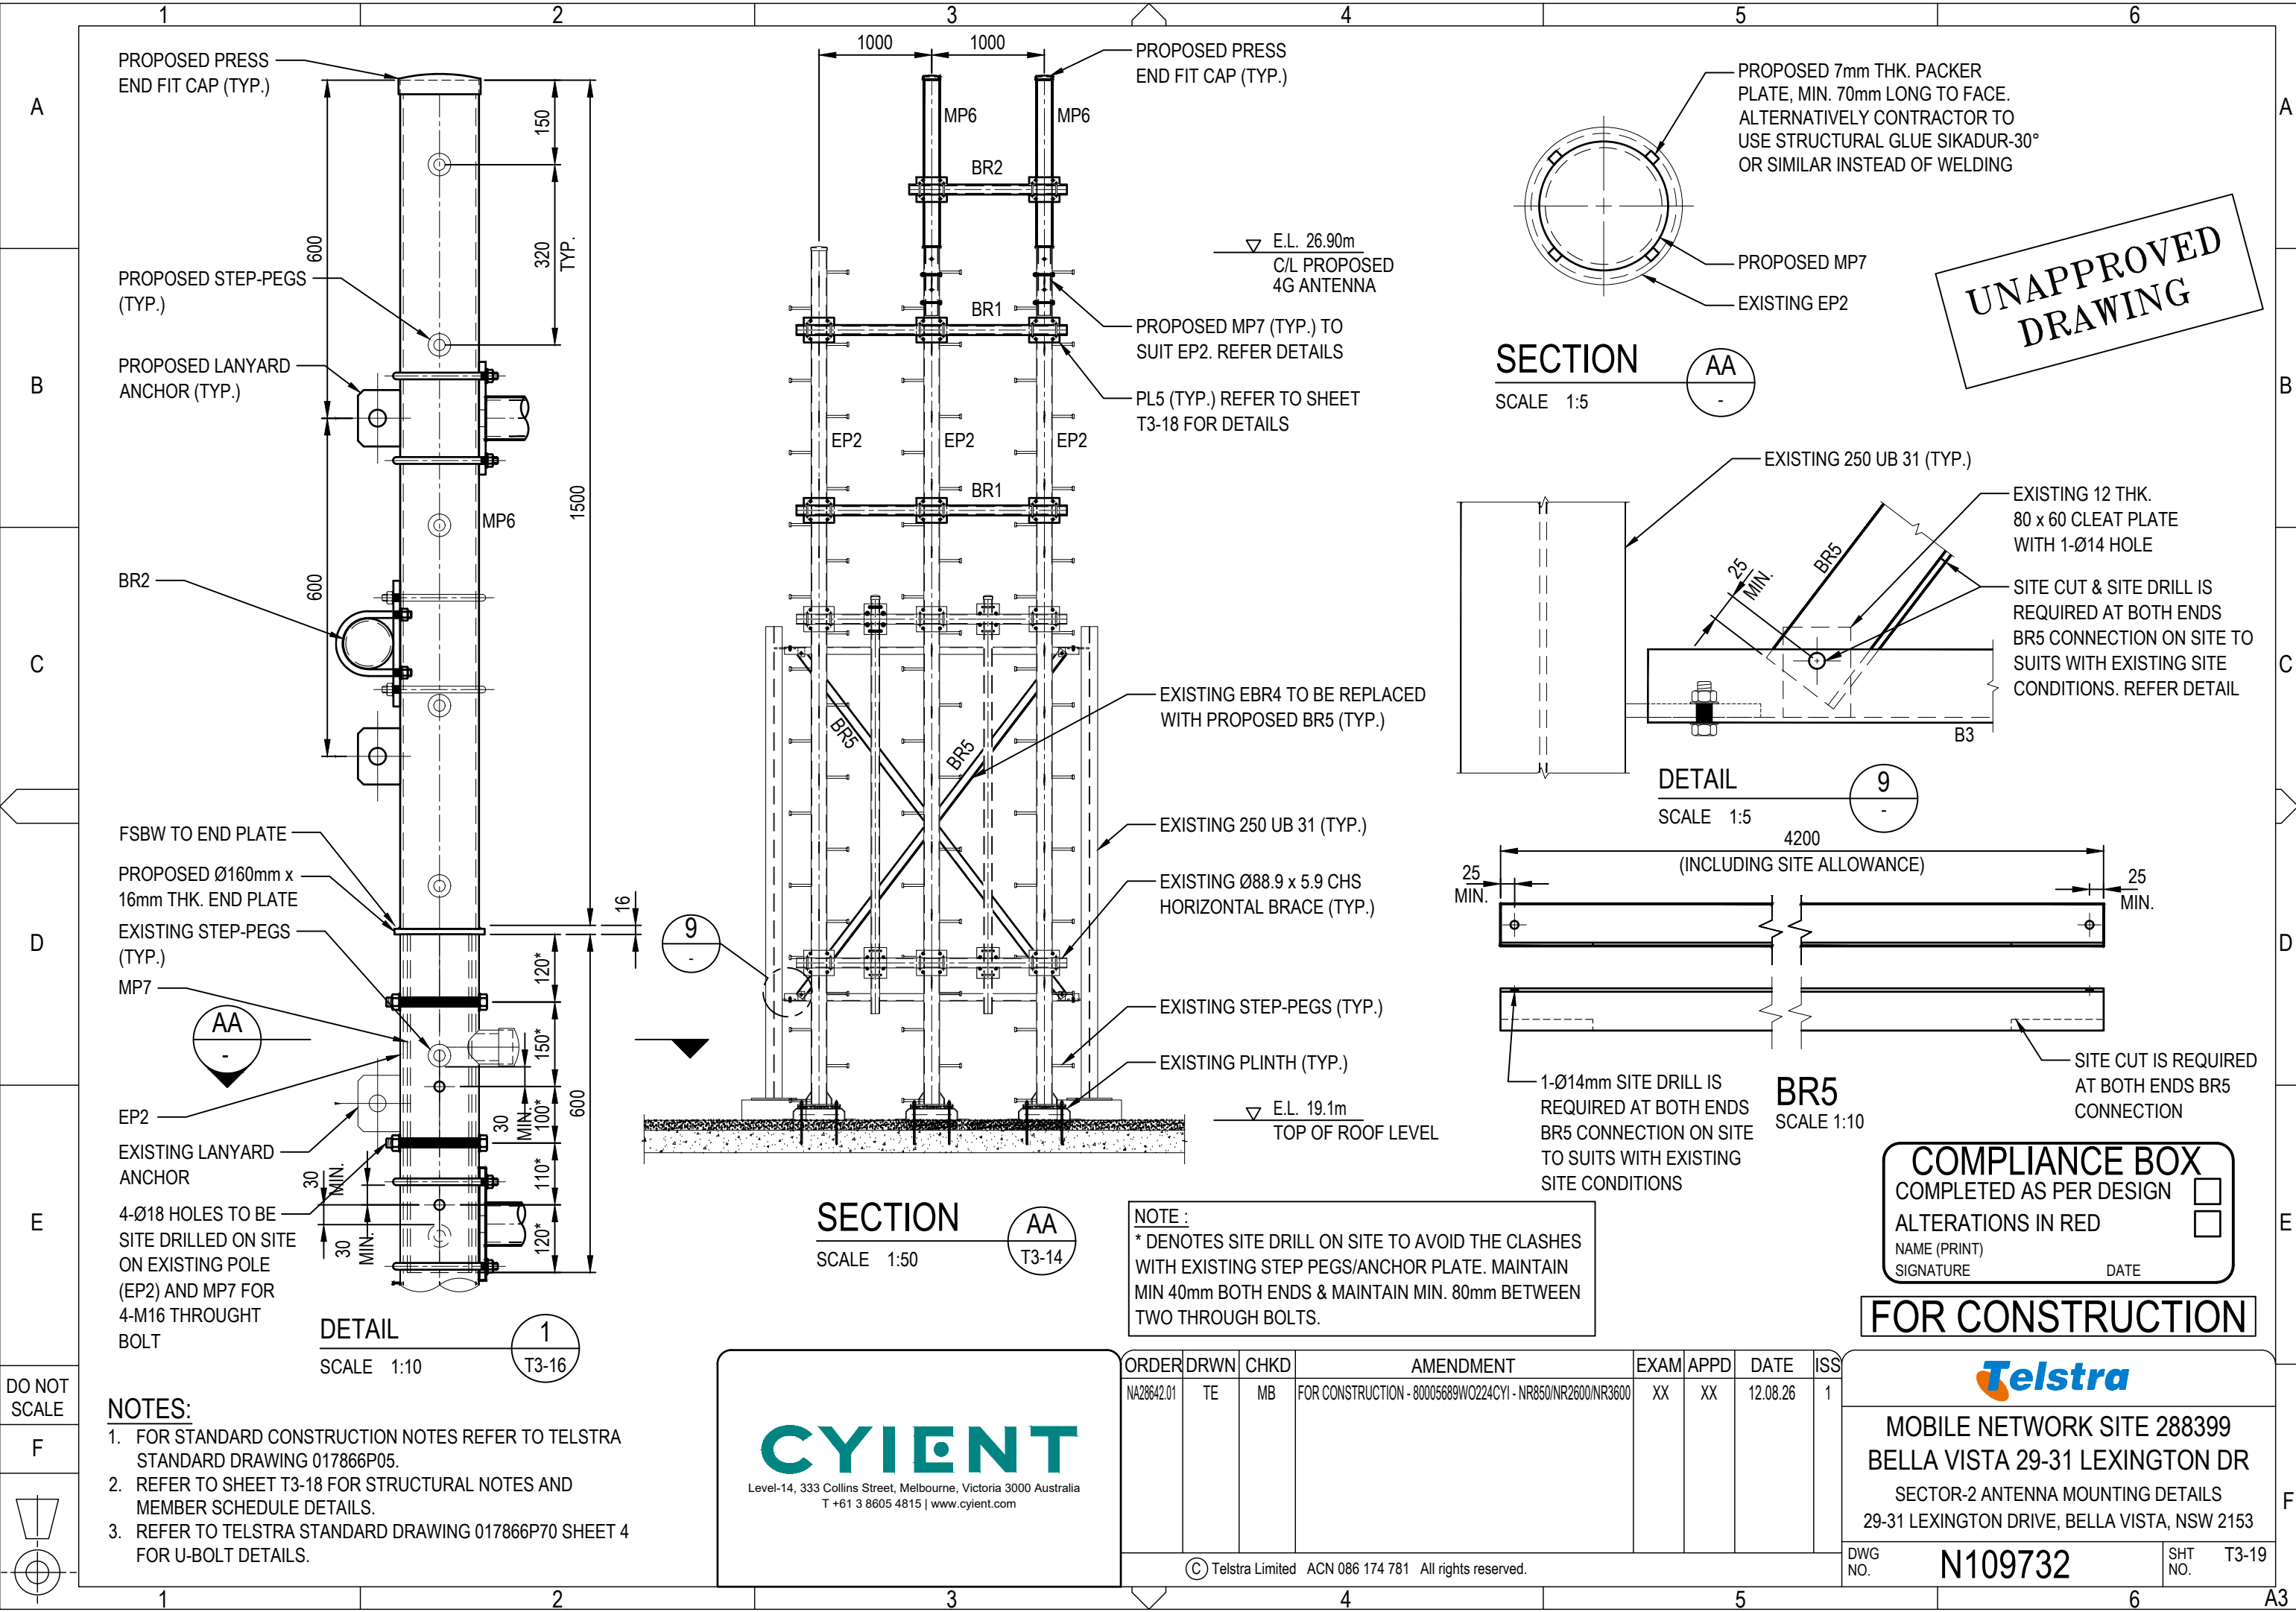

UNAPPROVED
DRAWING


SECTION
SCALE 1:5

AA
-

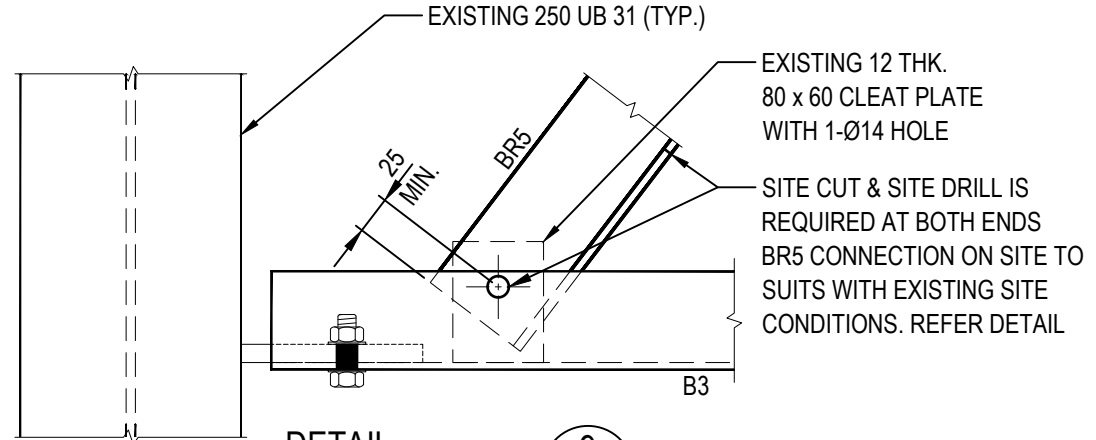

DETAIL
SCALE 1:5

9
-

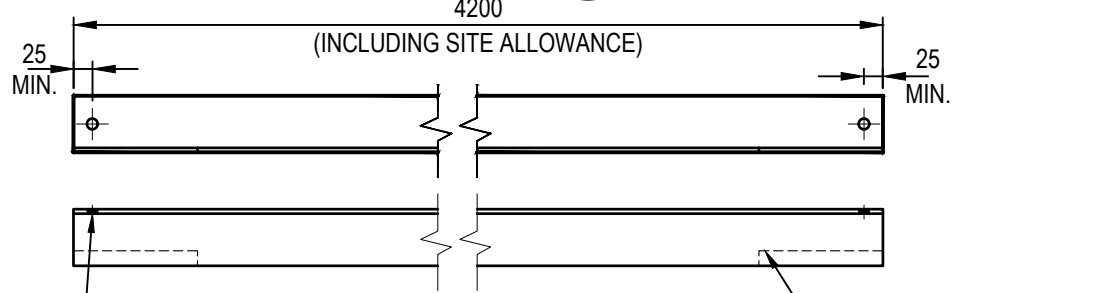

DETAIL
SCALE 1:10

1
T3-16

SECTION
SCALE 1:50

AA
T3-14

NOTE:
* DENOTES SITE DRILL ON SITE TO AVOID THE CLASHES WITH EXISTING STEP PEGS/ANCHOR PLATE. MAINTAIN MIN 40mm BOTH ENDS & MAINTAIN MIN. 80mm BETWEEN TWO THROUGH BOLTS.

COMPLIANCE BOX
COMPLETED AS PER DESIGN ☐
ALTERATIONS IN RED ☐
NAME (PRINT) _____
SIGNATURE _____ DATE _____


FOR CONSTRUCTION

CYIENT
Level-14, 333 Collins Street, Melbourne, Victoria 3000 Australia
T +61 3 8605 4815 | www.cyient.com

ORDER	DRWN	CHKD	AMENDMENT	EXAM	APPD	DATE	ISS
NA28642.01	TE	MB	FOR CONSTRUCTION - 80005689W0224CY1 - NR850/NR2600/NR3600	XX	XX	12.08.26	1

Telstra
MOBILE NETWORK SITE 288399
BELLA VISTA 29-31 LEXINGTON DR
SECTOR-2 ANTENNA MOUNTING DETAILS
29-31 LEXINGTON DRIVE, BELLA VISTA, NSW 2153

DWG NO. **N109732** SHT NO. T3-19

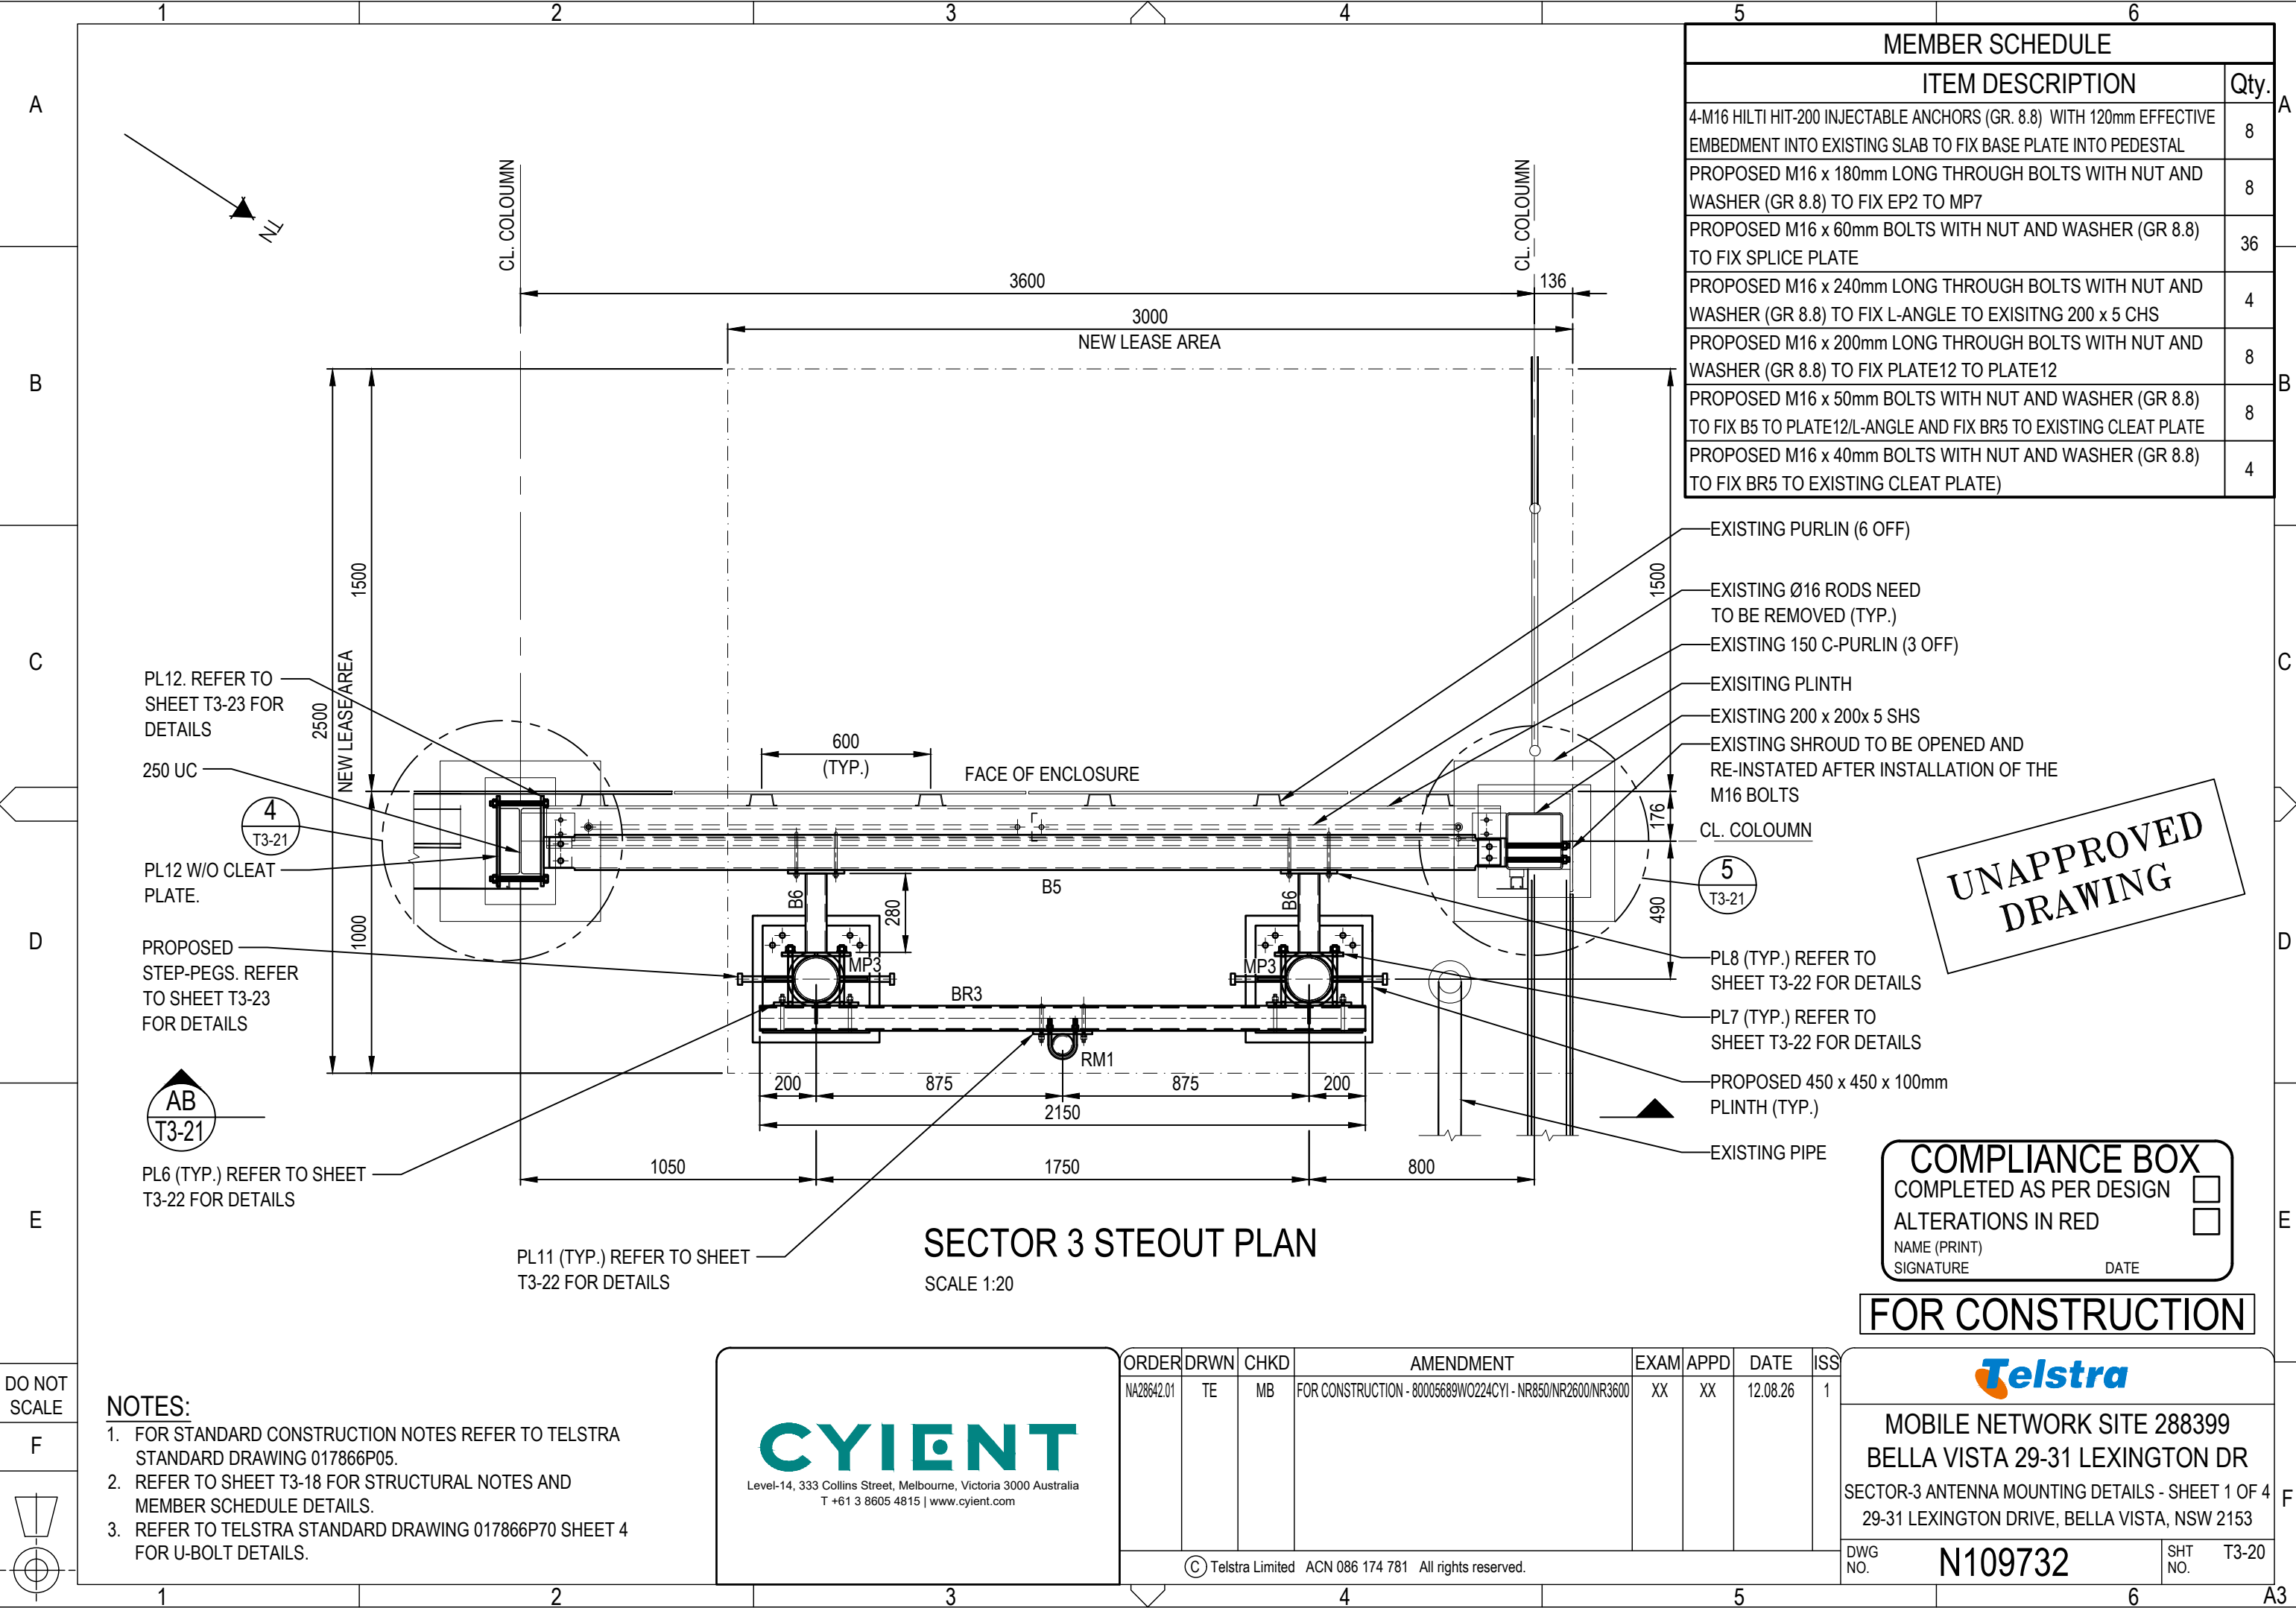

MEMBER SCHEDULE	
ITEM DESCRIPTION	Qty.
4-M16 HILTI HIT-200 INJECTABLE ANCHORS (GR. 8.8) WITH 120mm EFFECTIVE EMBEDMENT INTO EXISTING SLAB TO FIX BASE PLATE INTO PEDESTAL	8
PROPOSED M16 x 180mm LONG THROUGH BOLTS WITH NUT AND WASHER (GR 8.8) TO FIX EP2 TO MP7	8
PROPOSED M16 x 60mm BOLTS WITH NUT AND WASHER (GR 8.8) TO FIX SPLICE PLATE	36
PROPOSED M16 x 240mm LONG THROUGH BOLTS WITH NUT AND WASHER (GR 8.8) TO FIX L-ANGLE TO EXISITNG 200 x 5 CHS	4
PROPOSED M16 x 200mm LONG THROUGH BOLTS WITH NUT AND WASHER (GR 8.8) TO FIX PLATE12 TO PLATE12	8
PROPOSED M16 x 50mm BOLTS WITH NUT AND WASHER (GR 8.8) TO FIX B5 TO PLATE12/L-ANGLE AND FIX BR5 TO EXISTING CLEAT PLATE	8
PROPOSED M16 x 40mm BOLTS WITH NUT AND WASHER (GR 8.8) TO FIX BR5 TO EXISTING CLEAT PLATE)	4

UNAPPROVED
DRAWING

COMPLIANCE BOX	
COMPLETED AS PER DESIGN	☐
ALTERATIONS IN RED	☐
NAME (PRINT)	
SIGNATURE	DATE

FOR CONSTRUCTION

NOTES:

- FOR STANDARD CONSTRUCTION NOTES REFER TO TELSTRA STANDARD DRAWING 017866P05.
- REFER TO SHEET T3-18 FOR STRUCTURAL NOTES AND MEMBER SCHEDULE DETAILS.
- REFER TO TELSTRA STANDARD DRAWING 017866P70 SHEET 4 FOR U-BOLT DETAILS.

CYIENT

Level-14, 333 Collins Street, Melbourne, Victoria 3000 Australia
T +61 3 8605 4815 | www.cyient.com

ORDER	DRWN	CHKD	AMENDMENT	EXAM	APPD	DATE	ISS
NA28642.01	TE	MB	FOR CONSTRUCTION - 80005689WO224CYI - NR850/NR2600/NR3600	XX	XX	12.08.26	1

© Telstra Limited ACN 086 174 781 All rights reserved.




MOBILE NETWORK SITE 288399
BELLA VISTA 29-31 LEXINGTON DR
SECTOR-3 ANTENNA MOUNTING DETAILS - SHEET 1 OF 4
29-31 LEXINGTON DRIVE, BELLA VISTA, NSW 2153

DWG
NO.

N109732

SHT
NO.

T3-20

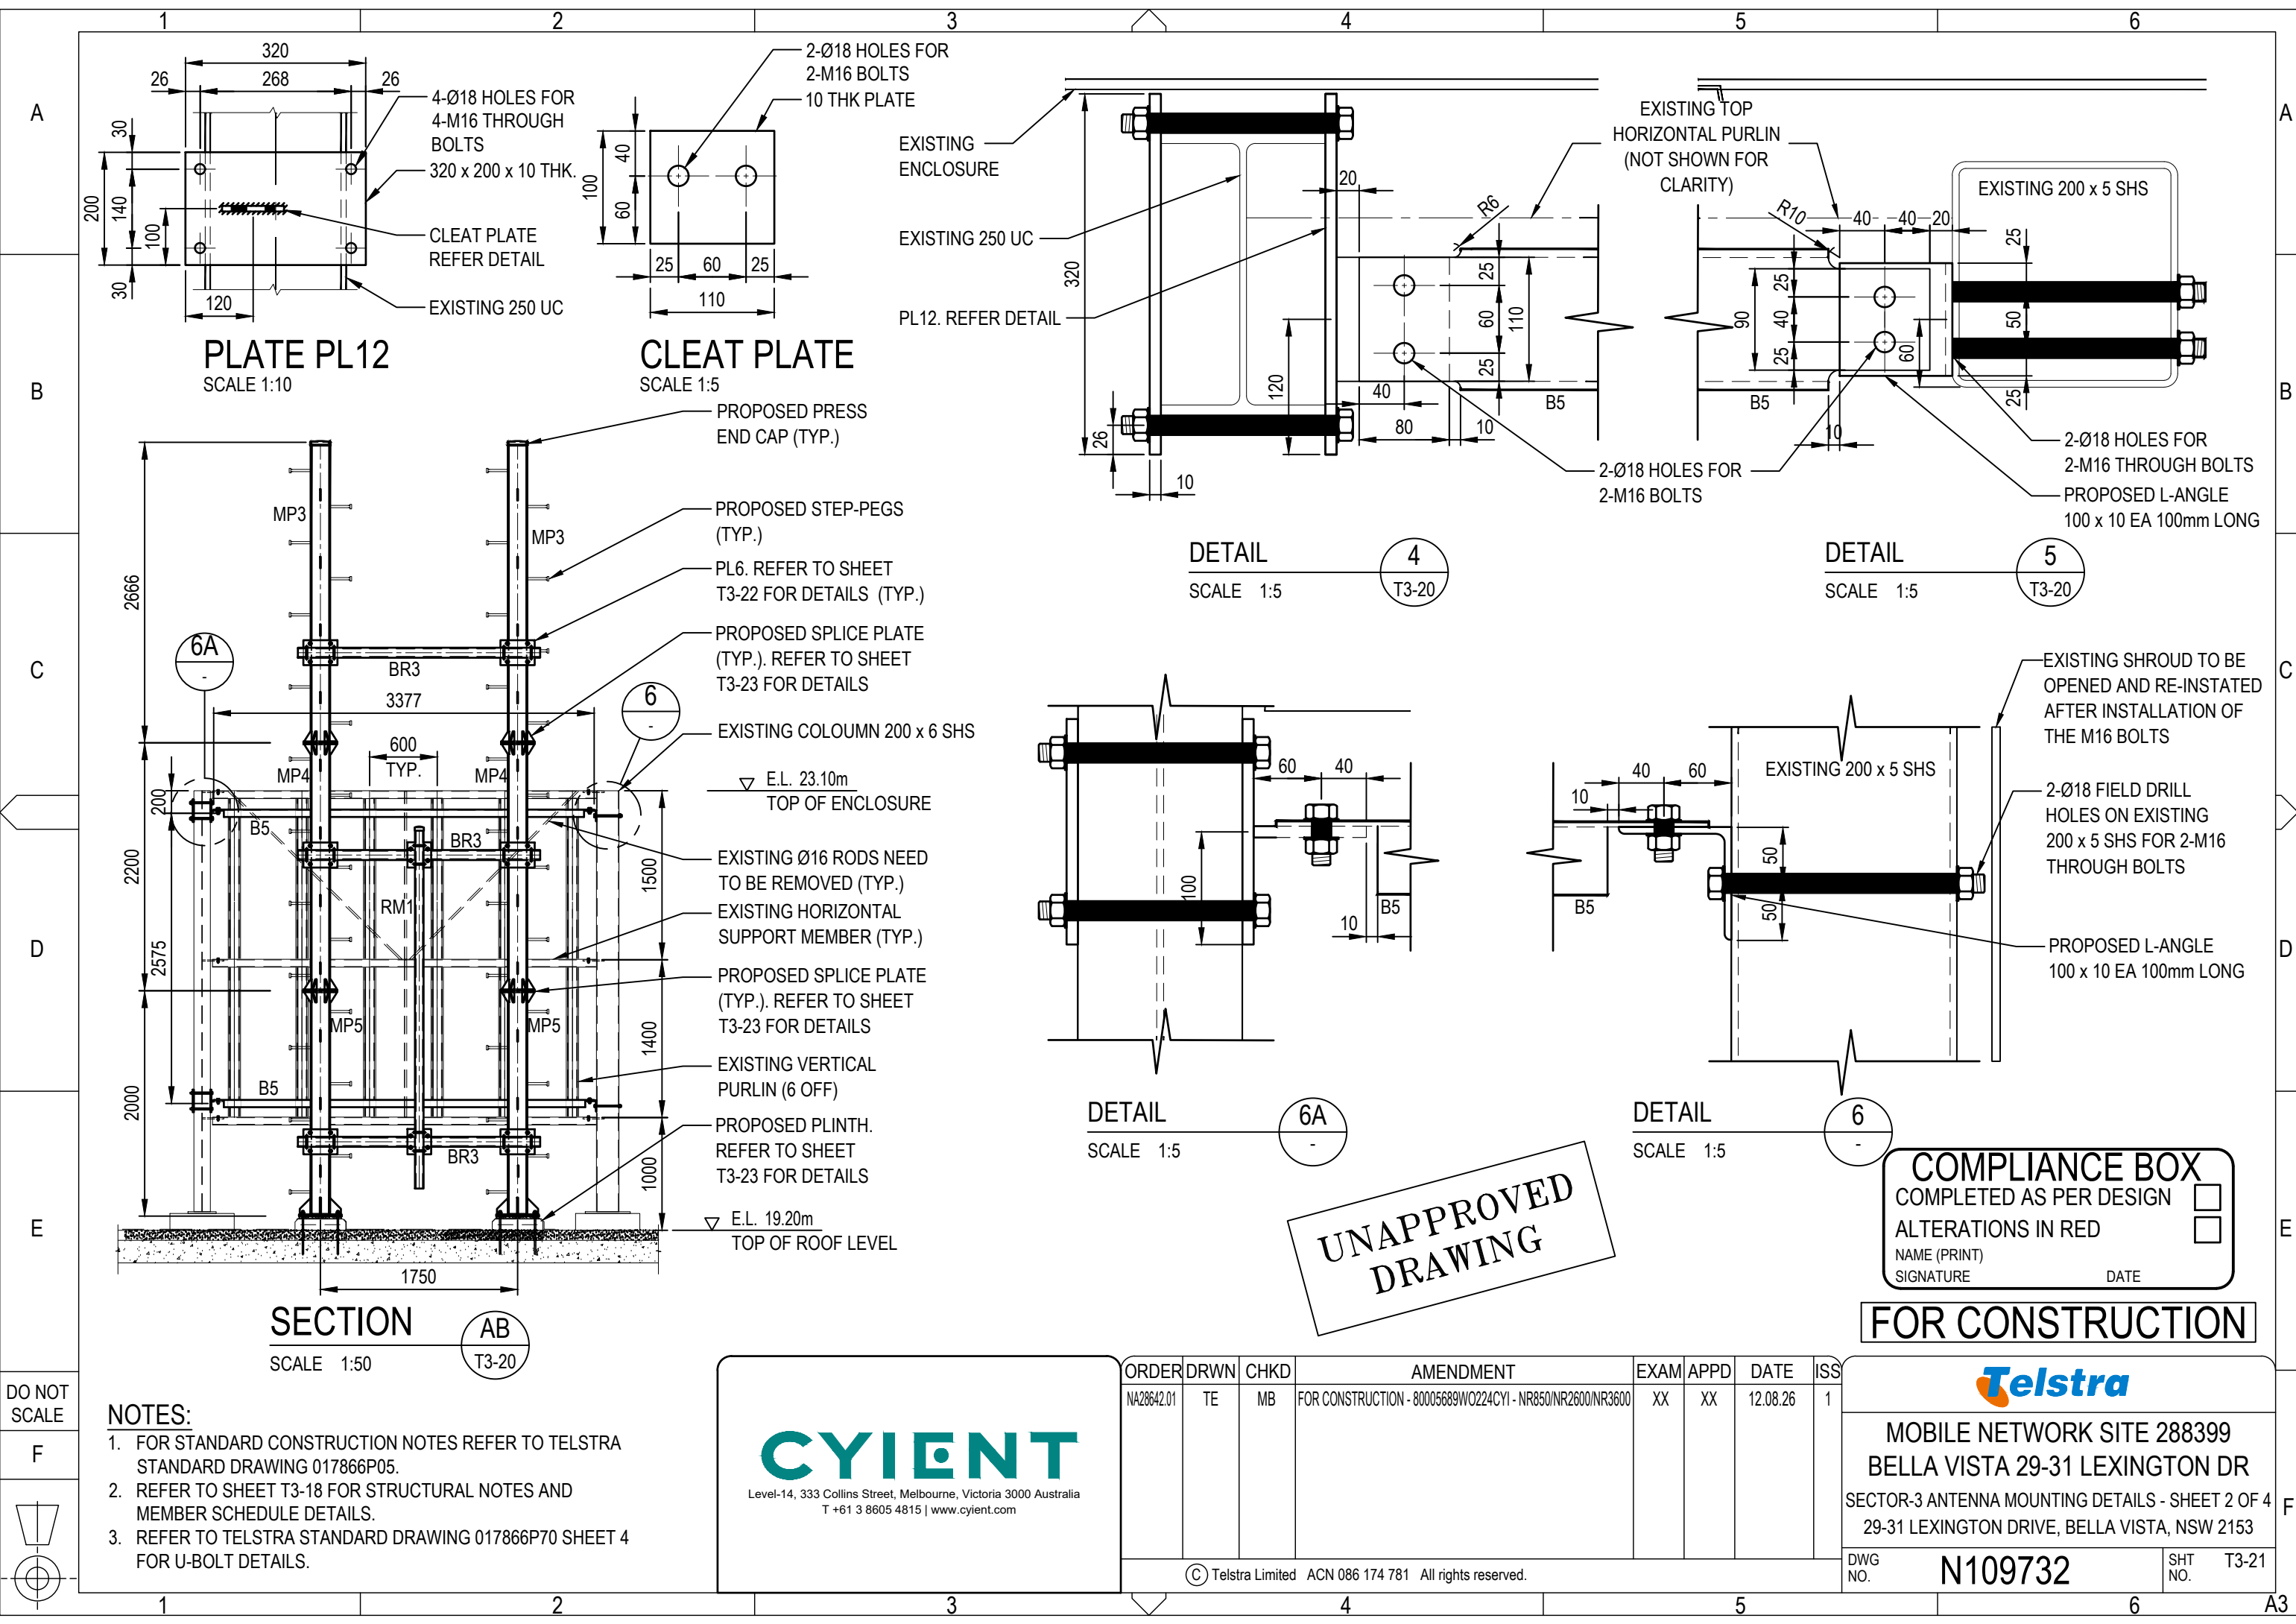

DO NOT
SCALE

F

- NOTES:**
- FOR STANDARD CONSTRUCTION NOTES REFER TO TELSTRA STANDARD DRAWING 017866P05.
 - REFER TO SHEET T3-18 FOR STRUCTURAL NOTES AND MEMBER SCHEDULE DETAILS.
 - REFER TO TELSTRA STANDARD DRAWING 017866P70 SHEET 4 FOR U-BOLT DETAILS.

CYIENT

Level-14, 333 Collins Street, Melbourne, Victoria 3000 Australia
T +61 3 8605 4815 | www.cyient.com

ORDER	DRWN	CHKD	AMENDMENT	EXAM	APPD	DATE	ISS
NA28642.01	TE	MB	FOR CONSTRUCTION - 80005689W0224CYI - NR850/NR2600/NR3600	XX	XX	12.08.26	1

COMPLIANCE BOX

COMPLETED AS PER DESIGN ☐

ALTERATIONS IN RED ☐

NAME (PRINT) _____

SIGNATURE _____

DATE _____

FOR CONSTRUCTION

Telstra

MOBILE NETWORK SITE 288399
BELLA VISTA 29-31 LEXINGTON DR
SECTOR-3 ANTENNA MOUNTING DETAILS - SHEET 2 OF 4
29-31 LEXINGTON DRIVE, BELLA VISTA, NSW 2153

DWG NO. **N109732** SHT NO. T3-21

