


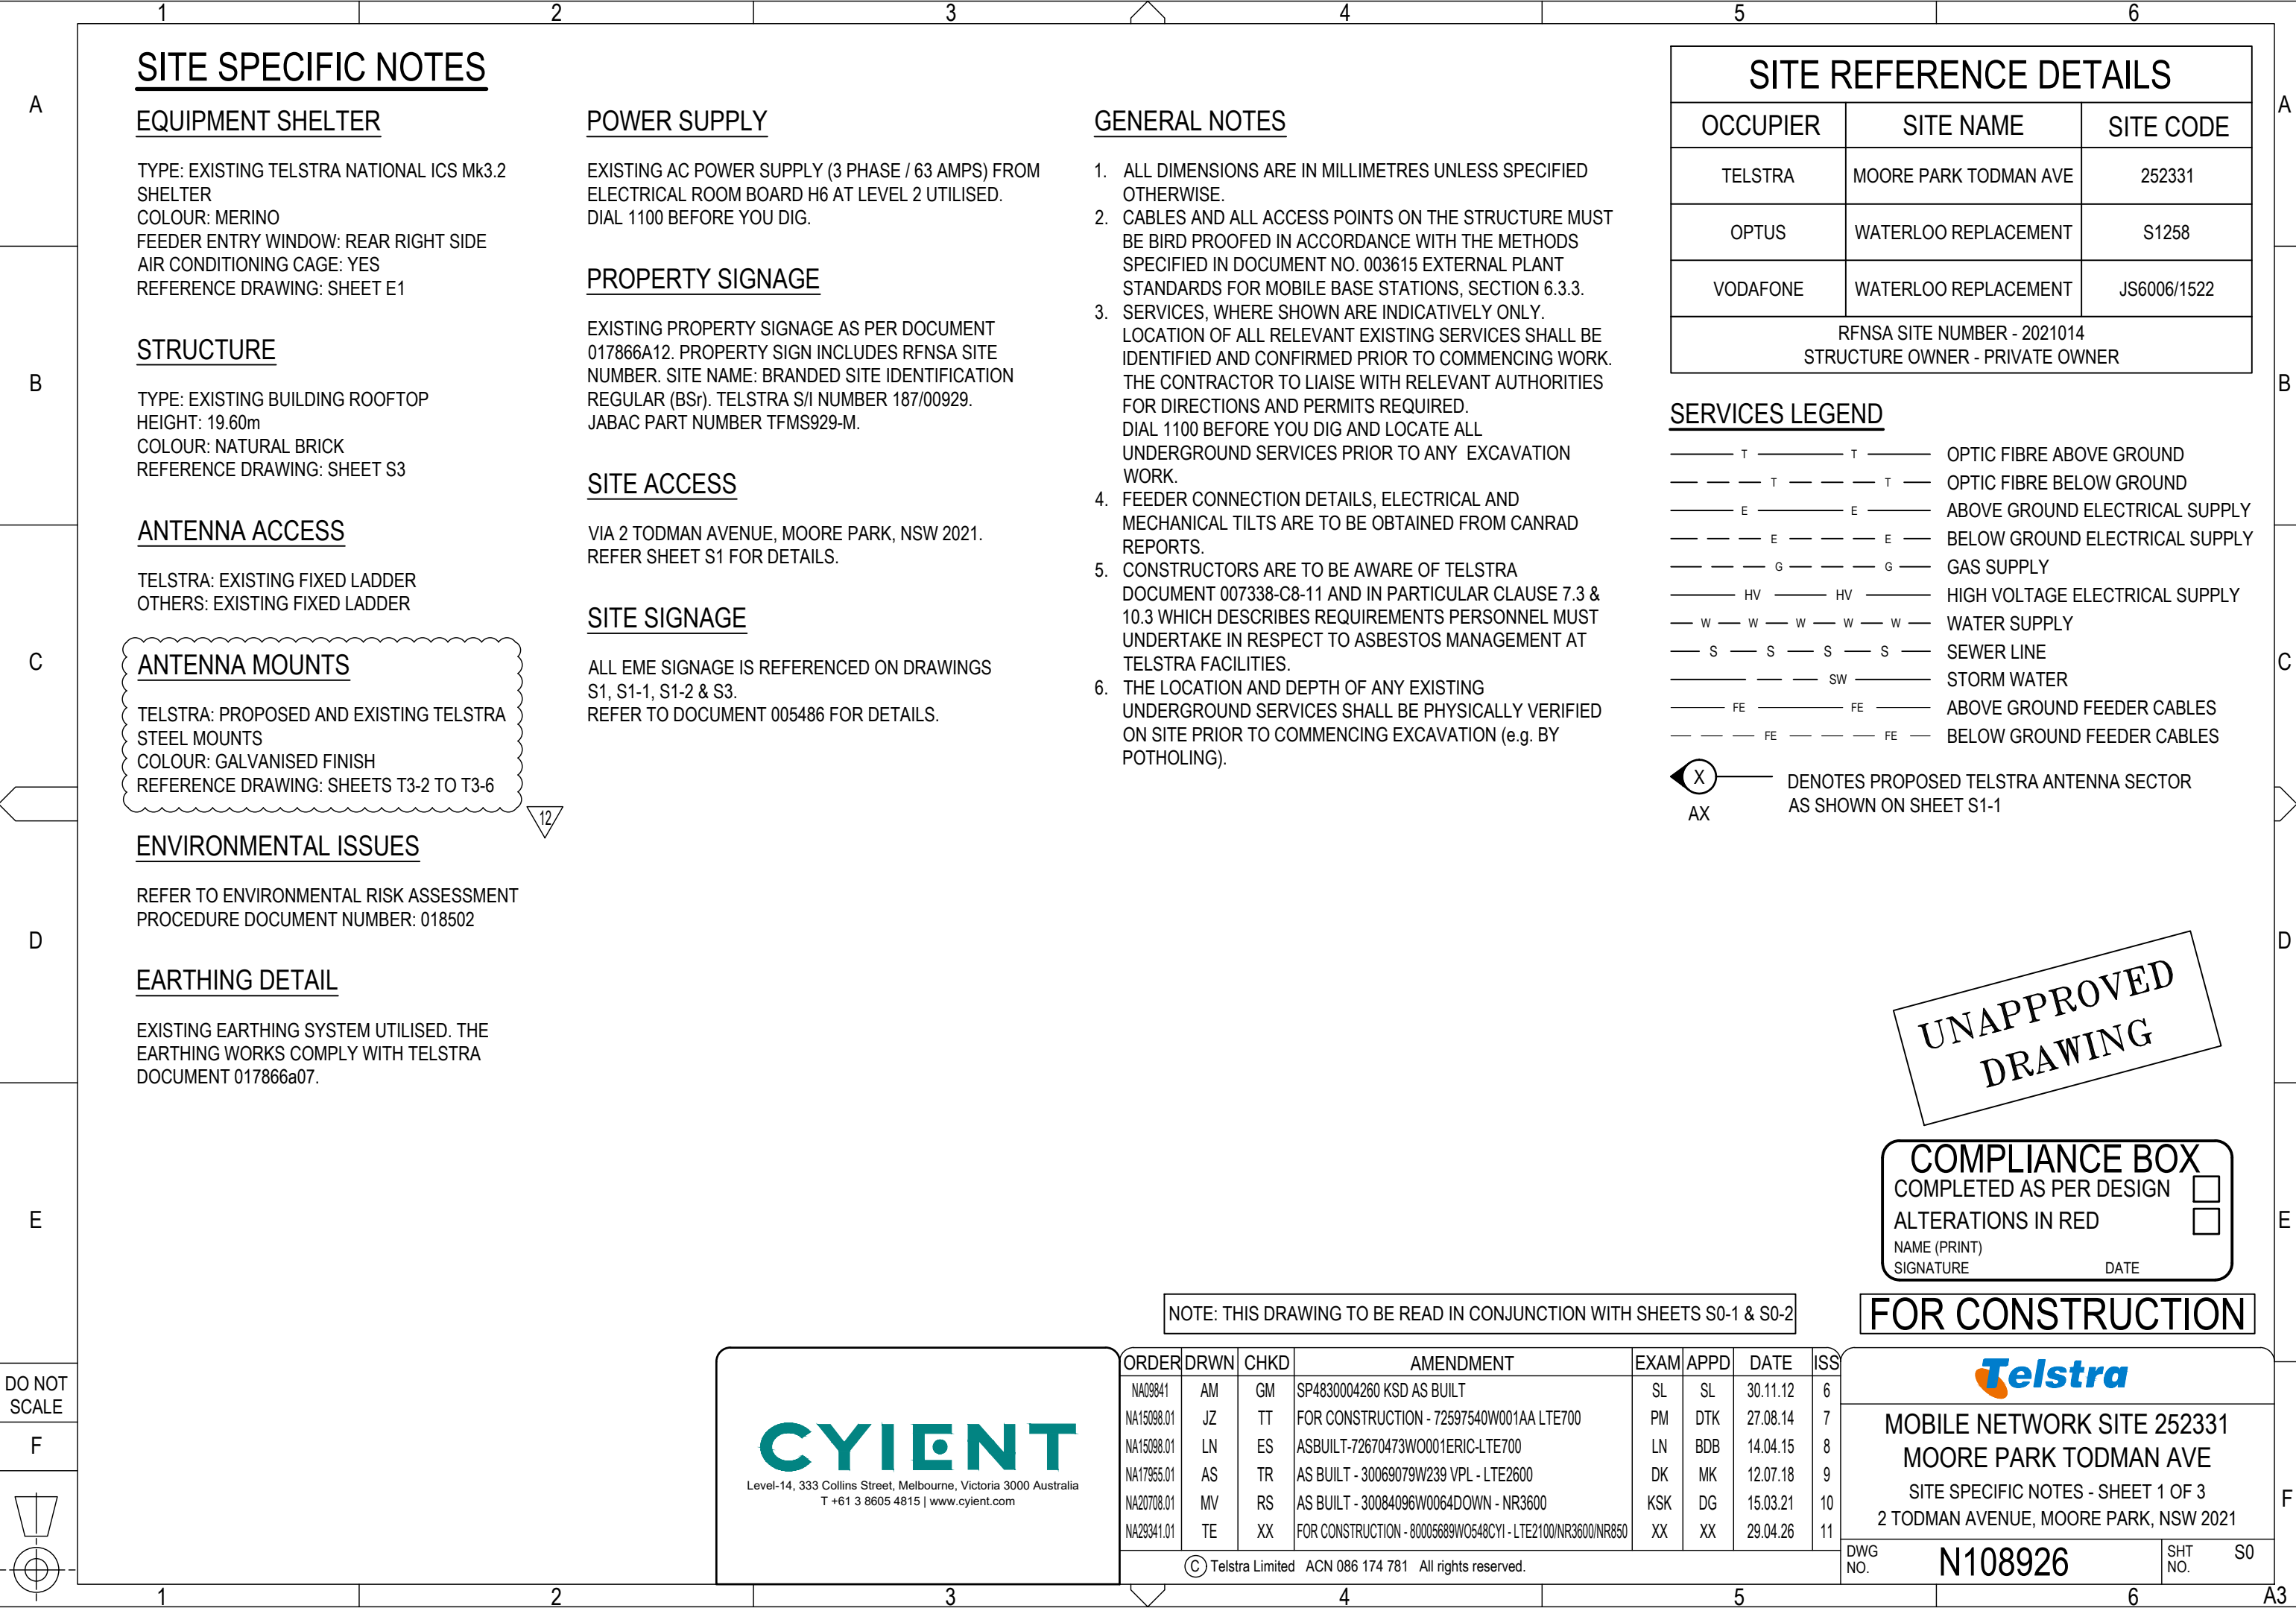

1

2

3

4

5

6

A

B

C

D

E

F

EQUIPMENT NOTES - PROJECT NO. NA29341.01

ITEM	EQUIPMENT	EQUIPMENT DETAILS	EXISTING	PROPOSED	TOTAL	REFERENCE DWG
33	RFS LCF114-50J	S1 (73m) LENGTH	2	2 (SPARE)	2	SHEETS S1-1 & S3
34	RFS LCF78-50JA	S2 (49m) & S3 (39m) LENGTH	4	2 (SPARE) & -2 (S3)	2	SHEETS S1-2 & S3
35	GPS SPLITTER	INSTALLED IN 45RU PATHFINDER RACK GD/2/3	1	1 (SPARE)	1	SHEETS E1 & E5
36	GPS RECEIVER	INSTALLED IN 45RU PATHFINDER RACK GD/2/3	1	-1	0	SHEETS E1 & E5
37	GPS ANTENNA (LTE)	ERICSSON GPS KRE 101 2082 1 OMNI	1	-1	0	SHEETS S1 & S3
38	GPS RECEIVER UNIT	ERICSSON GRU 05 01 RECEIVER NCD90189/1	0	1	1	SHEETS E1 & E5
39	KAELUS, DUAL BAND GNSS GPS ACTIVE ANTE	KA-7005-1110	0	1	1	SHEETS S1 & S3
40	RF JUMPER 1_5M N F TO SMA M	TSR951339/1500	0	1	1	-
41	GPS WBT TOD CABLE	WBT R6000 TOD CABLE - 3M	0	1	1	-
42	GPS SYNC CABLE	RPM1136127/2000	0	1	1	-
43	AIR CONDITIONER	RAC TYPE 6kW	2	0	2	SHEET E1
44	COOLING FAN	AC FAN	1	0	1	SHEET E1

DO NOT SCALE

UNAPPROVED
DRAWING

COMPLIANCE BOX

COMPLETED AS PER DESIGN

ALTERATIONS IN RED

NAME (PRINT)

SIGNATURE

DATE

FOR CONSTRUCTION

CYIENT

Level-14, 333 Collins Street, Melbourne, Victoria 3000 Australia

T +61 3 8605 4815 | www.cyient.com

ORDER	DRWN	CHKD	AMENDMENT	EXAM	APPD	DATE	ISS
NA29341.01	TE	XX	FOR CONSTRUCTION - 80005689W0548CY1 - LTE2100/NR3600/NR850	XX	XX	29.04.26	1

© Telstra Limited ACN 086 174 781 All rights reserved.

Telstra

MOBILE NETWORK SITE 252331

MOORE PARK TODMAN AVE

SITE SPECIFIC NOTES - SHEET 3 OF 3

2 TODMAN AVENUE, MOORE PARK, NSW 2021

DWG NO.

N108926

SHT NO.

S0-2

1

2



3

4

5

6

A3

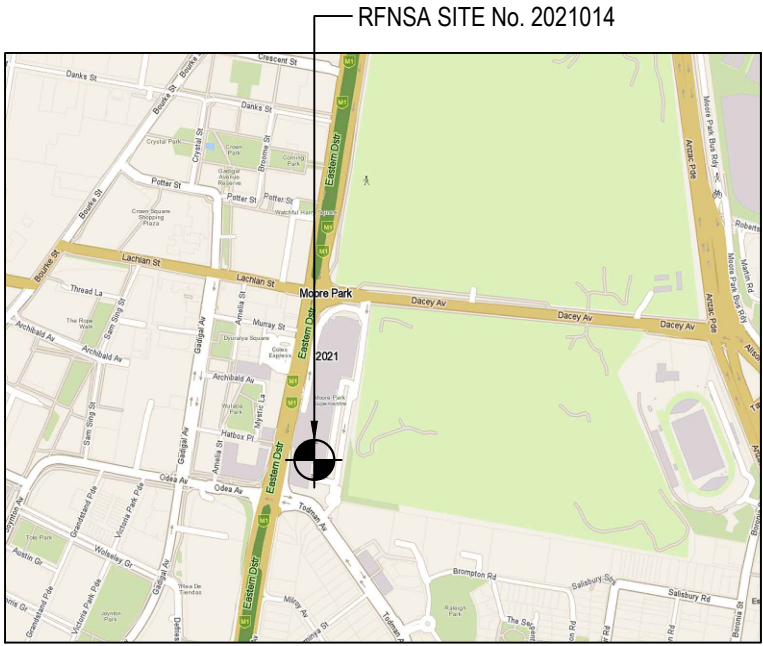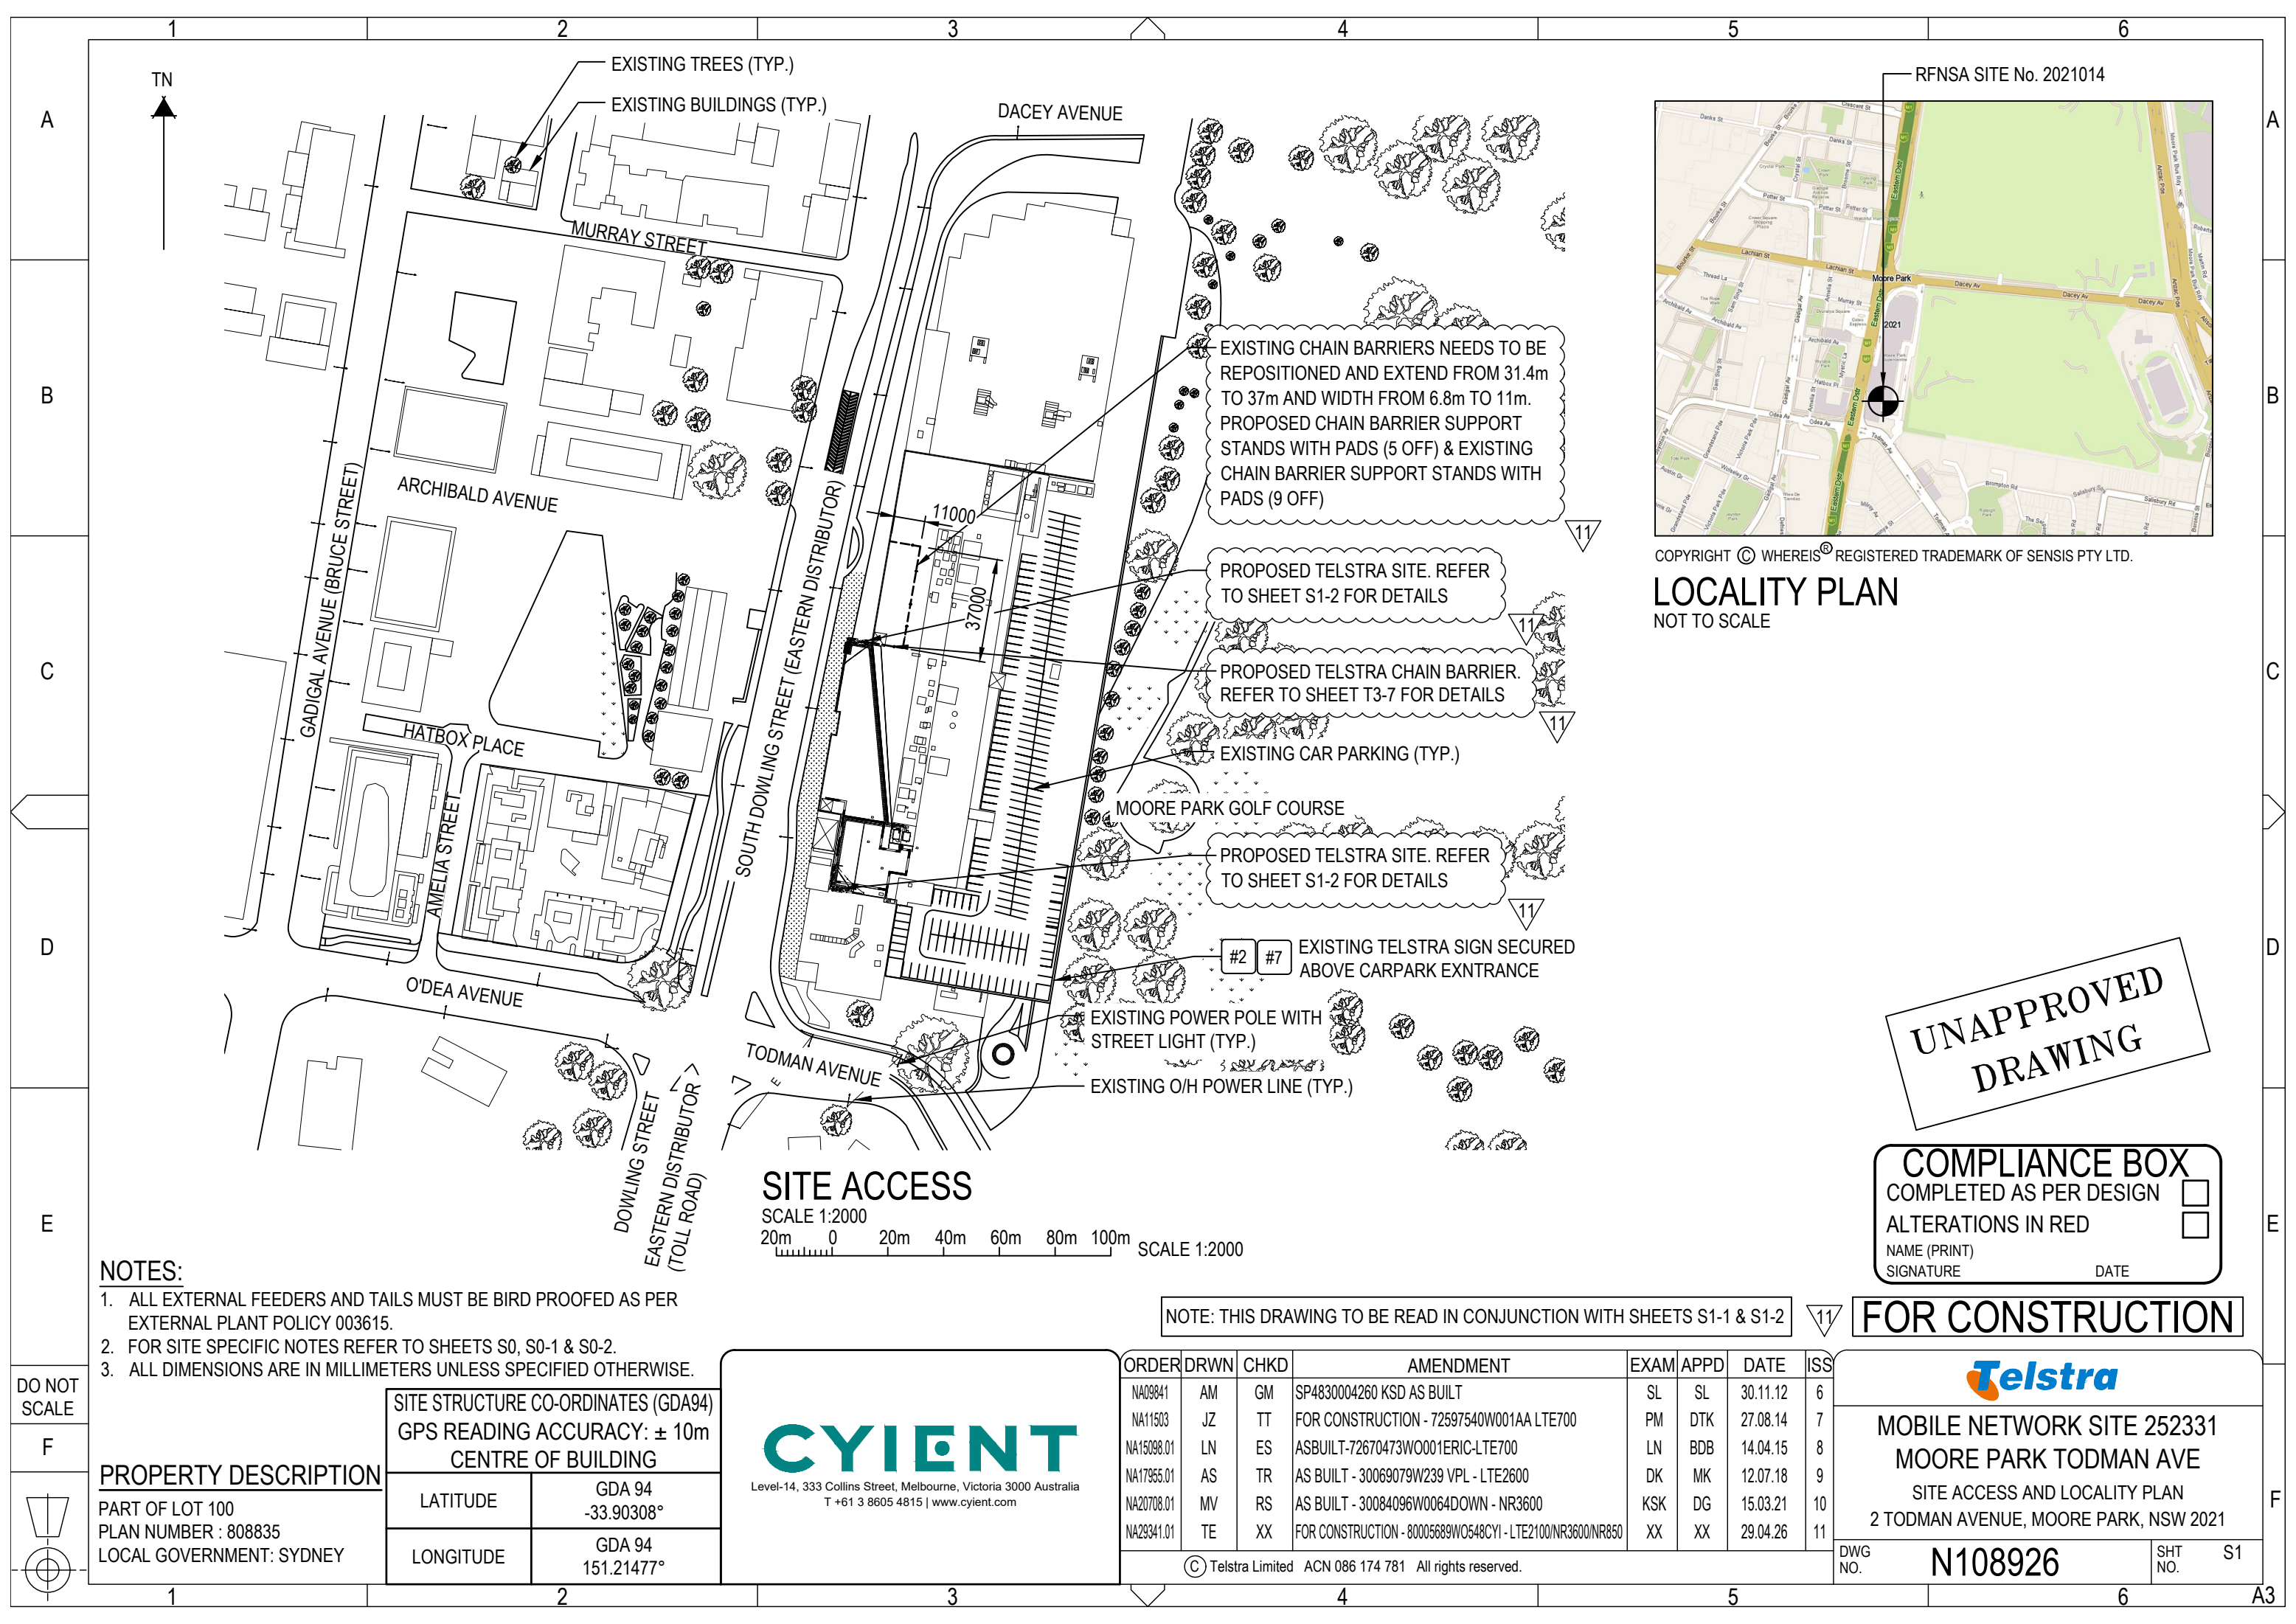

COPYRIGHT © WHEREIS® REGISTERED TRADEMARK OF SENSIS PTY LTD.

LOCALITY PLAN
NOT TO SCALE

UNAPPROVED
DRAWING

COMPLIANCE BOX

COMPLETED AS PER DESIGN

ALTERATIONS IN RED

NAME (PRINT)

SIGNATURE

DATE

- NOTES:
- ALL EXTERNAL FEEDERS AND TAILS MUST BE BIRD PROOFED AS PER EXTERNAL PLANT POLICY 003615.
 - FOR SITE SPECIFIC NOTES REFER TO SHEETS S0, S0-1 & S0-2.
 - ALL DIMENSIONS ARE IN MILLIMETERS UNLESS SPECIFIED OTHERWISE.

NOTE: THIS DRAWING TO BE READ IN CONJUNCTION WITH SHEETS S1-1 & S1-2

PROPERTY DESCRIPTION		
PART OF LOT 100		
PLAN NUMBER : 808835		
LOCAL GOVERNMENT: SYDNEY		
SITE STRUCTURE CO-ORDINATES (GDA94)		
GPS READING ACCURACY: ± 10m		
CENTRE OF BUILDING		
LATITUDE	GDA 94	
	-33.90308°	
LONGITUDE	GDA 94	
	151.21477°	

CYIENT

Level-14, 333 Collins Street, Melbourne, Victoria 3000 Australia

T +61 3 8605 4815 | www.cyient.com

ORDER	DRWN	CHKD	AMENDMENT	EXAM	APPD	DATE	ISS
NA09841	AM	GM	SP4830004260 KSD AS BUILT	SL	SL	30.11.12	6
NA11503	JZ	TT	FOR CONSTRUCTION - 72597540W001AA LTE700	PM	DTK	27.08.14	7
NA15098.01	LN	ES	ASBUILT-72670473W0001ERIC-LTE700	LN	BDB	14.04.15	8
NA17955.01	AS	TR	AS BUILT - 30069079W239 VPL - LTE2600	DK	MK	12.07.18	9
NA20708.01	MV	RS	AS BUILT - 30084096W0064DOWN - NR3600	KSK	DG	15.03.21	10
NA29341.01	TE	XX	FOR CONSTRUCTION - 80005689W0548CYI - LTE2100/NR3600/NR850	XX	XX	29.04.26	11

FOR CONSTRUCTION

Telstra

MOBILE NETWORK SITE 252331

MOORE PARK TODMAN AVE

SITE ACCESS AND LOCALITY PLAN


2 TODMAN AVENUE, MOORE PARK, NSW 2021


DWG NO.

N108926

SHT NO.

S1

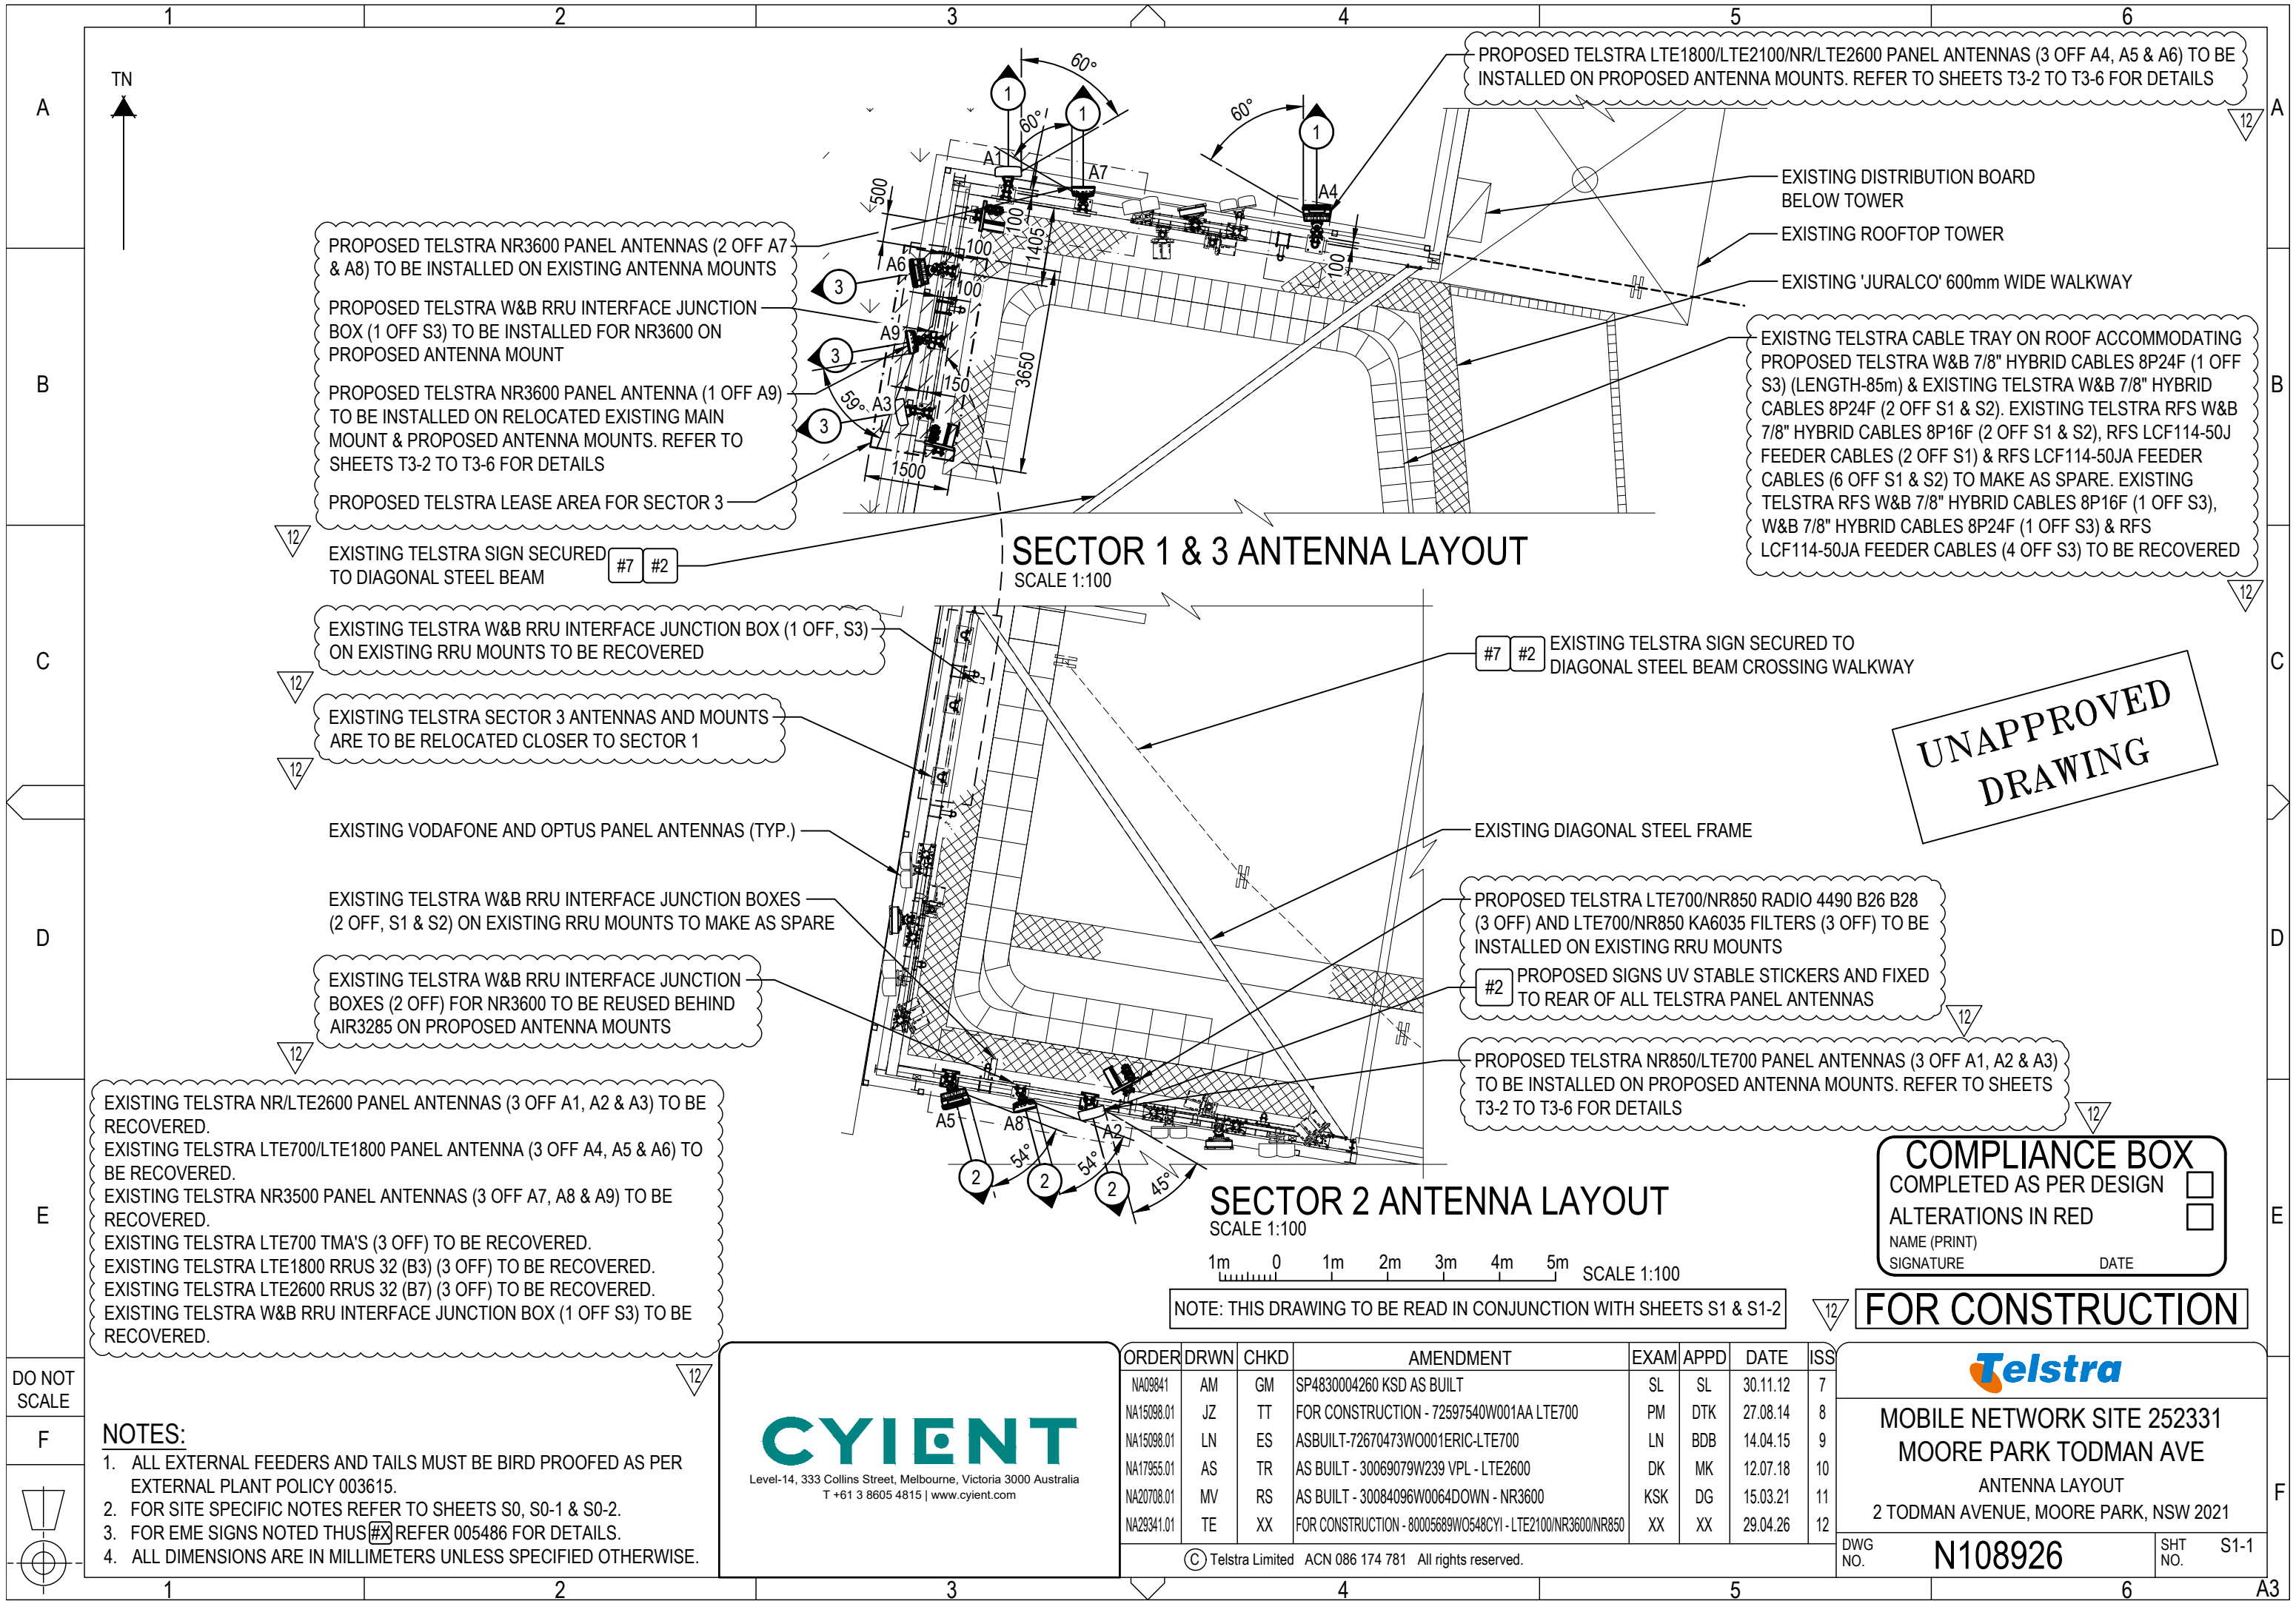

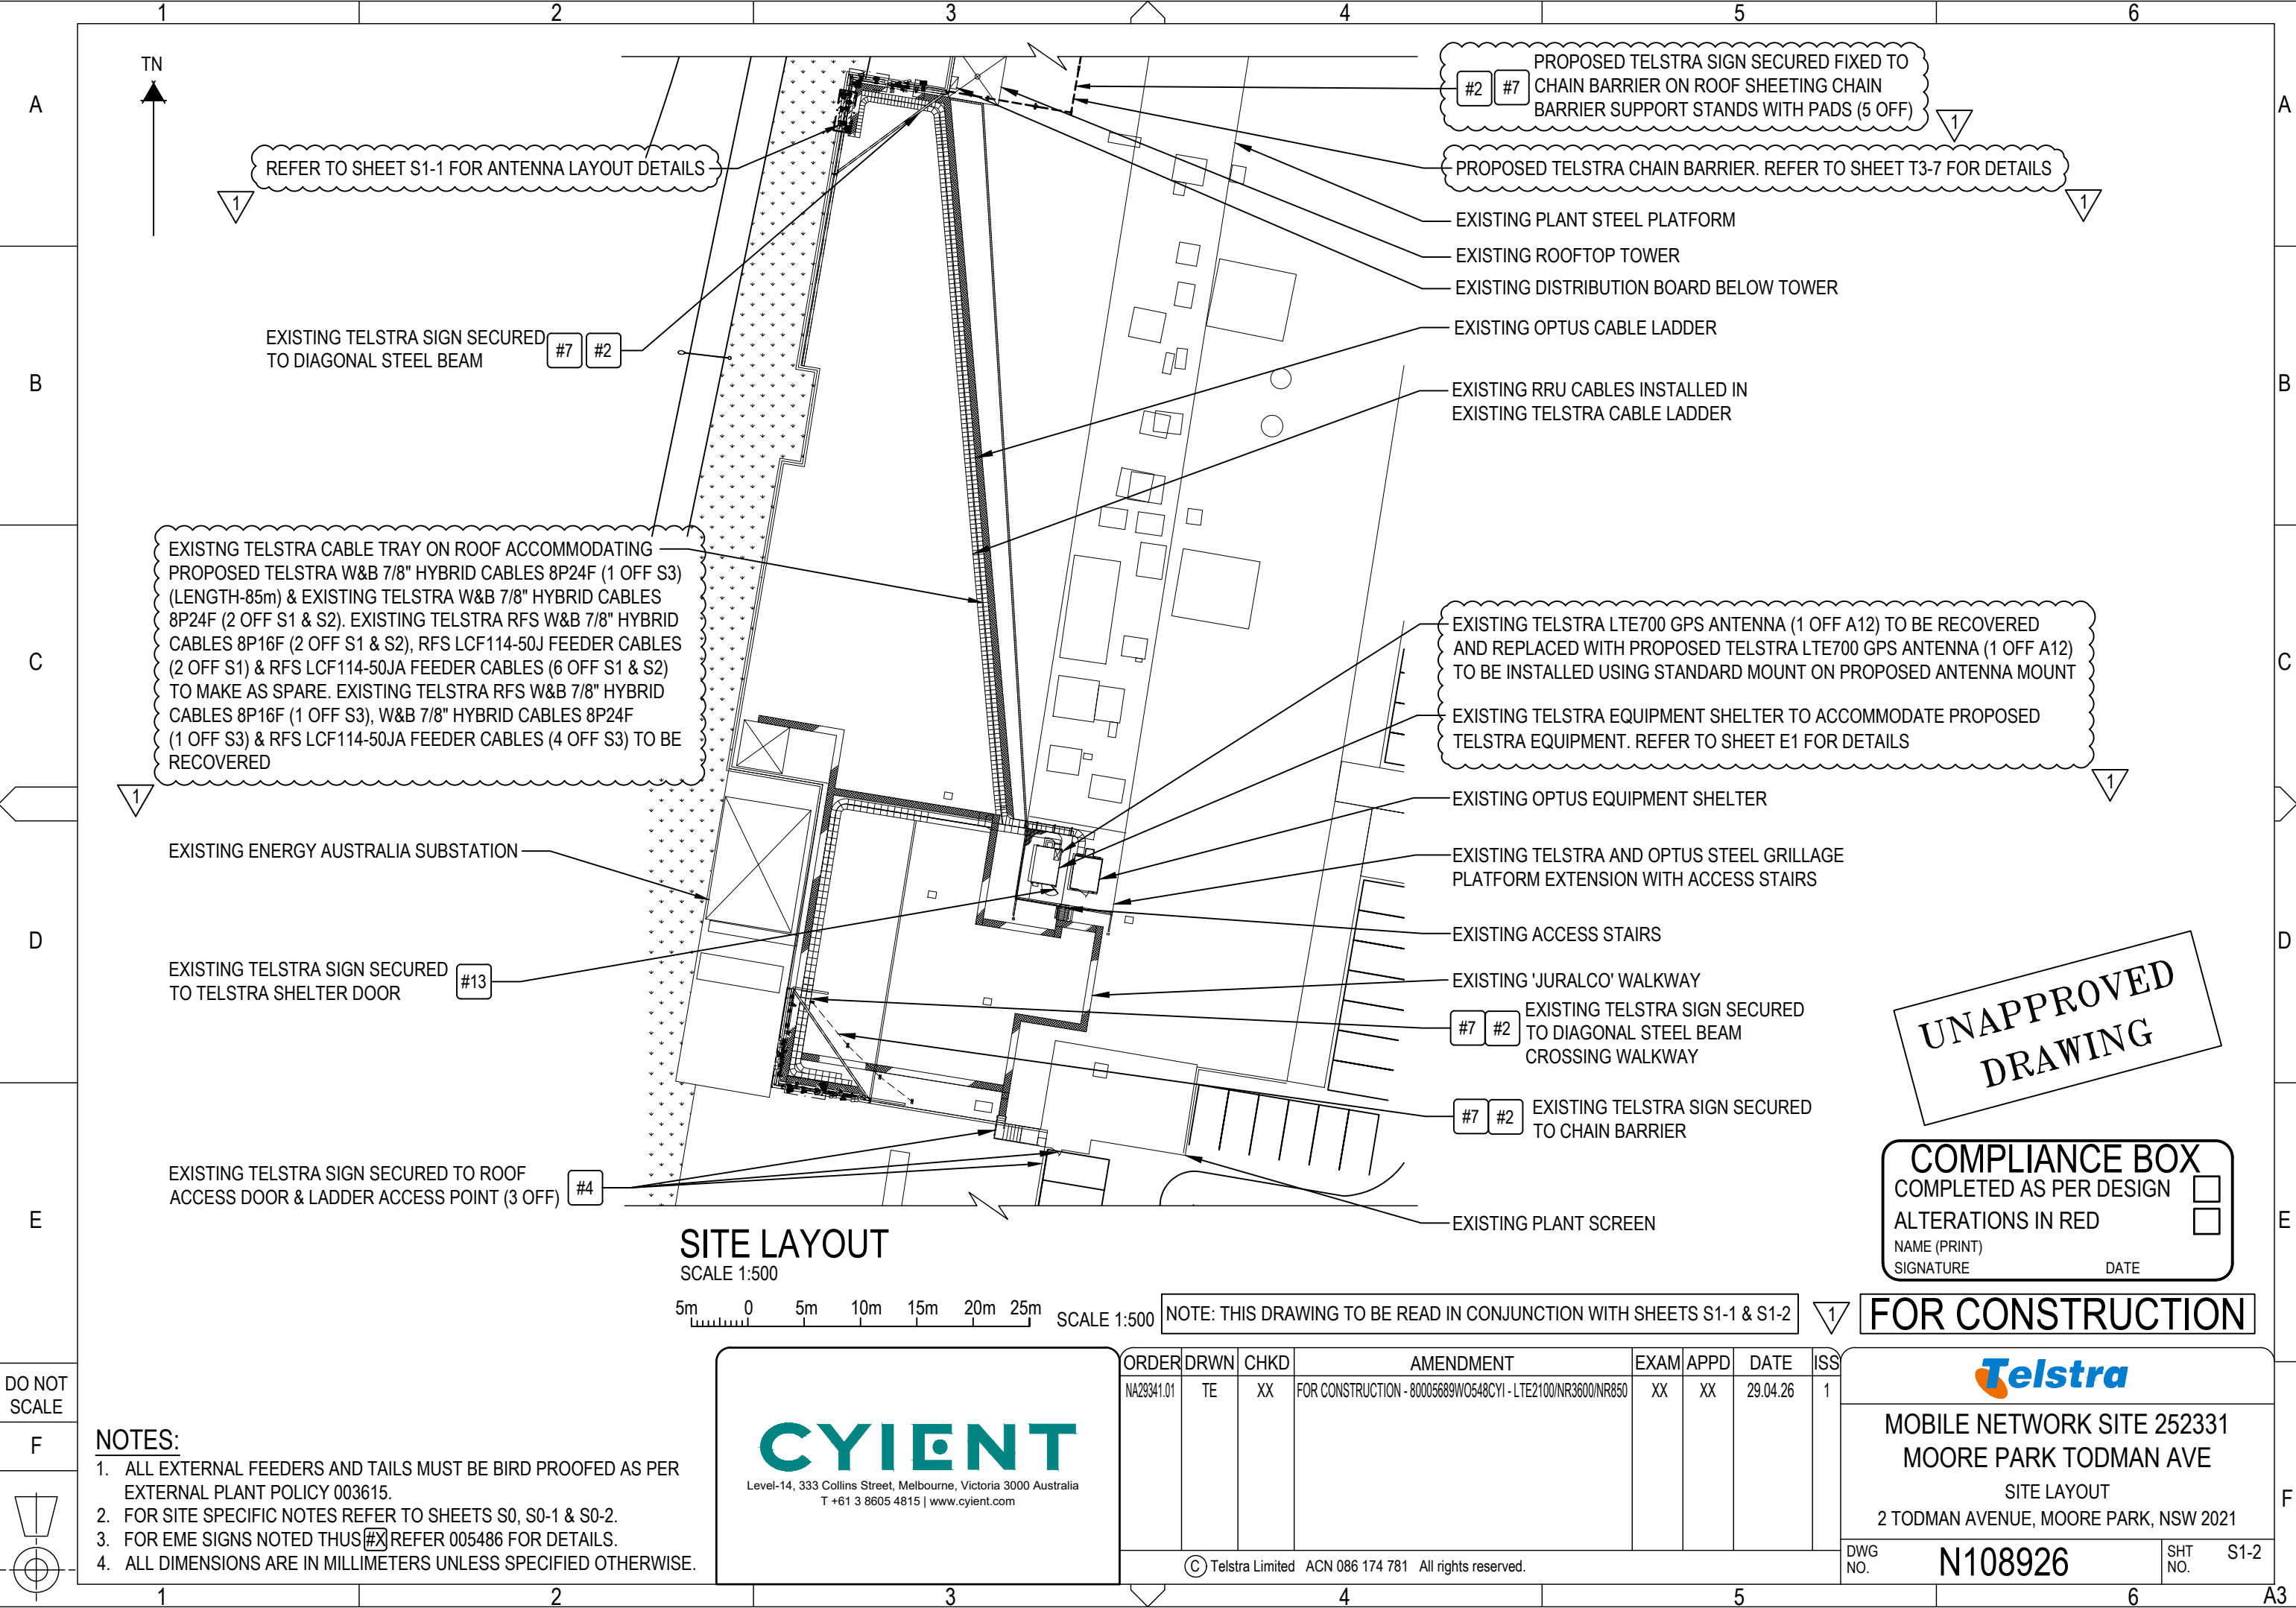

DO NOT SCALE

F

- NOTES:**
- 1. ALL EXTERNAL FEEDERS AND TAILS MUST BE BIRD PROOFED AS PER EXTERNAL PLANT POLICY 003615.
 - 2. FOR SITE SPECIFIC NOTES REFER TO SHEETS S0, S0-1 & S0-2.
 - 3. FOR EME SIGNS NOTED THUS ~~#X~~ REFER 005486 FOR DETAILS.
 - 4. ALL DIMENSIONS ARE IN MILLIMETERS UNLESS SPECIFIED OTHERWISE.

Level-14, 333 Collins Street, Melbourne, Victoria 3000 Australia
T +61 3 8605 4815 | www.cyient.com

ORDER	DRWN	CHKD	AMENDMENT	EXAM	APPD	DATE	ISS
NA29341.01	TE	XX	FOR CONSTRUCTION - 80005689W0548CY1 - LTE2100/NR3600/NR850	XX	XX	29.04.26	1

© Telstra Limited ACN 086 174 781 All rights reserved.

MOBILE NETWORK SITE 252331
MOORE PARK TODMAN AVE
SITE LAYOUT
2 TODMAN AVENUE, MOORE PARK, NSW 2021

DWG NO. **N108926**

SHT NO. S1-2

UNAPPROVED
DRAWING

COMPLIANCE BOX

COMPLETED AS PER DESIGN


ALTERATIONS IN RED

NAME (PRINT)

SIGNATURE

DATE

FOR CONSTRUCTION

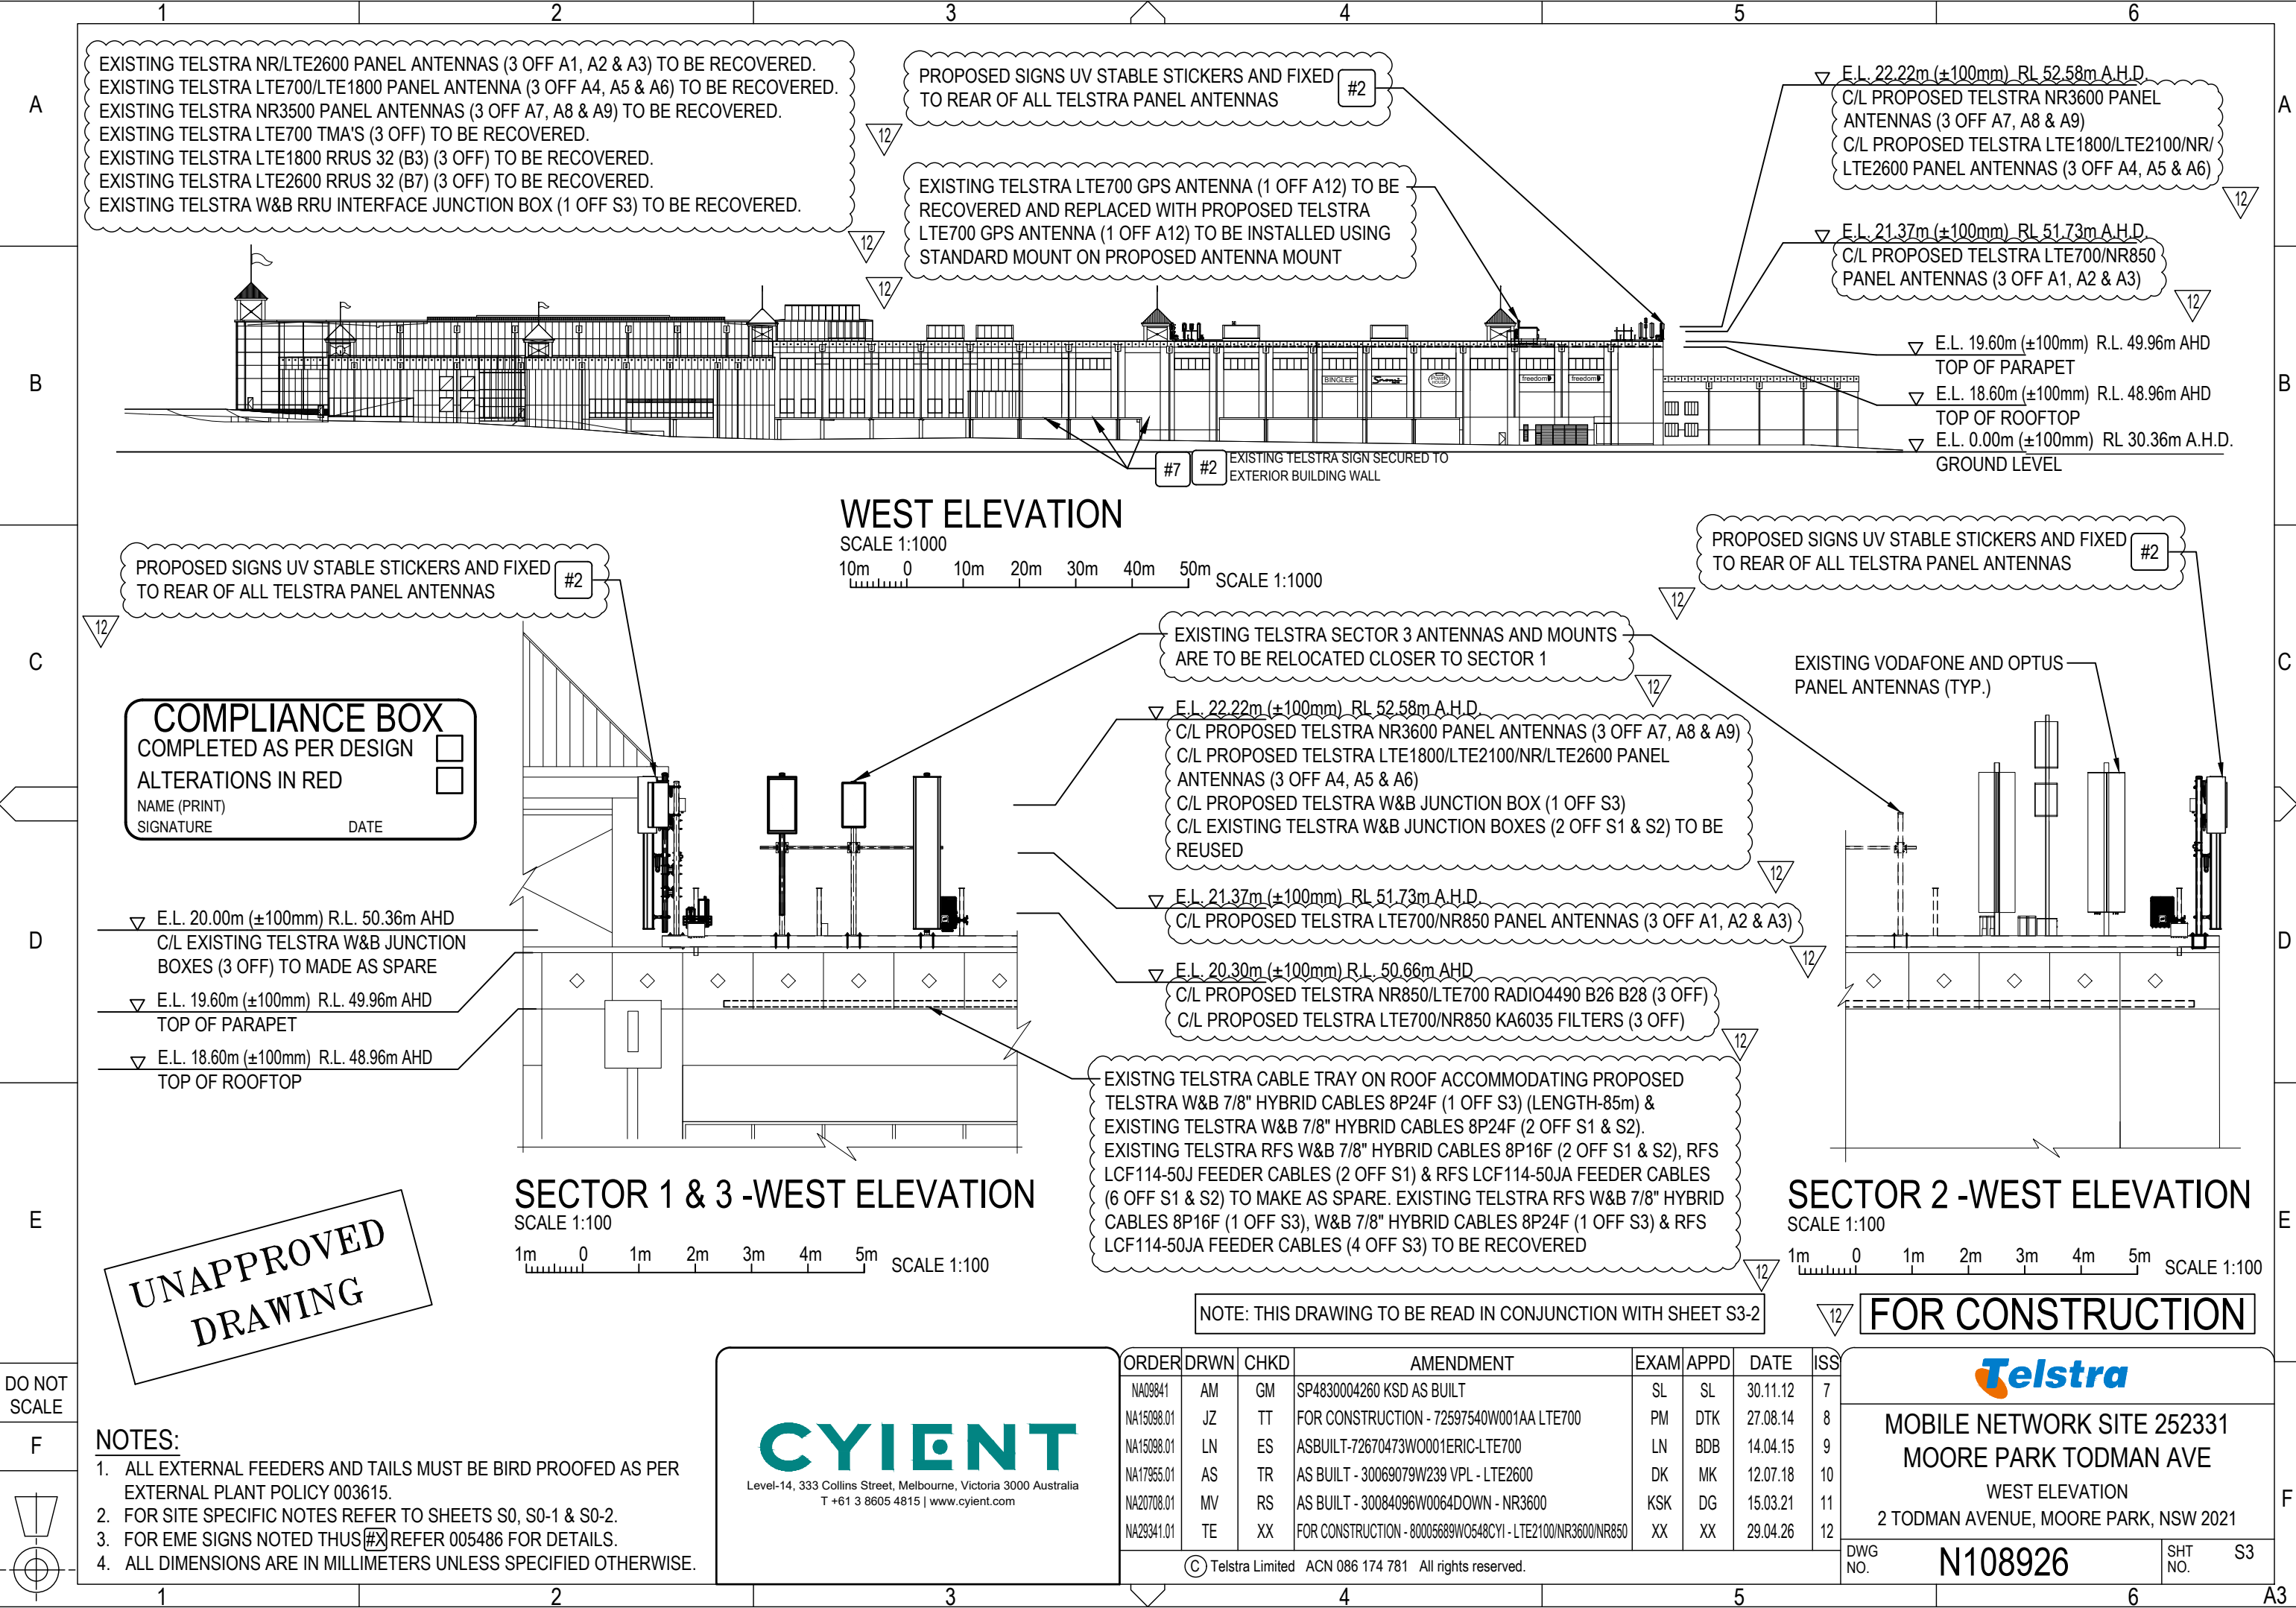

COMPLIANCE BOX

COMPLETED AS PER DESIGN

ALTERATIONS IN RED

NAME (PRINT)

SIGNATURE

DATE

UNAPPROVED
DRAWING

- NOTES:
- ALL EXTERNAL FEEDERS AND TAILS MUST BE BIRD PROOFED AS PER EXTERNAL PLANT POLICY 003615.
 - FOR SITE SPECIFIC NOTES REFER TO SHEETS S0, S0-1 & S0-2.
 - FOR EME SIGNS NOTED THUS [X] REFER 005486 FOR DETAILS.
 - ALL DIMENSIONS ARE IN MILLIMETERS UNLESS SPECIFIED OTHERWISE.

CYIENT

Level-14, 333 Collins Street, Melbourne, Victoria 3000 Australia
T +61 3 8605 4815 | www.cyient.com

ORDER	DRWN	CHKD	AMENDMENT	EXAM	APPD	DATE	ISS
NA09841	AM	GM	SP4830004260 KSD AS BUILT	SL	SL	30.11.12	7
NA15098.01	JZ	TT	FOR CONSTRUCTION - 72597540W001AA LTE700	PM	DTK	27.08.14	8
NA15098.01	LN	ES	ASBUILT-72670473W0001ERIC-LTE700	LN	BDB	14.04.15	9
NA17955.01	AS	TR	AS BUILT - 30069079W239 VPL - LTE2600	DK	MK	12.07.18	10
NA20708.01	MV	RS	AS BUILT - 30084096W0064DOWN - NR3600	KSK	DG	15.03.21	11
NA29341.01	TE	XX	FOR CONSTRUCTION - 80005689W0548CYI - LTE2100/NR3600/NR850	XX	XX	29.04.26	12

© Telstra Limited ACN 086 174 781 All rights reserved.




MOBILE NETWORK SITE 252331
MOORE PARK TODMAN AVE
WEST ELEVATION
2 TODMAN AVENUE, MOORE PARK, NSW 2021

DWG
NO.

N108926

SHT
NO.

S3

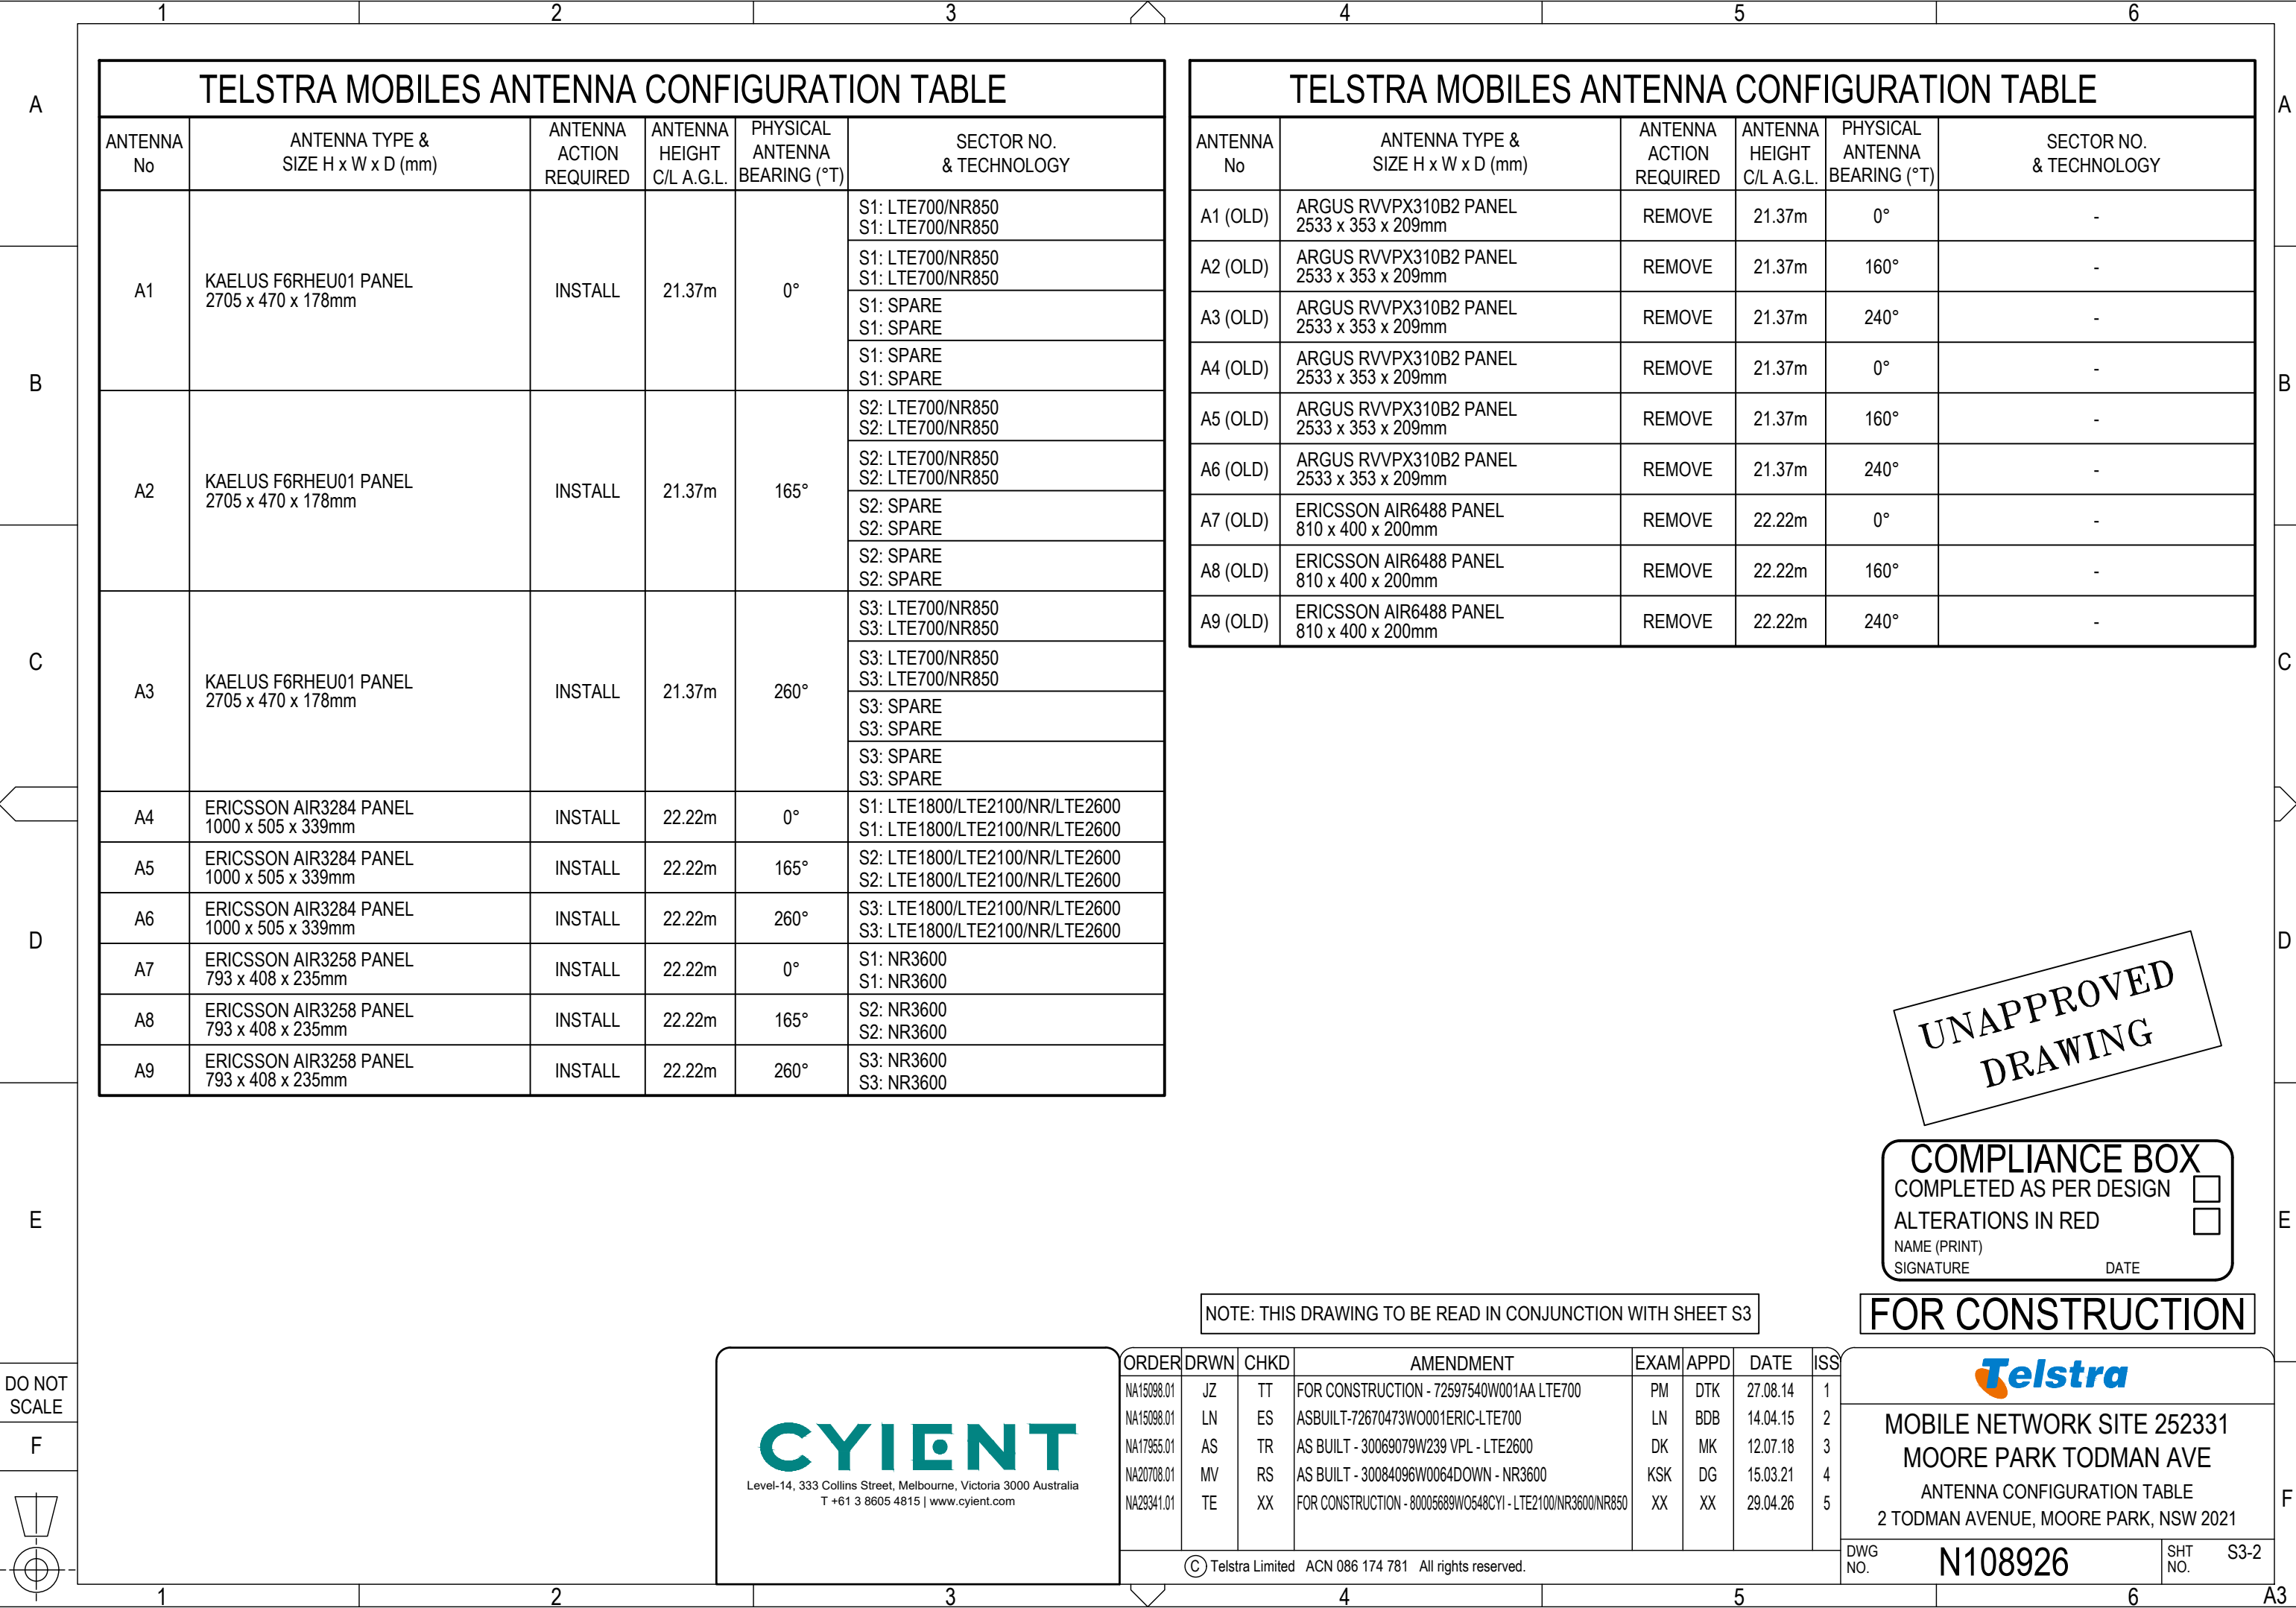

TELSTRA MOBILES ANTENNA CONFIGURATION TABLE

ANTENNA No	ANTENNA TYPE & SIZE H x W x D (mm)	ANTENNA ACTION REQUIRED	ANTENNA HEIGHT C/L A.G.L.	PHYSICAL ANTENNA BEARING (°T)	SECTOR NO. & TECHNOLOGY
A1	KAEIUS F6RHEU01 PANEL 2705 x 470 x 178mm	INSTALL	21.37m	0°	S1: LTE700/NR850 S1: LTE700/NR850
					S1: LTE700/NR850 S1: LTE700/NR850
					S1: SPARE S1: SPARE
					S1: SPARE S1: SPARE
A2	KAEIUS F6RHEU01 PANEL 2705 x 470 x 178mm	INSTALL	21.37m	165°	S2: LTE700/NR850 S2: LTE700/NR850
					S2: LTE700/NR850 S2: LTE700/NR850
					S2: SPARE S2: SPARE
					S2: SPARE S2: SPARE
A3	KAEIUS F6RHEU01 PANEL 2705 x 470 x 178mm	INSTALL	21.37m	260°	S3: LTE700/NR850 S3: LTE700/NR850
					S3: LTE700/NR850 S3: LTE700/NR850
					S3: SPARE S3: SPARE
					S3: SPARE S3: SPARE
A4	ERICSSON AIR3284 PANEL 1000 x 505 x 339mm	INSTALL	22.22m	0°	S1: LTE1800/LTE2100/NR/LTE2600 S1: LTE1800/LTE2100/NR/LTE2600
A5	ERICSSON AIR3284 PANEL 1000 x 505 x 339mm	INSTALL	22.22m	165°	S2: LTE1800/LTE2100/NR/LTE2600 S2: LTE1800/LTE2100/NR/LTE2600
A6	ERICSSON AIR3284 PANEL 1000 x 505 x 339mm	INSTALL	22.22m	260°	S3: LTE1800/LTE2100/NR/LTE2600 S3: LTE1800/LTE2100/NR/LTE2600
A7	ERICSSON AIR3258 PANEL 793 x 408 x 235mm	INSTALL	22.22m	0°	S1: NR3600 S1: NR3600
A8	ERICSSON AIR3258 PANEL 793 x 408 x 235mm	INSTALL	22.22m	165°	S2: NR3600 S2: NR3600
A9	ERICSSON AIR3258 PANEL 793 x 408 x 235mm	INSTALL	22.22m	260°	S3: NR3600 S3: NR3600

TELSTRA MOBILES ANTENNA CONFIGURATION TABLE

ANTENNA No	ANTENNA TYPE & SIZE H x W x D (mm)	ANTENNA ACTION REQUIRED	ANTENNA HEIGHT C/L A.G.L.	PHYSICAL ANTENNA BEARING (°T)	SECTOR NO. & TECHNOLOGY
A1 (OLD)	ARGUS RVVPX310B2 PANEL 2533 x 353 x 209mm	REMOVE	21.37m	0°	-
A2 (OLD)	ARGUS RVVPX310B2 PANEL 2533 x 353 x 209mm	REMOVE	21.37m	160°	-
A3 (OLD)	ARGUS RVVPX310B2 PANEL 2533 x 353 x 209mm	REMOVE	21.37m	240°	-
A4 (OLD)	ARGUS RVVPX310B2 PANEL 2533 x 353 x 209mm	REMOVE	21.37m	0°	-
A5 (OLD)	ARGUS RVVPX310B2 PANEL 2533 x 353 x 209mm	REMOVE	21.37m	160°	-
A6 (OLD)	ARGUS RVVPX310B2 PANEL 2533 x 353 x 209mm	REMOVE	21.37m	240°	-
A7 (OLD)	ERICSSON AIR6488 PANEL 810 x 400 x 200mm	REMOVE	22.22m	0°	-
A8 (OLD)	ERICSSON AIR6488 PANEL 810 x 400 x 200mm	REMOVE	22.22m	160°	-
A9 (OLD)	ERICSSON AIR6488 PANEL 810 x 400 x 200mm	REMOVE	22.22m	240°	-

UNAPPROVED
DRAWING

COMPLIANCE BOX

COMPLETED AS PER DESIGN ☐

ALTERATIONS IN RED ☐

NAME (PRINT)

SIGNATURE

DATE

FOR CONSTRUCTION

CYIENT

Level-14, 333 Collins Street, Melbourne, Victoria 3000 Australia
T +61 3 8605 4815 | www.cyient.com

NOTE: THIS DRAWING TO BE READ IN CONJUNCTION WITH SHEET S3

ORDER	DRWN	CHKD	AMENDMENT	EXAM	APPD	DATE	ISS
NA15098.01	JZ	TT	FOR CONSTRUCTION - 72597540W001AA LTE700	PM	DTK	27.08.14	1
NA15098.01	LN	ES	ASBUILT-72670473W0001ERIC-LTE700	LN	BDB	14.04.15	2
NA17955.01	AS	TR	AS BUILT - 30069079W239 VPL - LTE2600	DK	MK	12.07.18	3
NA20708.01	MV	RS	AS BUILT - 30084096W0064DOWN - NR3600	KSK	DG	15.03.21	4
NA29341.01	TE	XX	FOR CONSTRUCTION - 80005689W0548CYI - LTE2100/NR3600/NR850	XX	XX	29.04.26	5

© Telstra Limited ACN 086 174 781 All rights reserved.



MOBILE NETWORK SITE 252331
MOORE PARK TODMAN AVE


ANTENNA CONFIGURATION TABLE
2 TODMAN AVENUE, MOORE PARK, NSW 2021

DWG NO.

N108926

SHT NO.

S3-2

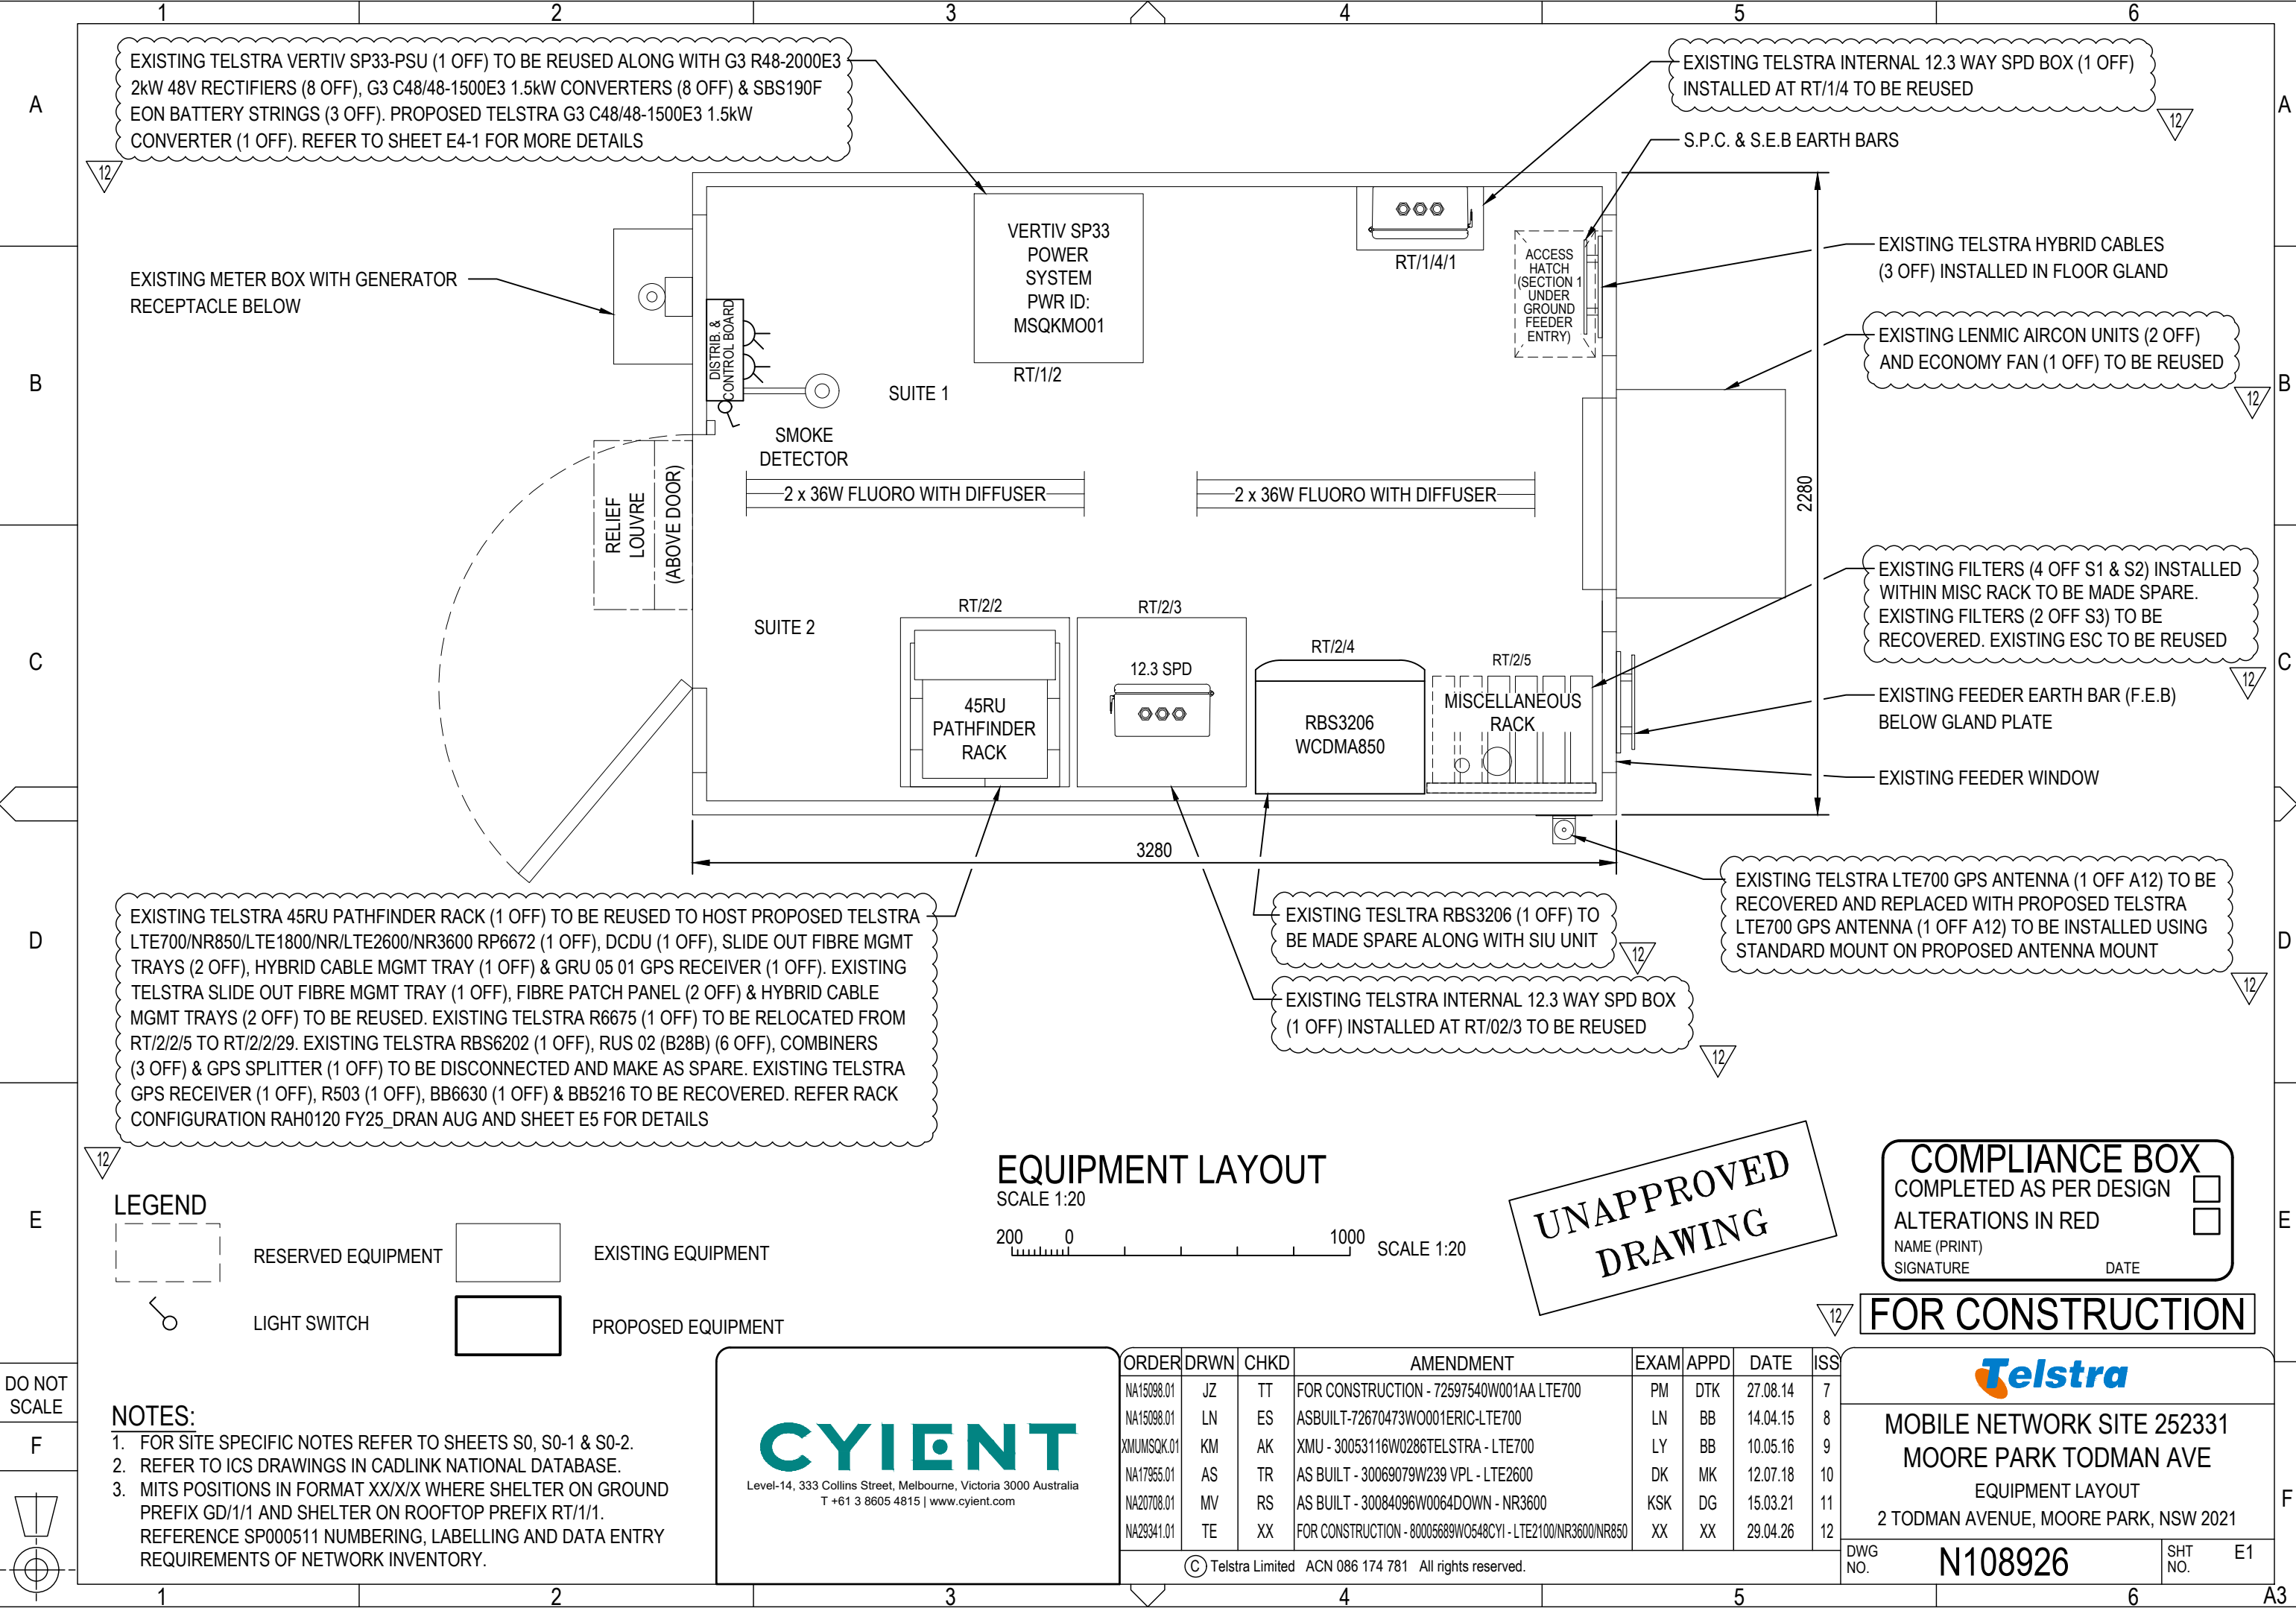

EXISTING TELSTRA VERTIV SP33-PSU (1 OFF) TO BE REUSED ALONG WITH G3 R48-2000E3 2kW 48V RECTIFIERS (8 OFF), G3 C48/48-1500E3 1.5kW CONVERTERS (8 OFF) & SBS190F EON BATTERY STRINGS (3 OFF). PROPOSED TELSTRA G3 C48/48-1500E3 1.5kW CONVERTER (1 OFF). REFER TO SHEET E4-1 FOR MORE DETAILS

EXISTING TELSTRA INTERNAL 12.3 WAY SPD BOX (1 OFF) INSTALLED AT RT/1/4 TO BE REUSED

EXISTING METER BOX WITH GENERATOR RECEPTACLE BELOW

VERTIV SP33
POWER
SYSTEM
PWR ID:
MSQKMO01

RT/1/4/1

ACCESS
HATCH
(SECTION 1
UNDER
GROUND
FEEDER
ENTRY)

S.P.C. & S.E.B EARTH BARS

EXISTING TELSTRA HYBRID CABLES
(3 OFF) INSTALLED IN FLOOR GLAND

EXISTING LENMIC AIRCON UNITS (2 OFF)
AND ECONOMY FAN (1 OFF) TO BE REUSED

EXISTING FILTERS (4 OFF S1 & S2) INSTALLED
WITHIN MISC RACK TO BE MADE SPARE.
EXISTING FILTERS (2 OFF S3) TO BE
RECOVERED. EXISTING ESC TO BE REUSED

EXISTING FEEDER EARTH BAR (F.E.B)
BELOW GLAND PLATE

EXISTING FEEDER WINDOW

EXISTING TELSTRA 45RU PATHFINDER RACK (1 OFF) TO BE REUSED TO HOST PROPOSED TELSTRA LTE700/NR850/LTE1800/NR/LTE2600/NR3600 RP6672 (1 OFF), DCPU (1 OFF), SLIDE OUT FIBRE MGMT TRAYS (2 OFF), HYBRID CABLE MGMT TRAY (1 OFF) & GRU 05 01 GPS RECEIVER (1 OFF). EXISTING TELSTRA SLIDE OUT FIBRE MGMT TRAY (1 OFF), FIBRE PATCH PANEL (2 OFF) & HYBRID CABLE MGMT TRAYS (2 OFF) TO BE REUSED. EXISTING TELSTRA R6675 (1 OFF) TO BE RELOCATED FROM RT/2/2/5 TO RT/2/2/29. EXISTING TELSTRA RBS6202 (1 OFF), RUS 02 (B28B) (6 OFF), COMBINERS (3 OFF) & GPS SPLITTER (1 OFF) TO BE DISCONNECTED AND MAKE AS SPARE. EXISTING TELSTRA GPS RECEIVER (1 OFF), R503 (1 OFF), BB6630 (1 OFF) & BB5216 TO BE RECOVERED. REFER RACK CONFIGURATION RAH0120 FY25_DRAN AUG AND SHEET E5 FOR DETAILS

EXISTING TESLTRA RBS3206 (1 OFF) TO
BE MADE SPARE ALONG WITH SIU UNIT

EXISTING TELSTRA INTERNAL 12.3 WAY SPD BOX
(1 OFF) INSTALLED AT RT/02/3 TO BE REUSED

EXISTING TELSTRA LTE700 GPS ANTENNA (1 OFF A12) TO BE
RECOVERED AND REPLACED WITH PROPOSED TELSTRA
LTE700 GPS ANTENNA (1 OFF A12) TO BE INSTALLED USING
STANDARD MOUNT ON PROPOSED ANTENNA MOUNT

LEGEND



RESERVED EQUIPMENT



EXISTING EQUIPMENT



LIGHT SWITCH



PROPOSED EQUIPMENT

EQUIPMENT LAYOUT

SCALE 1:20



UNAPPROVED
DRAWING

COMPLIANCE BOX
COMPLETED AS PER DESIGN ☐
ALTERATIONS IN RED ☐
NAME (PRINT) _____
SIGNATURE _____ DATE _____

FOR CONSTRUCTION

NOTES:

- FOR SITE SPECIFIC NOTES REFER TO SHEETS S0, S0-1 & S0-2.
- REFER TO ICS DRAWINGS IN CADLINK NATIONAL DATABASE.
- MITS POSITIONS IN FORMAT XX/X/X WHERE SHELTER ON GROUND PREFIX GD/1/1 AND SHELTER ON ROOFTOP PREFIX RT/1/1. REFERENCE SP000511 NUMBERING, LABELLING AND DATA ENTRY REQUIREMENTS OF NETWORK INVENTORY.

CYIENT

Level-14, 333 Collins Street, Melbourne, Victoria 3000 Australia
T +61 3 8605 4815 | www.cyient.com

ORDER	DRWN	CHKD	AMENDMENT	EXAM	APPD	DATE	ISS
NA15098.01	JZ	TT	FOR CONSTRUCTION - 72597540W001AA LTE700	PM	DTK	27.08.14	7
NA15098.01	LN	ES	ASBUILT-72670473W0001ERIC-LTE700	LN	BB	14.04.15	8
XNUMSQK.01	KM	AK	XMU - 30053116W0286TELSTRA - LTE700	LY	BB	10.05.16	9
NA17955.01	AS	TR	AS BUILT - 30069079W239 VPL - LTE2600	DK	MK	12.07.18	10
NA20708.01	MV	RS	AS BUILT - 30084096W0064DOWN - NR3600	KSK	DG	15.03.21	11
NA29341.01	TE	XX	FOR CONSTRUCTION - 80005689W0548CYI - LTE2100/NR3600/NR850	XX	XX	29.04.26	12

© Telstra Limited ACN 086 174 781 All rights reserved.




MOBILE NETWORK SITE 252331
MOORE PARK TODMAN AVE
EQUIPMENT LAYOUT
2 TODMAN AVENUE, MOORE PARK, NSW 2021

DWG
NO.

N108926

SHT
NO.

E1

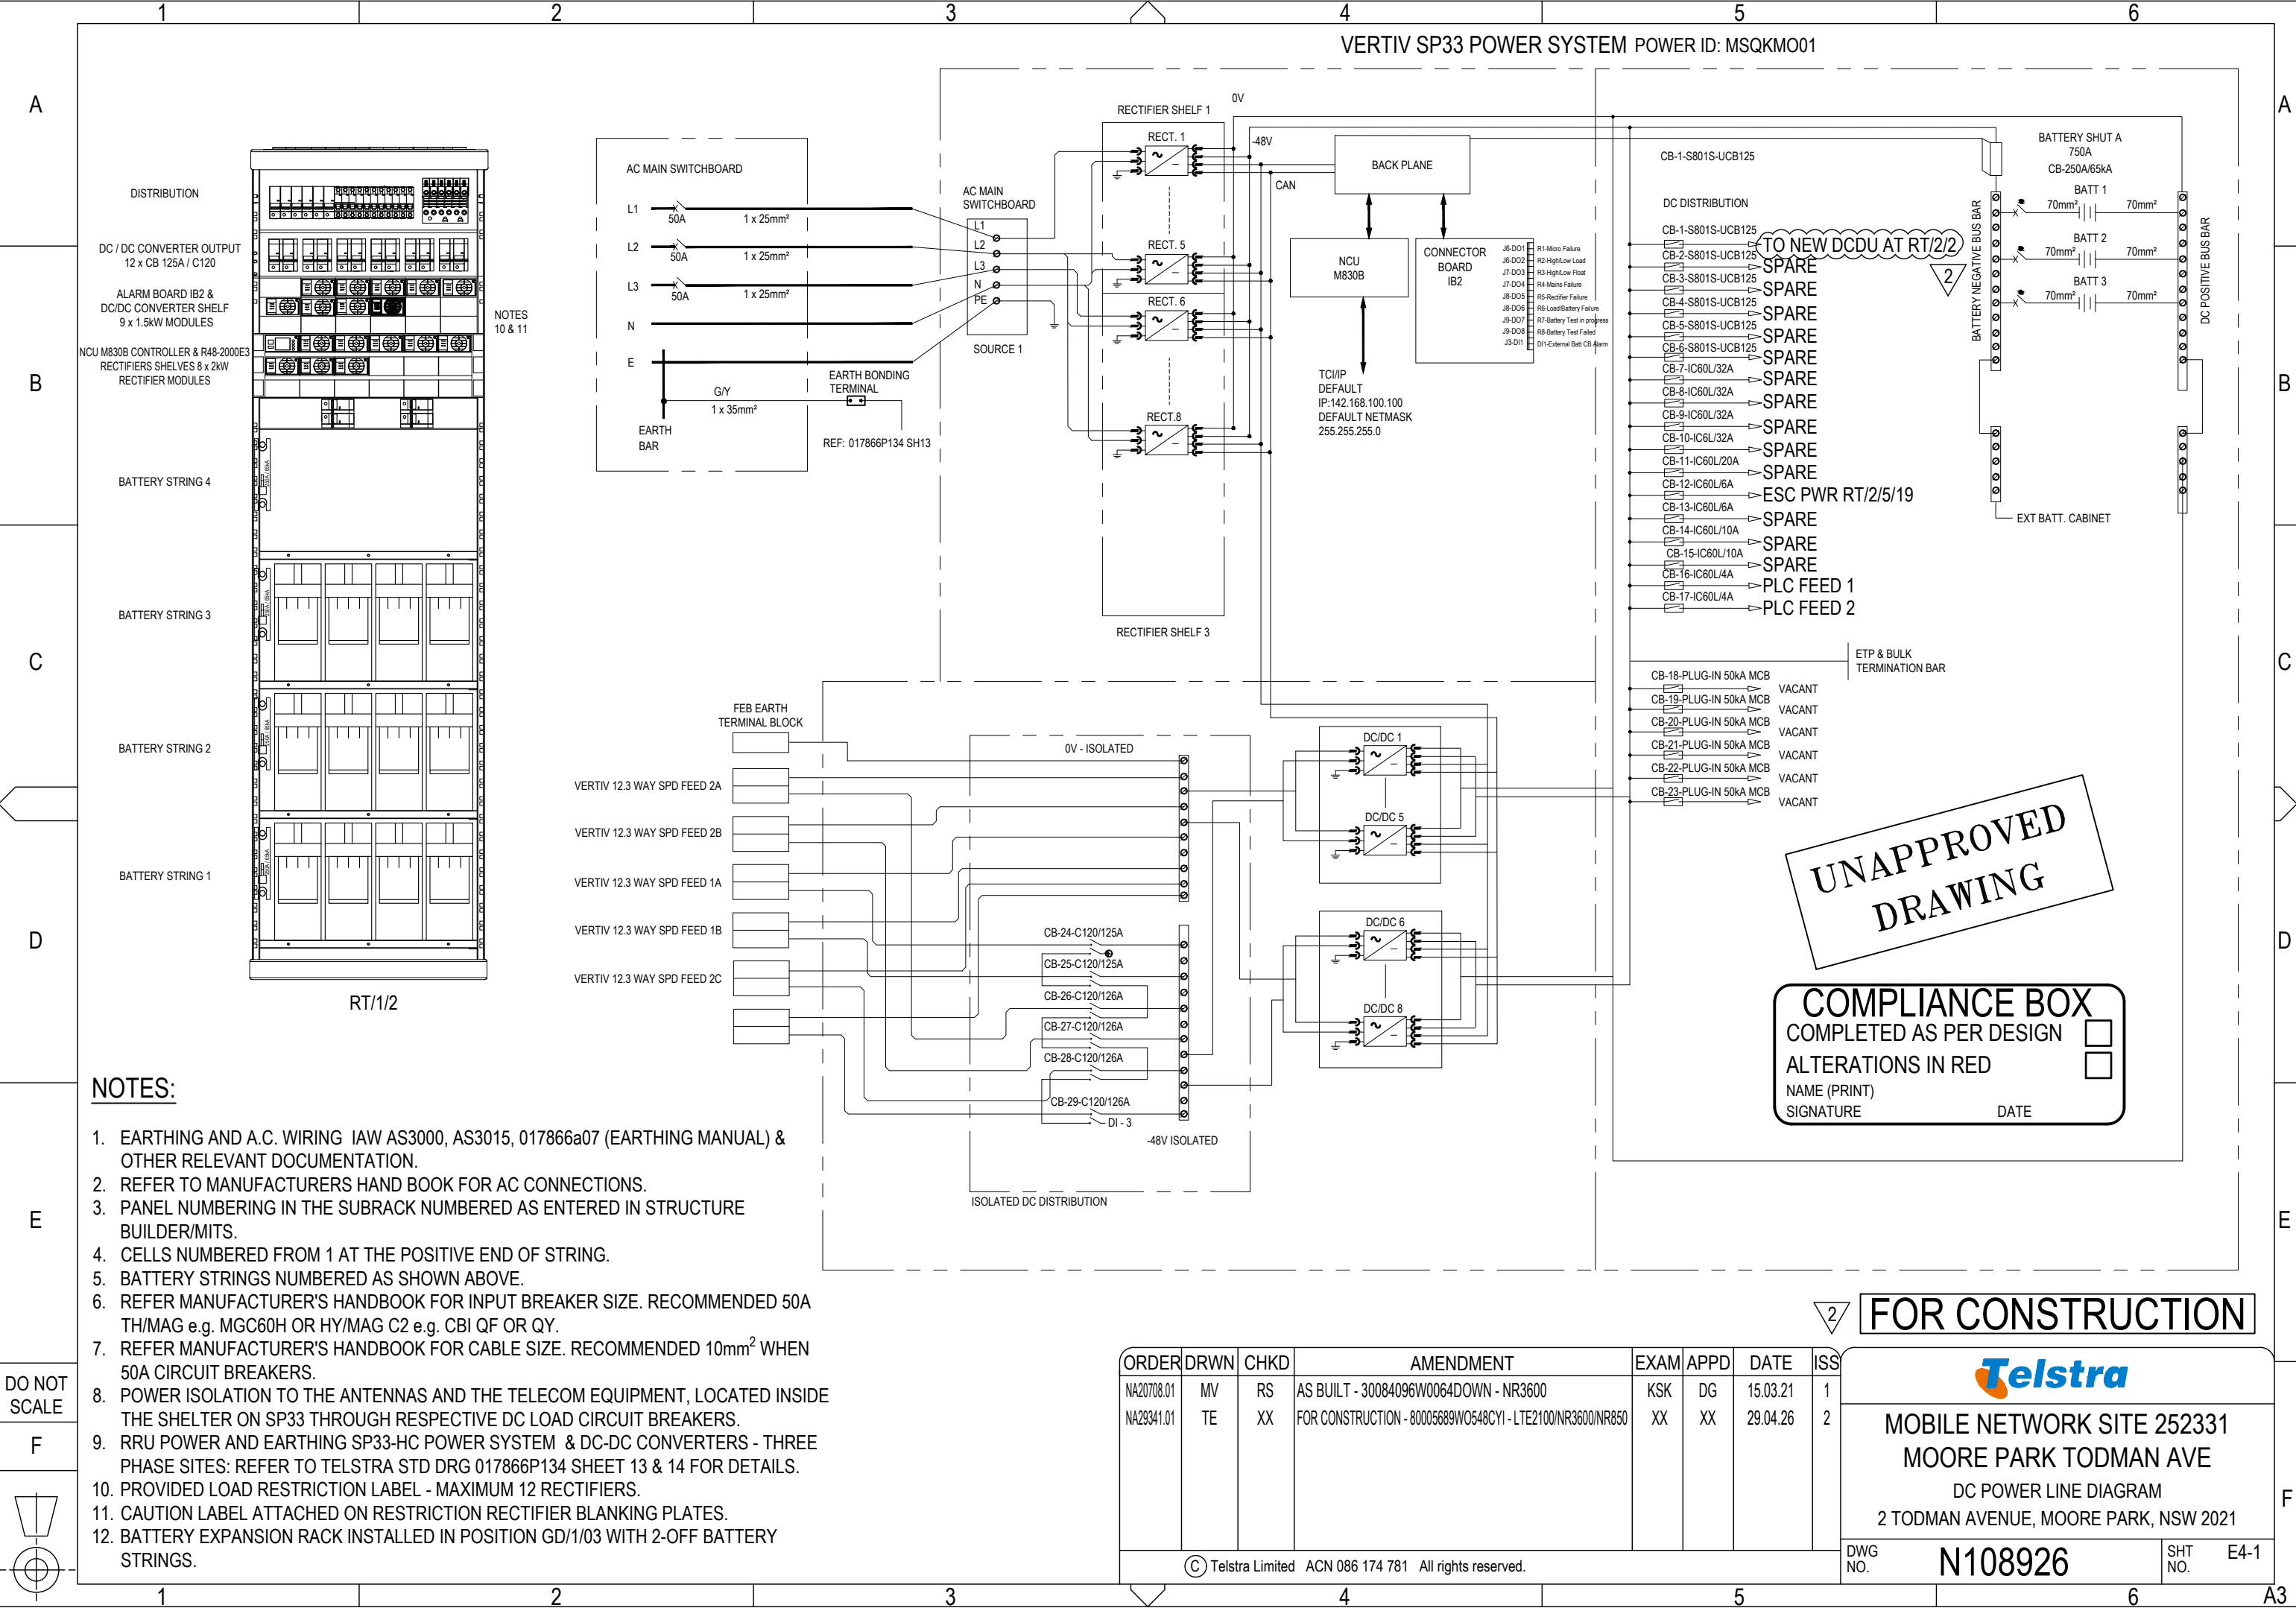

NOTES:

1. EARTHING AND A.C. WIRING IAW AS3000, AS3015, 017866a07 (EARTHING MANUAL) & OTHER RELEVANT DOCUMENTATION.
2. REFER TO MANUFACTURERS HAND BOOK FOR AC CONNECTIONS.
3. PANEL NUMBERING IN THE SUBRACK NUMBERED AS ENTERED IN STRUCTURE BUILDER/MITS.
4. CELLS NUMBERED FROM 1 AT THE POSITIVE END OF STRING.
5. BATTERY STRINGS NUMBERED AS SHOWN ABOVE.
6. REFER MANUFACTURER'S HANDBOOK FOR INPUT BREAKER SIZE. RECOMMENDED 50A TH/MAG e.g. MGC60H OR HY/MAG C2 e.g. CBI QF OR QY.
7. REFER MANUFACTURER'S HANDBOOK FOR CABLE SIZE. RECOMMENDED 10mm² WHEN 50A CIRCUIT BREAKERS.
8. POWER ISOLATION TO THE ANTENNAS AND THE TELECOM EQUIPMENT, LOCATED INSIDE THE SHELTER ON SP33 THROUGH RESPECTIVE DC LOAD CIRCUIT BREAKERS.
9. RRU POWER AND EARTHING SP33-HC POWER SYSTEM & DC-DC CONVERTERS - THREE PHASE SITES: REFER TO TELSTRA STD DRG 017866P134 SHEET 13 & 14 FOR DETAILS.
10. PROVIDED LOAD RESTRICTION LABEL - MAXIMUM 12 RECTIFIERS.
11. CAUTION LABEL ATTACHED ON RESTRICTION RECTIFIER BLANKING PLATES.
12. BATTERY EXPANSION RACK INSTALLED IN POSITION GD/1/03 WITH 2-OFF BATTERY STRINGS.

ORDER	DRWN	CHKD	AMENDMENT	EXAM	APPD	DATE	ISS
NA20708.01	MV	RS	AS BUILT - 30084096W0064DOWN - NR3600	KSK	DG	15.03.21	1
NA29341.01	TE	XX	FOR CONSTRUCTION - 80005689W0548CY1 - LTE2100/NR3600/NR850	XX	XX	29.04.26	2

© Telstra Limited ACN 086 174 781 All rights reserved.

FOR CONSTRUCTION




MOBILE NETWORK SITE 252331
MOORE PARK TODMAN AVE
DC POWER LINE DIAGRAM
2 TODMAN AVENUE, MOORE PARK, NSW 2021

DWG NO.

N108926

SHT NO.

E4-1

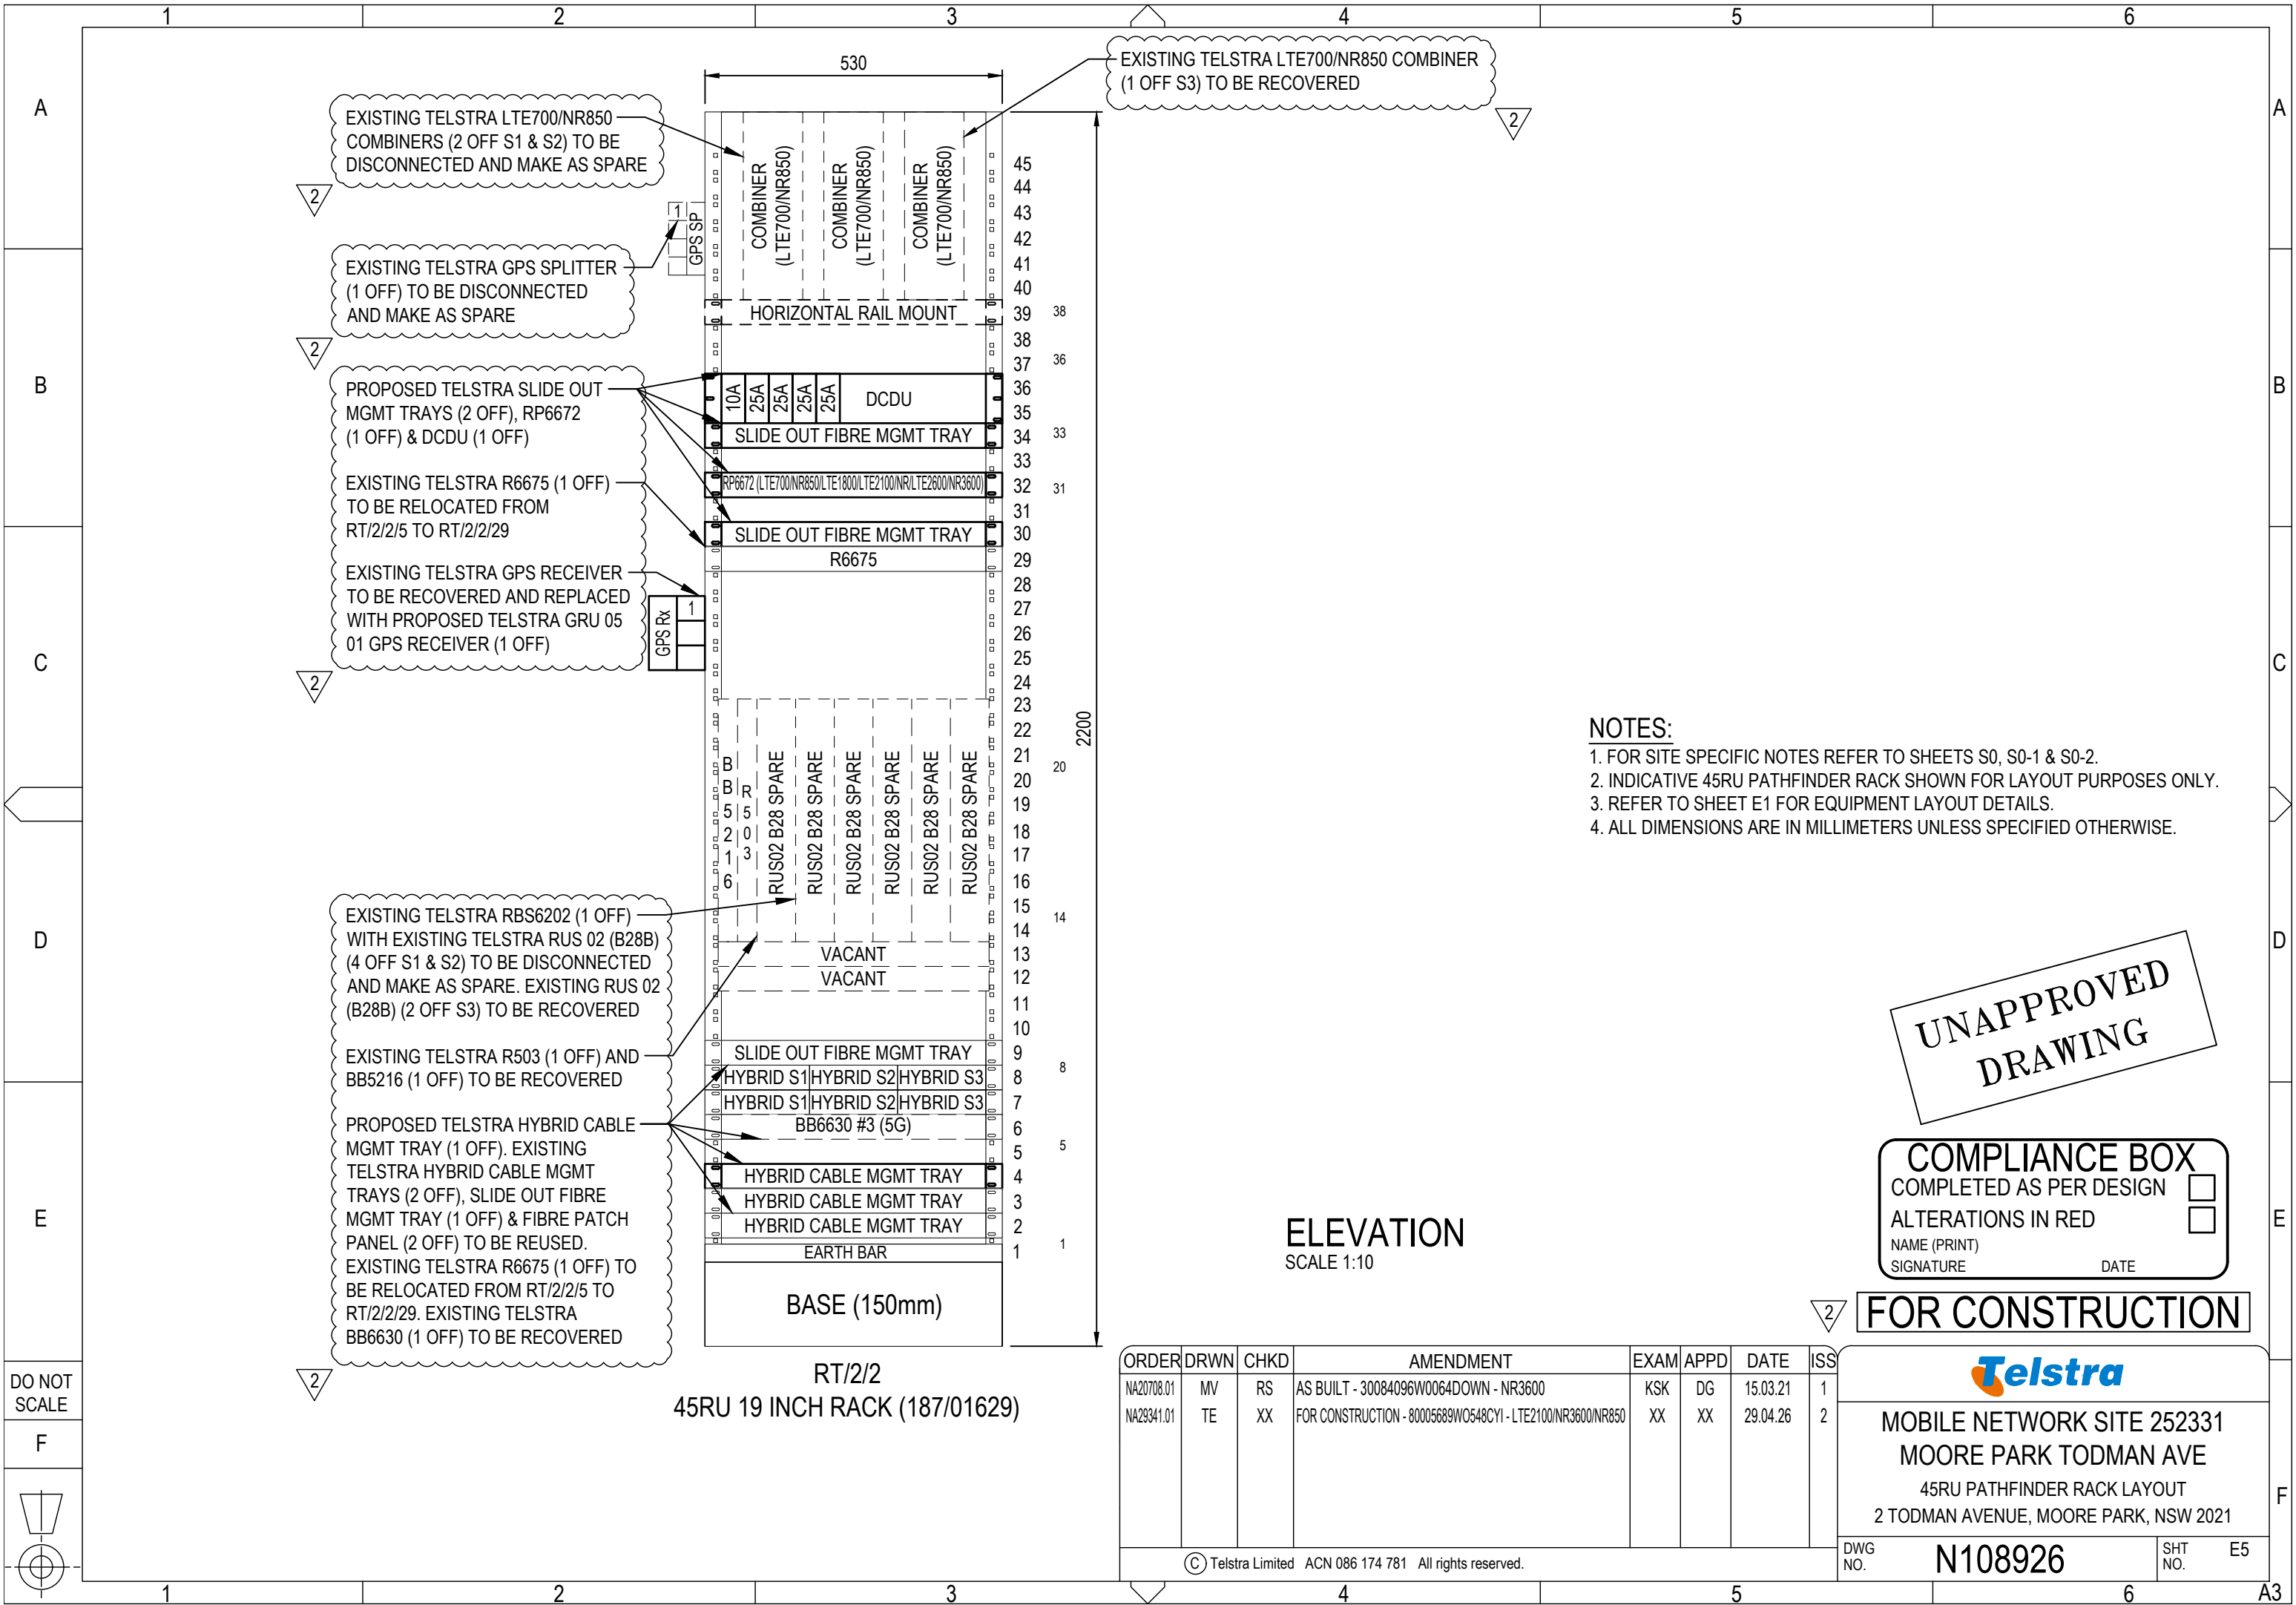

- NOTES:**
- 1. FOR SITE SPECIFIC NOTES REFER TO SHEETS S0, S0-1 & S0-2.
 - 2. INDICATIVE 45RU PATHFINDER RACK SHOWN FOR LAYOUT PURPOSES ONLY.
 - 3. REFER TO SHEET E1 FOR EQUIPMENT LAYOUT DETAILS.
 - 4. ALL DIMENSIONS ARE IN MILLIMETERS UNLESS SPECIFIED OTHERWISE.

UNAPPROVED
DRAWING

COMPLIANCE BOX

COMPLETED AS PER DESIGN

ALTERATIONS IN RED

NAME (PRINT)

SIGNATURE

DATE

FOR CONSTRUCTION

ORDER	DRWN	CHKD	AMENDMENT	EXAM	APPD	DATE	ISS
NA20708.01	MV	RS	AS BUILT - 30084096W0064DOWN - NR3600	KSK	DG	15.03.21	1
NA29341.01	TE	XX	FOR CONSTRUCTION - 80005689W0548CY1 - LTE2100/NR3600/NR850	XX	XX	29.04.26	2

© Telstra Limited ACN 086 174 781 All rights reserved.

DWG NO.


N108926

SHT NO.

E5



MOBILE NETWORK SITE 252331
MOORE PARK TODMAN AVE
45RU PATHFINDER RACK LAYOUT
2 TODMAN AVENUE, MOORE PARK, NSW 2021

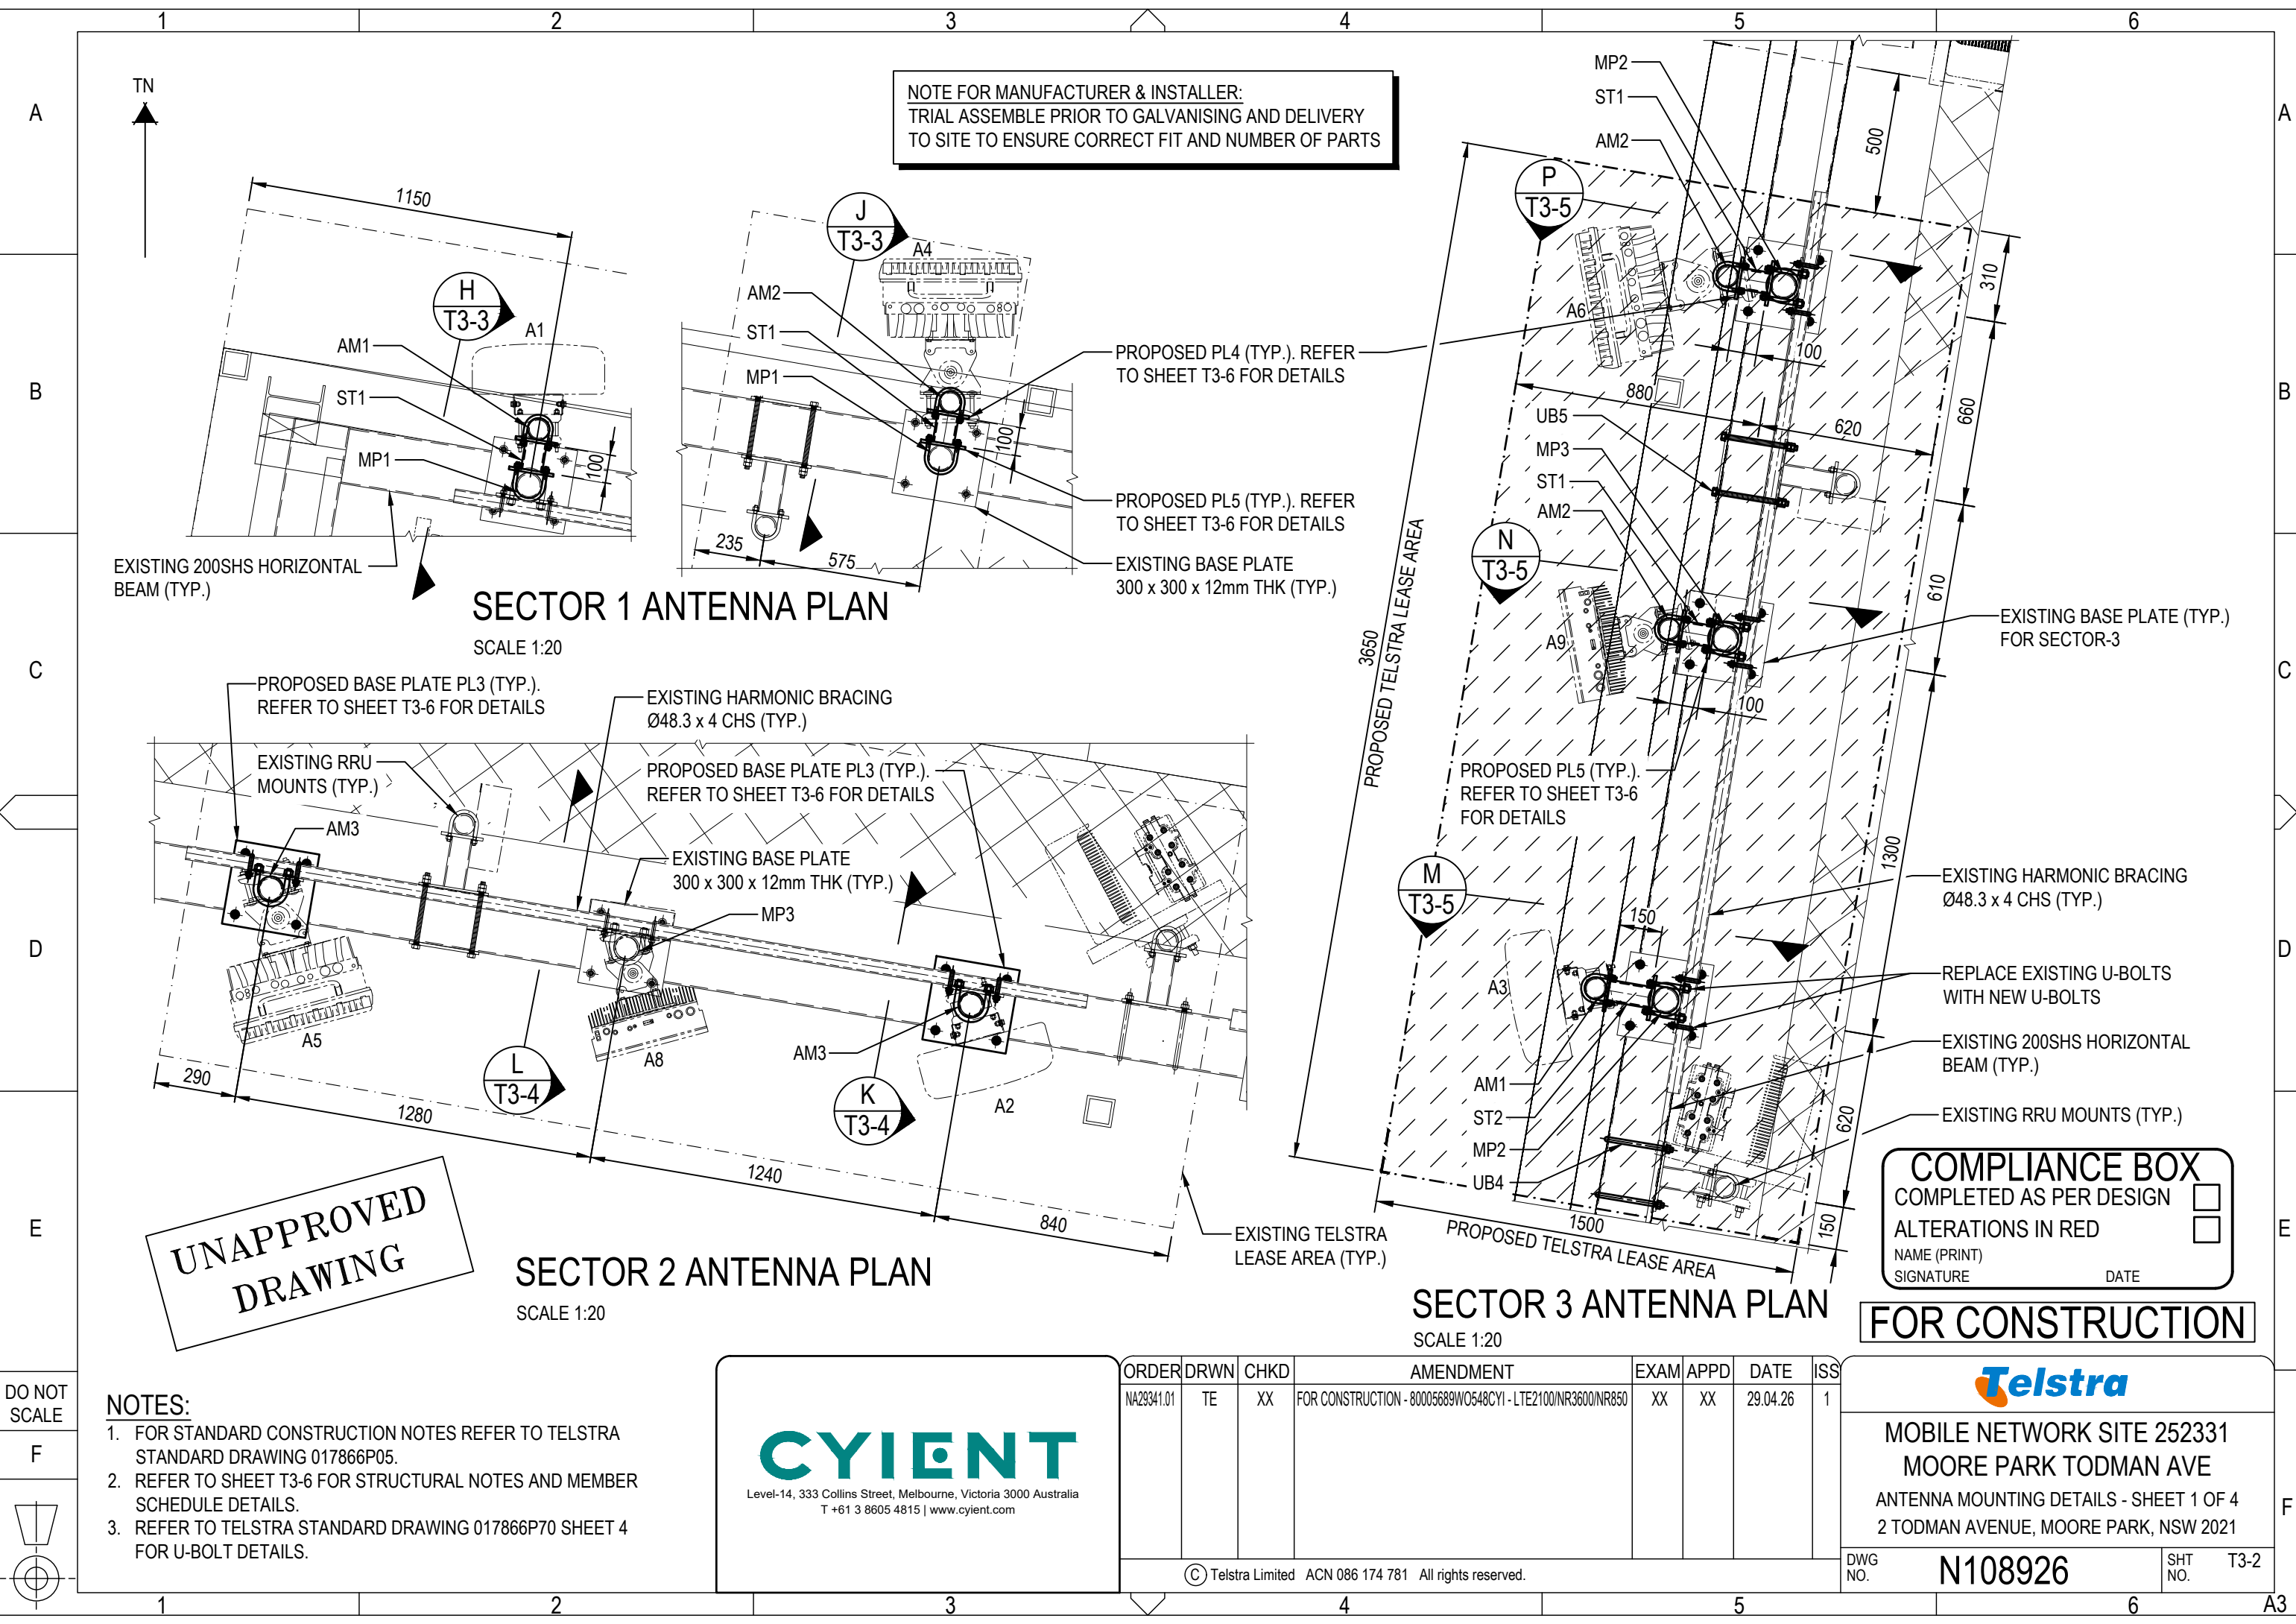

NOTE FOR MANUFACTURER & INSTALLER:
TRIAL ASSEMBLE PRIOR TO GALVANISING AND DELIVERY
TO SITE TO ENSURE CORRECT FIT AND NUMBER OF PARTS

SECTOR 1 ANTENNA PLAN

SCALE 1:20

SECTOR 2 ANTENNA PLAN

SCALE 1:20

SECTOR 3 ANTENNA PLAN

SCALE 1:20

COMPLIANCE BOX
COMPLETED AS PER DESIGN ☐
ALTERATIONS IN RED ☐
NAME (PRINT) _____
SIGNATURE _____ DATE _____

FOR CONSTRUCTION

NOTES:

1. FOR STANDARD CONSTRUCTION NOTES REFER TO TELSTRA STANDARD DRAWING 017866P05.
2. REFER TO SHEET T3-6 FOR STRUCTURAL NOTES AND MEMBER SCHEDULE DETAILS.
3. REFER TO TELSTRA STANDARD DRAWING 017866P70 SHEET 4 FOR U-BOLT DETAILS.

CYIENT

Level-14, 333 Collins Street, Melbourne, Victoria 3000 Australia
T +61 3 8605 4815 | www.cyient.com

ORDER	DRWN	CHKD	AMENDMENT	EXAM	APPD	DATE	ISS
NA29341.01	TE	XX	FOR CONSTRUCTION - 80005689W0548CY1 - LTE2100/NR3600/NR850	XX	XX	29.04.26	1

© Telstra Limited ACN 086 174 781 All rights reserved.




MOBILE NETWORK SITE 252331
MOORE PARK TODMAN AVE
ANTENNA MOUNTING DETAILS - SHEET 1 OF 4
2 TODMAN AVENUE, MOORE PARK, NSW 2021


DWG NO.


N108926

SHT NO.

T3-2

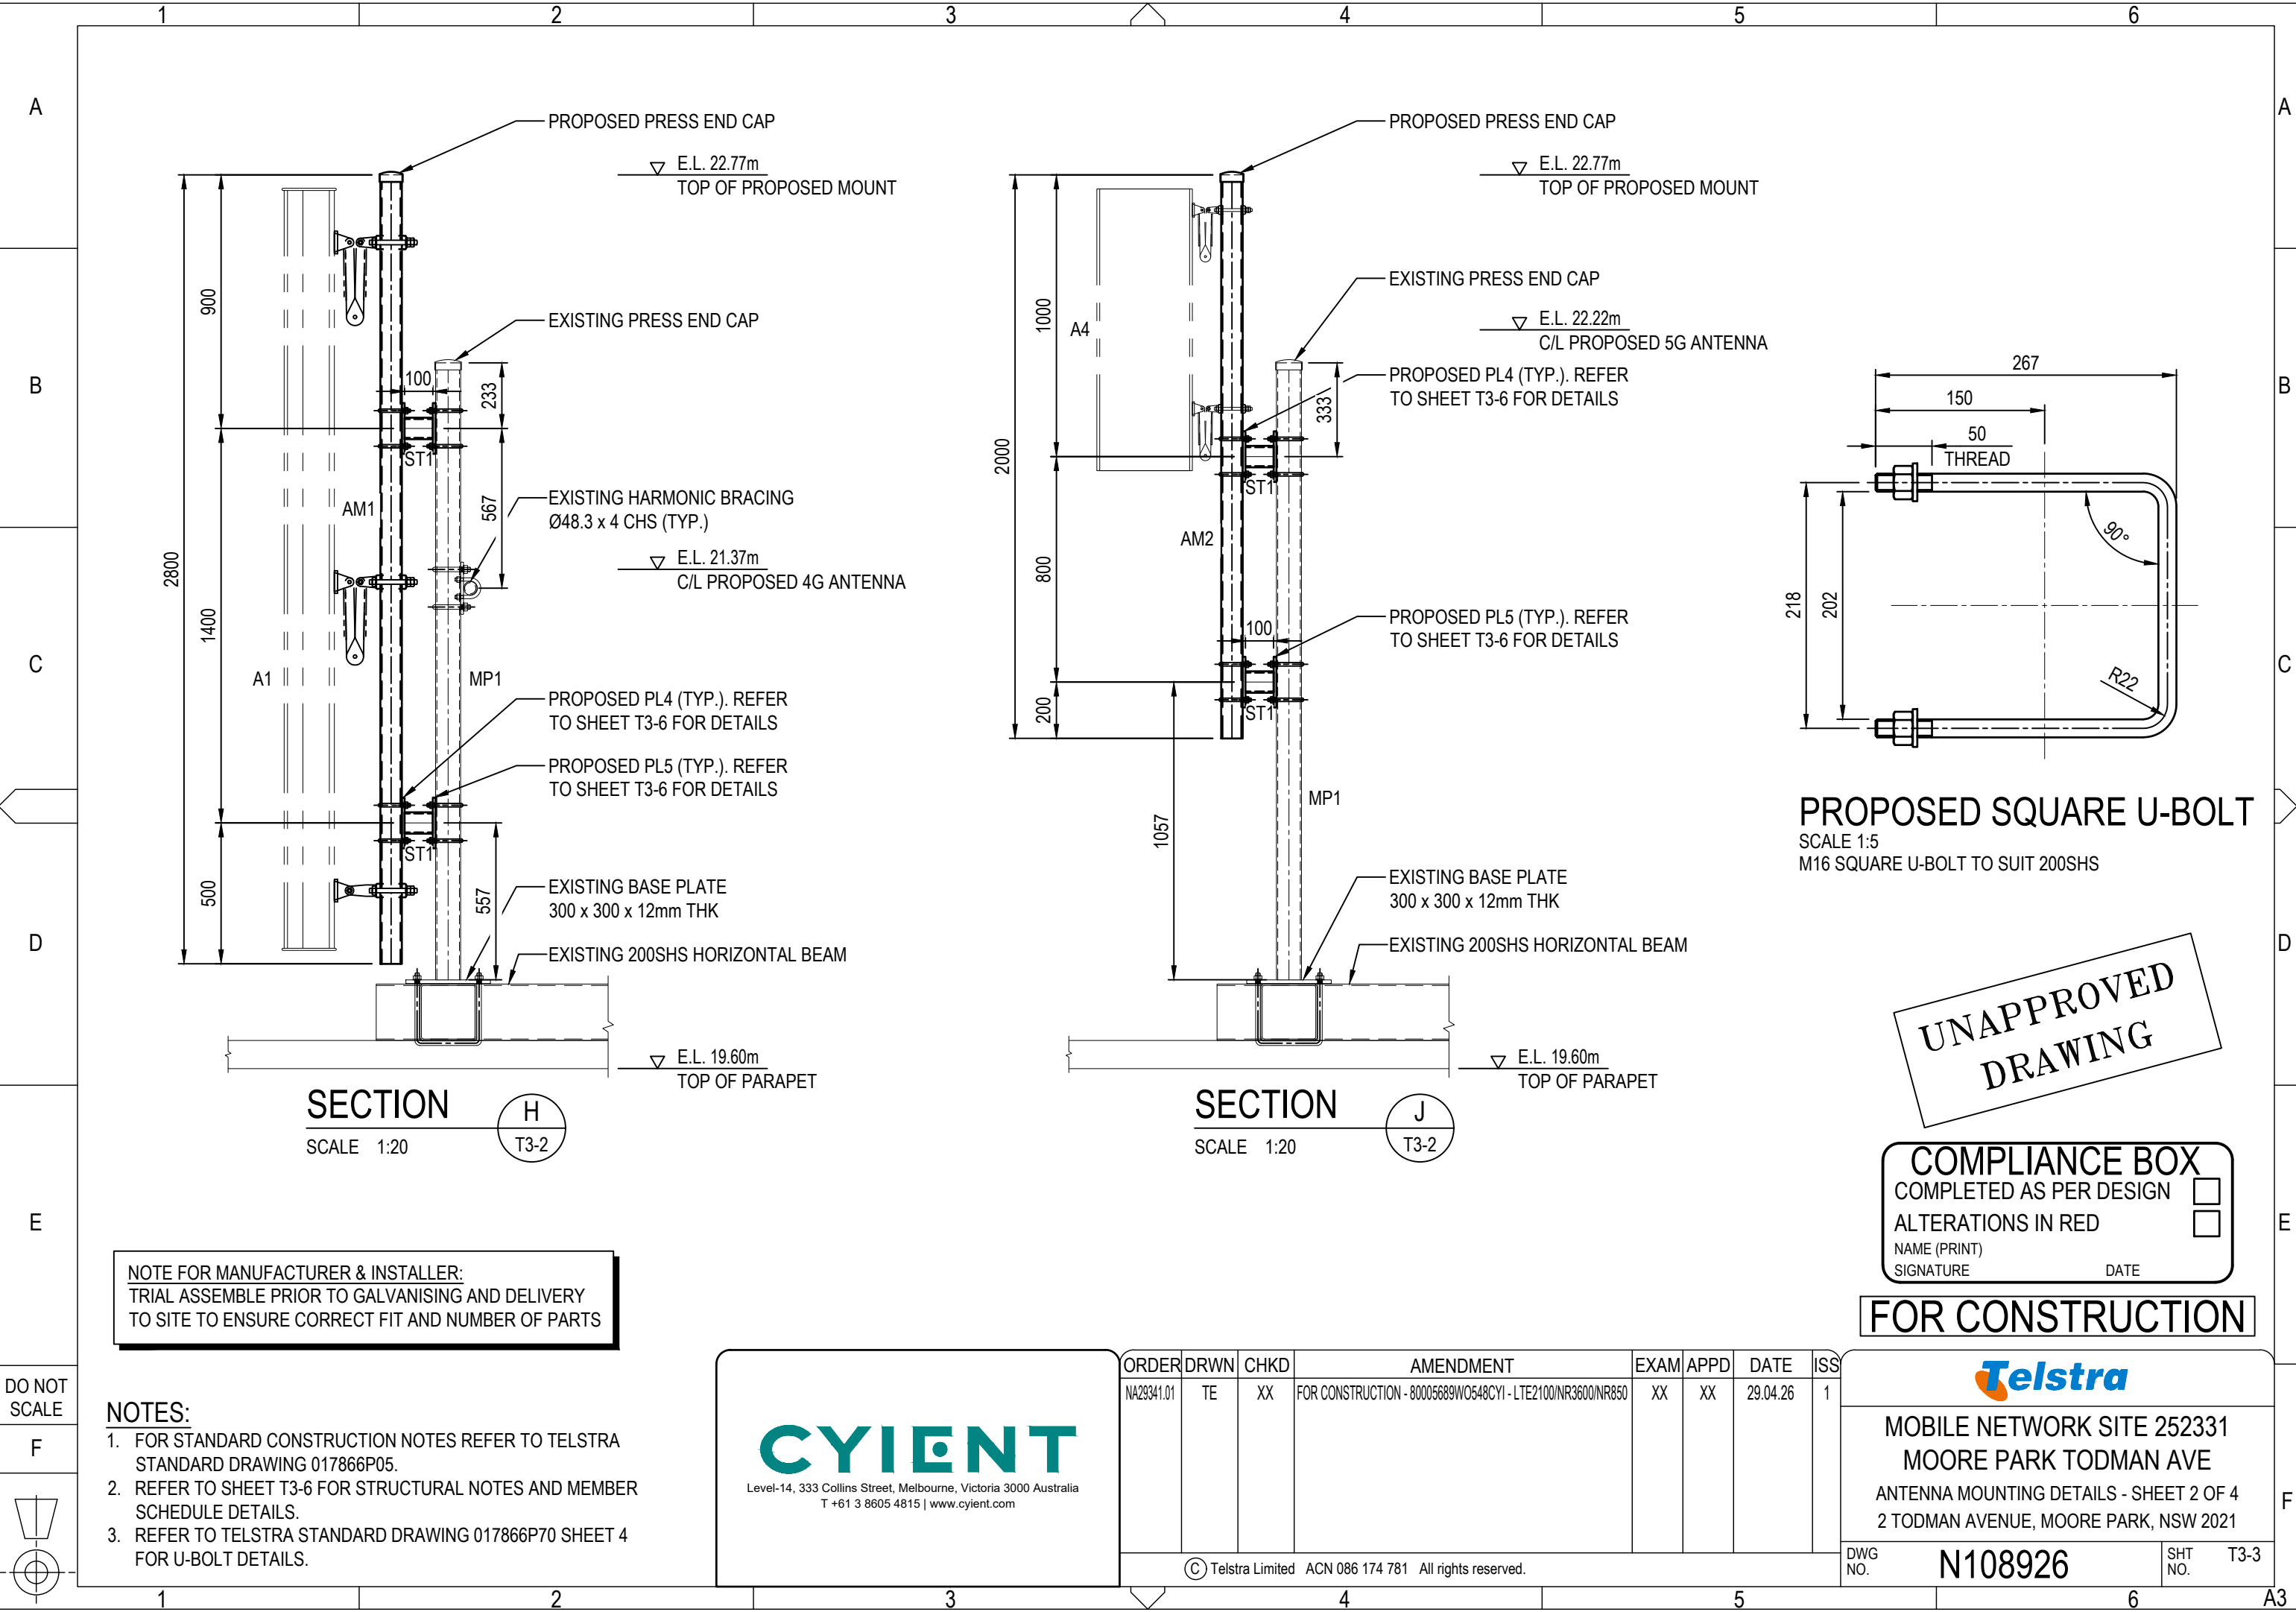

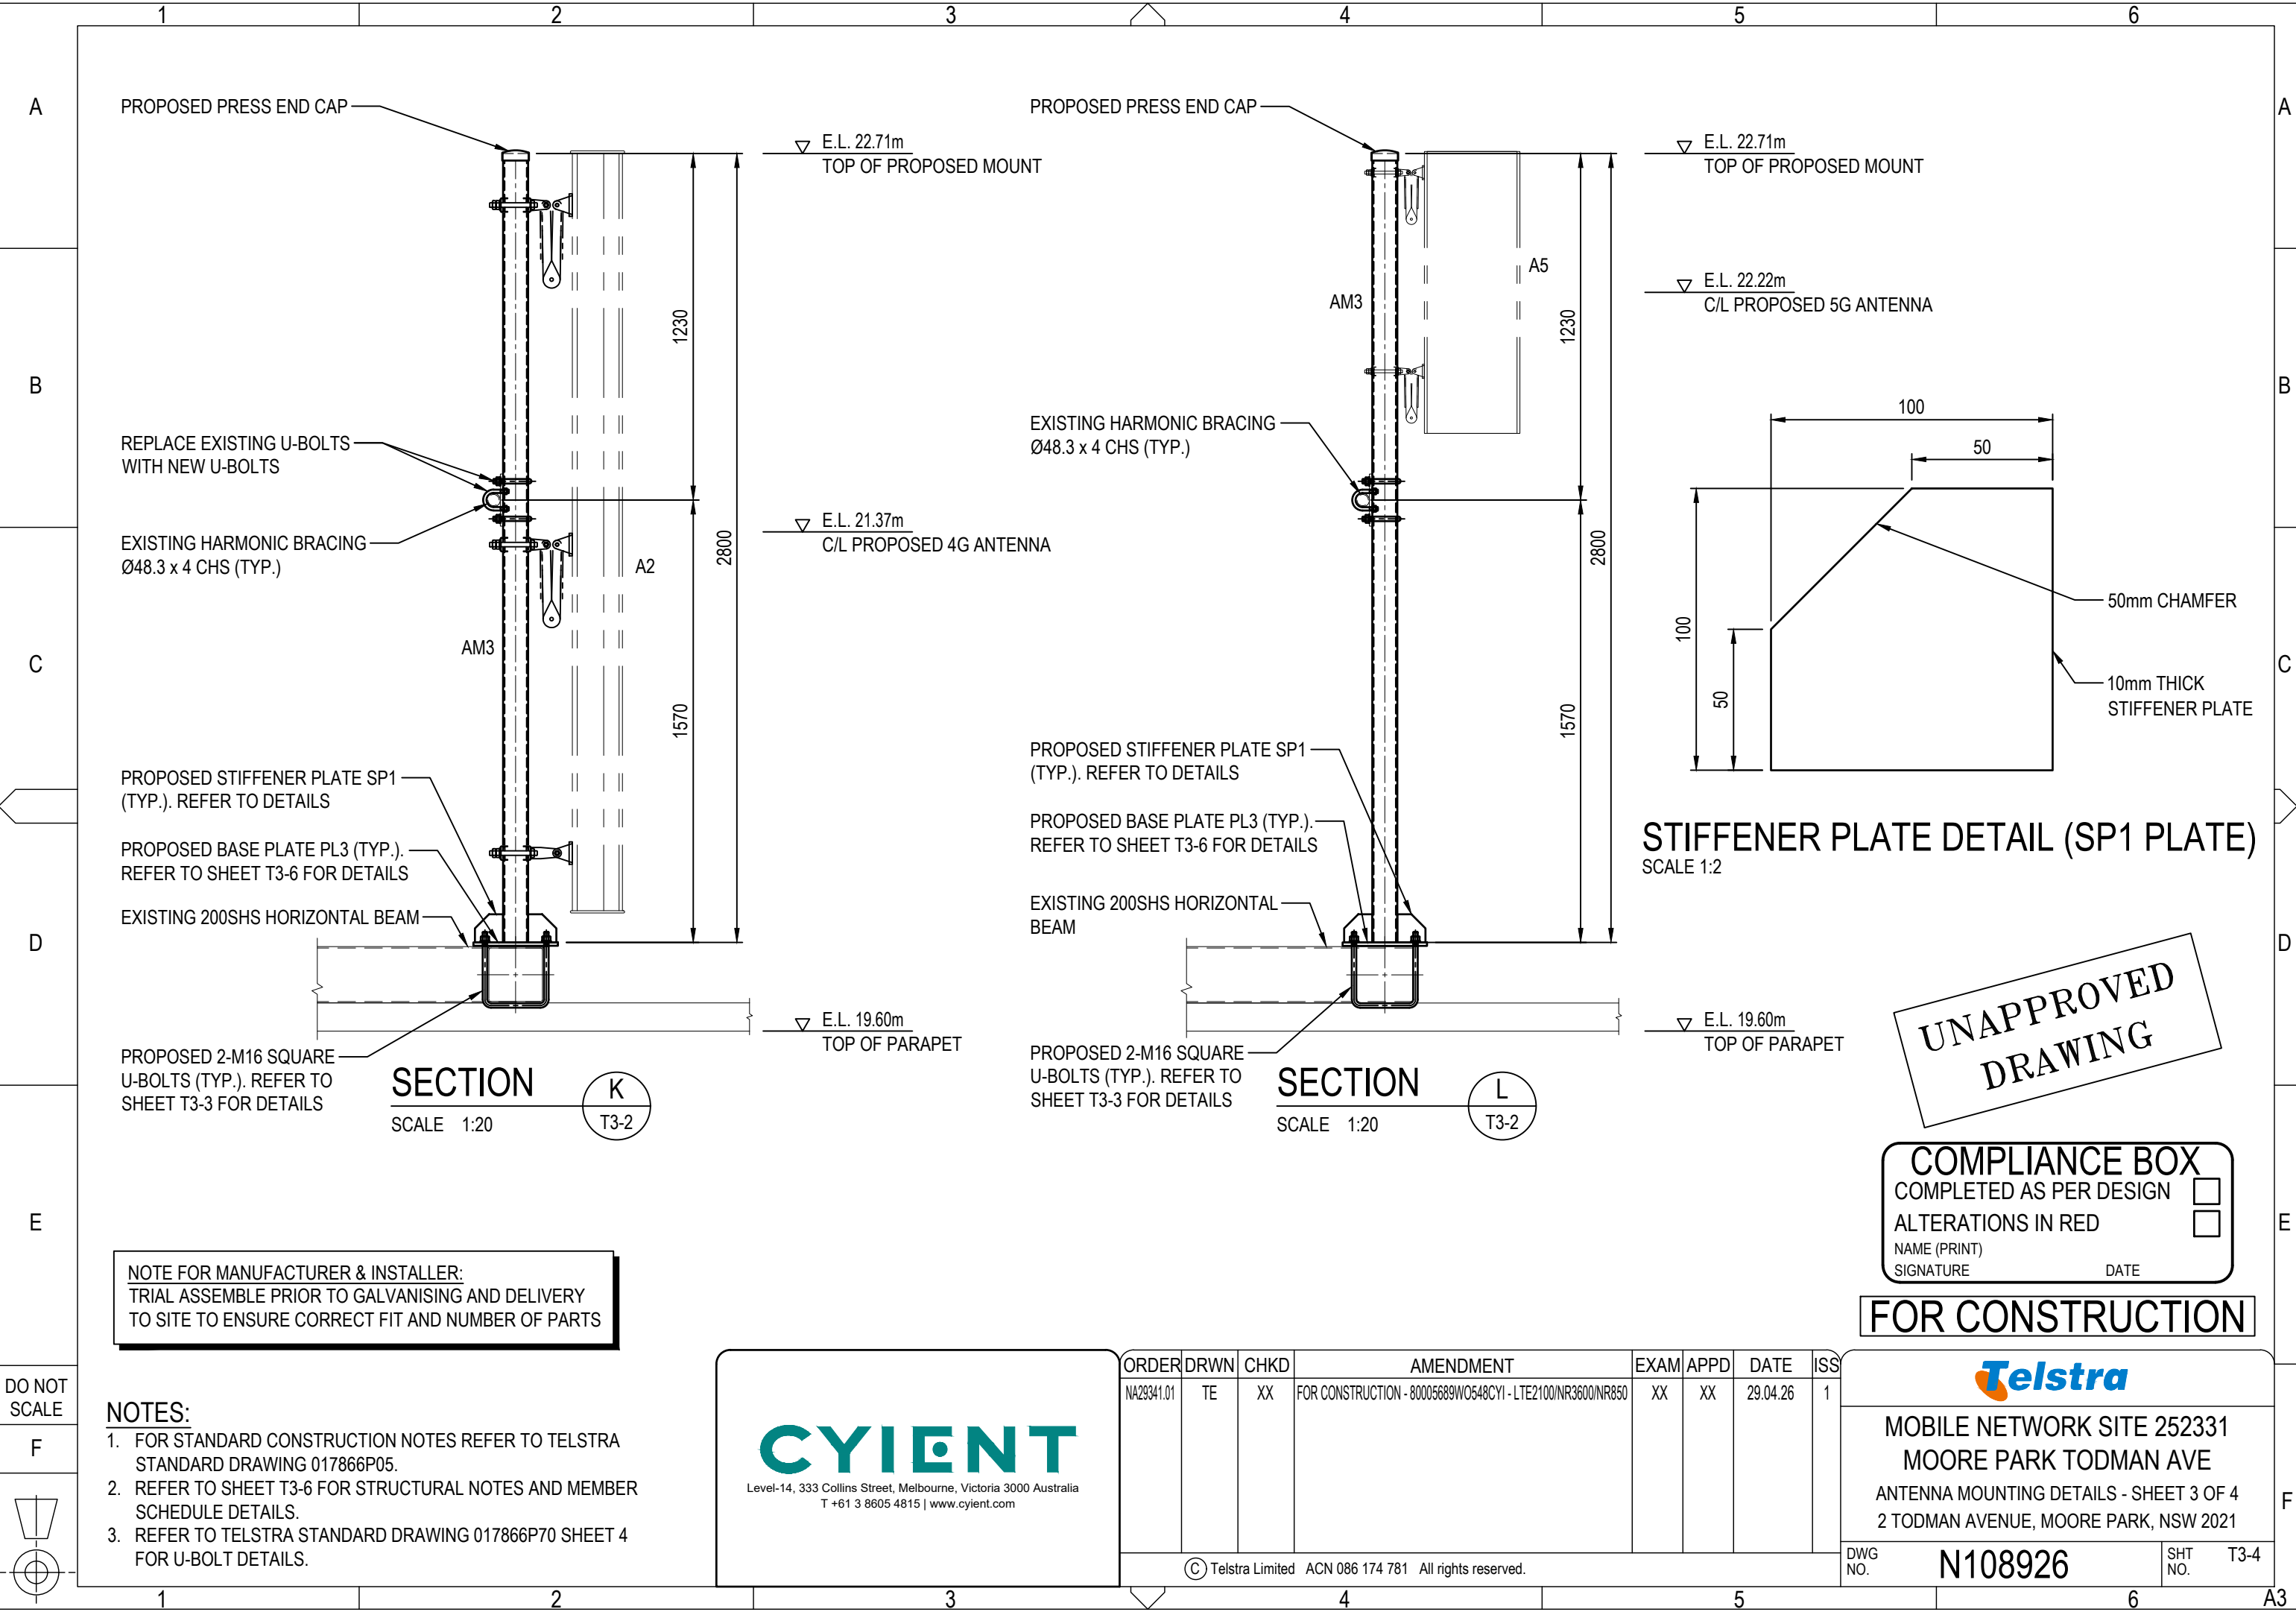

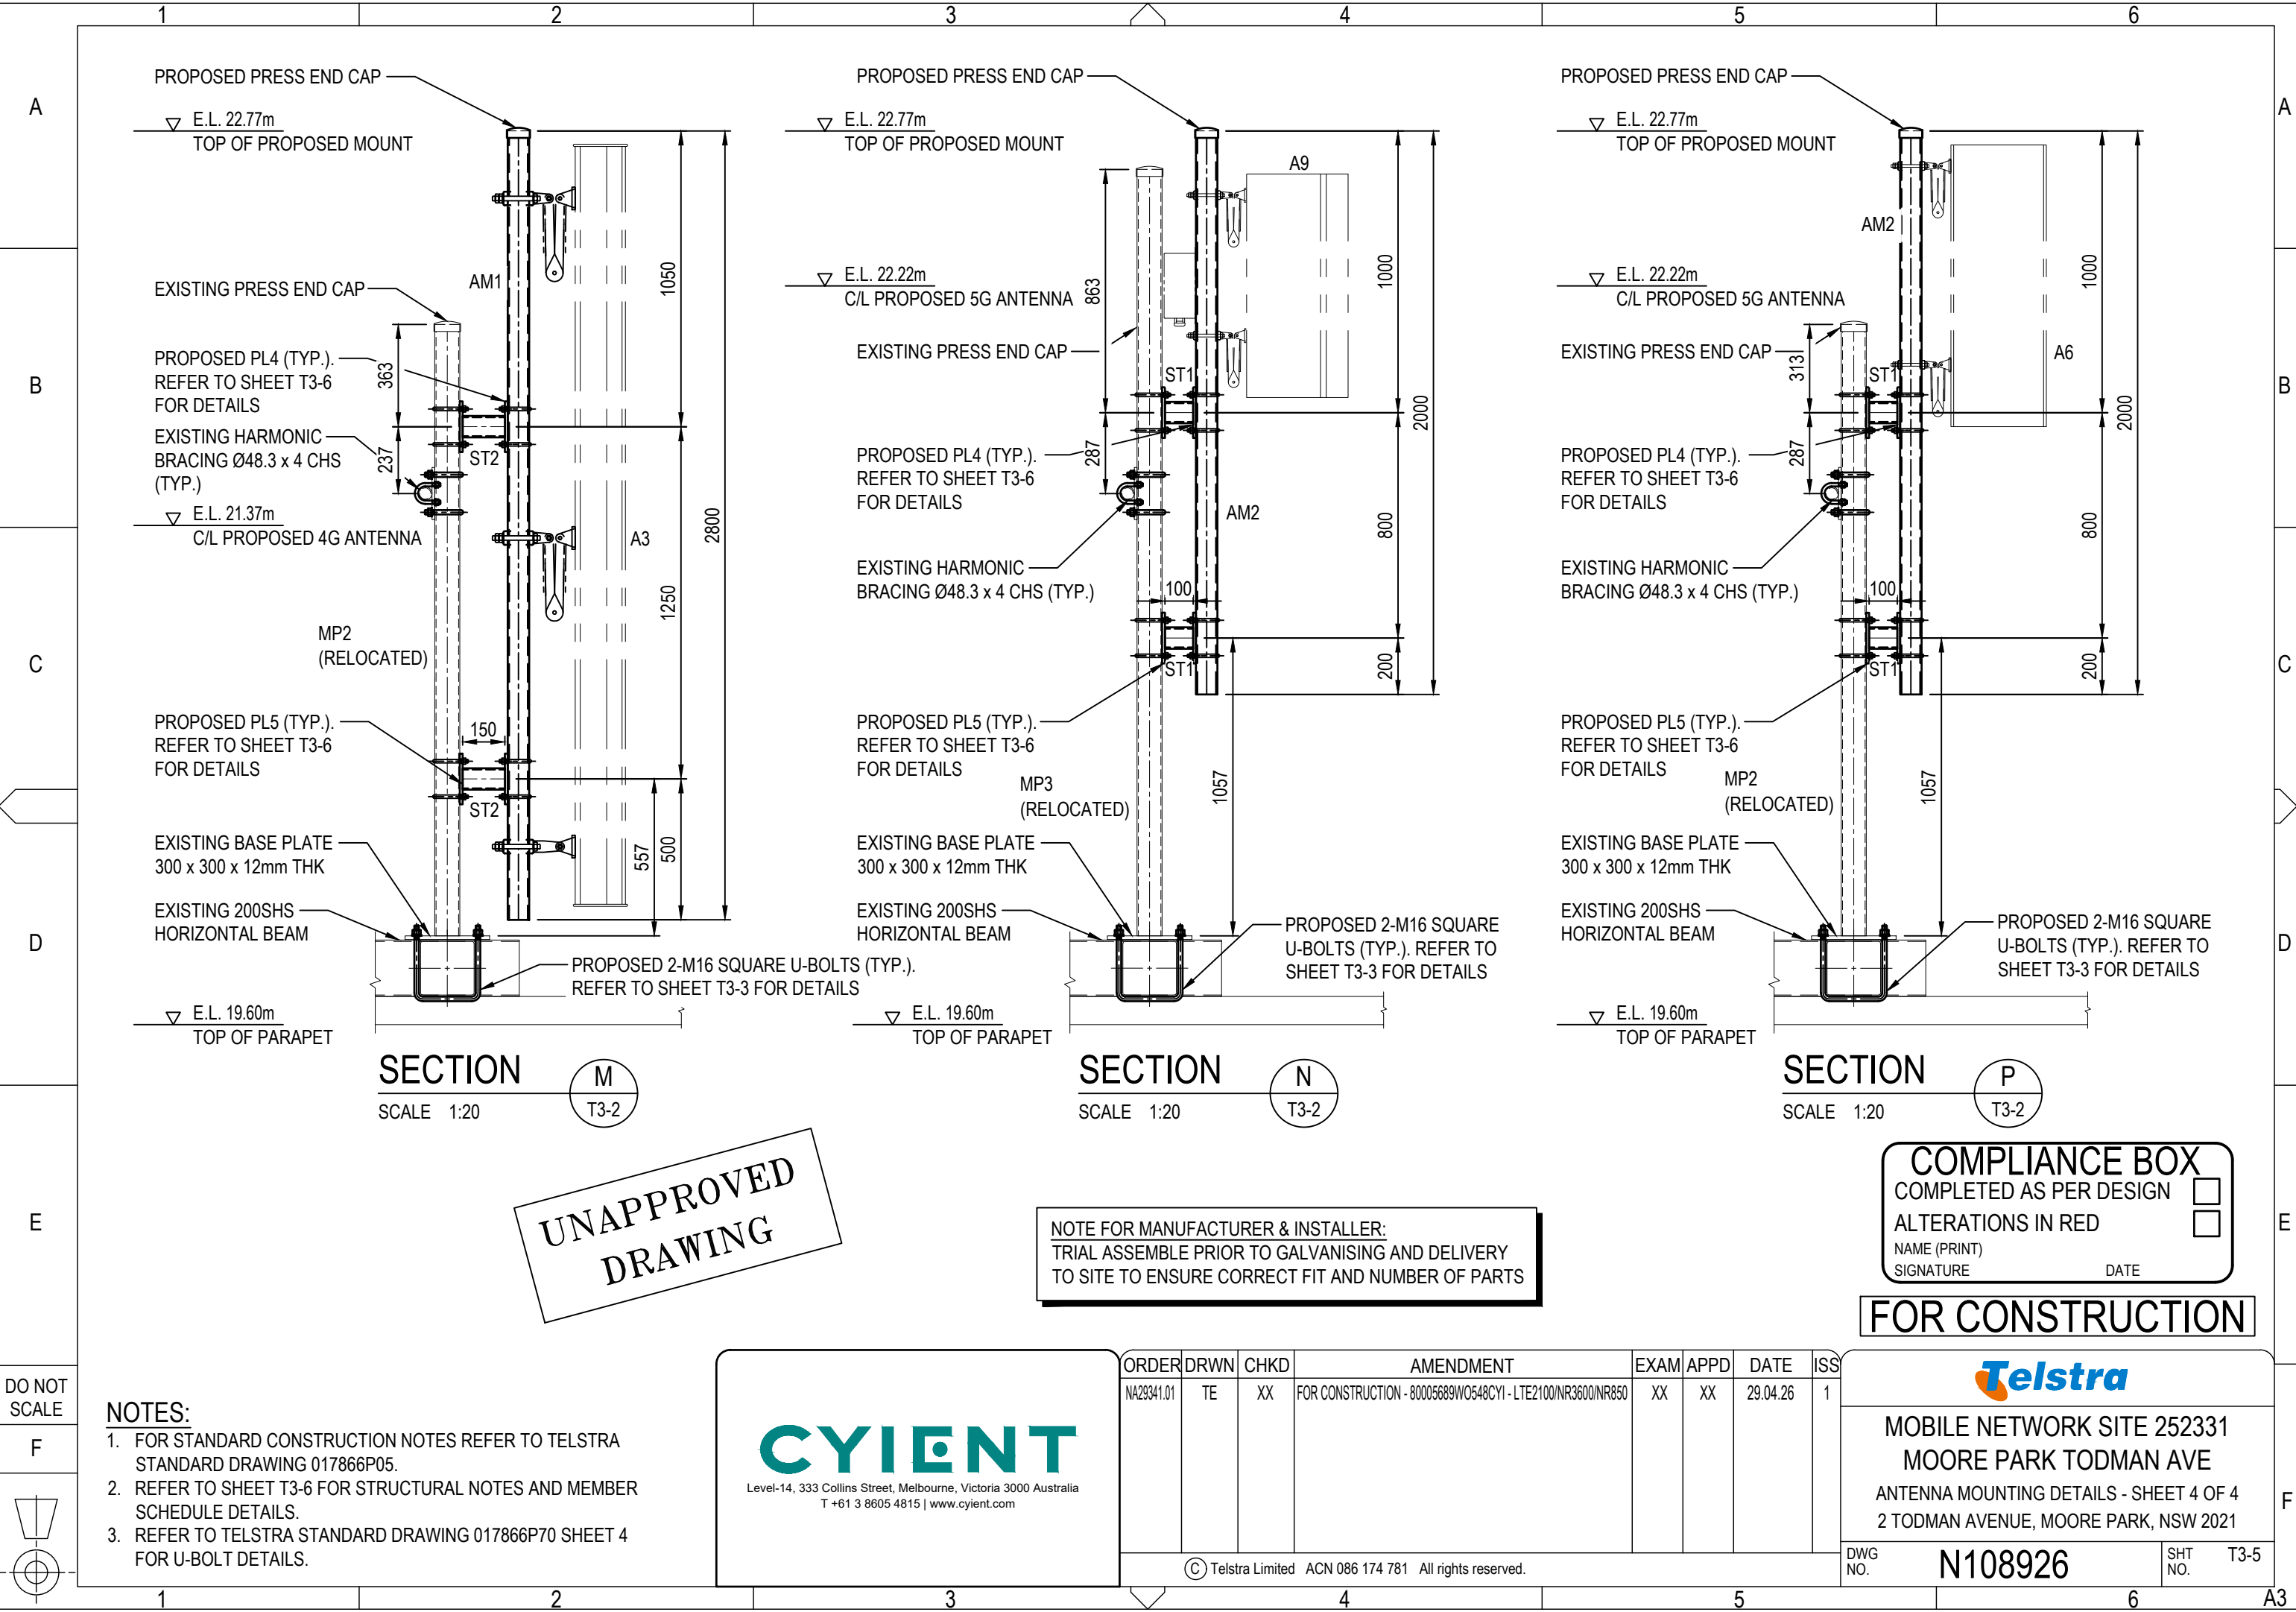

UNAPPROVED
DRAWING

NOTE FOR MANUFACTURER & INSTALLER:
TRIAL ASSEMBLE PRIOR TO GALVANISING AND DELIVERY
TO SITE TO ENSURE CORRECT FIT AND NUMBER OF PARTS

COMPLIANCE BOX	
COMPLETED AS PER DESIGN	☐
ALTERATIONS IN RED	☐
NAME (PRINT)	
SIGNATURE	DATE

FOR CONSTRUCTION

NOTES:

- FOR STANDARD CONSTRUCTION NOTES REFER TO TELSTRA STANDARD DRAWING 017866P05.
- REFER TO SHEET T3-6 FOR STRUCTURAL NOTES AND MEMBER SCHEDULE DETAILS.
- REFER TO TELSTRA STANDARD DRAWING 017866P70 SHEET 4 FOR U-BOLT DETAILS.

CYIENT

Level-14, 333 Collins Street, Melbourne, Victoria 3000 Australia
T +61 3 8605 4815 | www.cyient.com

ORDER	DRWN	CHKD	AMENDMENT	EXAM	APPD	DATE	ISS
NA29341.01	TE	XX	FOR CONSTRUCTION - 80005689W0548CY1 - LTE2100/NR3600/NR850	XX	XX	29.04.26	1

© Telstra Limited ACN 086 174 781 All rights reserved.




MOBILE NETWORK SITE 252331
MOORE PARK TODMAN AVE
ANTENNA MOUNTING DETAILS - SHEET 4 OF 4
2 TODMAN AVENUE, MOORE PARK, NSW 2021

DWG
NO.

N108926


SHT
NO.

T3-5

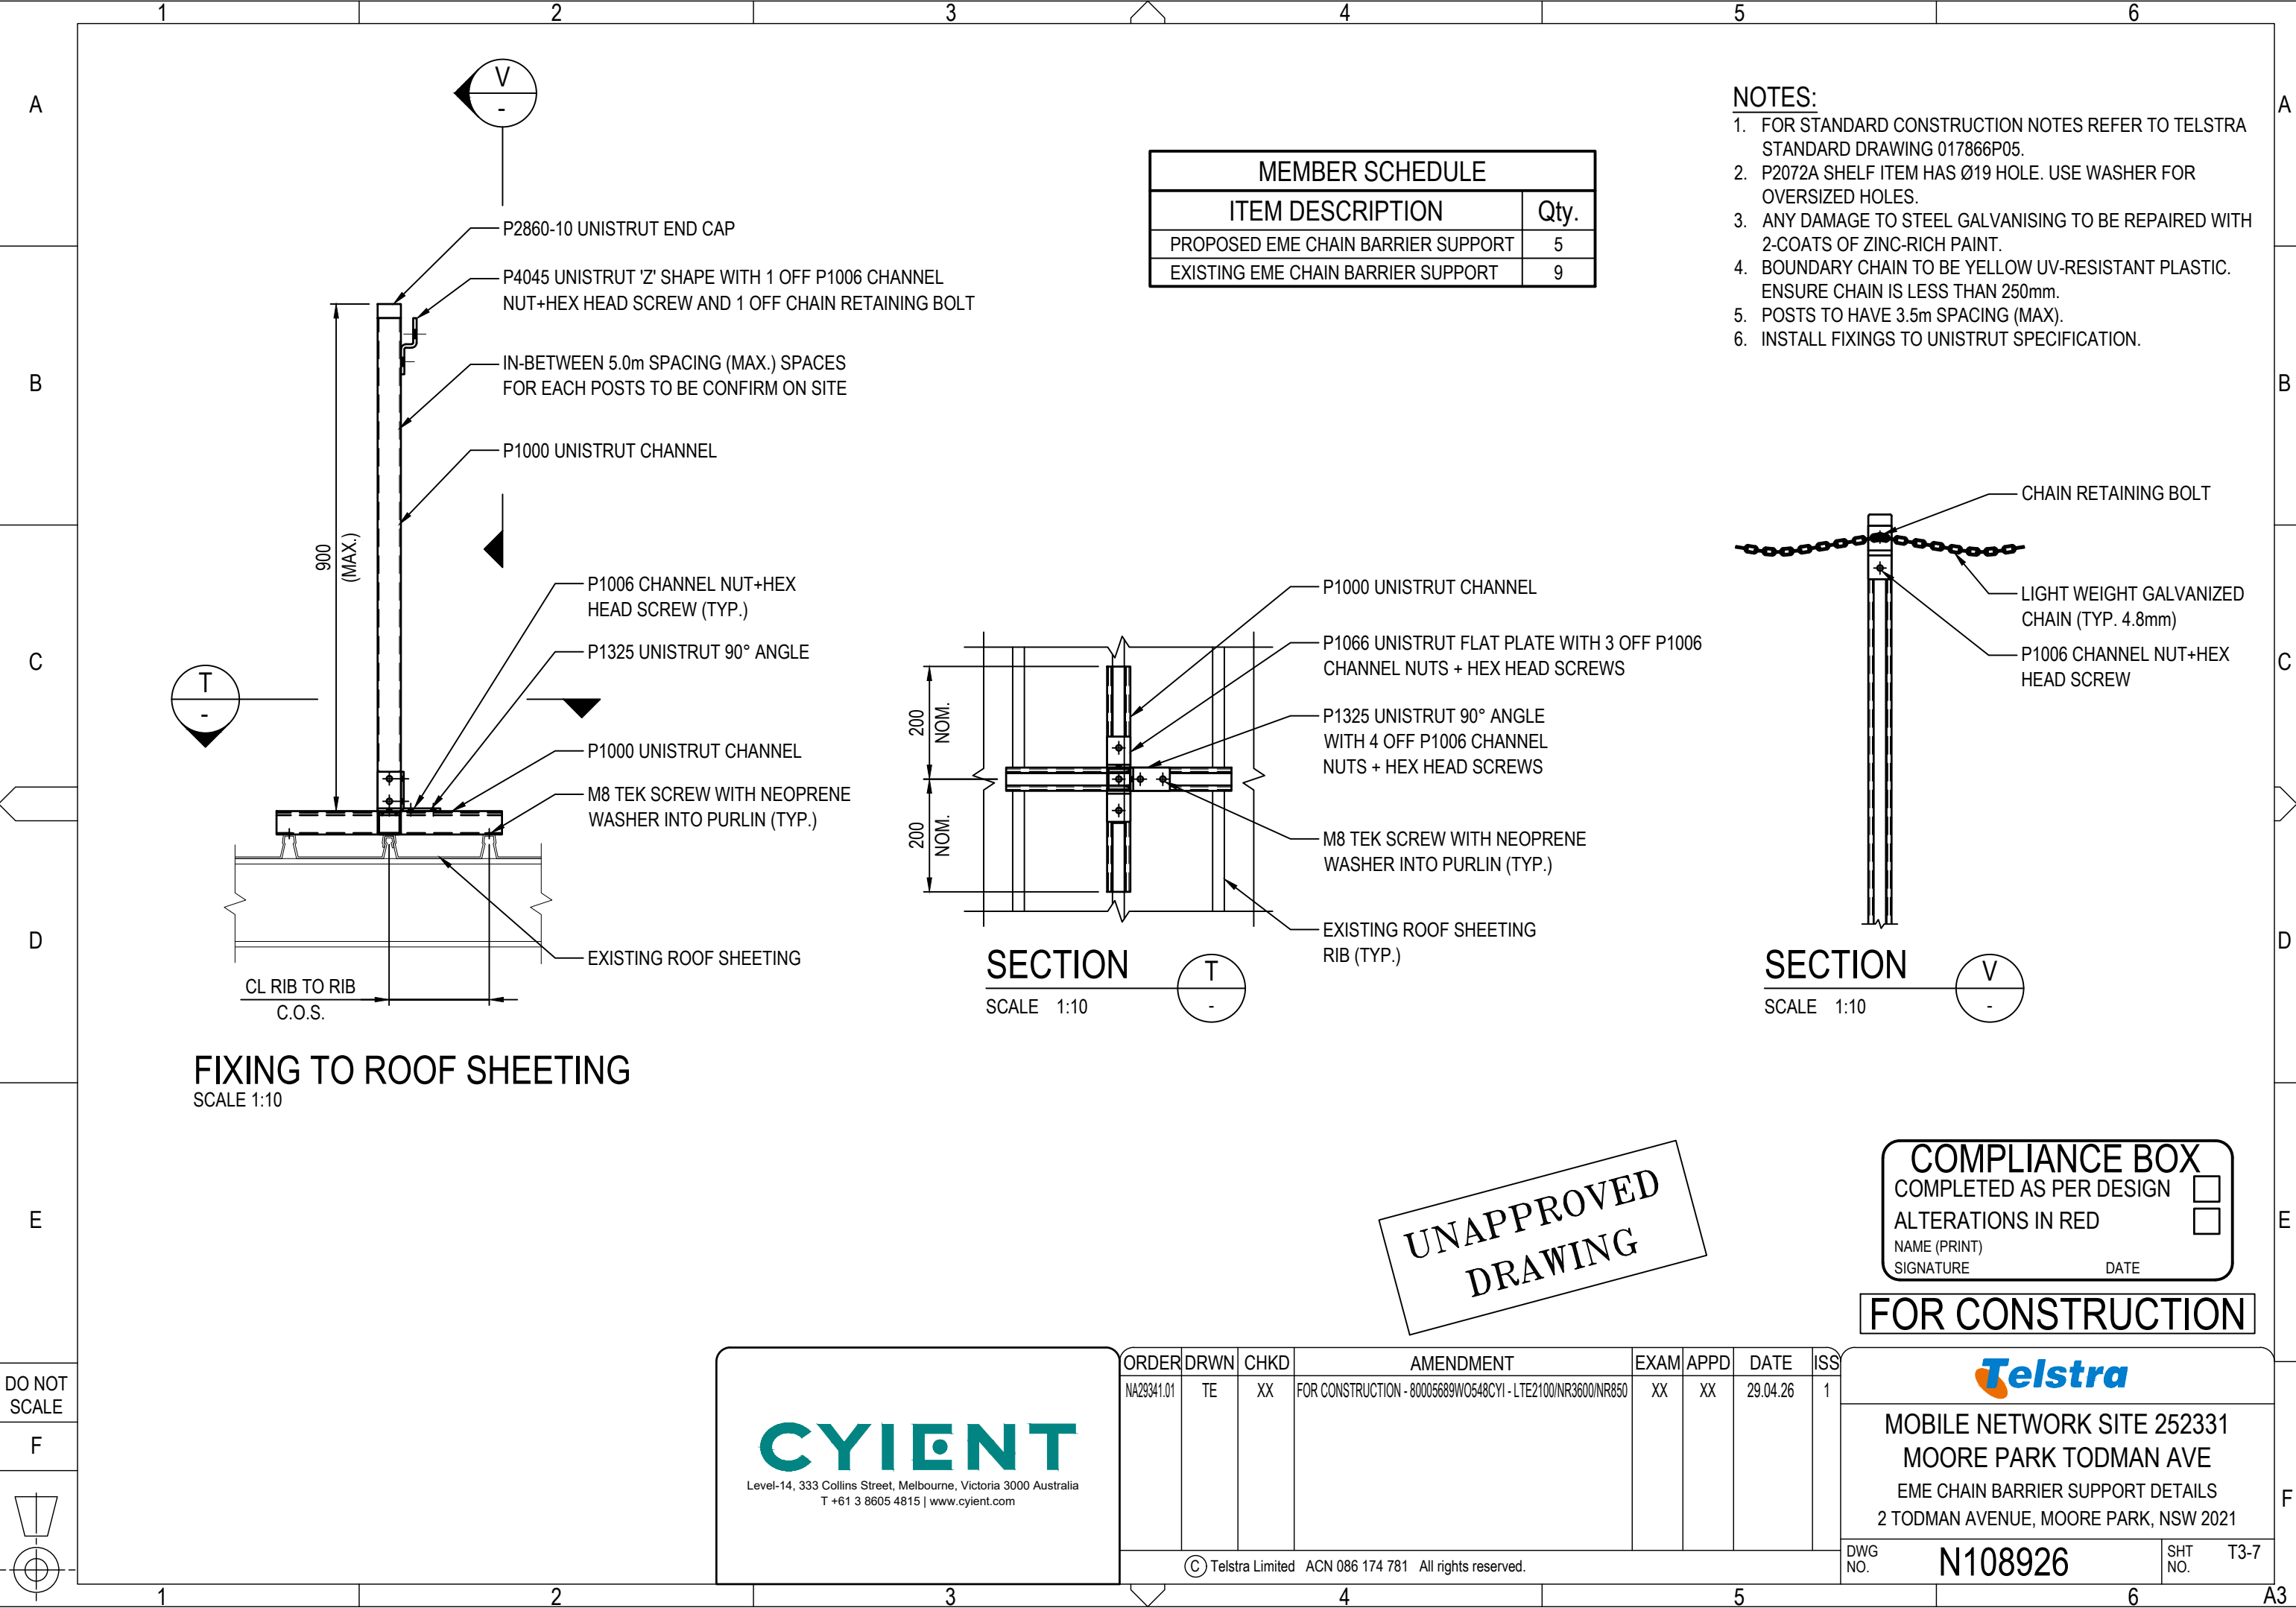

MEMBER SCHEDULE	
ITEM DESCRIPTION	Qty.
PROPOSED EME CHAIN BARRIER SUPPORT	5
EXISTING EME CHAIN BARRIER SUPPORT	9

- NOTES:
- FOR STANDARD CONSTRUCTION NOTES REFER TO TELSTRA STANDARD DRAWING 017866P05.
 - P2072A SHELF ITEM HAS Ø19 HOLE. USE WASHER FOR OVERSIZED HOLES.
 - ANY DAMAGE TO STEEL GALVANISING TO BE REPAIRED WITH 2-COATS OF ZINC-RICH PAINT.
 - BOUNDARY CHAIN TO BE YELLOW UV-RESISTANT PLASTIC. ENSURE CHAIN IS LESS THAN 250mm.
 - POSTS TO HAVE 3.5m SPACING (MAX).
 - INSTALL FIXINGS TO UNISTRUT SPECIFICATION.

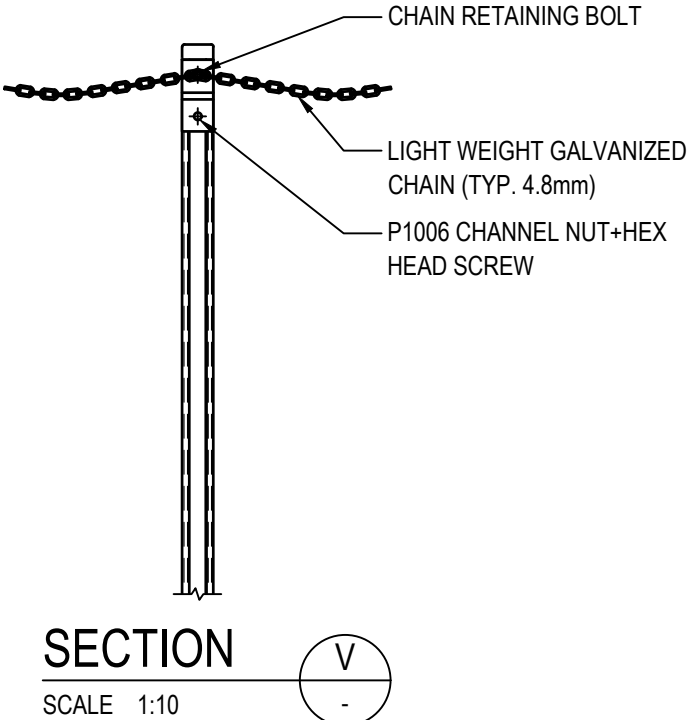

UNAPPROVED
DRAWING

COMPLIANCE BOX	
COMPLETED AS PER DESIGN	☐
ALTERATIONS IN RED	☐
NAME (PRINT)	
SIGNATURE	DATE

FOR CONSTRUCTION

Level-14, 333 Collins Street, Melbourne, Victoria 3000 Australia
T +61 3 8605 4815 | www.cyient.com

ORDER	DRWN	CHKD	AMENDMENT	EXAM	APPD	DATE	ISS
NA29341.01	TE	XX	FOR CONSTRUCTION - 80005689WO548CY1 - LTE2100/NR3600/NR850	XX	XX	29.04.26	1

© Telstra Limited ACN 086 174 781 All rights reserved.

MOBILE NETWORK SITE 252331
MOORE PARK TODMAN AVE
EME CHAIN BARRIER SUPPORT DETAILS
2 TODMAN AVENUE, MOORE PARK, NSW 2021

DWG NO.	N108926	SHT NO.	T3-7
---------	---------	---------	------