


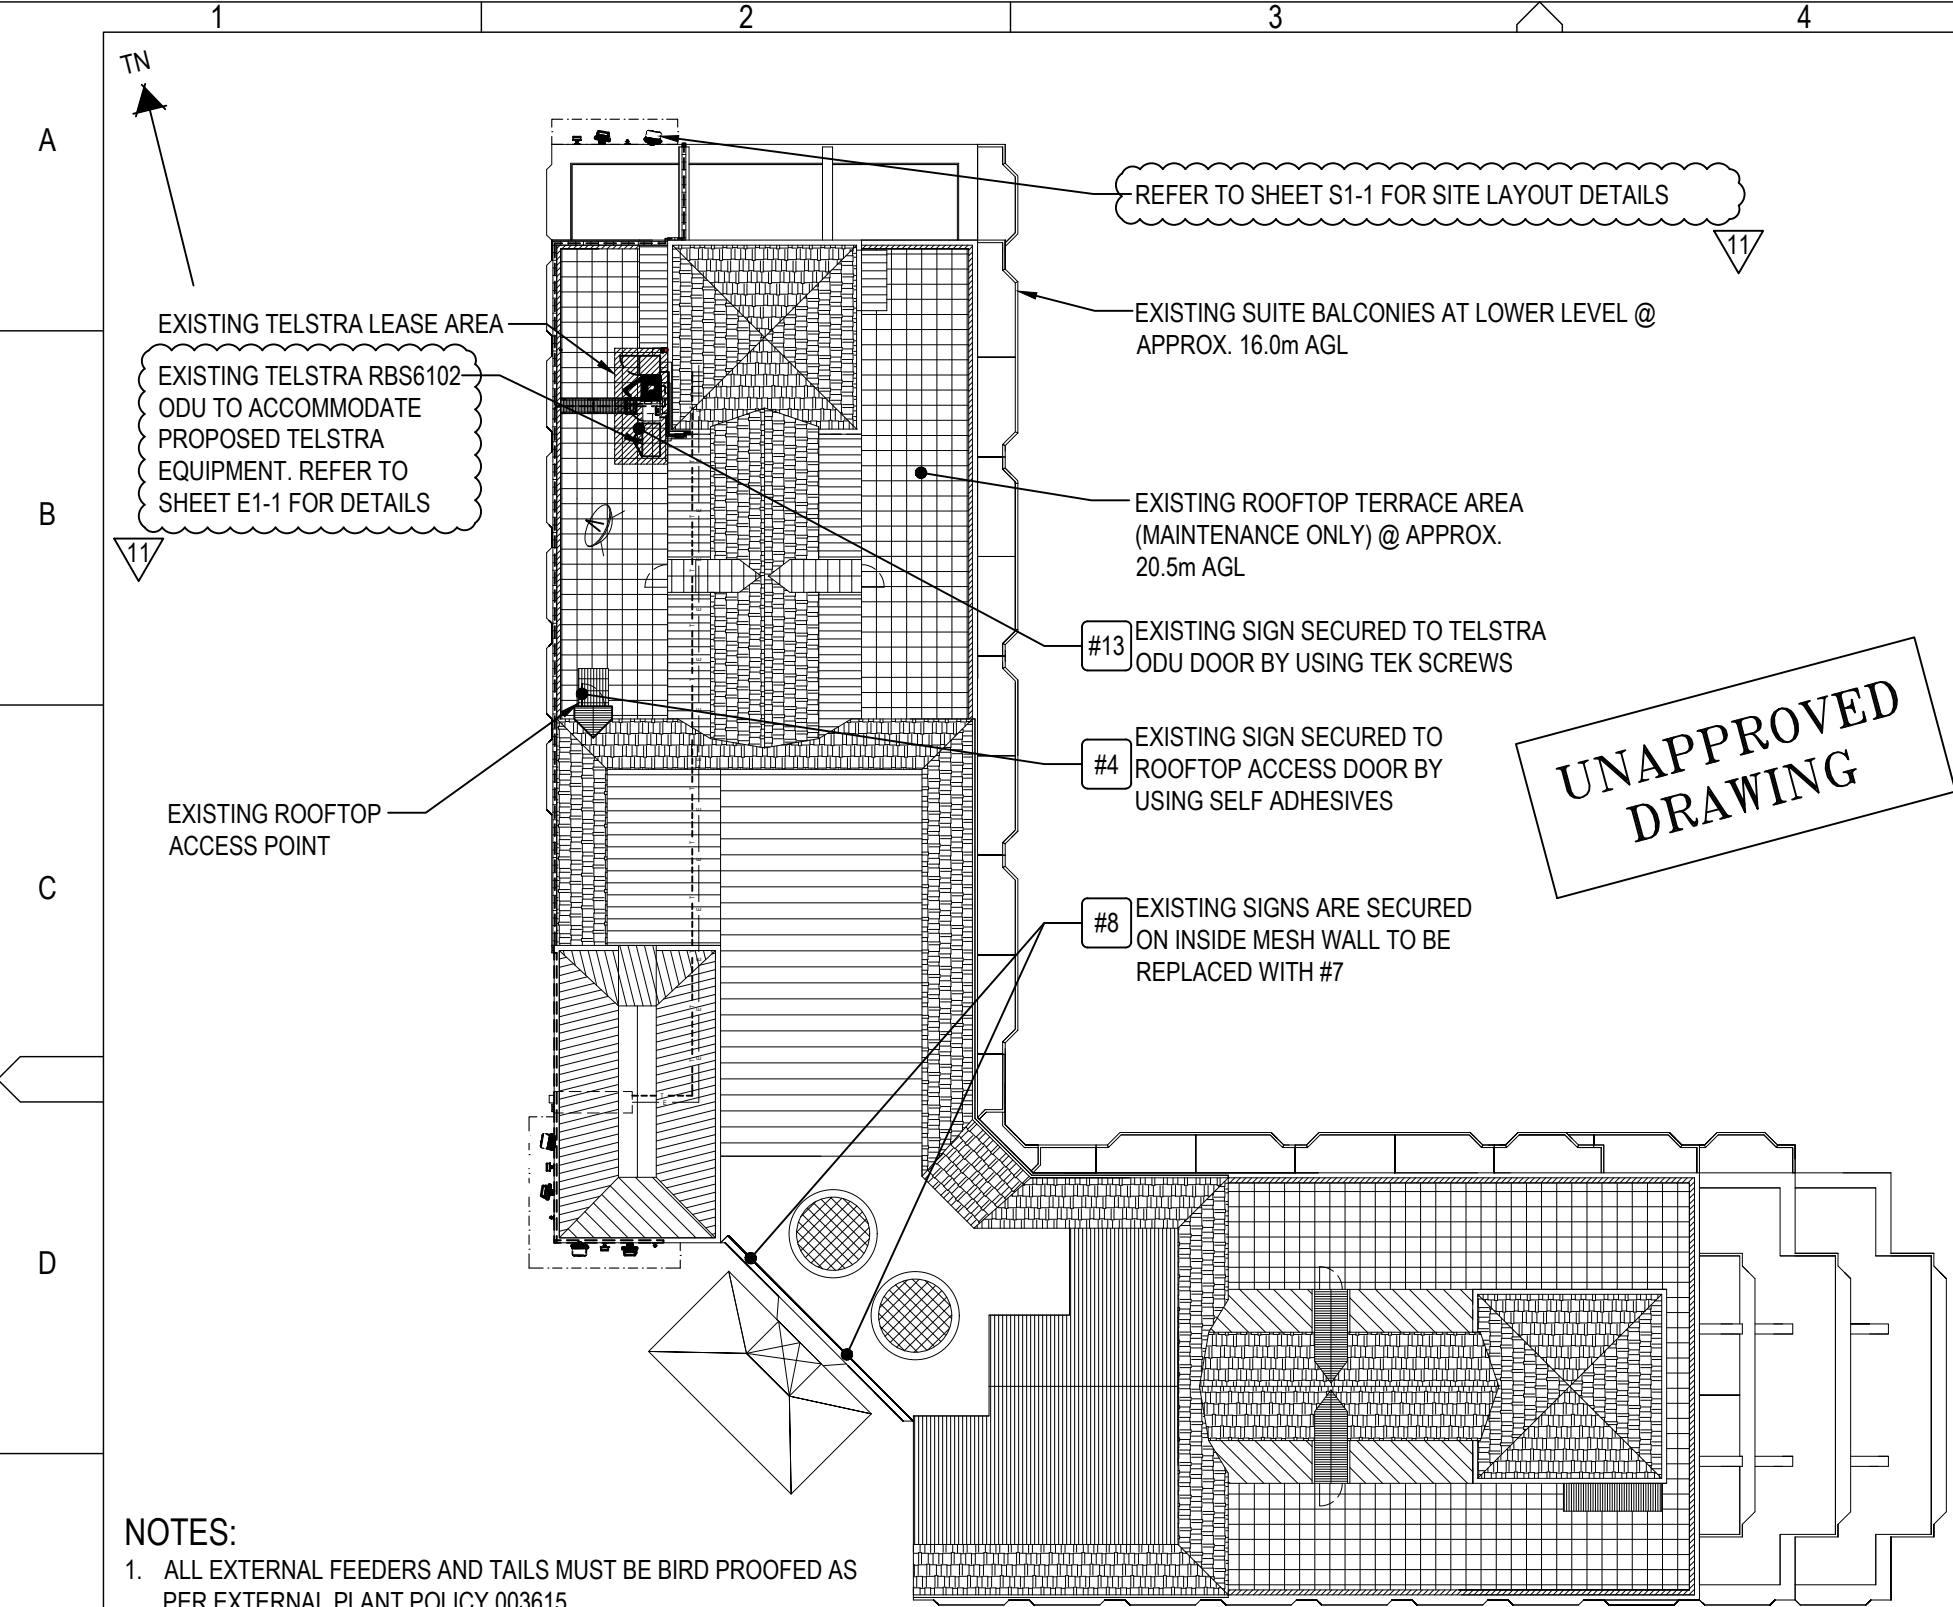

- NOTES:
1. ALL EXTERNAL FEEDERS AND TAILS MUST BE BIRD PROOFED AS PER EXTERNAL PLANT POLICY 003615.
 2. FOR SITE SPECIFIC NOTES REFER TO SHEETS S0, S0-1 & S0-2.
 3. FOR EME SIGNS NOTED THUS [X] REFER TO 005486 FOR DETAILS.
 4. ALL DIMENSIONS ARE IN MILLIMETRES UNLESS OTHERWISE STATED.
 5. PROPOSED R6678 (2 OFF) TO BE INSTALLED AT DONOR SITE LOCATION: SITE NODE (XXXX).

SITE LAYOUT
NTS

DO NOT SCALE

PROPERTY DESCRIPTION

PART OF LOT 1/772123
PARISH OF ALEXANDRIA
COUNTY OF CUMBERLAND

SITE STRUCTURE CO-ORDINATES (GDA94) GPS READING ACCURACY: ± 10m CENTRE OF BUILDING	
LATITUDE	GDA 94 -33.92242°
LONGITUDE	GDA 94 151.25572°


CYIENT

Level 14, 3 Parramatta Square, 153 Macquarie St, Parramatta, NSW 2150, Australia
T +61 2 8896 6160 | www.cyient.com

NOTE: THIS DRAWING TO BE READ IN CONJUNCTION WITH SHEETS S1-1 & S1-2


ORDER	DRWN	CHKD	AMENDMENT	EXAM	APPD	DATE	ISS
NA10632.01	GH	CMcD	AS BUILT WCDMA2100 71353696WO01SIL	RS	BDB	05.02.14	6
NA16165.01	MN	MN	FOR CONSTRUCTION 30053350WO55ERIC LTE700	AQ	SL	08.03.16	7
NA16165.01	MBR	MBR	ASBUILT 30053350WO076 ERIC-LTE700	MBR	RV	28.09.16	8
NA18045.01	RA	TR	AS BUILT - 30069079W0049 VPL - LTE2600	AA	MK	19.02.18	9
NA21168.01	MV	RS	AS BUILT - 30084110W0141SSNC - NR3600	KSK	DG	04.09.20	10
NA29355.01	BN	RT	FOR CONSTRUCTION - 80005689WO561CYI - NR850/LTE2100	MB	MB	11.06.26	11

© Telstra Limited ACN 086 174 781 All rights reserved.

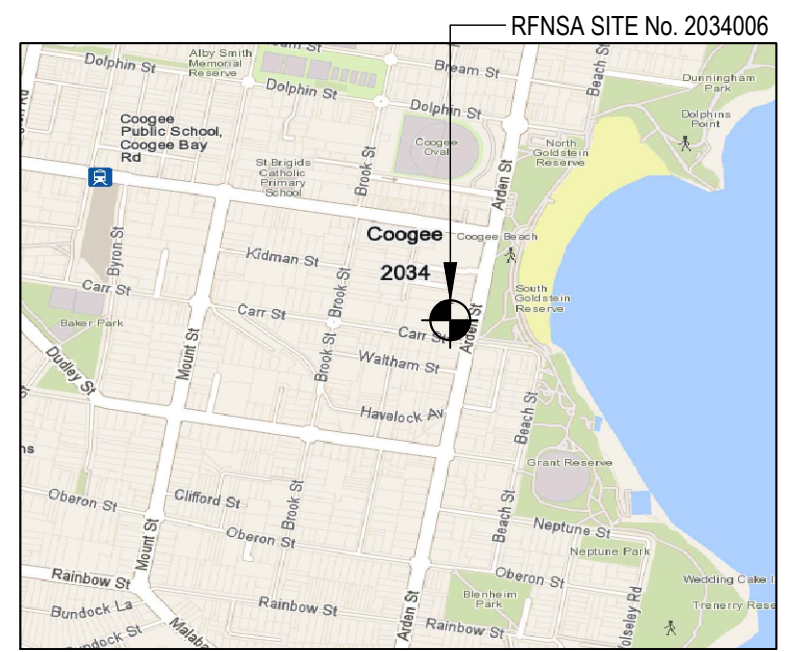

COPYRIGHT © WHEREIS® REGISTERED TRADEMARK OF SENSIS PTY LTD.

LOCALITY PLAN
NOT TO SCALE

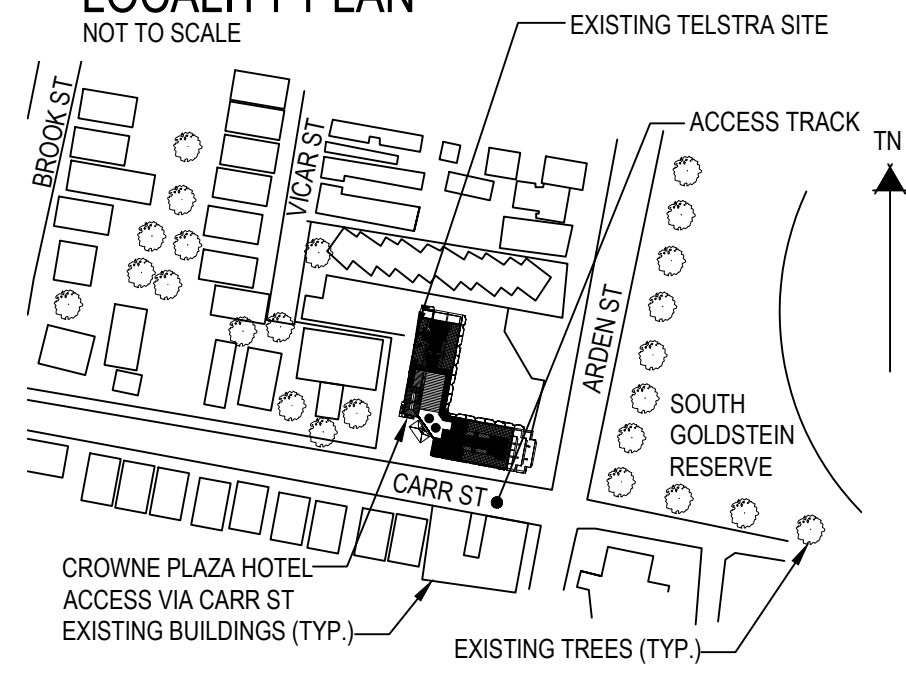

SITE ACCESS
NOT TO SCALE

COMPLIANCE BOX

COMPLETED AS PER DESIGN ☐

ALTERATIONS IN RED ☐

NAME (PRINT) _____


SIGNATURE _____ DATE _____

FOR CONSTRUCTION

Telstra

MOBILE NETWORK SITE 41009
CROWNE PLAZA
SITE LAYOUT AND ACCESS
242 ARDEN ST, COOGEE, NSW 2034

DWG NO. **N25414** SHT NO. S1

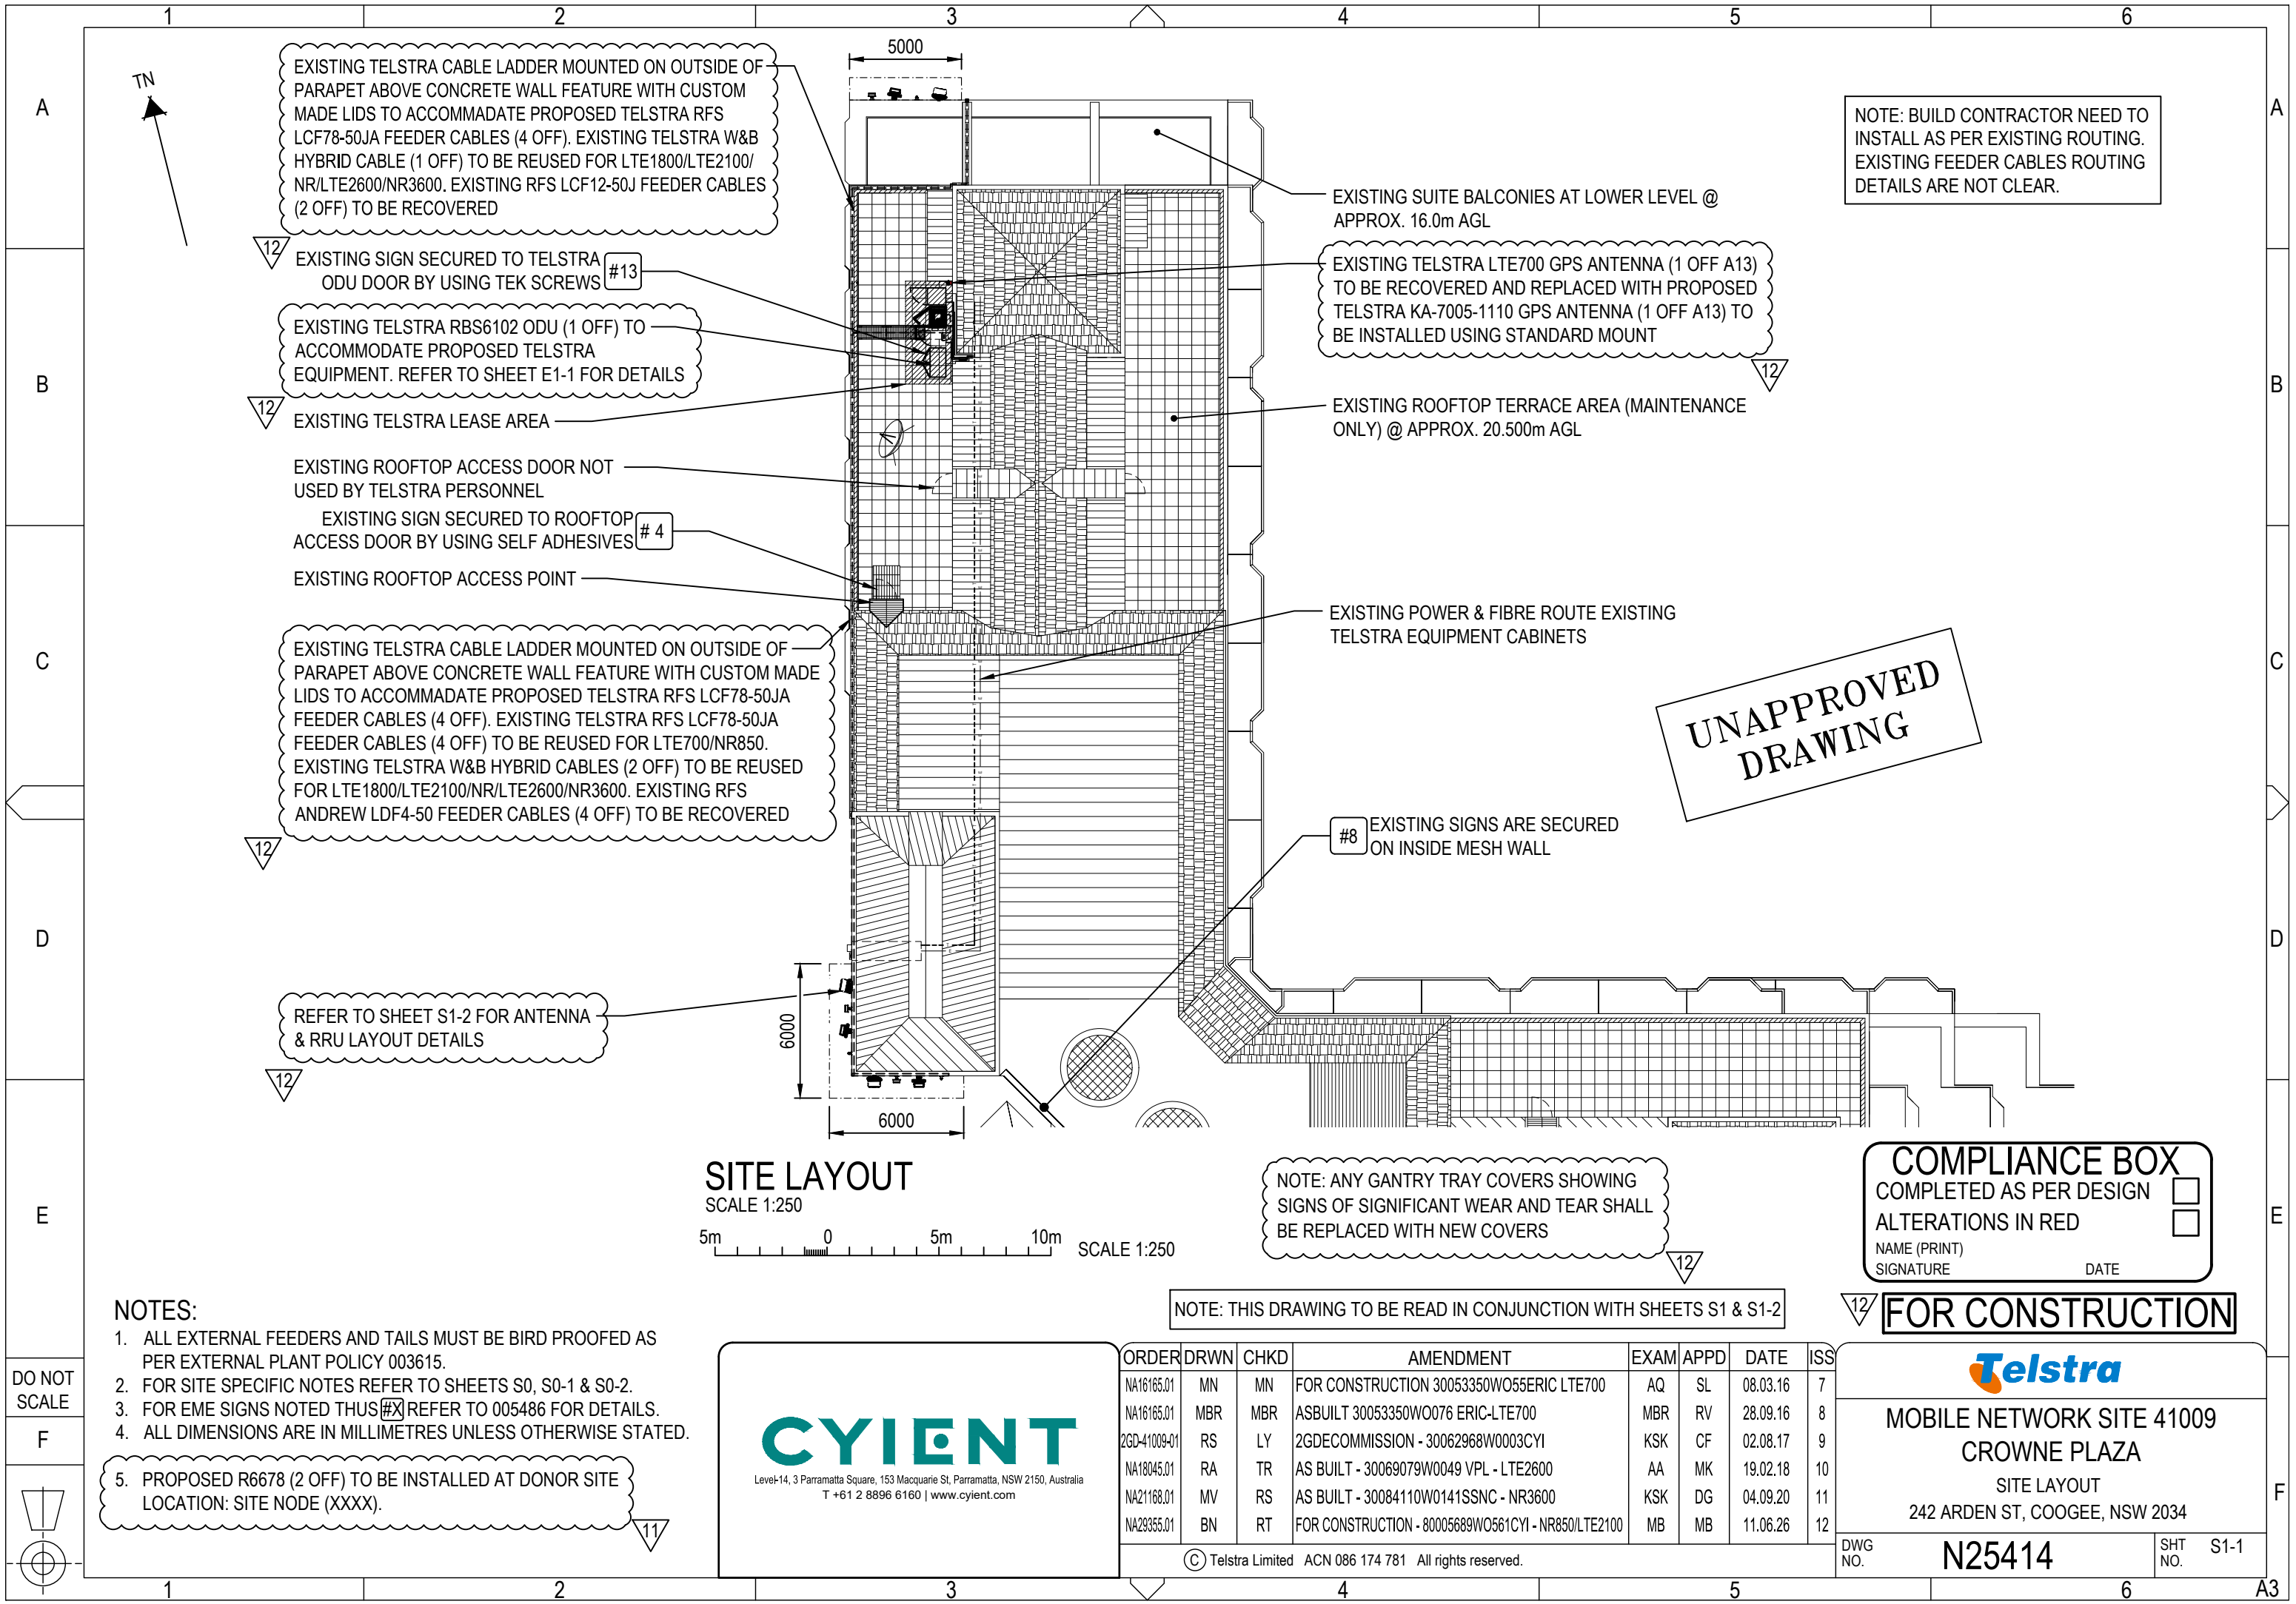

- NOTES:**
1. ALL EXTERNAL FEEDERS AND TAILS MUST BE BIRD PROOFED AS PER EXTERNAL PLANT POLICY 003615.
 2. FOR SITE SPECIFIC NOTES REFER TO SHEETS S0, S0-1 & S0-2.
 3. FOR EME SIGNS NOTED THUS (#X) REFER TO 005486 FOR DETAILS.
 4. ALL DIMENSIONS ARE IN MILLIMETRES UNLESS OTHERWISE STATED.
 5. PROPOSED R6678 (2 OFF) TO BE INSTALLED AT DONOR SITE LOCATION: SITE NODE (XXXX).


CYIENT
Level-14, 3 Parramatta Square, 153 Macquarie St, Parramatta, NSW 2150, Australia
T +61 2 8896 6160 | www.cyient.com

ORDER	DRWN	CHKD	AMENDMENT	EXAM	APPD	DATE	ISS
NA16165.01	MN	MN	FOR CONSTRUCTION 30053350W055ERIC LTE700	AQ	SL	08.03.16	7
NA16165.01	MBR	MBR	ASBUILT 30053350W0076 ERIC-LTE700	MBR	RV	28.09.16	8
2GD-41009-01	RS	LY	2GDECOMMISSION - 30062968W0003CYI	KSK	CF	02.08.17	9
NA18045.01	RA	TR	AS BUILT - 30069079W0049 VPL - LTE2600	AA	MK	19.02.18	10
NA21168.01	MV	RS	AS BUILT - 30084110W0141SSNC - NR3600	KSK	DG	04.09.20	11
NA29355.01	BN	RT	FOR CONSTRUCTION - 80005689W0561CYI - NR850/LTE2100	MB	MB	11.06.26	12

COMPLIANCE BOX
COMPLETED AS PER DESIGN ☐
ALTERATIONS IN RED ☐
NAME (PRINT) _____
SIGNATURE _____ DATE _____

FOR CONSTRUCTION

Telstra
MOBILE NETWORK SITE 41009
CROWNE PLAZA
SITE LAYOUT
242 ARDEN ST, COOGEE, NSW 2034
DWG NO. **N25414** SHT NO. S1-1

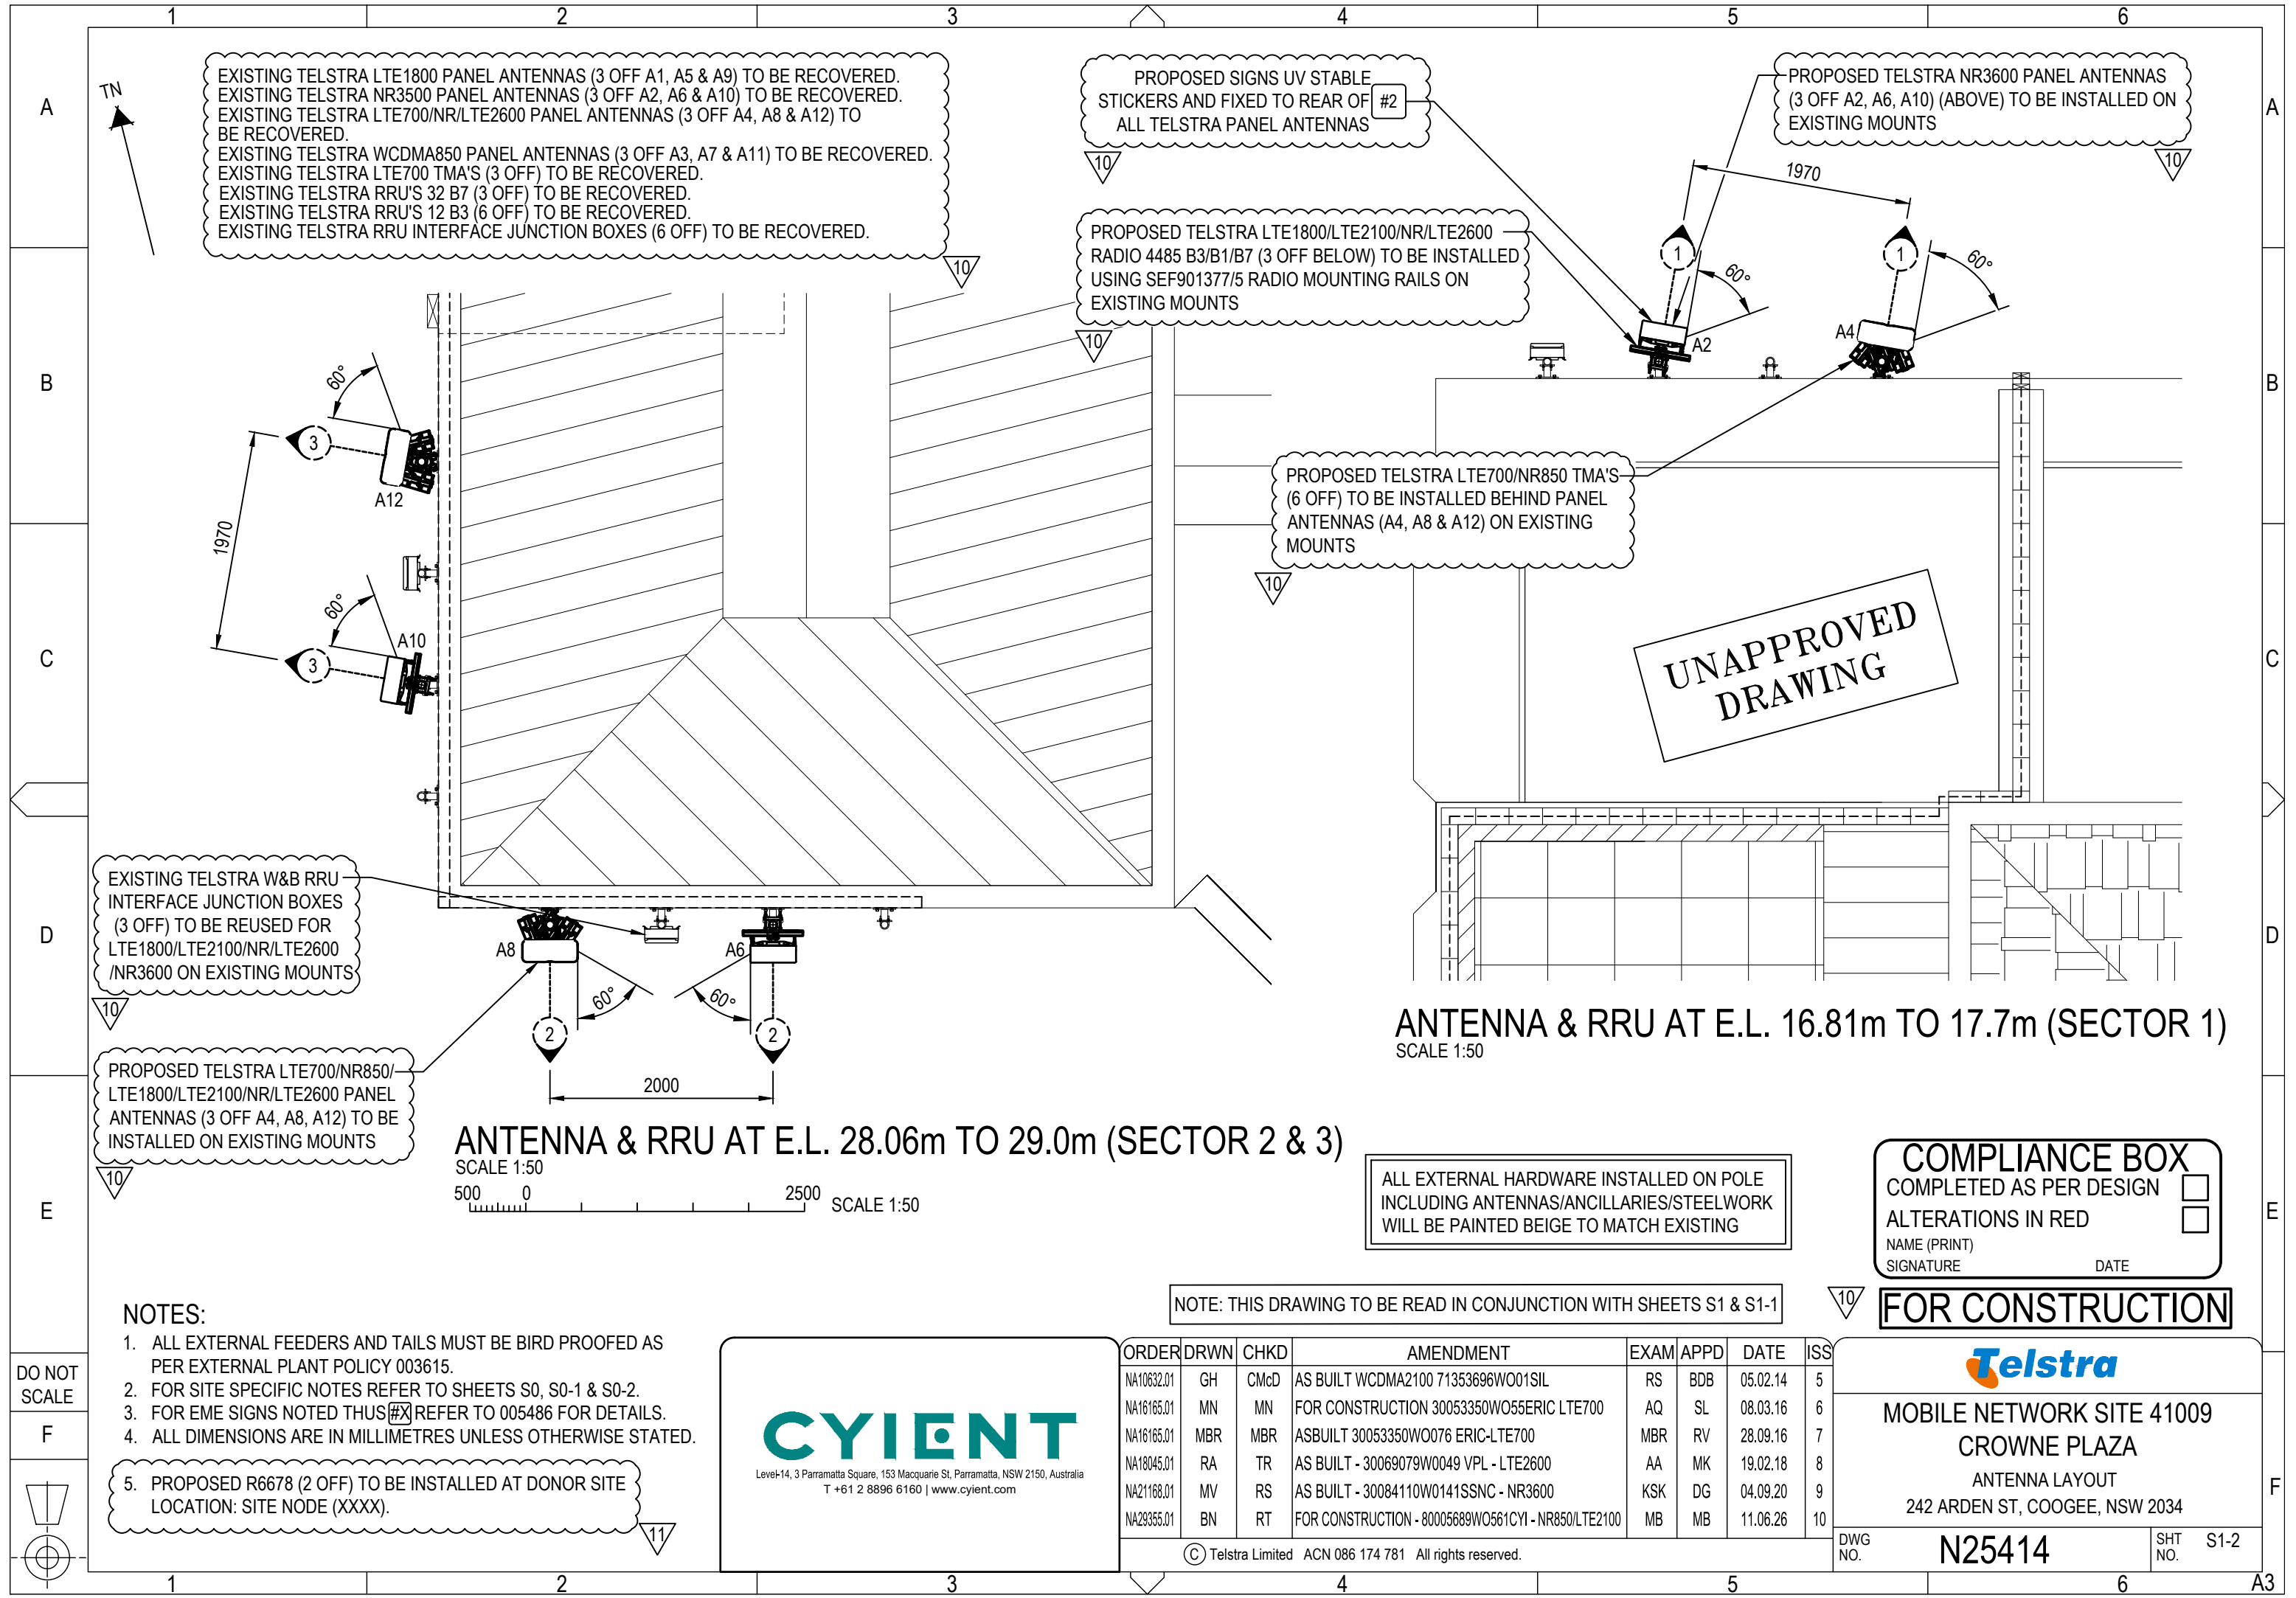

EXISTING TELSTRA LTE1800 PANEL ANTENNAS (3 OFF A1, A5 & A9) TO BE RECOVERED.
EXISTING TELSTRA NR3500 PANEL ANTENNAS (3 OFF A2, A6 & A10) TO BE RECOVERED.
EXISTING TELSTRA LTE700/NR/LTE2600 PANEL ANTENNAS (3 OFF A4, A8 & A12) TO BE RECOVERED.
EXISTING TELSTRA WCDMA850 PANEL ANTENNAS (3 OFF A3, A7 & A11) TO BE RECOVERED.
EXISTING TELSTRA LTE700 TMA'S (3 OFF) TO BE RECOVERED.
EXISTING TELSTRA RRU'S 32 B7 (3 OFF) TO BE RECOVERED.
EXISTING TELSTRA RRU'S 12 B3 (6 OFF) TO BE RECOVERED.
EXISTING TELSTRA RRU INTERFACE JUNCTION BOXES (6 OFF) TO BE RECOVERED.

PROPOSED SIGNS UV STABLE STICKERS AND FIXED TO REAR OF ALL TELSTRA PANEL ANTENNAS

PROPOSED TELSTRA NR3600 PANEL ANTENNAS (3 OFF A2, A6, A10) (ABOVE) TO BE INSTALLED ON EXISTING MOUNTS

PROPOSED TELSTRA LTE1800/LTE2100/NR/LTE2600 RADIO 4485 B3/B1/B7 (3 OFF BELOW) TO BE INSTALLED USING SEF901377/5 RADIO MOUNTING RAILS ON EXISTING MOUNTS

PROPOSED TELSTRA LTE700/NR850 TMA'S (6 OFF) TO BE INSTALLED BEHIND PANEL ANTENNAS (A4, A8 & A12) ON EXISTING MOUNTS

EXISTING TELSTRA W&B RRU INTERFACE JUNCTION BOXES (3 OFF) TO BE REUSED FOR LTE1800/LTE2100/NR/LTE2600 /NR3600 ON EXISTING MOUNTS

PROPOSED TELSTRA LTE700/NR850/LTE1800/LTE2100/NR/LTE2600 PANEL ANTENNAS (3 OFF A4, A8, A12) TO BE INSTALLED ON EXISTING MOUNTS

ANTENNA & RRU AT E.L. 28.06m TO 29.0m (SECTOR 2 & 3)

ANTENNA & RRU AT E.L. 16.81m TO 17.7m (SECTOR 1)

- NOTES:
1. ALL EXTERNAL FEEDERS AND TAILS MUST BE BIRD PROOFED AS PER EXTERNAL PLANT POLICY 003615.
 2. FOR SITE SPECIFIC NOTES REFER TO SHEETS S0, S0-1 & S0-2.
 3. FOR EME SIGNS NOTED THUS (#X) REFER TO 005486 FOR DETAILS.
 4. ALL DIMENSIONS ARE IN MILLIMETRES UNLESS OTHERWISE STATED.

NOTE: THIS DRAWING TO BE READ IN CONJUNCTION WITH SHEETS S1 & S1-1

ALL EXTERNAL HARDWARE INSTALLED ON POLE INCLUDING ANTENNAS/ANCILLARIES/STEELWORK WILL BE PAINTED BEIGE TO MATCH EXISTING


COMPLIANCE BOX
COMPLETED AS PER DESIGN ☐
ALTERATIONS IN RED ☐
NAME (PRINT) _____
SIGNATURE _____ DATE _____

FOR CONSTRUCTION

CYIENT
Level 14, 3 Parramatta Square, 153 Macquarie St, Parramatta, NSW 2150, Australia
T +61 2 8896 6160 | www.cyient.com

ORDER	DRWN	CHKD	AMENDMENT	EXAM	APPD	DATE	ISS
NA10632.01	GH	CMcD	AS BUILT WCDMA2100 71353696W001SIL	RS	BDB	05.02.14	5
NA16165.01	MN	MN	FOR CONSTRUCTION 30053350W055ERIC LTE700	AQ	SL	08.03.16	6
NA16165.01	MBR	MBR	ASBUILT 30053350W0076 ERIC-LTE700	MBR	RV	28.09.16	7
NA18045.01	RA	TR	AS BUILT - 30069079W0049 VPL - LTE2600	AA	MK	19.02.18	8
NA21168.01	MV	RS	AS BUILT - 30084110W0141SSNC - NR3600	KSK	DG	04.09.20	9
NA29355.01	BN	RT	FOR CONSTRUCTION - 80005689W0561CYI - NR850/LTE2100	MB	MB	11.06.26	10

Telstra
MOBILE NETWORK SITE 41009
CROWNE PLAZA
ANTENNA LAYOUT
242 ARDEN ST, COOGEE, NSW 2034
DWG NO. **N25414** SHT NO. S1-2

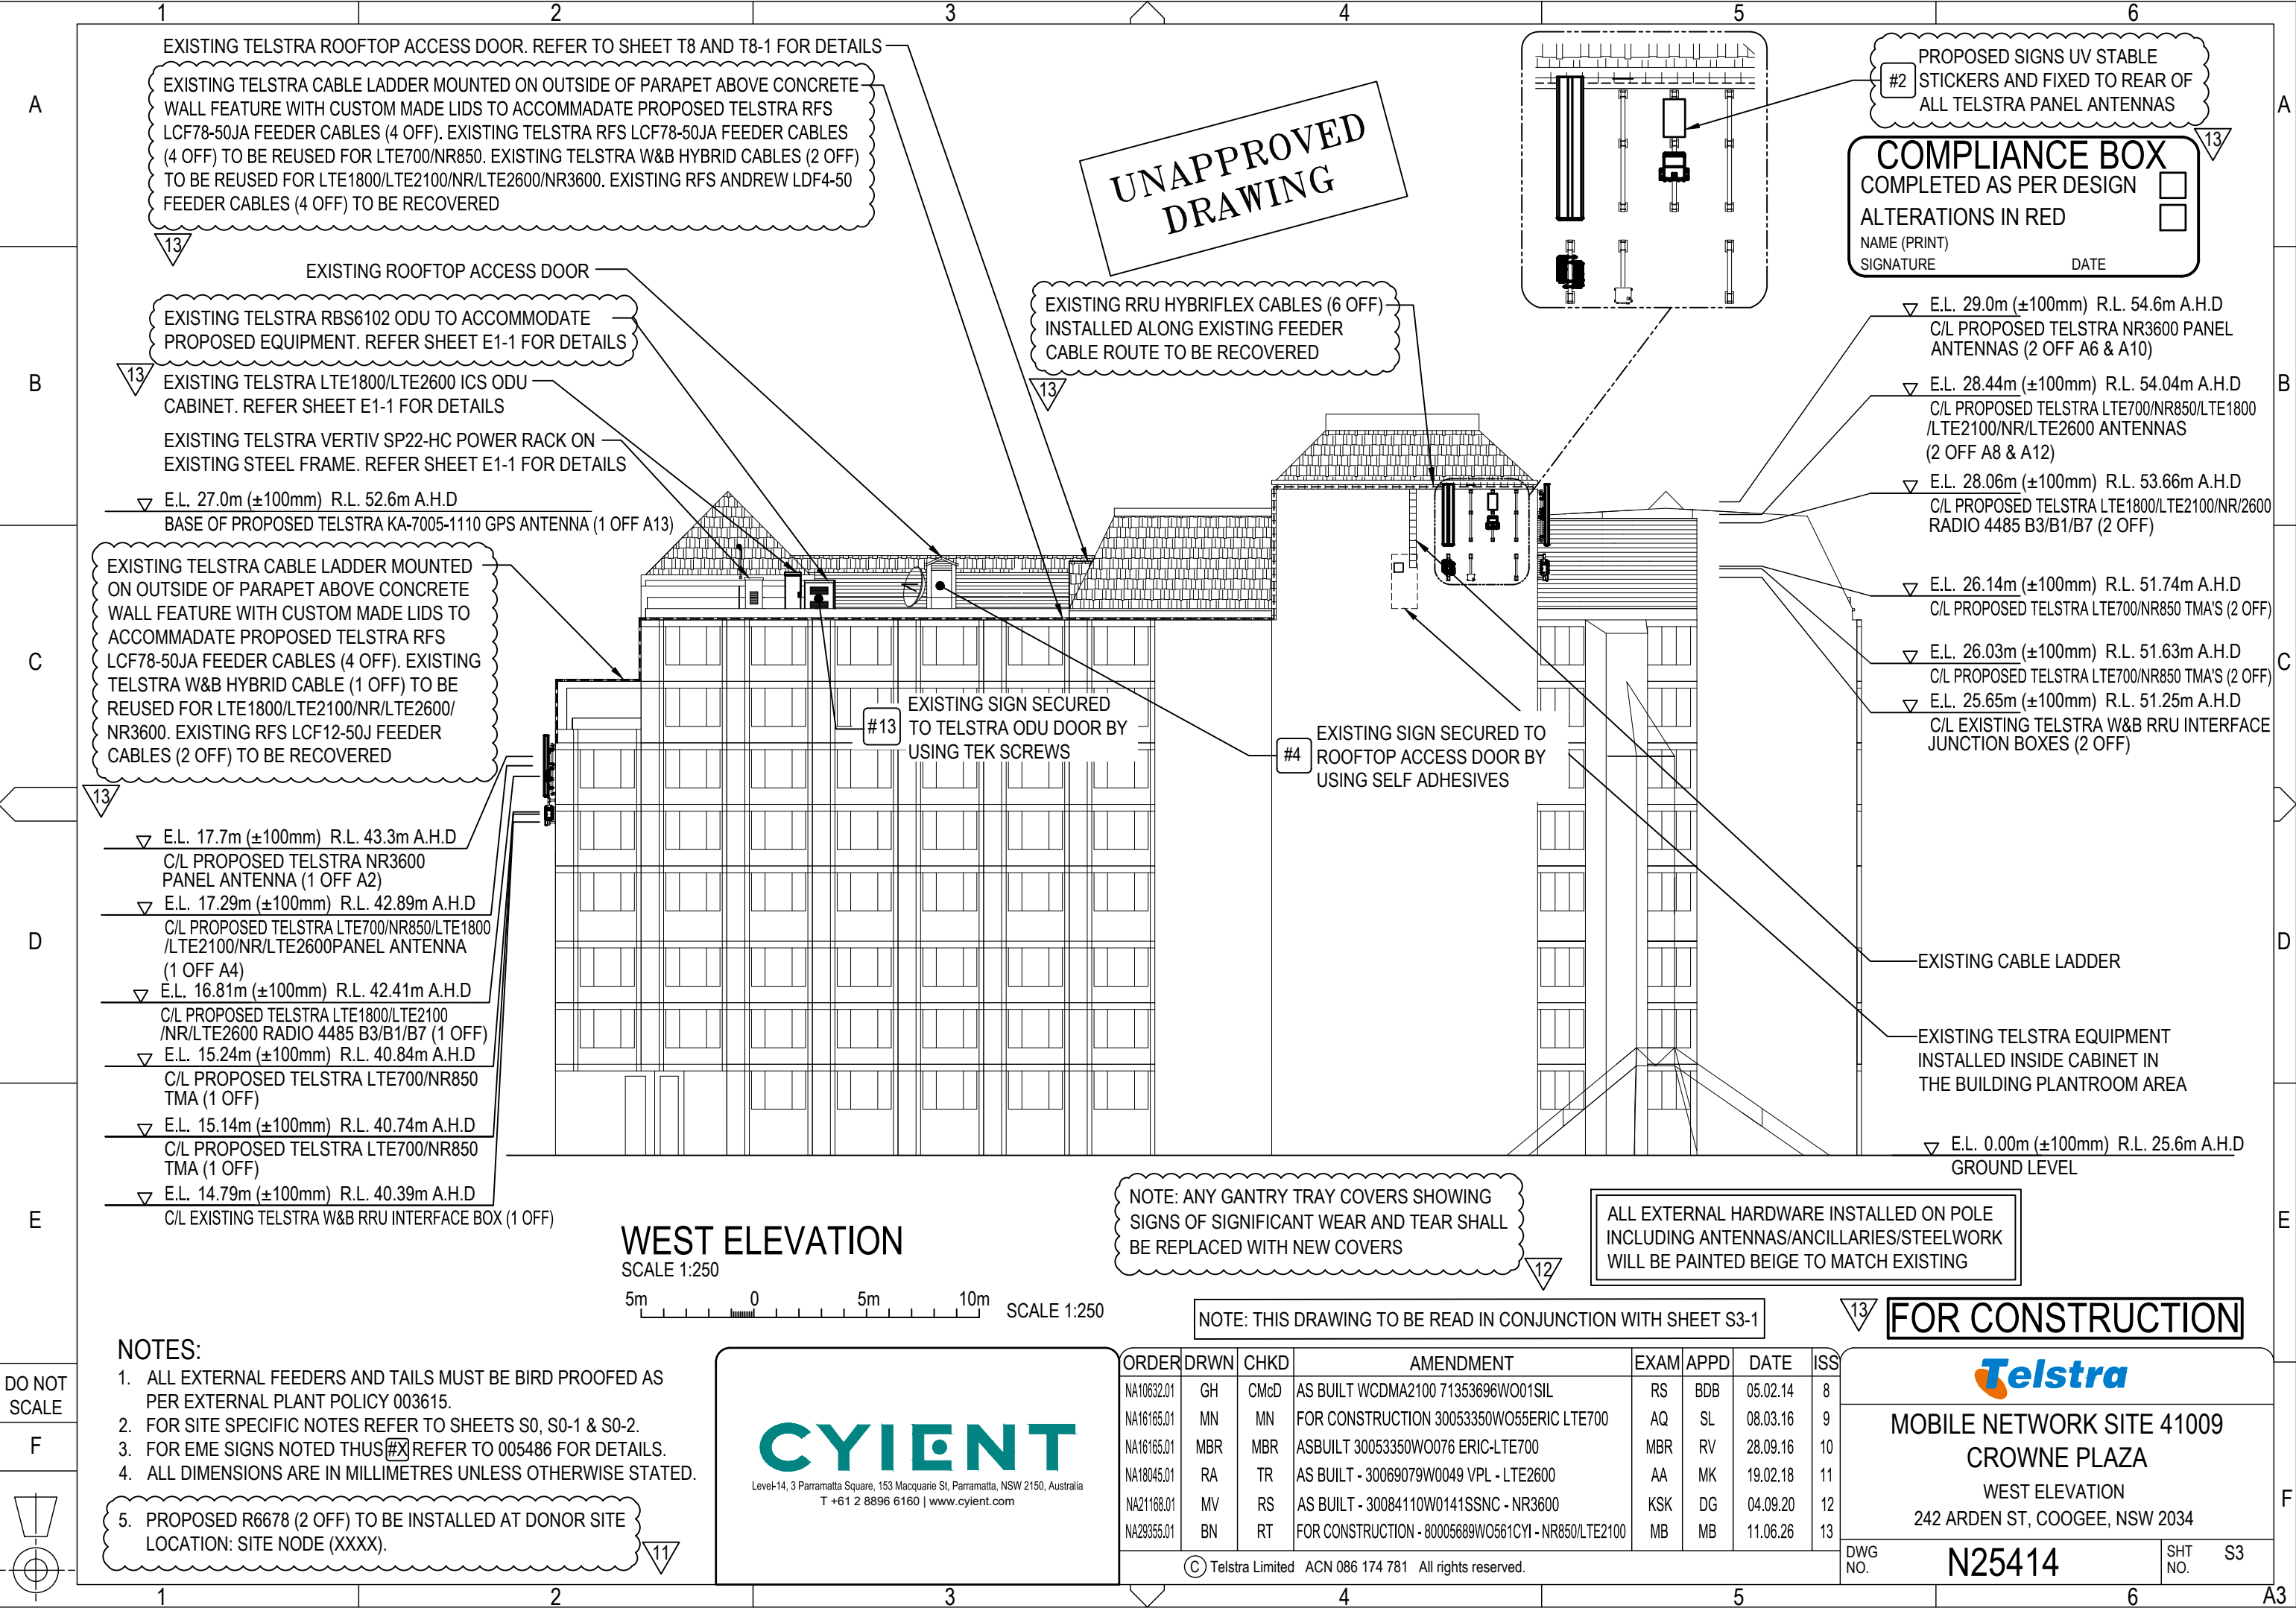

UNAPPROVED
DRAWING

COMPLIANCE BOX

COMPLETED AS PER DESIGN


ALTERATIONS IN RED

NAME (PRINT)

SIGNATURE

DATE

WEST ELEVATION

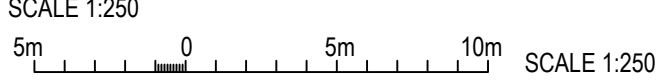

NOTES:

- ALL EXTERNAL FEEDERS AND TAILS MUST BE BIRD PROOFED AS PER EXTERNAL PLANT POLICY 003615.
- FOR SITE SPECIFIC NOTES REFER TO SHEETS S0, S0-1 & S0-2.
- FOR EME SIGNS NOTED THUS (X) REFER TO 005486 FOR DETAILS.
- ALL DIMENSIONS ARE IN MILLIMETRES UNLESS OTHERWISE STATED.
- PROPOSED R6678 (2 OFF) TO BE INSTALLED AT DONOR SITE LOCATION: SITE NODE (XXXX).

CYIENT

Level-14, 3 Parramatta Square, 153 Macquarie St, Parramatta, NSW 2150, Australia
T +61 2 8896 6160 | www.cyient.com

NOTE: THIS DRAWING TO BE READ IN CONJUNCTION WITH SHEET S3-1

ORDER	DRWN	CHKD	AMENDMENT	EXAM	APPD	DATE	ISS
NA10632.01	GH	CMcD	AS BUILT WCDMA2100 71353696W001SIL	RS	BDB	05.02.14	8
NA16165.01	MN	MN	FOR CONSTRUCTION 30053350W055ERIC LTE700	AQ	SL	08.03.16	9
NA16165.01	MBR	MBR	ASBUILT 30053350W0076 ERIC-LTE700	MBR	RV	28.09.16	10
NA18045.01	RA	TR	AS BUILT - 30069079W0049 VPL - LTE2600	AA	MK	19.02.18	11
NA21168.01	MV	RS	AS BUILT - 30084110W0141SSNC - NR3600	KSK	DG	04.09.20	12
NA29355.01	BN	RT	FOR CONSTRUCTION - 80005689W0561CYI - NR850/LTE2100	MB	MB	11.06.26	13

© Telstra Limited ACN 086 174 781 All rights reserved.



MOBILE NETWORK SITE 41009
CROWNE PLAZA
WEST ELEVATION
242 ARDEN ST, COOGEE, NSW 2034

N25414

SHT NO. S3

