


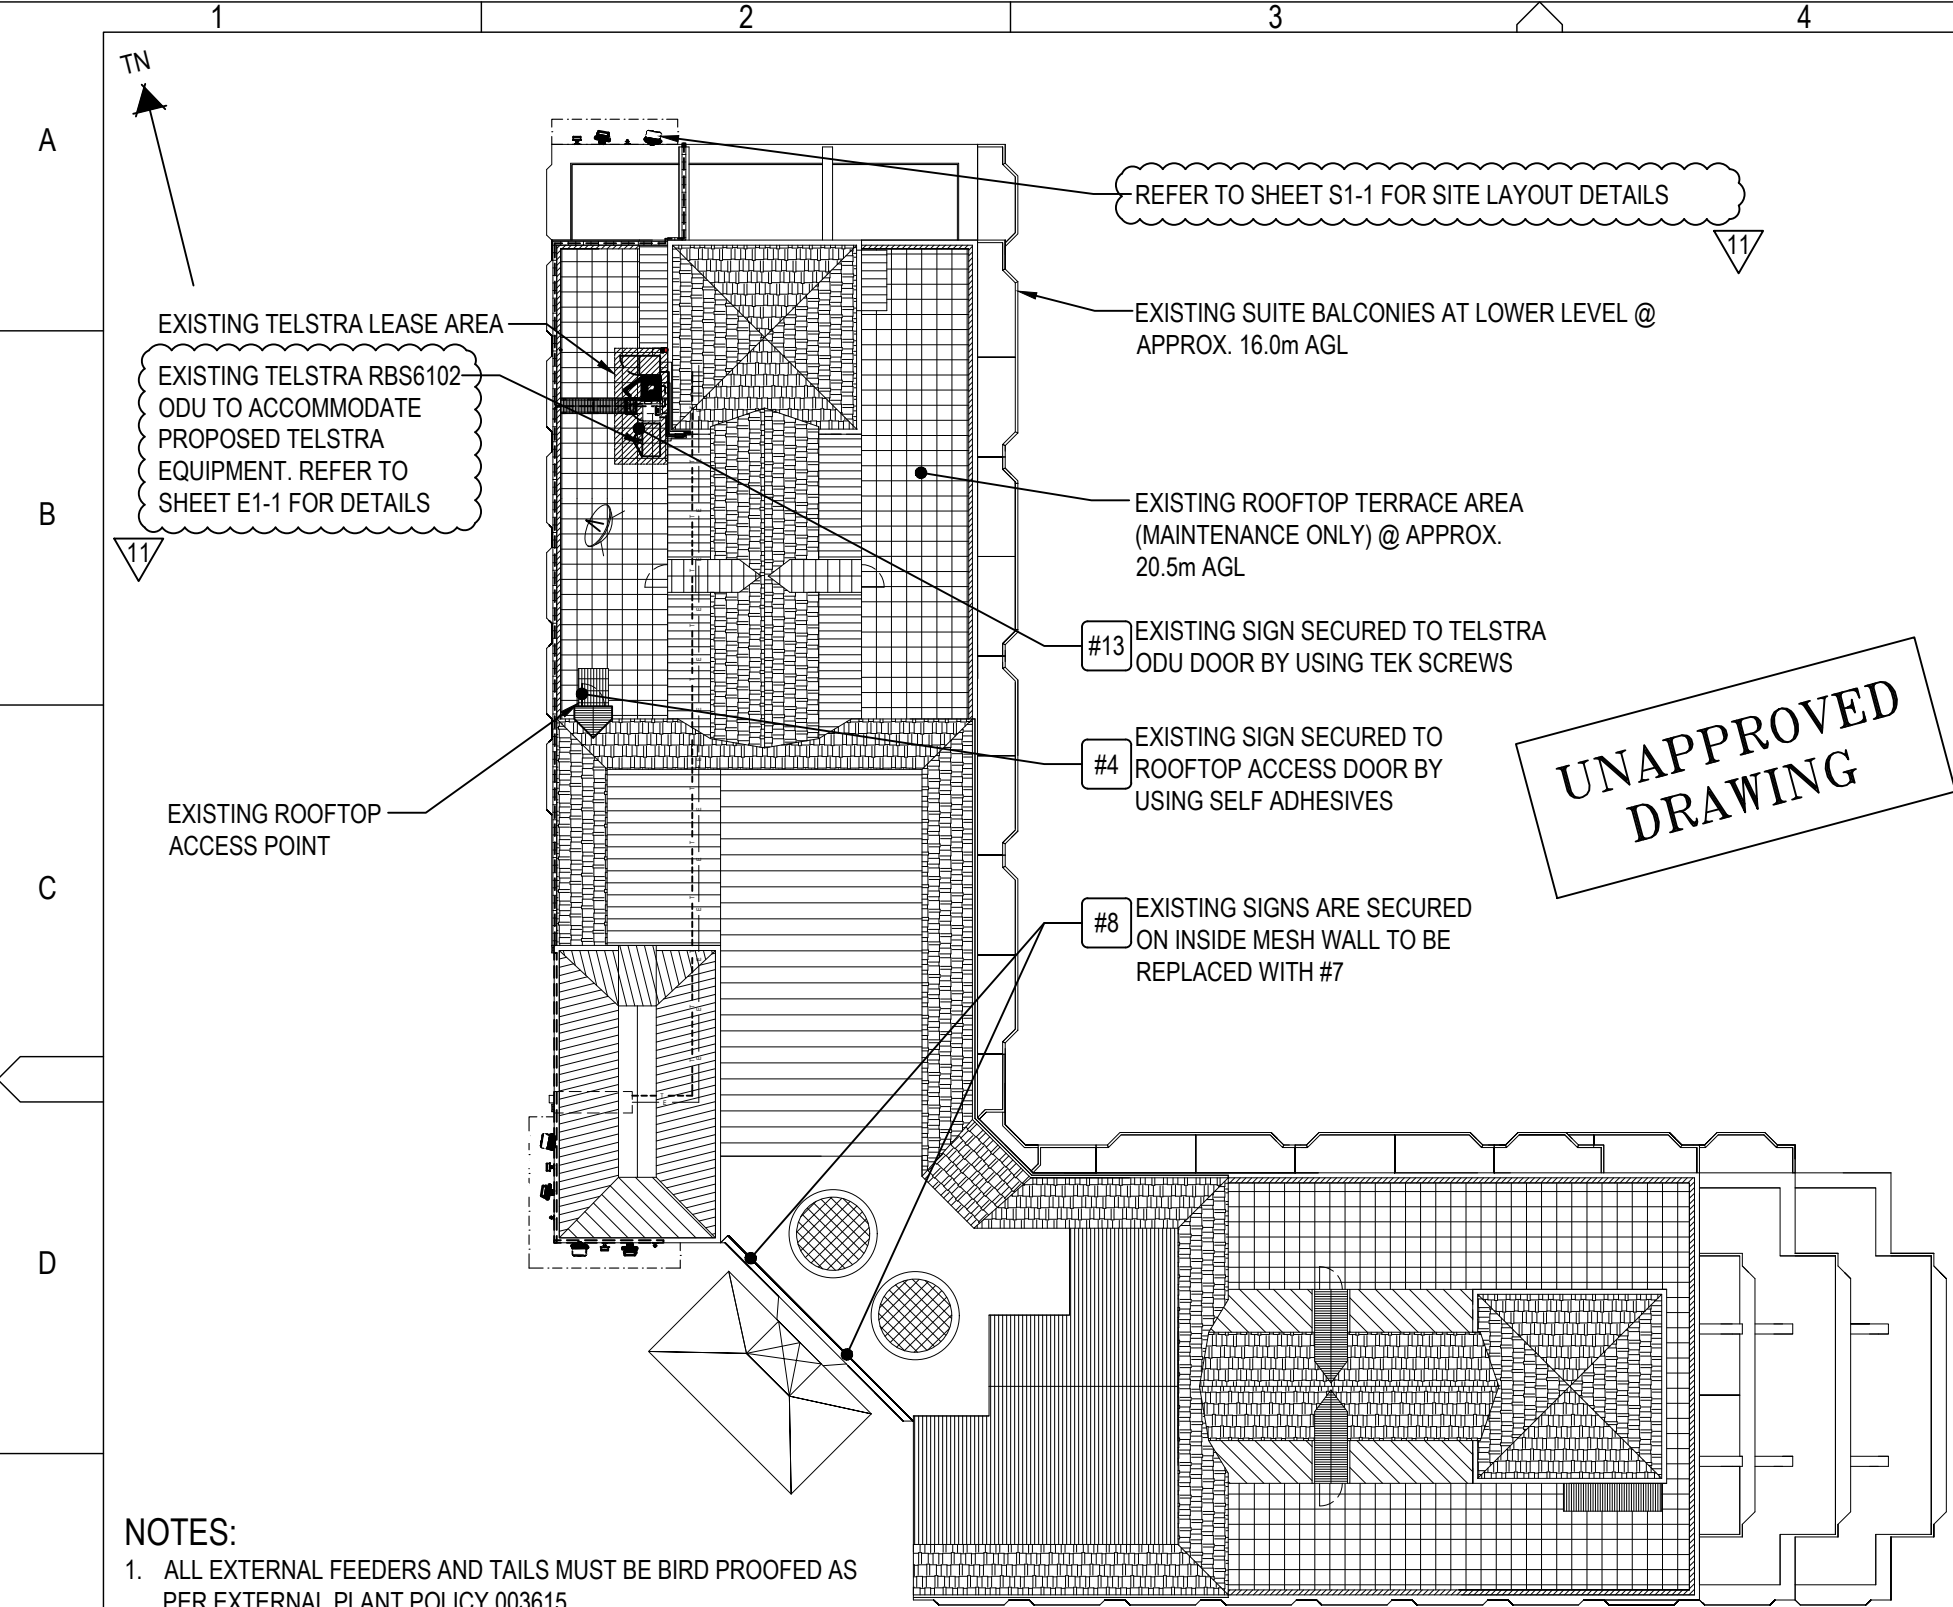

- NOTES:
1. ALL EXTERNAL FEEDERS AND TAILS MUST BE BIRD PROOFED AS PER EXTERNAL PLANT POLICY 003615.
 2. FOR SITE SPECIFIC NOTES REFER TO SHEETS S0, S0-1 & S0-2.
 3. FOR EME SIGNS NOTED THUS [X] REFER TO 005486 FOR DETAILS.
 4. ALL DIMENSIONS ARE IN MILLIMETRES UNLESS OTHERWISE STATED.
 5. PROPOSED R6678 (2 OFF) TO BE INSTALLED AT DONOR SITE LOCATION: SITE NODE (XXXX).

SITE LAYOUT
NTS

DO NOT SCALE

PROPERTY DESCRIPTION

PART OF LOT 1/772123
PARISH OF ALEXANDRIA
COUNTY OF CUMBERLAND

SITE STRUCTURE CO-ORDINATES (GDA94) GPS READING ACCURACY: ± 10m CENTRE OF BUILDING	
LATITUDE	GDA 94 -33.92242°
LONGITUDE	GDA 94 151.25572°


CYIENT

Level 14, 3 Parramatta Square, 153 Macquarie St, Parramatta, NSW 2150, Australia
T +61 2 8896 6160 | www.cyient.com

NOTE: THIS DRAWING TO BE READ IN CONJUNCTION WITH SHEETS S1-1 & S1-2


ORDER	DRWN	CHKD	AMENDMENT	EXAM	APPD	DATE	ISS
NA10632.01	GH	CMcD	AS BUILT WCDMA2100 71353696WO01SIL	RS	BDB	05.02.14	6
NA16165.01	MN	MN	FOR CONSTRUCTION 30053350WO55ERIC LTE700	AQ	SL	08.03.16	7
NA16165.01	MBR	MBR	ASBUILT 30053350WO076 ERIC-LTE700	MBR	RV	28.09.16	8
NA18045.01	RA	TR	AS BUILT - 30069079W0049 VPL - LTE2600	AA	MK	19.02.18	9
NA21168.01	MV	RS	AS BUILT - 30084110W0141SSNC - NR3600	KSK	DG	04.09.20	10
NA29355.01	BN	RT	FOR CONSTRUCTION - 80005689WO561CYI - NR850/LTE2100	MB	MB	11.06.26	11

© Telstra Limited ACN 086 174 781 All rights reserved.

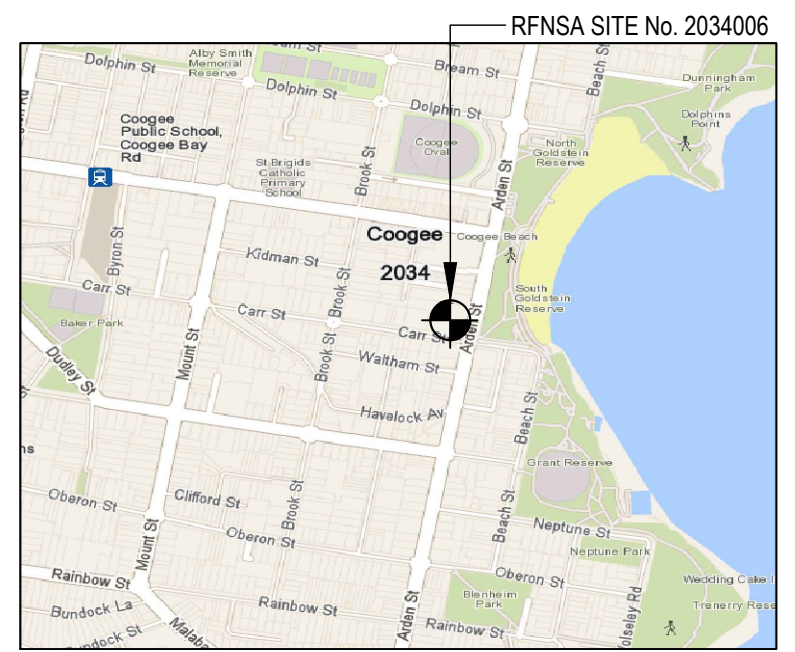

COPYRIGHT © WHEREIS® REGISTERED TRADEMARK OF SENSIS PTY LTD.

LOCALITY PLAN
NOT TO SCALE

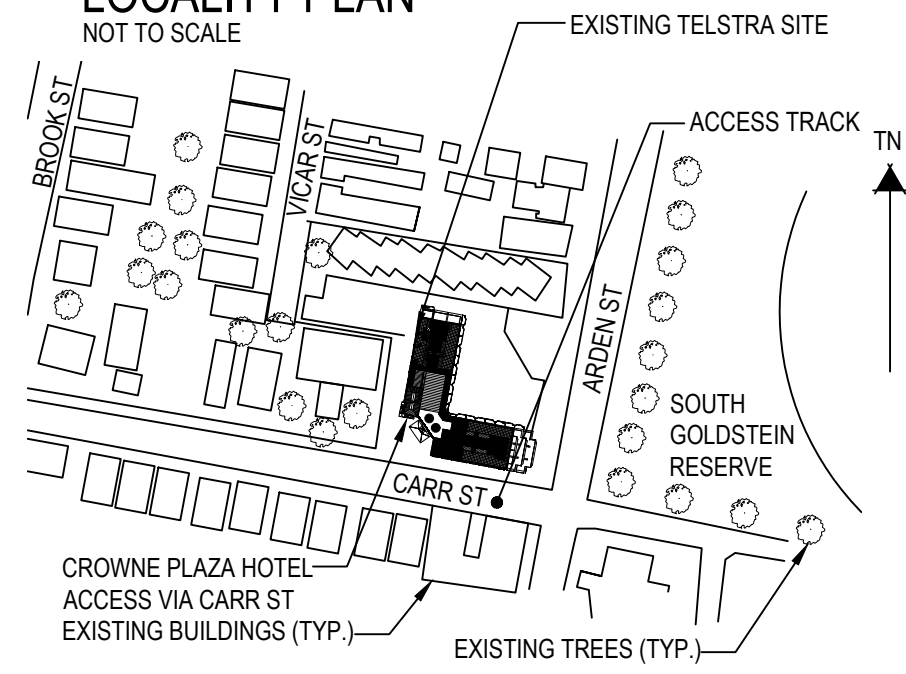

SITE ACCESS
NOT TO SCALE

COMPLIANCE BOX

COMPLETED AS PER DESIGN ☐

ALTERATIONS IN RED ☐

NAME (PRINT) _____


SIGNATURE _____ DATE _____

FOR CONSTRUCTION

Telstra

MOBILE NETWORK SITE 41009
CROWNE PLAZA
SITE LAYOUT AND ACCESS
242 ARDEN ST, COOGEE, NSW 2034

DWG NO. **N25414** SHT NO. S1

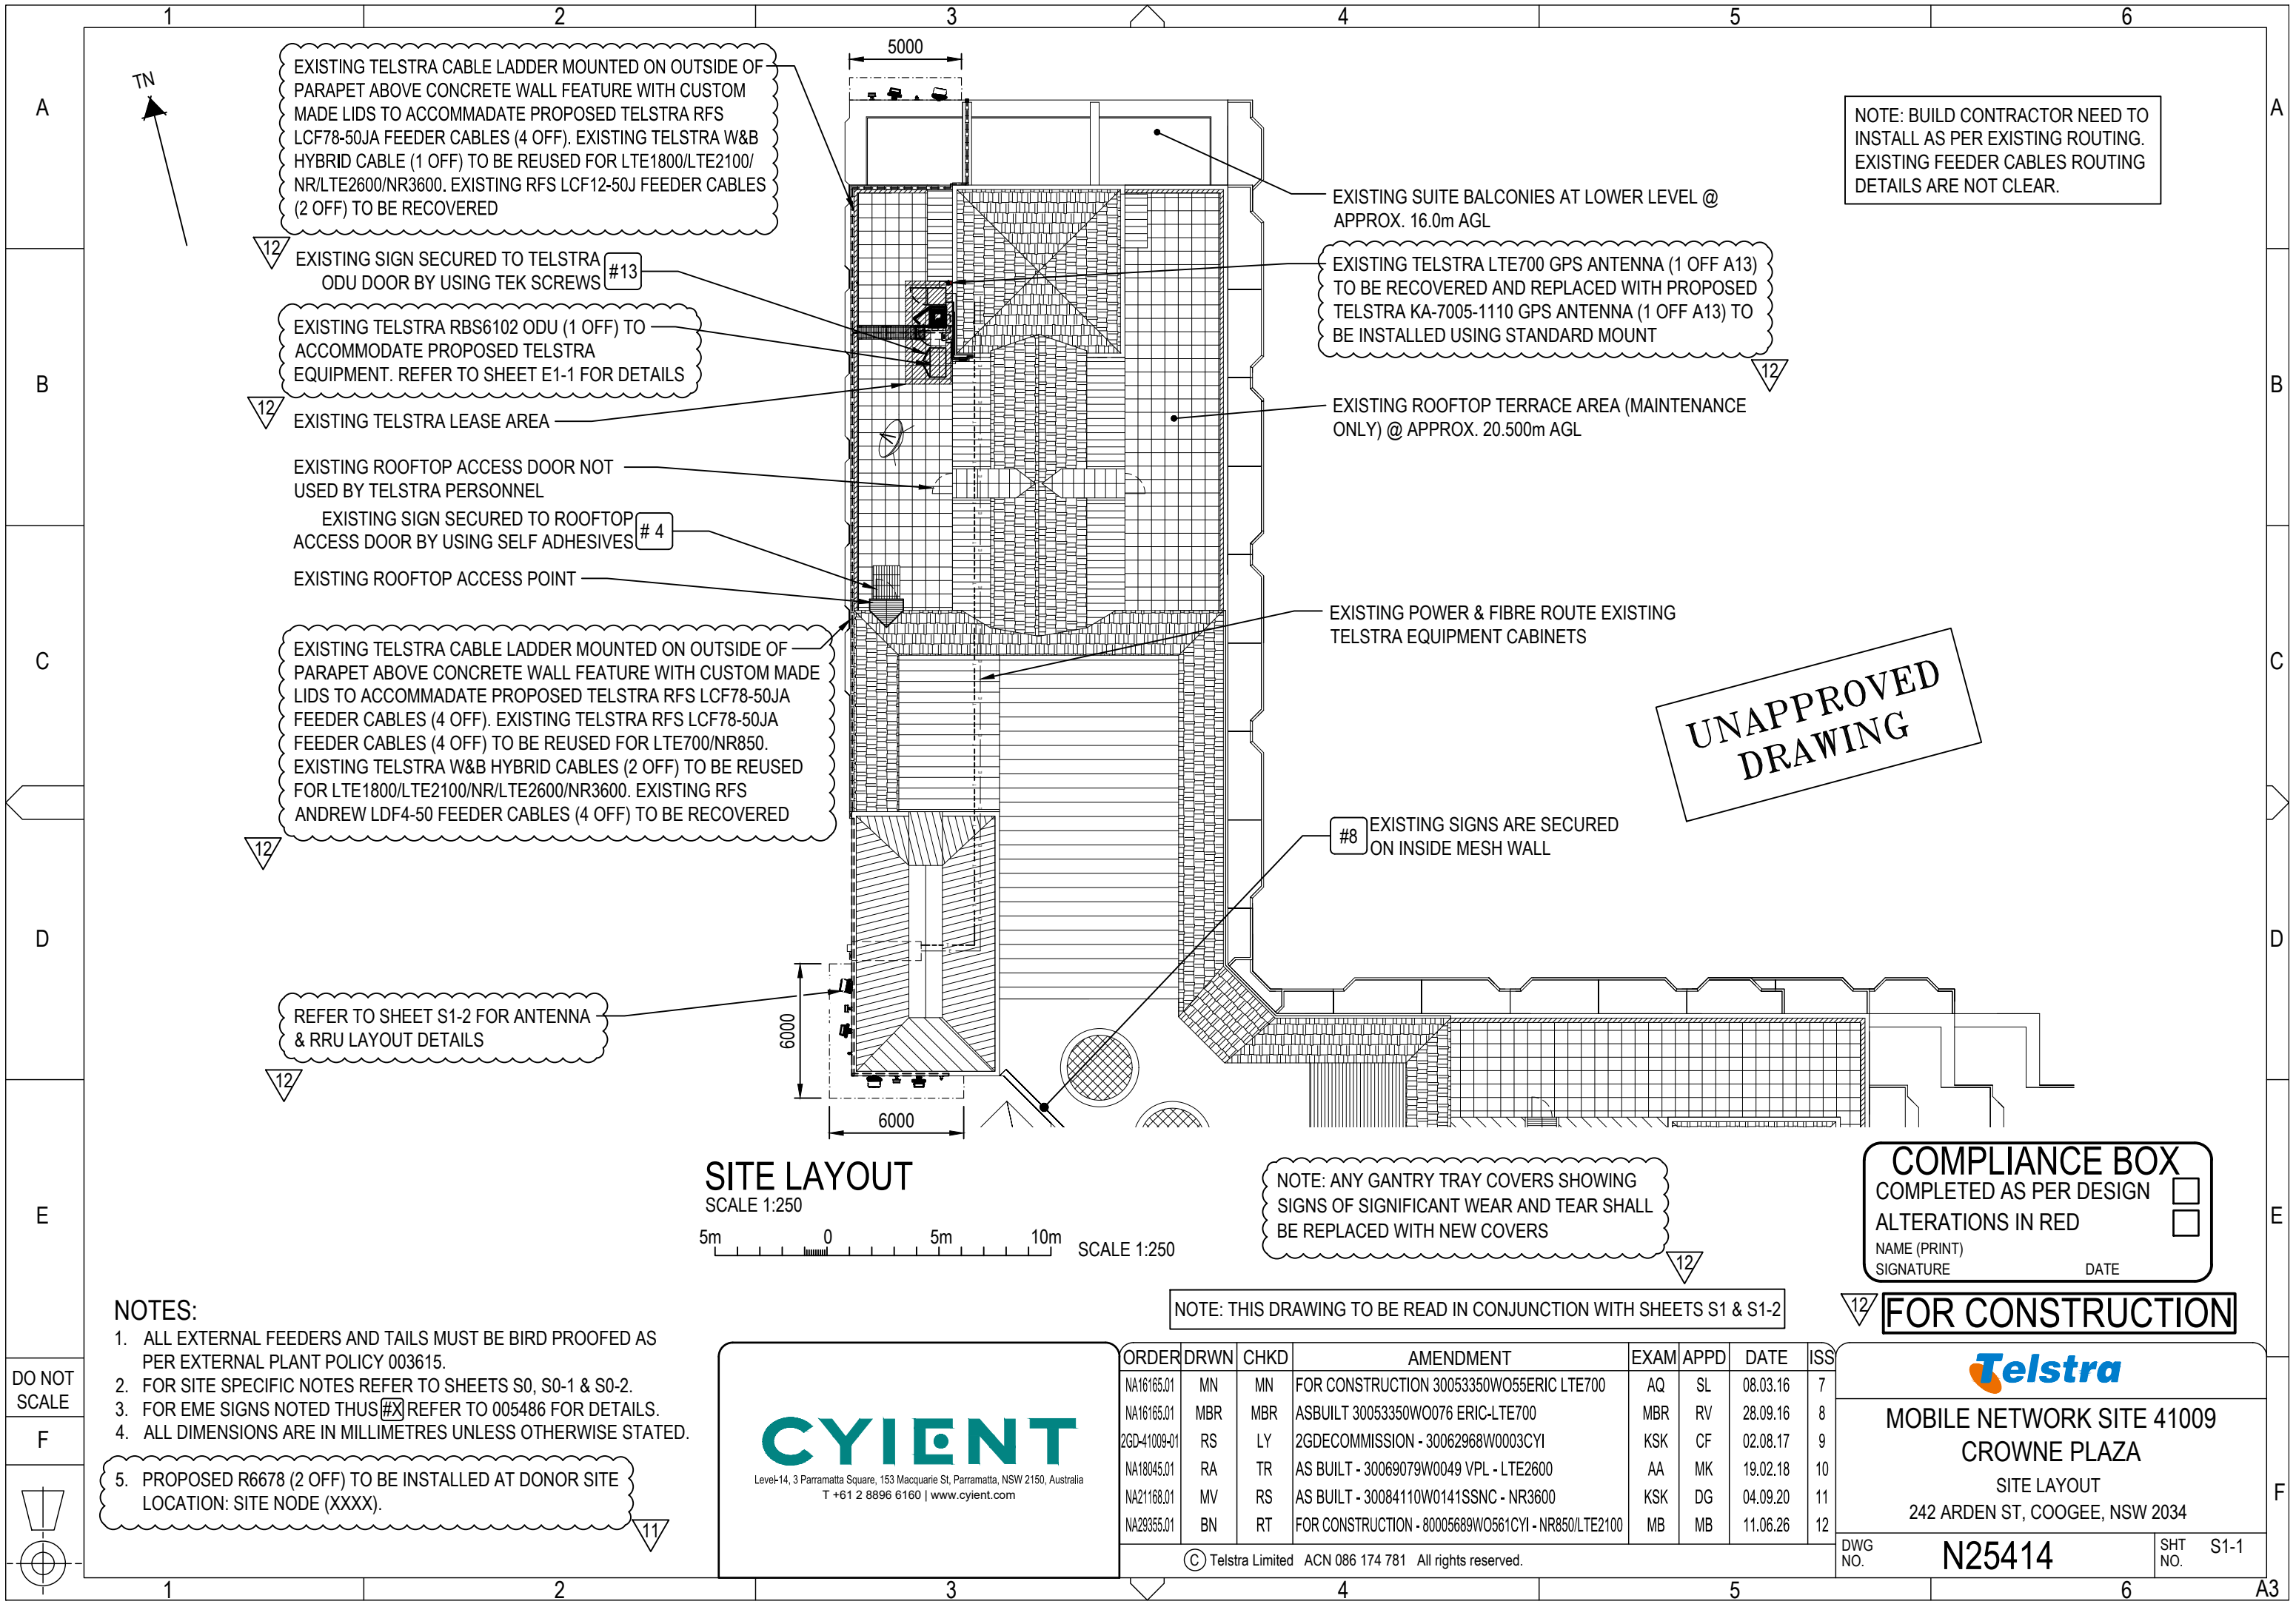

EXISTING TELSTRA CABLE LADDER MOUNTED ON OUTSIDE OF PARAPET ABOVE CONCRETE WALL FEATURE WITH CUSTOM MADE LIDS TO ACCOMMODATE PROPOSED TELSTRA RFS LCF78-50JA FEEDER CABLES (4 OFF). EXISTING TELSTRA W&B HYBRID CABLE (1 OFF) TO BE REUSED FOR LTE1800/LTE2100/NR/LTE2600/NR3600. EXISTING RFS LCF12-50J FEEDER CABLES (2 OFF) TO BE RECOVERED

EXISTING SIGN SECURED TO TELSTRA ODU DOOR BY USING TEK SCREWS #13

EXISTING TELSTRA RBS6102 ODU (1 OFF) TO ACCOMMODATE PROPOSED TELSTRA EQUIPMENT. REFER TO SHEET E1-1 FOR DETAILS

EXISTING TELSTRA LEASE AREA

EXISTING ROOFTOP ACCESS DOOR NOT USED BY TELSTRA PERSONNEL

EXISTING SIGN SECURED TO ROOFTOP ACCESS DOOR BY USING SELF ADHESIVES #4

EXISTING ROOFTOP ACCESS POINT

EXISTING TELSTRA CABLE LADDER MOUNTED ON OUTSIDE OF PARAPET ABOVE CONCRETE WALL FEATURE WITH CUSTOM MADE LIDS TO ACCOMMODATE PROPOSED TELSTRA RFS LCF78-50JA FEEDER CABLES (4 OFF). EXISTING TELSTRA RFS LCF78-50JA FEEDER CABLES (4 OFF) TO BE REUSED FOR LTE700/NR850. EXISTING TELSTRA W&B HYBRID CABLES (2 OFF) TO BE REUSED FOR LTE1800/LTE2100/NR/LTE2600/NR3600. EXISTING RFS ANDREW LDF4-50 FEEDER CABLES (4 OFF) TO BE RECOVERED

REFER TO SHEET S1-2 FOR ANTENNA & RRU LAYOUT DETAILS

EXISTING SUITE BALCONIES AT LOWER LEVEL @ APPROX. 16.0m AGL

EXISTING TELSTRA LTE700 GPS ANTENNA (1 OFF A13) TO BE RECOVERED AND REPLACED WITH PROPOSED TELSTRA KA-7005-1110 GPS ANTENNA (1 OFF A13) TO BE INSTALLED USING STANDARD MOUNT

EXISTING ROOFTOP TERRACE AREA (MAINTENANCE ONLY) @ APPROX. 20.500m AGL

EXISTING POWER & FIBRE ROUTE EXISTING TELSTRA EQUIPMENT CABINETS

EXISTING SIGNS ARE SECURED ON INSIDE MESH WALL

UNAPPROVED
DRAWING

SITE LAYOUT

SCALE 1:250

5m 0 5m 10m SCALE 1:250

NOTE: ANY GANTRY TRAY COVERS SHOWING SIGNS OF SIGNIFICANT WEAR AND TEAR SHALL BE REPLACED WITH NEW COVERS

NOTE: THIS DRAWING TO BE READ IN CONJUNCTION WITH SHEETS S1 & S1-2

COMPLIANCE BOX

COMPLETED AS PER DESIGN ☐

ALTERATIONS IN RED ☐

NAME (PRINT)

SIGNATURE

DATE

FOR CONSTRUCTION

NOTES:

- ALL EXTERNAL FEEDERS AND TAILS MUST BE BIRD PROOFED AS PER EXTERNAL PLANT POLICY 003615.
- FOR SITE SPECIFIC NOTES REFER TO SHEETS S0, S0-1 & S0-2.
- FOR EME SIGNS NOTED THUS (#X) REFER TO 005486 FOR DETAILS.
- ALL DIMENSIONS ARE IN MILLIMETRES UNLESS OTHERWISE STATED.

- PROPOSED R6678 (2 OFF) TO BE INSTALLED AT DONOR SITE LOCATION: SITE NODE (XXXX).

CYIENT

Level-14, 3 Parramatta Square, 153 Macquarie St, Parramatta, NSW 2150, Australia
T +61 2 8896 6160 | www.cyient.com

ORDER	DRWN	CHKD	AMENDMENT	EXAM	APPD	DATE	ISS
NA16165.01	MN	MN	FOR CONSTRUCTION 30053350W055ERIC LTE700	AQ	SL	08.03.16	7
NA16165.01	MBR	MBR	ASBUILT 30053350W0076 ERIC-LTE700	MBR	RV	28.09.16	8
2GD-41009-01	RS	LY	2GDECOMMISSION - 30062968W0003CYI	KSK	CF	02.08.17	9
NA18045.01	RA	TR	AS BUILT - 30069079W0049 VPL - LTE2600	AA	MK	19.02.18	10
NA21168.01	MV	RS	AS BUILT - 30084110W0141SSNC - NR3600	KSK	DG	04.09.20	11
NA29355.01	BN	RT	FOR CONSTRUCTION - 80005689W0561CYI - NR850/LTE2100	MB	MB	11.06.26	12

© Telstra Limited ACN 086 174 781 All rights reserved.



MOBILE NETWORK SITE 41009
CROWNE PLAZA

SITE LAYOUT
242 ARDEN ST, COOGEE, NSW 2034

DWG
NO.

N25414

SHT
NO.

S1-1

