

1		2			3		4		5		6	
A		DRAWING DESCRIPTION	DRAWING NUMBER	SHEET NO.	ISSUE NO.	ISSUE DATE	DRAWING STATUS					
							CANCELLED	PRELIMINARY	FOR CONSTRUCTION	AS BUILT	REFERENCE ONLY	
B		STRUCTURAL DESIGN CERTIFICATION 016159F01 PROJECT NO. NA19287.01	N27928	Z1-10	2	07/06/19						✓
		AS BUILT STRUCTURAL CERTIFICATION - 016159F02 PROJECT NO. NA19287.01	N27928	Z1-11	1	10/05/19						✓
		AS BUILT STRUCTURAL & EME COMPLIANCE CERTIFICATION 016159F04 PROJECT NO. NA19287.01	N27928	Z1-12	1	01/05/20						✓
		STRUCTURAL DESIGN CERTIFICATION 016159F01 PROJECT NO. NA22652.01	N27928	Z1-13	1	08/09/25						✓
		AS BUILT CONSTRUCTION CERTIFICATION (F02) PROJECT NO. NA22652.01	N27928	Z1-14	1	08/09/25						✓
		AS BUILT STRUCTURAL AND EME COMPLIANCE CERTIFICATION (F04) PROJECT NO. NA22652.01	N27928	Z1-15	1	08/09/25						✓
		STRUCTURAL DESIGN CERTIFICATION (F01) PROJECT NO. NA29861.01	N27928	Z1-16	1	15/06/26			✓			
C												
D		REFERENCE DRAWING:										
		STANDARD CONSTRUCTION NOTES	017866P05	1	3	10/01/23						✓
		HUT AC POWER LINE SCHEMATIC	017866P122	1	3	17/01/23						✓
		EQUIPMENT ALARM CONFIGURATION	017866P123	1	3	17/01/23						✓
		DC POWER LINE DIAGRAM - FLATPACK 2	017866P124	1	7	17/01/23						✓
		DC POWER LINE DIAGRAM - SP18	017866P124	3	4	17/01/23						✓
		DC POWER LINE DIAGRAM ICS MK3.2 SHELTER SP22-HC POWER SYSTEM	017866P124	5	3	17/01/23						✓
		MOBILE NETWORK SITE STANDARD DRAWING RBS6601 DONOR RACK LAYOUT	017866P131	9	3	23/01/23						✓
E		MOBILE NETWORK SITE STANDARD DRAWING 45 RU PATHFINDER RACK LAYOUT LTE700 - OPTION 1	017866P131	11	4	23/01/23					✓	
		RRU POWER AND EARTHING DIAGRAM	017866P134	1	7	25/01/23						✓
		RRU POWER AND EARTHING SP22-HC POWER SYSTEM & DC-DC CONVERTERS - 3 PHASE SITES	017866P134	11	4	25/01/23						✓
		ELECTRICAL SPECIFICATION	017866P160	1	5	03/02/23						✓
		EARTHING STD - GALV. STEEL BASED SYS	017866P201	1	3	29/03/23						✓
		FEEDER EARTHING DETAILS	017866P201	11	3	29/03/23						✓
		EARTHING STD - RRU FEEDER DETAIL	017866P201	12	5	29/03/23						✓
		EARTHING STD - INTERNAL EARTHING SET	017866P201	13	5	29/03/23						✓
F		FEEDER EARTH BAR DETAILS	017866P201	18	2	29/03/23					✓	
		STANDARD ROCLA COMMUNICATIONS POLE	SR2	1	B	21/02/14					✓	
		RRU/CWDM MOUNTS FOR 6xRRUS ON POLES GENERAL ARRANGEMENT & DETAILS	CF-12565	1	1	14/11/12						✓
		POST CONSTRUCTION BUILD VALIDATION REPORT	N27928	P2	1	12/09/13						✓
1		2			3		4		5		6	



BLACKBUTT RESERVOIR

NODE MANAGER ADDRESS ID: 232974

ADDRESS: 75 PIONEER DR
BLACKBUTT
NSW 2529



Level-14, 3 Parramatta Square, 153 Macquarie St, Parramatta, NSW 2150, Australia
T +61 2 8896 6160 | www.cyient.com

UNAPPROVED
DRAWING

ORDER	DRWN	CHKD	AMENDMENT	EXAM	APPD	DATE	ISS
NA15979.01	AK	LY	AS BUILT - 30053394W0008VPL - LTE700	AK	MK	02.12.15	4
NA19287.01	DJ	MS	FOR CONSTRUCTION - 30077714W0061KOR - LTE2100 / LTE2600	JG	DB	04.03.19	5
NA19287.01	AB	AD	AS BUILT - 30077714W0092KOR - LTE2100 / LTE2600	CF	CF	19.03.19	6
NA22652.01	SP	GM	FOR CONSTRUCTION - 30088461W0125CYI - NR850/NR3600	MB	MB	07.01.21	7
NA22652.01	CU	SK	AS BUILT - 30088461W0178CYI - NR850/NR3600	KSK	DG	13.08.21	8
NA29861.01	JH	RT	FOR CONSTRUCTION - 80005689W0730CYI - LTE850/NR2600	MB	MB	15.06.26	9



MOBILE NETWORK SITE 232974 BLACKBUTT RESERVOIR

DRAWING INDEX AND DOCUMENT CONTROL - SHEET 2 OF 2
75 PIONEER DR, BLACKBUTT, NSW 2529

DWG NO.

N27928

SHT NO.

DC-2



12

3

4

5

6

A3

A

B

C

D

F

DO NOT
SCALE

F

--	--

15

A

B

C


D

F

F

NOTE: THIS DRAWING TO BE READ IN CONJUNCTION WITH SHEETS S0-2 & S0-3

FOR CONSTRUCTION

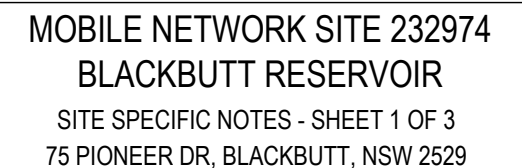

CYIENT

Level-14, 3 Parramatta Square, 153 Macquarie St, Parramatta, NSW 2150, Australia
T +61 2 8896 6160 | www.cyient.com

© Telstra Limited ACN 086 174 781 All rights reserved.

1

2

3

4

5

6

A

EQUIPMENT NOTES - PROJECT NO. NA29861.01

ITEM	EQUIPMENT	EQUIPMENT DETAILS	EXISTING	PROPOSED	TOTAL	REFERENCE DWG
31	5G AUGMENTATION BOX	200 x 150 x 400mm (W,D,H)	1	-1	0	SHEET E1-1
32	RFS RRU INTERFACE JUNCTION BOXES	-	3	-3	0	SHEETS S1-1 & S3
33	W&B RRU INTERFACE JUNCTION BOXES	TC4039MOBILE08	0	3	3	SHEETS S1-1 & S3
34	ERICSSON RADIO 4415 (B7)	342 (W) x 149 (D) x 420mm (H) NATURAL COLOUR	3	-3	0	SHEETS S1-1 & S3
35	ERICSSON RADIO 2212 (B5)	342 x 160 x 420mm (W,D,H) NATURAL COLOUR	3	-3	0	SHEETS E1-1 & E5
36	ERICSSON RADIO 4485 (B3/B1/B7) (LTE1800/LTE2100/NR/LTE2600)	398 x 145 x 533mm (W,D,H) NATURAL COLOUR	0	3	3	SHEETS S1-1 & S3
37	ERICSSON RADIO 4480 (B1/B3)	400 x 145 x 550mm (W,D,H) NATURAL COLOUR	3	-3	0	SHEETS S1-1 & S3
38	ERICSSON RADIO 4490HP (B28/B26) (LTE700/LTE850/NR850)	397 x 165 x 522mm (W,D,H) NATURAL COLOUR	0	3	3	SHEETS E1-1 & E5
39	KAELUS TWIN BANDSTOP FILTER	BSF0020F1V12	3	-3	0	SHEETS E1-1 & E5
40	TRIASX DUAL DUPLEX FILTER	DDF0022F1V1	6	6 (SPARE)	6	SHEET E1-1
41	KAELUS QUAD FILTERS (LTE700/LTE850/NR850)	KA-6035	0	3	3	SHEETS E1-1 & E5
42	KAELUS TWIN COMBINER	DBC0086F1V1-1 INSTALLED IN 45RU PATHFINDER RACK	3	3 (SPARE)	3	SHEETS E1-1 & E5
43	KAELUS TMA (LTE700/LTE850/NR850)	KA-1031 TMA	0	6	6	SHEETS S1-1 & S3
44	KAELUS TMA	TMA2158F01V2-1E TWIN TMA	3	-3	0	SHEETS S1-1 & S3
45	RFS LCF78-50JA	40m LENGTH	12	0	12	SHEETS S1 & S3
46	RFS HYBRIFLEX 7/8" 8P16F	60m LENGTH	3	-3	0	SHEETS S1 & S3
47	W&B HYBRID CABLE 7/8"	50m LENGTH	0	3	3	SHEETS S1 & S3
48	GPS SPLITTER	INSTALLED IN PATHFINDER RACK GD/103/2	1	1 (SPARE)	1	SHEETS E1-1 & E5
49	GPS RECEIVER	INSTALLED IN PATHFINDER RACK GD/103/2	1	-1	0	SHEETS E1-1 & E5
50	GPS RECEIVER UNIT	ERICSSION GRU 05 01 RECEIVER NCD90189/1	0	1	1	SHEETS E1-1 & E5
51	GPS ANTENNA (LTE)	GPS KRE 101 2082 1 OMNI	1	-1	0	SHEETS S1 & S3
52	KAELUS, DUAL BAND GNSS GPS ACTIVE ANT	KA-7005-1110	0	1	1	SHEETS S1 & S3
53	RF JUMPER 1_5M N F TO SMA M	TSR951339/1500	0	1	1	-
54	GPS WBT TOD CABLE	WBT R6000 TOD CABLE - 3M	0	1	1	-
55	GPS SYNC CABLE	RPM1136127/2000	0	1	1	-
56	AIRWEL AIR CONDITIONER	WALL MOUNTED RAC TYPE	1	1 (SPARE)	1	-
57	LENMIC AIR CONDITIONER	L600P2 WALL MOUNTED RAC TYPE	1	0	1	-
58	L350A FAN UNIT	-	1	0	1	-
59	COOLING FAN FILTER	-	1	-1	0	-
60	COOLING FAN FILTER	VAK0005	0	1	1	-
61	PLC	MITSUBISHI AL2-14MR-D	1	0	1	SHEET E1

D

E

UNAPPROVED
DRAWING

COMPLIANCE BOX

COMPLETED AS PER DESIGN

ALTERATIONS IN RED

NAME (PRINT)

SIGNATURE

DATE

DO NOT
SCALE

DIMS
IN

NOTE: THIS DRAWING TO BE READ IN CONJUNCTION WITH SHEETS S0-1 & S0-2

CYIENT

Level-14, 3 Parramatta Square, 153 Macquarie St,
Parramatta, NSW 2150, Australia
T +61 2 8896 6160 | www.cyient.com

ORDER	DRWN	CHKD	AMENDMENT	EXAM	APPD	DATE	ISS
NA19287.01	DJ	MS	FOR CONSTRUCTION - 30077714WO061KOR - LTE2100 / LTE2600	JG	DB	04.03.19	1
NA19287.01	MS	AD	AS BUILT - 30077714WO092KOR - LTE2100 / LTE2600	CF	CF	19.03.19	2
NA22652.01	SP	GM	FOR CONSTRUCTION - 30088461W0125CYI - NR850/NR3600	MB	MB	07.01.21	3
NA22652.01	CU	SK	AS BUILT - 30088461W0178CYI - NR850/NR3600	KSK	DG	13.08.21	4
NA29861.01	JH	RT	FOR CONSTRUCTION - 80005689W0730CYI - LTE850/NR2600	MB	MB	15.06.26	5

Telstra

MOBILE NETWORK SITE 232974
BLACKBUTT RESERVOIR

SITE SPECIFIC NOTES - SHEET 3 OF 3
75 PIONEER DR, BLACKBUTT, NSW 2529

DWG
NO.

N27928

SHT
NO.

S0-3

1

2


3


4

5

6

A3V

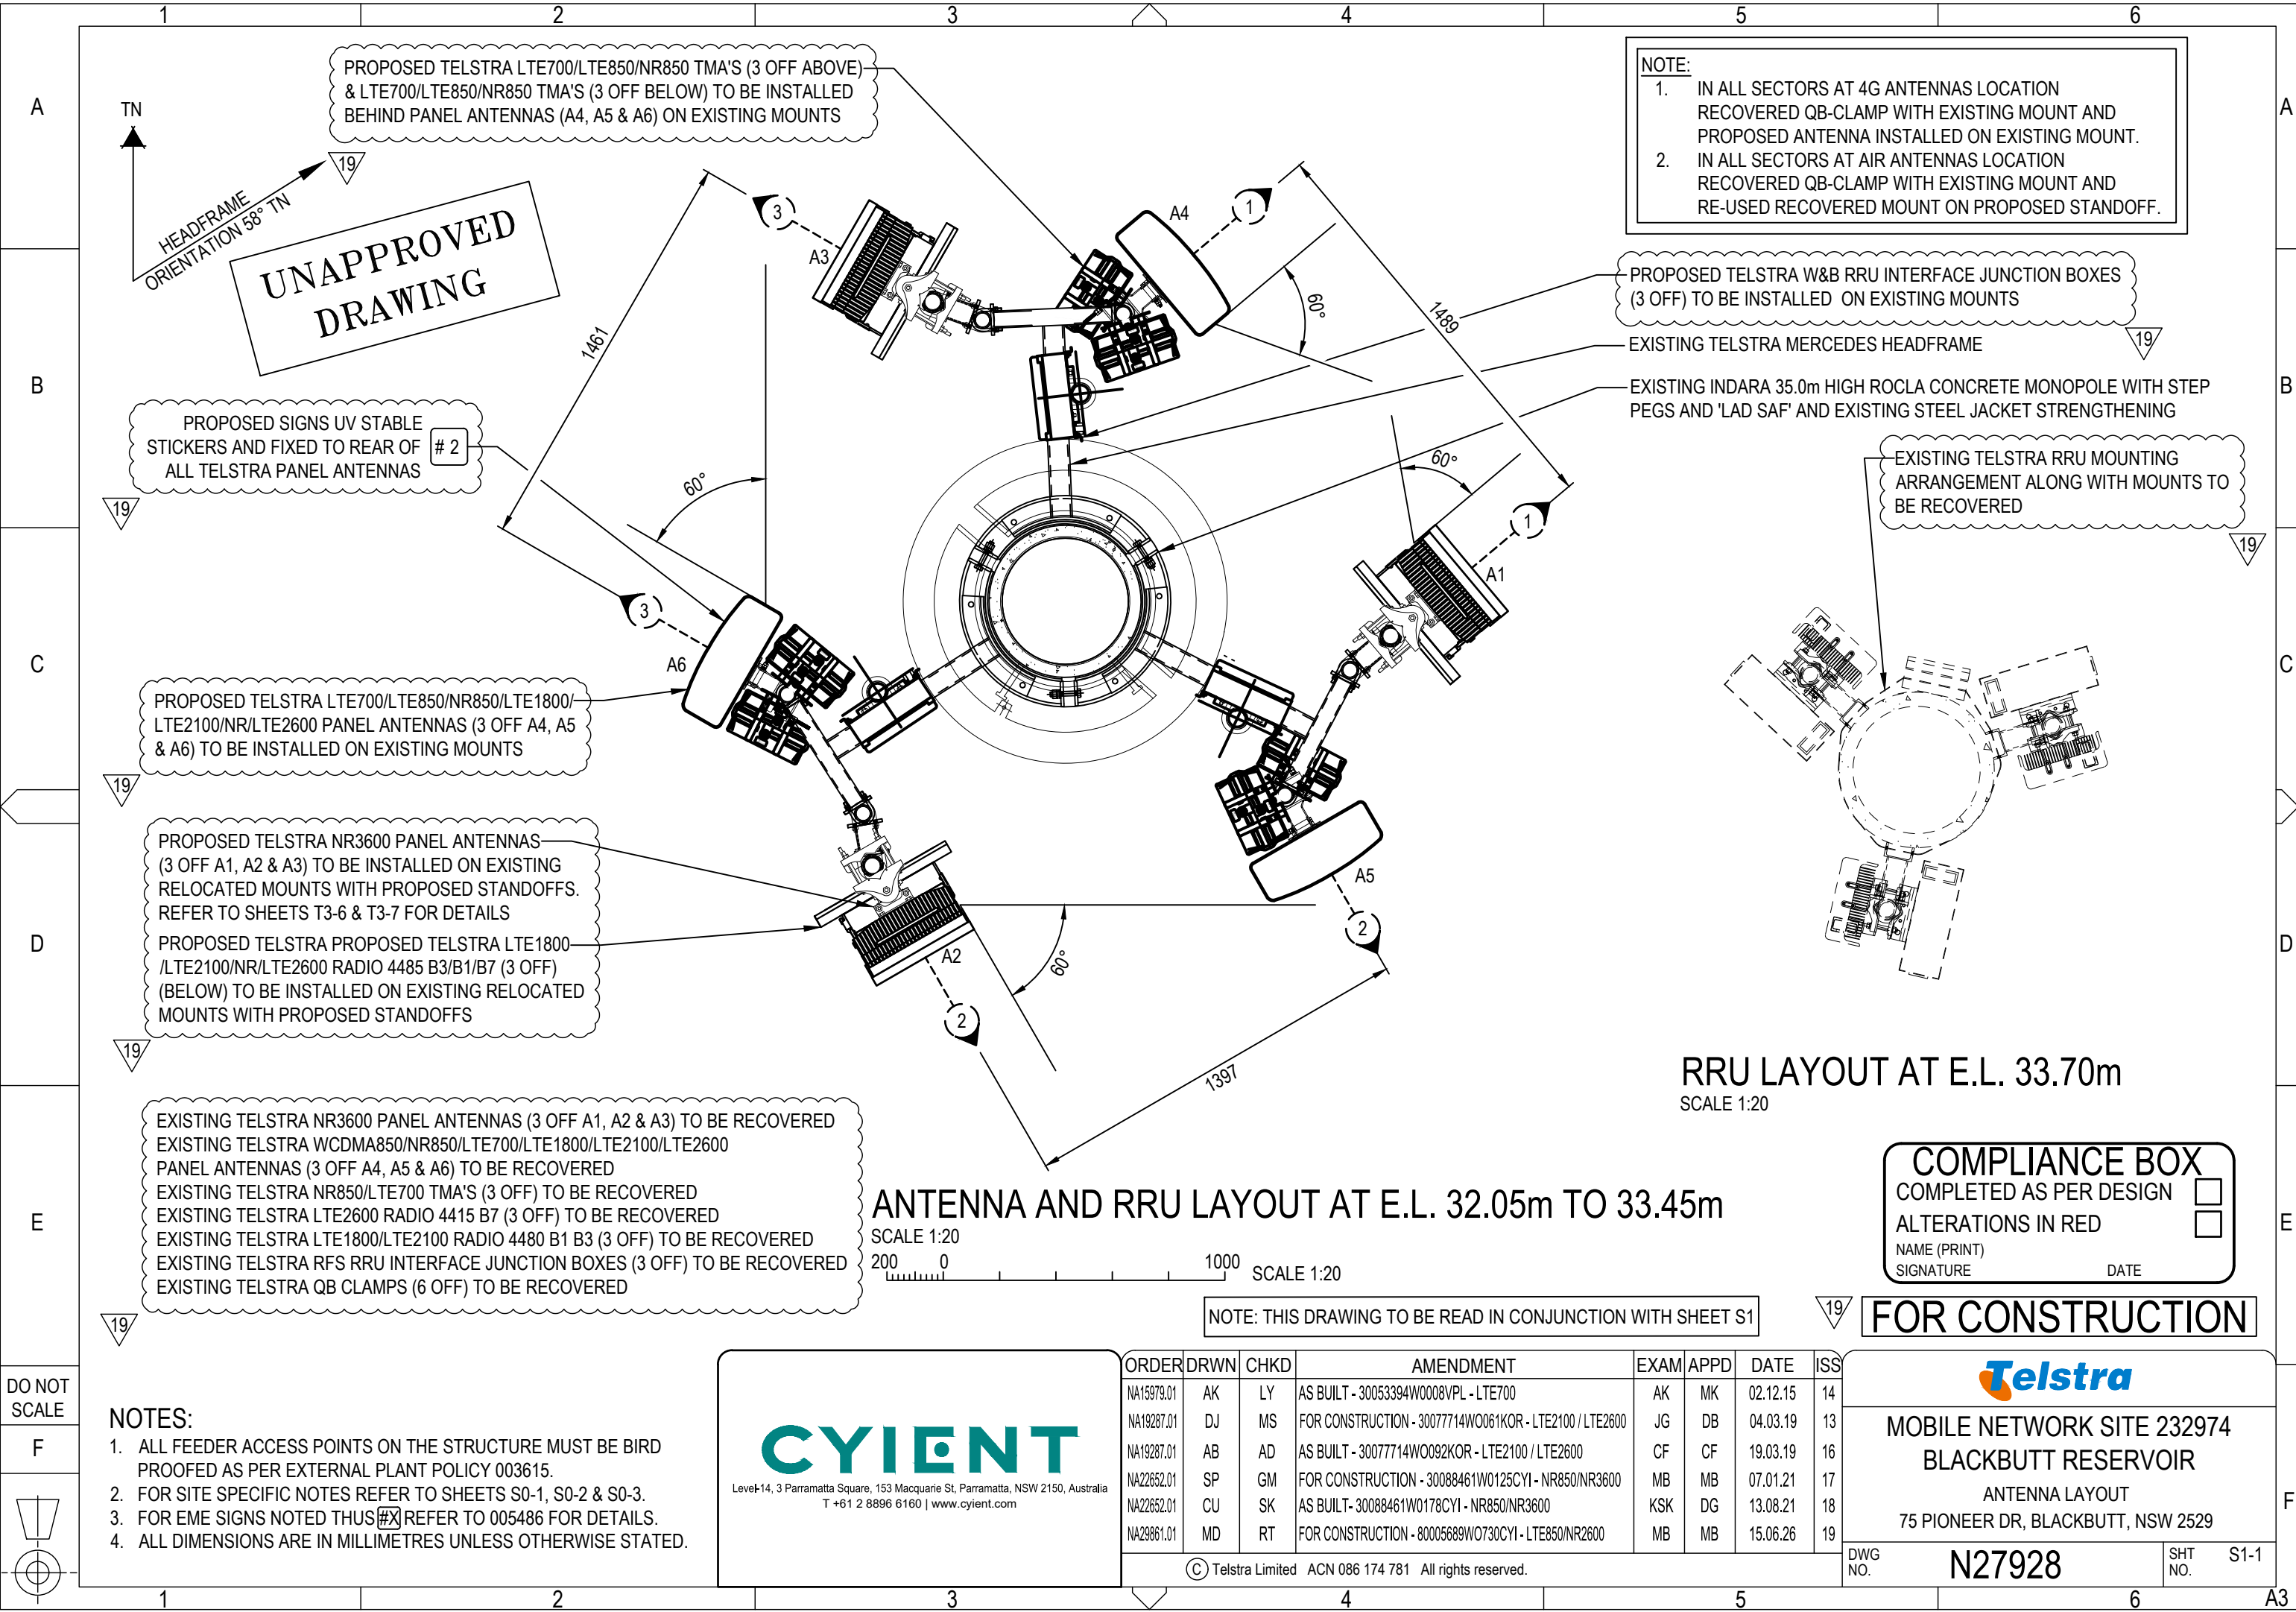

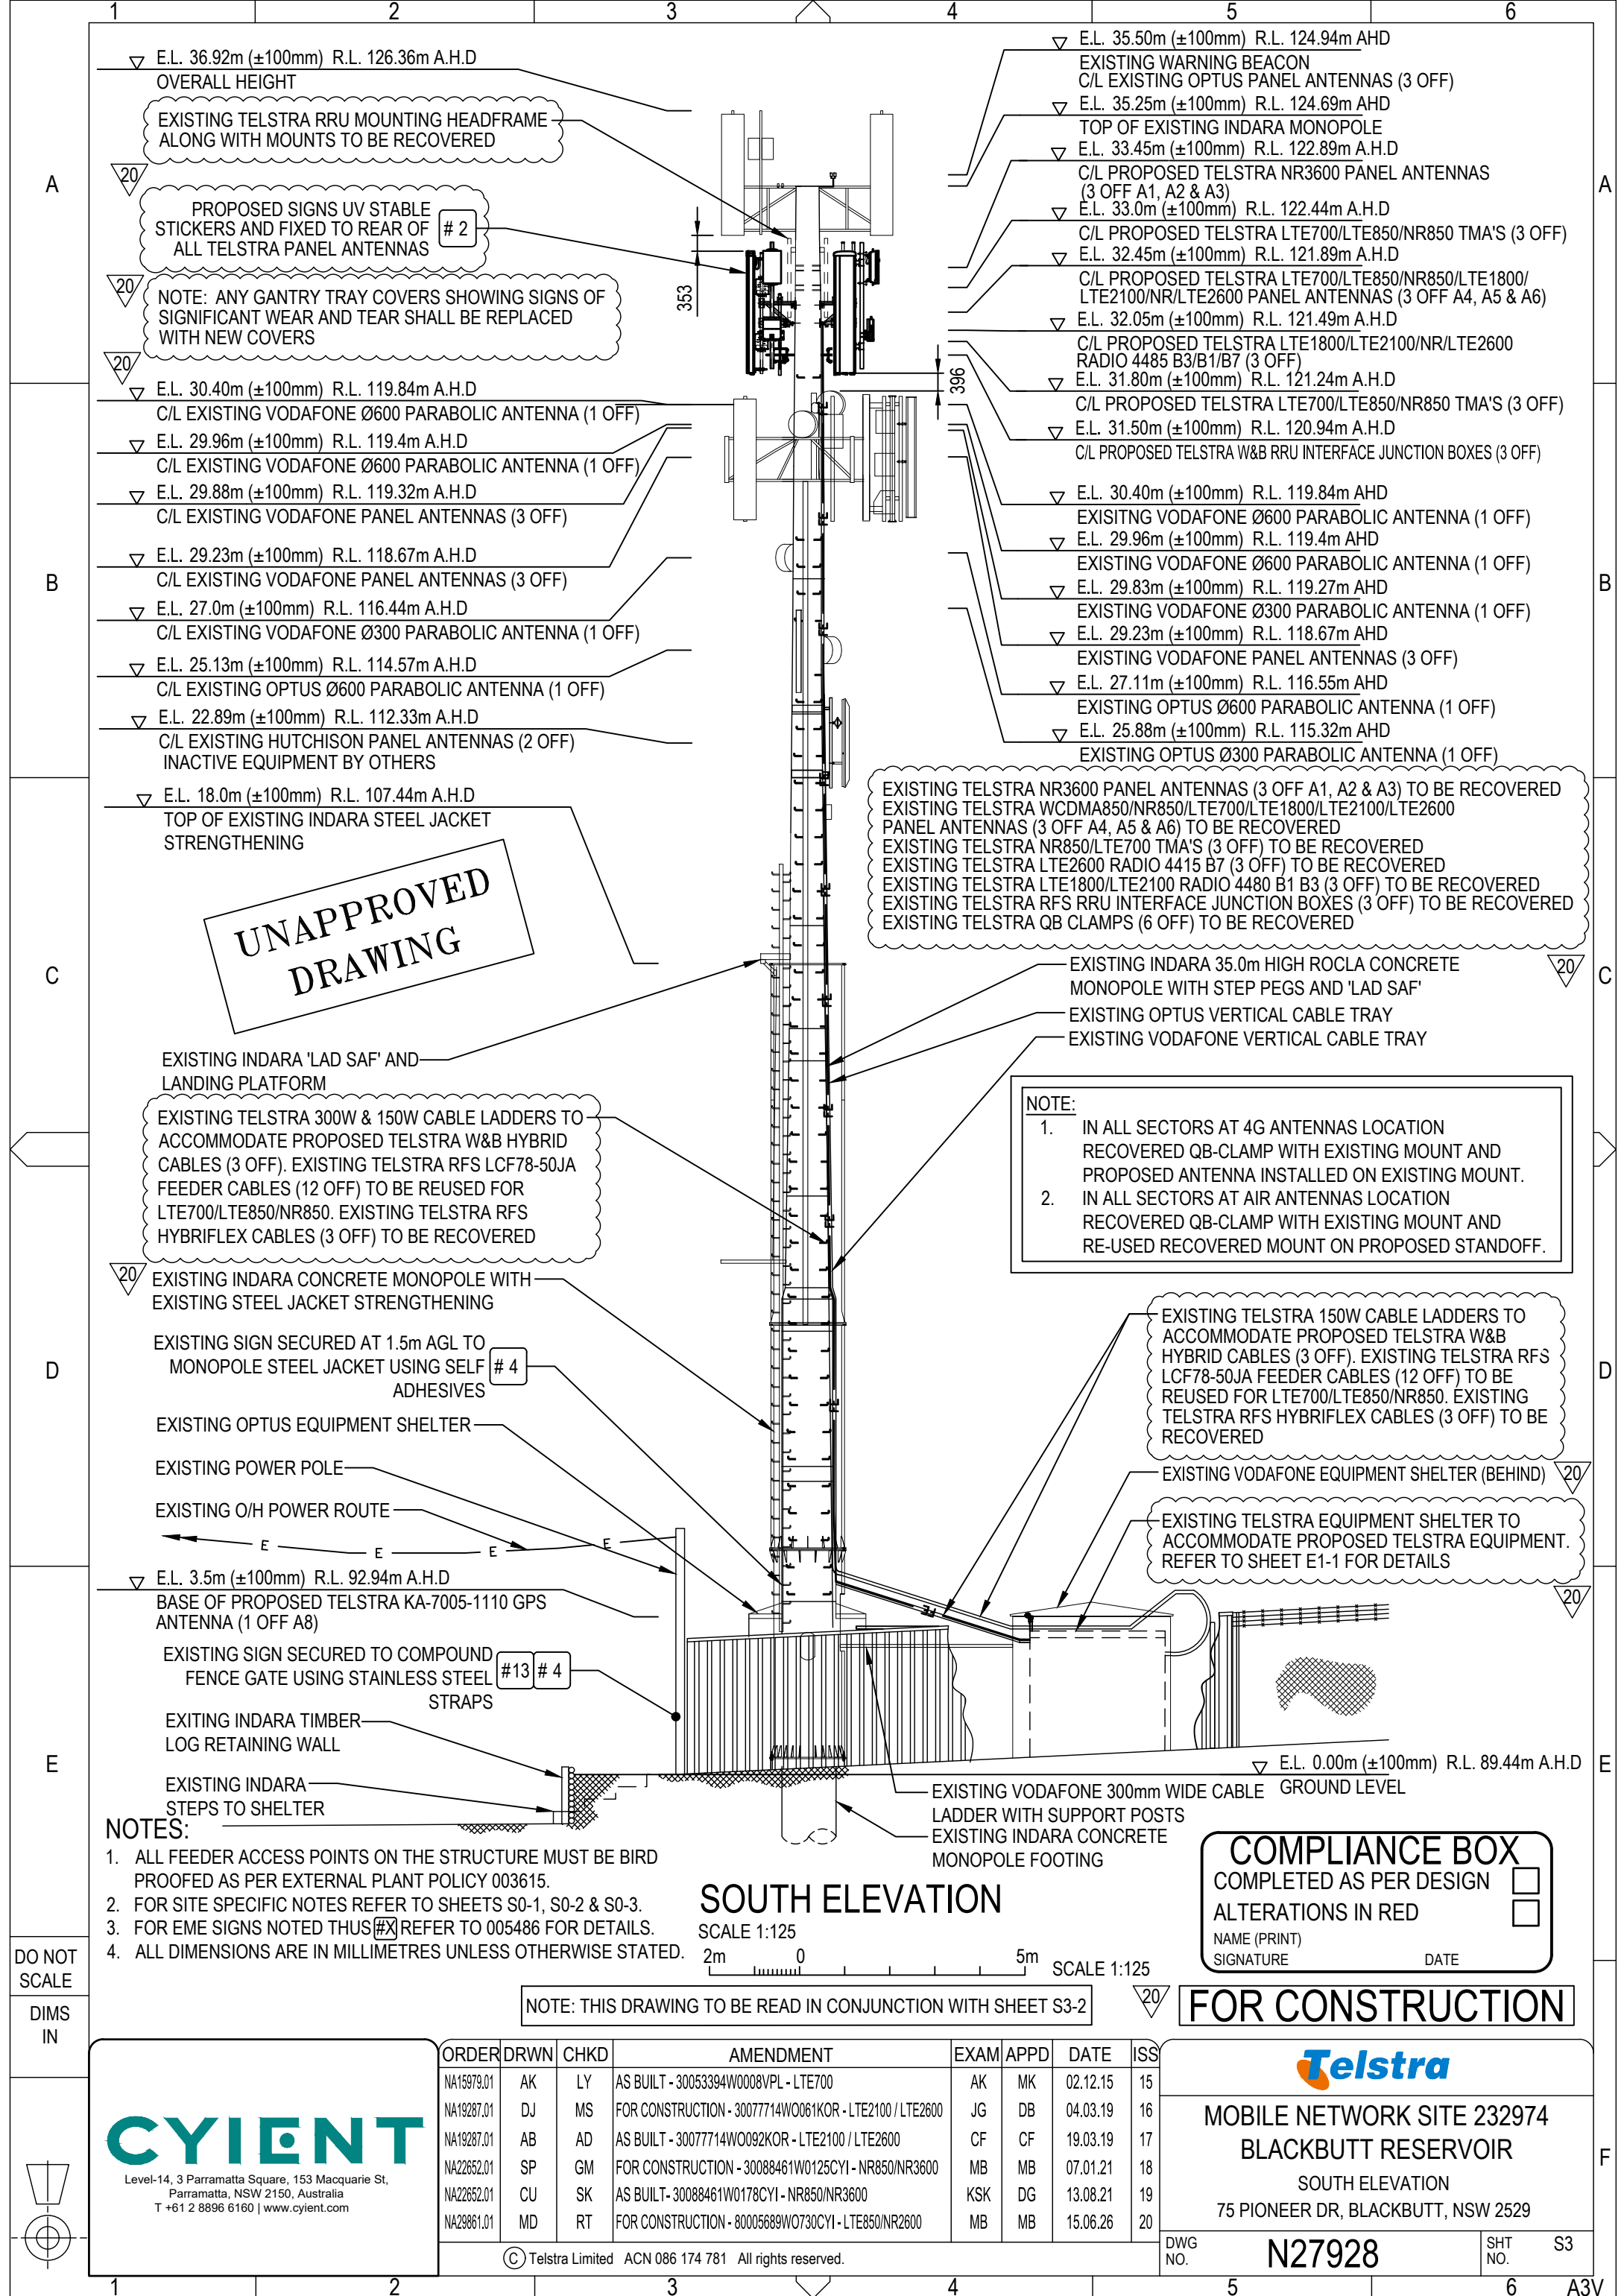

TELSTRA MOBILES ANTENNA CONFIGURATION TABLE

ANTENNA No	ANTENNA TYPE & SIZE H x W x D (mm)	ANTENNA ACTION REQUIRED	ANTENNA HEIGHT C/L A.G.L.	PHYSICAL ANTENNA BEARING (°T)	SECTOR NO. & TECHNOLOGY
A1	ERICSSON AIR3258 PANEL 720 x 400 x 200 (mm)	INSTALL	33.45m	50°	S1: NR3600 S1: NR3600
A2	ERICSSON AIR3258 PANEL 720 x 400 x 200 (mm)	INSTALL	33.45m	150°	S2: NR3600 S2: NR3600
A3	ERICSSON AIR3258 PANEL 720 x 400 x 200 (mm)	INSTALL	33.45m	300°	S3: NR3600 S3: NR3600
A4	KAELUS F6RHEU01 PANEL 2705 x 470 x 178 (mm)	INSTALL	32.45m	50°	S1: LTE700/LTE850/NR850 S1: LTE700/LTE850/NR850
					S1: LTE700/LTE850/NR850 S1: LTE700/LTE850/NR850
					S1: LTE1800/LTE2100/NR/LTE2600 S1: LTE1800/LTE2100/NR/LTE2600
					S1: LTE1800/LTE2100/NR/LTE2600 S1: LTE1800/LTE2100/NR/LTE2600
A5	KAELUS F6RHEU01 PANEL 2705 x 470 x 178 (mm)	INSTALL	32.45m	150°	S2: LTE700/LTE850/NR850 S2: LTE700/LTE850/NR850
					S2: LTE700/LTE850/NR850 S2: LTE700/LTE850/NR850
					S2: LTE1800/LTE2100/NR/LTE2600 S2: LTE1800/LTE2100/NR/LTE2600
					S2: LTE1800/LTE2100/NR/LTE2600 S2: LTE1800/LTE2100/NR/LTE2600
A6	KAELUS F6RHEU01 PANEL 2705 x 470 x 178 (mm)	INSTALL	32.45m	300°	S3: LTE700/LTE850/NR850 S3: LTE700/LTE850/NR850
					S3: LTE700/LTE850/NR850 S3: LTE700/LTE850/NR850
					S3: LTE1800/LTE2100/NR/LTE2600 S3: LTE1800/LTE2100/NR/LTE2600
					S3: LTE1800/LTE2100/NR/LTE2600 S3: LTE1800/LTE2100/NR/LTE2600

TELSTRA MOBILES ANTENNA CONFIGURATION TABLE

ANTENNA No	ANTENNA TYPE & SIZE H x DIA (mm)	ANTENNA ACTION REQUIRED	ANTENNA HEIGHT B/O A.G.L.	PHYSICAL ANTENNA BEARING (°T)	SECTOR NO. & TECHNOLOGY
A1 (OLD)	ERICSSON AIR6488 PANEL	REMOVE	32.65m	50°	-
A2 (OLD)	ERICSSON AIR6488 PANEL	REMOVE	32.65m	150°	-
A3 (OLD)	ERICSSON AIR6488 PANEL	REMOVE	32.65m	300°	-
A4 (OLD)	TONGYU T2004L6R021 PANEL	REMOVE	32.65m	50°	-
A5 (OLD)	TONGYU T2004L6R021 PANEL	REMOVE	32.65m	150°	-
A6 (OLD)	TONGYU T2004L6R021 PANEL	REMOVE	32.65m	300°	-

TELSTRA MOBILES ANTENNA CONFIGURATION TABLE

ANTENNA No	ANTENNA TYPE & SIZE H x DIA (mm)	ANTENNA ACTION REQUIRED	ANTENNA HEIGHT B/O A.G.L.	PHYSICAL ANTENNA BEARING (°T)	SECTOR NO. & TECHNOLOGY
A8 (OLD)	ERICSSON GPS KRE 101 2082 1 OMNI	REMOVE	3.5m	0°	-
A8	KAELUS KA-7005-1110 GPS ACTIVE ANTENNA	INSTALL	3.5m	0°	-

UNAPPROVED
DRAWING

COMPLIANCE BOX

COMPLETED AS PER DESIGN

ALTERATIONS IN RED

NAME (PRINT)

SIGNATURE

DATE

FOR CONSTRUCTION

NOTE: THIS DRAWING TO BE READ IN CONJUNCTION WITH SHEET S3

CYIENT

Level-14, 3 Parramatta Square, 153 Macquarie St, Parramatta, NSW 2150, Australia
T +61 2 8896 6160 | www.cyient.com

ORDER	DRWN	CHKD	AMENDMENT	EXAM	APPD	DATE	ISS
NA15979.01	AK	LY	AS BUILT - 30053394W0008VPL - LTE700	AK	MK	02.12.15	5
NA19287.01	DJ	MS	FOR CONSTRUCTION - 30077714W0061KOR - LTE2100 / LTE2600	JG	DB	04.03.19	6
NA19287.01	AB	AD	AS BUILT - 30077714W0092KOR - LTE2100 / LTE2600	CF	CF	19.03.19	7
NA22652.01	SP	GM	FOR CONSTRUCTION - 30088461W0125CYI - NR850/NR3600	MB	MB	07.01.21	8
NA22652.01	CU	SK	AS BUILT - 30088461W0178CYI - NR850/NR3600	KSK	DG	13.08.21	9
NA29861.01	MD	RT	FOR CONSTRUCTION - 80005689W0730CYI - LTE850/NR2600	MB	MB	15.06.26	10

© Telstra Limited ACN 086 174 781 All rights reserved.



MOBILE NETWORK SITE 232974
BLACKBUTT RESERVOIR
ANTENNA CONFIGURATION TABLE - SHEET 1
75 PIONEER DR, BLACKBUTT, NSW 2529

DWG NO.

N27928


SHT NO.

S3-2

DO NOT
SCALE

F



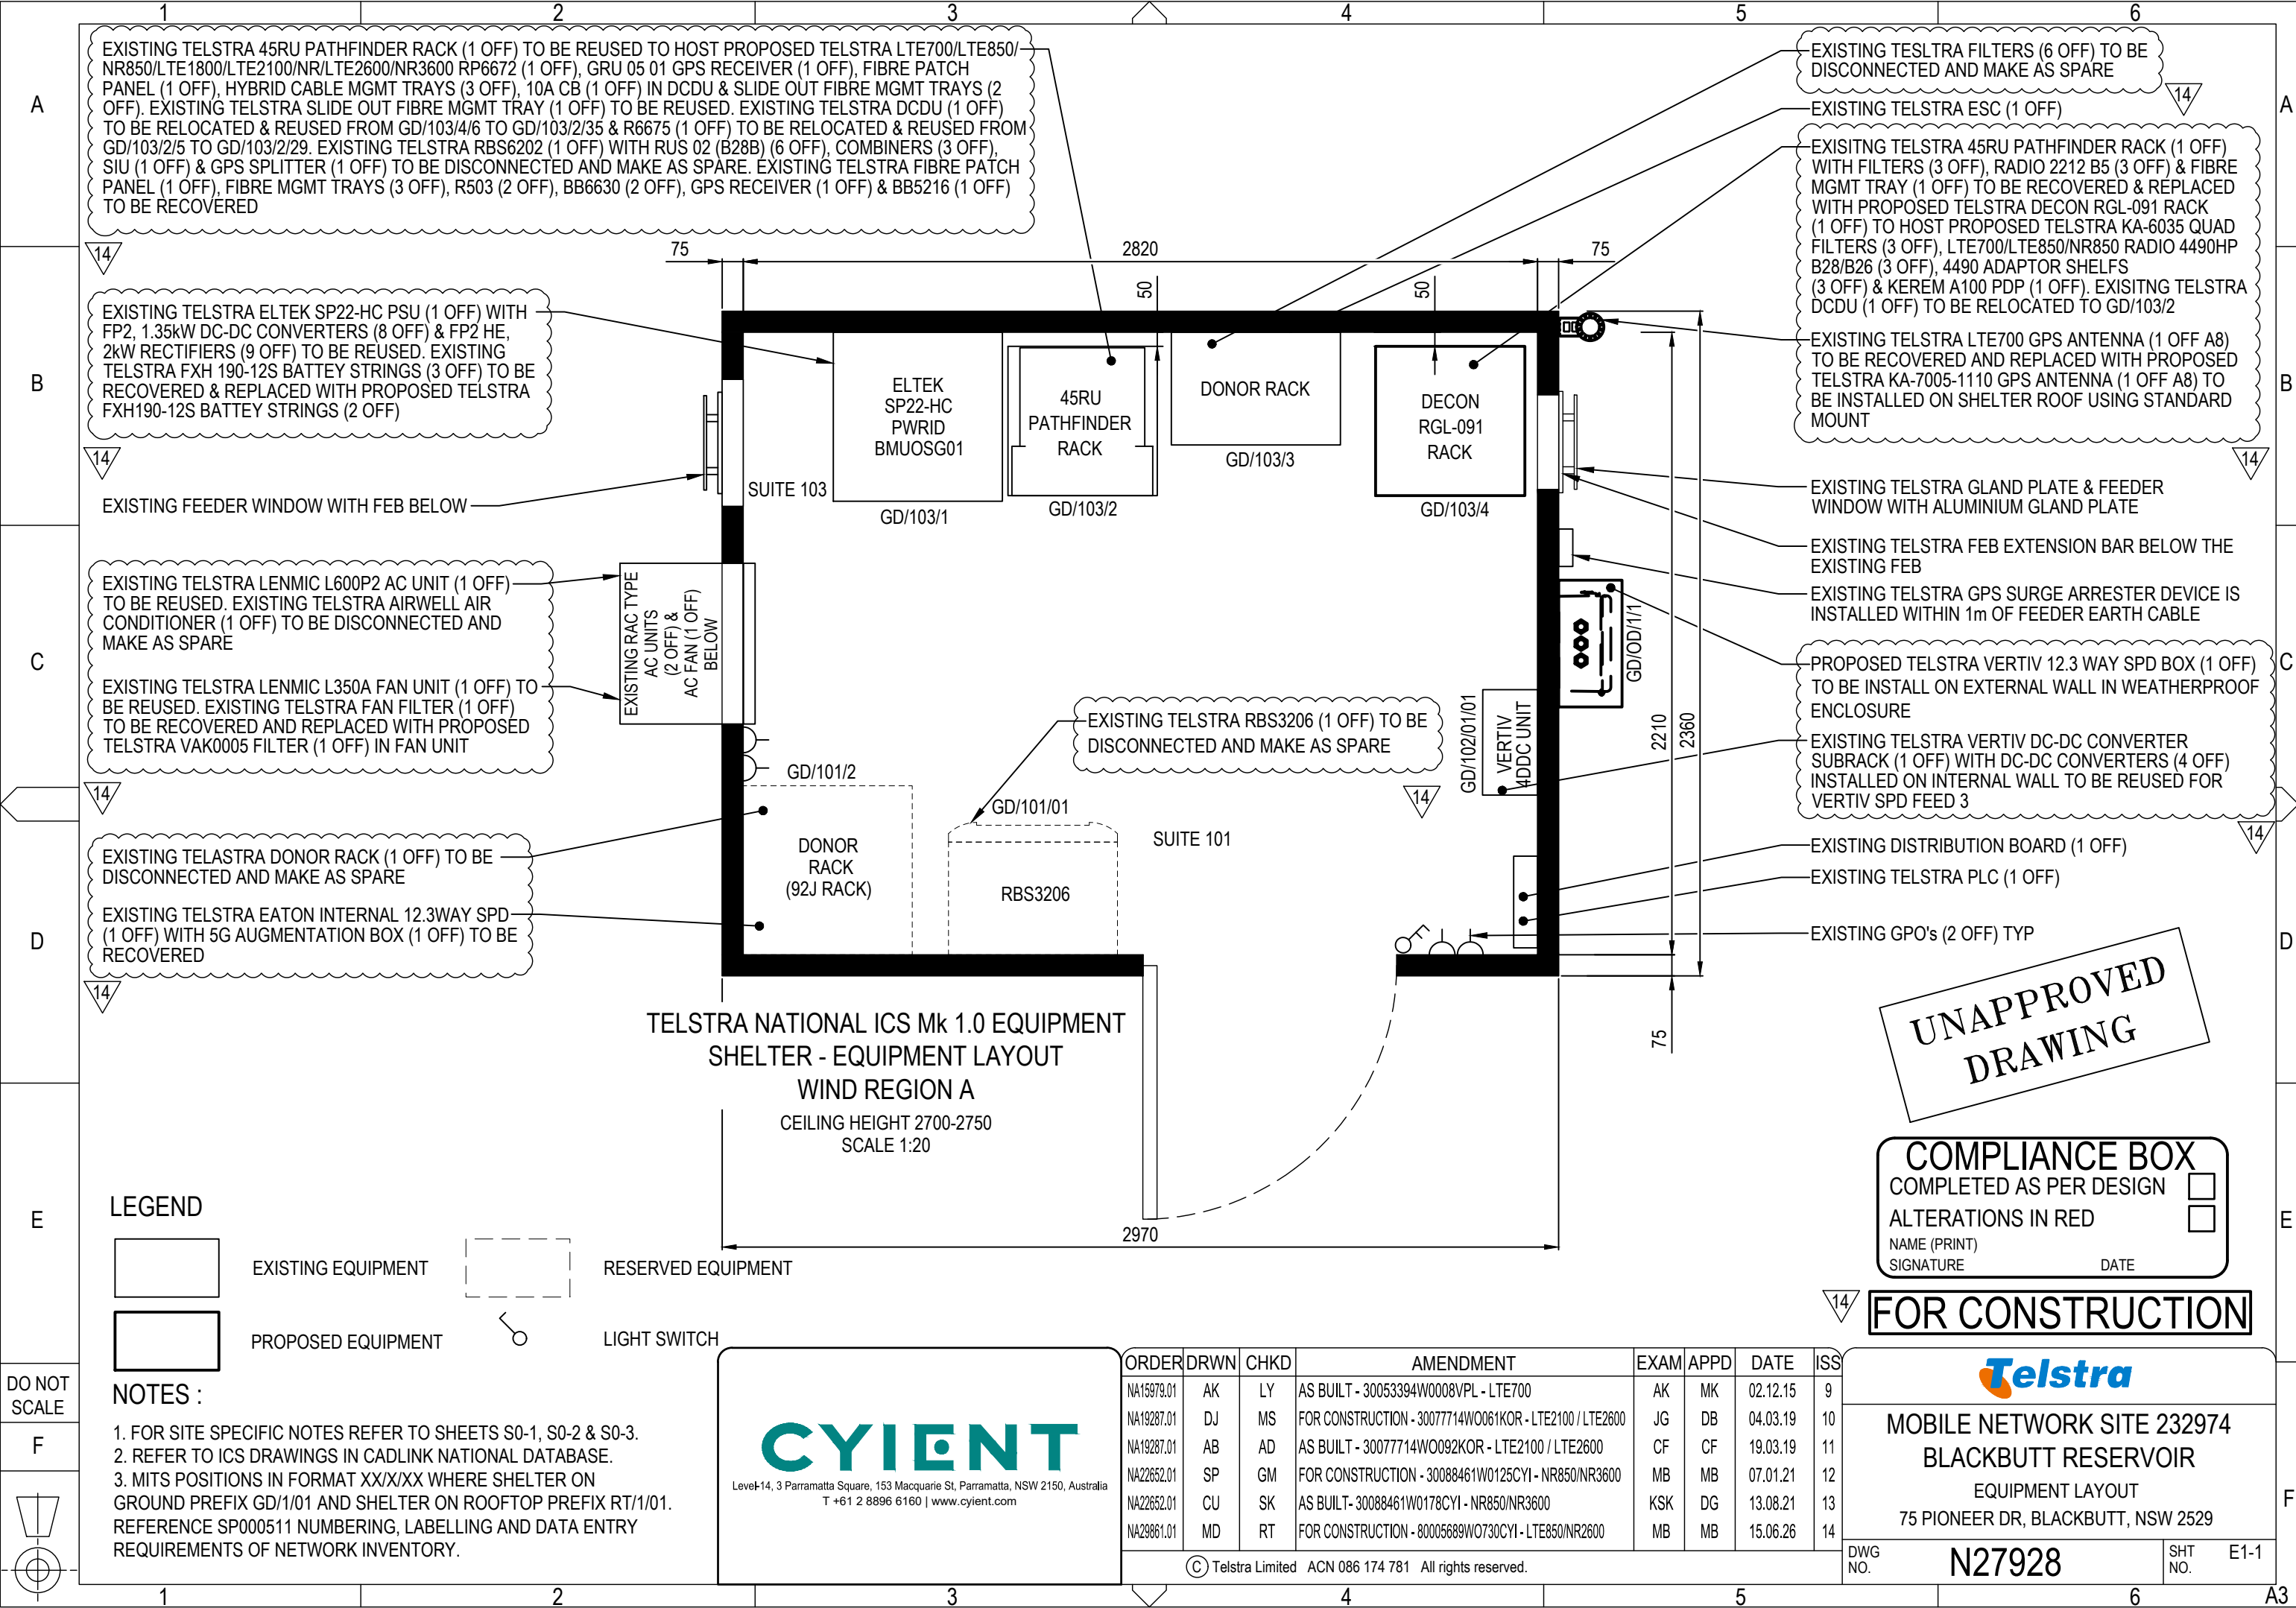

EXISTING TELSTRA 45RU PATHFINDER RACK (1 OFF) TO BE REUSED TO HOST PROPOSED TELSTRA LTE700/LTE850/ NR850/LTE1800/LTE2100/NR/LTE2600/NR3600 RP6672 (1 OFF), GRU 05 01 GPS RECEIVER (1 OFF), FIBRE PATCH PANEL (1 OFF), HYBRID CABLE MGMT TRAYS (3 OFF), 10A CB (1 OFF) IN DCDU & SLIDE OUT FIBRE MGMT TRAYS (2 OFF). EXISTING TELSTRA SLIDE OUT FIBRE MGMT TRAY (1 OFF) TO BE REUSED. EXISTING TELSTRA DCDU (1 OFF) TO BE RELOCATED & REUSED FROM GD/103/4/6 TO GD/103/2/35 & R6675 (1 OFF) TO BE RELOCATED & REUSED FROM GD/103/2/5 TO GD/103/2/29. EXISTING TELSTRA RBS6202 (1 OFF) WITH RUS 02 (B28B) (6 OFF), COMBINERS (3 OFF), SIU (1 OFF) & GPS SPLITTER (1 OFF) TO BE DISCONNECTED AND MAKE AS SPARE. EXISTING TELSTRA FIBRE PATCH PANEL (1 OFF), FIBRE MGMT TRAYS (3 OFF), R503 (2 OFF), BB6630 (2 OFF), GPS RECEIVER (1 OFF) & BB5216 (1 OFF) TO BE RECOVERED

EXISTING TELSTRA ELTEK SP22-HC PSU (1 OFF) WITH FP2, 1.35kW DC-DC CONVERTERS (8 OFF) & FP2 HE, 2kW RECTIFIERS (9 OFF) TO BE REUSED. EXISTING TELSTRA FXH 190-12S BATTEY STRINGS (3 OFF) TO BE RECOVERED & REPLACED WITH PROPOSED TELSTRA FXH190-12S BATTEY STRINGS (2 OFF)

EXISTING TELSTRA LENMIC L600P2 AC UNIT (1 OFF) TO BE REUSED. EXISTING TELSTRA AIRWELL AIR CONDITIONER (1 OFF) TO BE DISCONNECTED AND MAKE AS SPARE
EXISTING TELSTRA LENMIC L350A FAN UNIT (1 OFF) TO BE REUSED. EXISTING TELSTRA FAN FILTER (1 OFF) TO BE RECOVERED AND REPLACED WITH PROPOSED TELSTRA VAK0005 FILTER (1 OFF) IN FAN UNIT

EXISTING TELSTRA DONOR RACK (1 OFF) TO BE DISCONNECTED AND MAKE AS SPARE
EXISTING TELSTRA EATON INTERNAL 12.3WAY SPD (1 OFF) WITH 5G AUGMENTATION BOX (1 OFF) TO BE RECOVERED

EXISTING TESLTRA FILTERS (6 OFF) TO BE DISCONNECTED AND MAKE AS SPARE
EXISTING TELSTRA ESC (1 OFF)
EXISTING TELSTRA 45RU PATHFINDER RACK (1 OFF) WITH FILTERS (3 OFF), RADIO 2212 B5 (3 OFF) & FIBRE MGMT TRAY (1 OFF) TO BE RECOVERED & REPLACED WITH PROPOSED TELSTRA DECON RGL-091 RACK (1 OFF) TO HOST PROPOSED TELSTRA KA-6035 QUAD FILTERS (3 OFF), LTE700/LTE850/NR850 RADIO 4490HP B28/B26 (3 OFF), 4490 ADAPTOR SHELF (3 OFF) & KEREM A100 PDP (1 OFF). EXISTING TELSTRA DCDU (1 OFF) TO BE RELOCATED TO GD/103/2
EXISTING TELSTRA LTE700 GPS ANTENNA (1 OFF A8) TO BE RECOVERED AND REPLACED WITH PROPOSED TELSTRA KA-7005-1110 GPS ANTENNA (1 OFF A8) TO BE INSTALLED ON SHELTER ROOF USING STANDARD MOUNT

EXISTING TELSTRA GLAND PLATE & FEEDER WINDOW WITH ALUMINIUM GLAND PLATE
EXISTING TELSTRA FEB EXTENSION BAR BELOW THE EXISTING FEB
EXISTING TELSTRA GPS SURGE ARRESTER DEVICE IS INSTALLED WITHIN 1m OF FEEDER EARTH CABLE
PROPOSED TELSTRA VERTIV 12.3 WAY SPD BOX (1 OFF) TO BE INSTALL ON EXTERNAL WALL IN WEATHERPROOF ENCLOSURE
EXISTING TELSTRA VERTIV DC-DC CONVERTER SUBRACK (1 OFF) WITH DC-DC CONVERTERS (4 OFF) INSTALLED ON INTERNAL WALL TO BE REUSED FOR VERTIV SPD FEED 3


EXISTING DISTRIBUTION BOARD (1 OFF)
EXISTING TELSTRA PLC (1 OFF)
EXISTING GPO's (2 OFF) TYP

UNAPPROVED
DRAWING

COMPLIANCE BOX
COMPLETED AS PER DESIGN ☐
ALTERATIONS IN RED ☐
NAME (PRINT) _____
SIGNATURE _____ DATE _____

FOR CONSTRUCTION

LEGEND

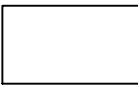

EXISTING EQUIPMENT



RESERVED EQUIPMENT



PROPOSED EQUIPMENT



LIGHT SWITCH

NOTES :

- FOR SITE SPECIFIC NOTES REFER TO SHEETS S0-1, S0-2 & S0-3.
- REFER TO ICS DRAWINGS IN CADLINK NATIONAL DATABASE.
- MITS POSITIONS IN FORMAT XX/X/XX WHERE SHELTER ON GROUND PREFIX GD/1/01 AND SHELTER ON ROOFTOP PREFIX RT/1/01. REFERENCE SP000511 NUMBERING, LABELLING AND DATA ENTRY REQUIREMENTS OF NETWORK INVENTORY.

CYIENT

Level 14, 3 Parramatta Square, 153 Macquarie St, Parramatta, NSW 2150, Australia
T +61 2 8896 6160 | www.cyient.com

ORDER	DRWN	CHKD	AMENDMENT	EXAM	APPD	DATE	ISS
NA15979.01	AK	LY	AS BUILT - 30053394W0008VPL - LTE700	AK	MK	02.12.15	9
NA19287.01	DJ	MS	FOR CONSTRUCTION - 30077714W0061KOR - LTE2100 / LTE2600	JG	DB	04.03.19	10
NA19287.01	AB	AD	AS BUILT - 30077714W0092KOR - LTE2100 / LTE2600	CF	CF	19.03.19	11
NA22652.01	SP	GM	FOR CONSTRUCTION - 30088461W0125CYI - NR850/NR3600	MB	MB	07.01.21	12
NA22652.01	CU	SK	AS BUILT - 30088461W0178CYI - NR850/NR3600	KSK	DG	13.08.21	13
NA29861.01	MD	RT	FOR CONSTRUCTION - 80005689W0730CYI - LTE850/NR2600	MB	MB	15.06.26	14

© Telstra Limited ACN 086 174 781 All rights reserved.




MOBILE NETWORK SITE 232974
BLACKBUTT RESERVOIR
EQUIPMENT LAYOUT
75 PIONEER DR, BLACKBUTT, NSW 2529

DWG NO.

N27928

SHT NO.

E1-1

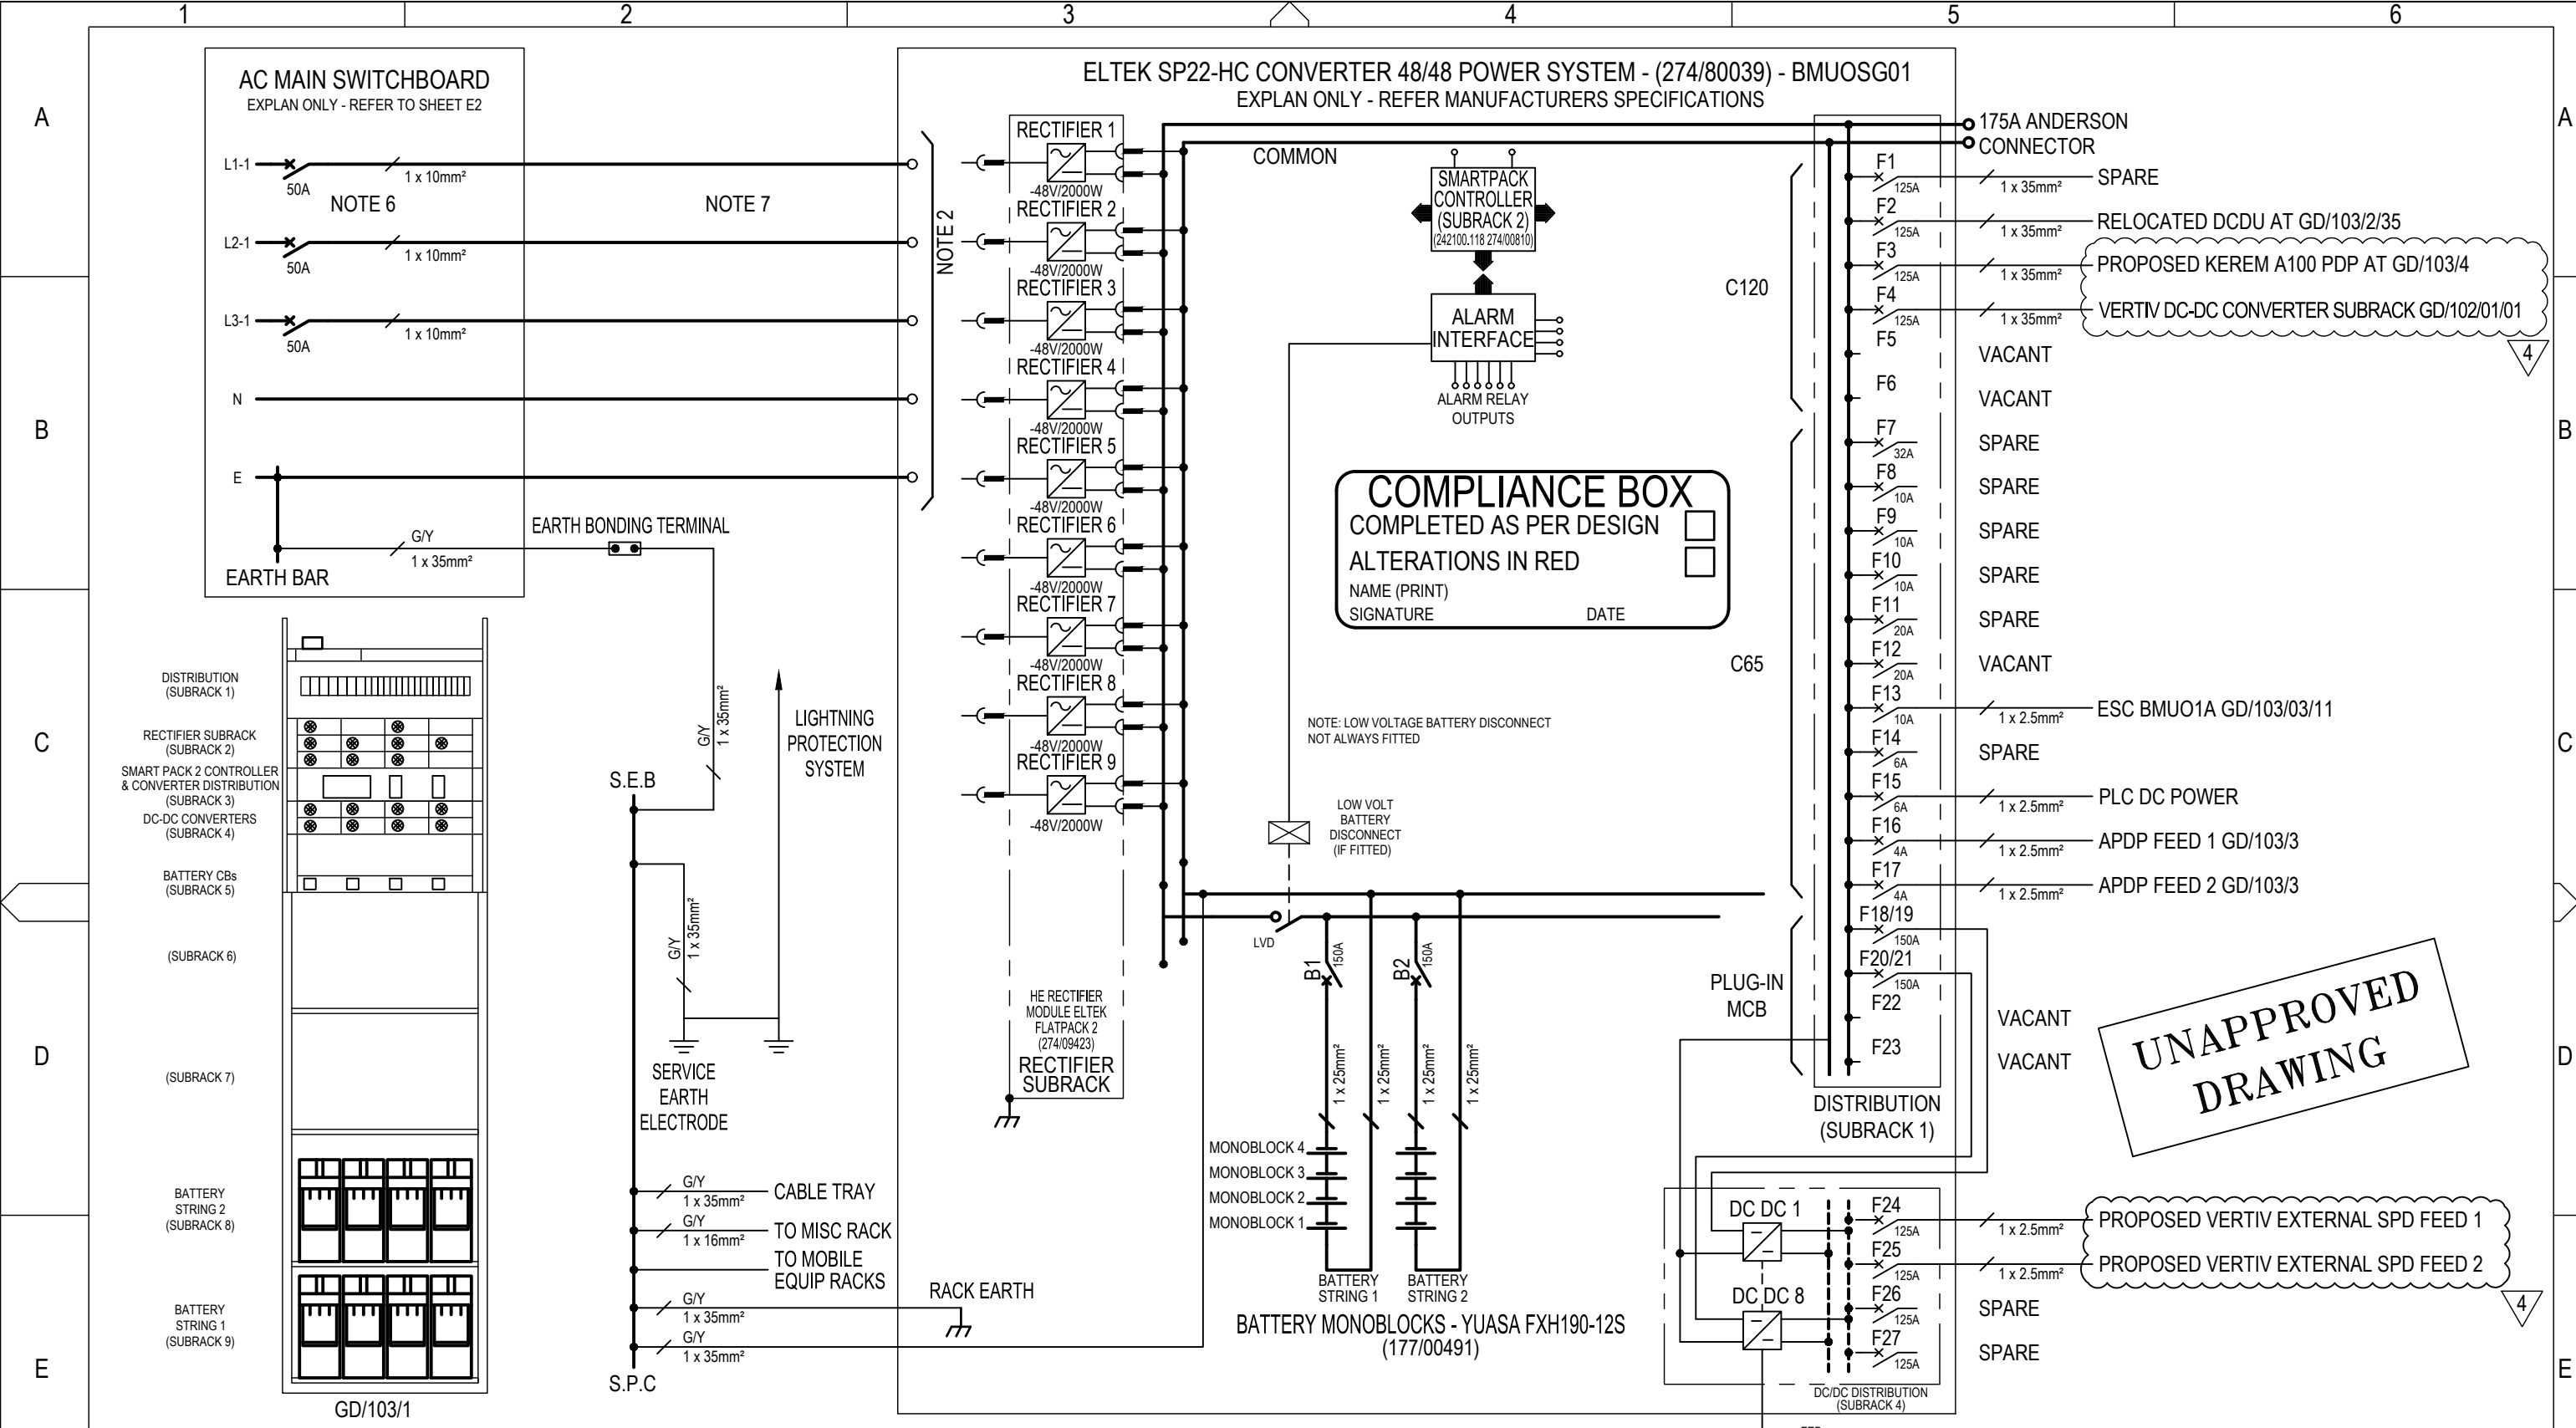

1. EARTHING AND A.C. WIRING IAW AS3000, AS3015, & OTHER RELEVANT DOCUMENTATION.
2. REFER TO MANUFACTURERS HAND BOOK FOR AC CONNECTIONS.
3. PANEL NUMBERING IN THE SUBRACK NUMBERED AS ENTERED IN STRUCTURE BUILDER/MITS.
4. CELLS TO BE NUMBERED FROM 1 AT THE POSITIVE END OF STRING.
5. BATTERY STRINGS TO BE NUMBERED AS SHOWN ABOVE.
6. BATTERY EXTENSION RACK (27480042) TO BE INSTALLED AS REQUIRED.
7. REFER MANUFACTURER'S HANDBOOK FOR INPUT BREAKER SIZE. MINIMUM 32 A, RECOMMENDED 50 A Th/Mag e.g. MGC60H OR Hy/Mag C2 e.g.. CBI QF OR QY.
8. REFER MANUFACTURER'S HANDBOOK FOR CABLE SIZE. MINIMUM 6mm², RECOMMENDED 10mm². WHEN 50A CIRCUIT. BREAKERS ARE USED, CABLE TO BE 10mm² OR GREATER.
9. DC-DC CONVERTER MODULES TO BE ORDERED AS REQUIRED.


Level-14, 3 Parramatta Square, 153 Macquarie St, Parramatta, NSW 2150, Australia
T +61 2 8896 6160 | www.cyient.com

ORDER	DRWN	CHKD	AMENDMENT	EXAM	APPD	DATE	ISS
NA19287.01	DB	AD	AS BUILT - 30077714W0092KOR - LTE2100 / LTE2600	CF	CF	19.03.19	1
NA22652.01	SP	GM	FOR CONSTRUCTION - 30088461W0125CYI - NR850/NR3600	MB	MB	07.01.21	2
NA22652.01	CU	SK	AS BUILT - 30088461W0178CYI - NR850/NR3600	KSK	DG	13.08.21	3
NA29861.01	JH	RT	FOR CONSTRUCTION - 80005689W0730CYI - LTE850/NR2600	MB	MB	15.06.26	4

FOR CONSTRUCTION

MOBILE NETWORK SITE 232974
BLACKBUTT RESERVOIR
DC POWER LINE DIAGRAM
75 PIONEER DR, BLACKBUTT, NSW 2529

DWG NO. N27928 SHT NO. E4

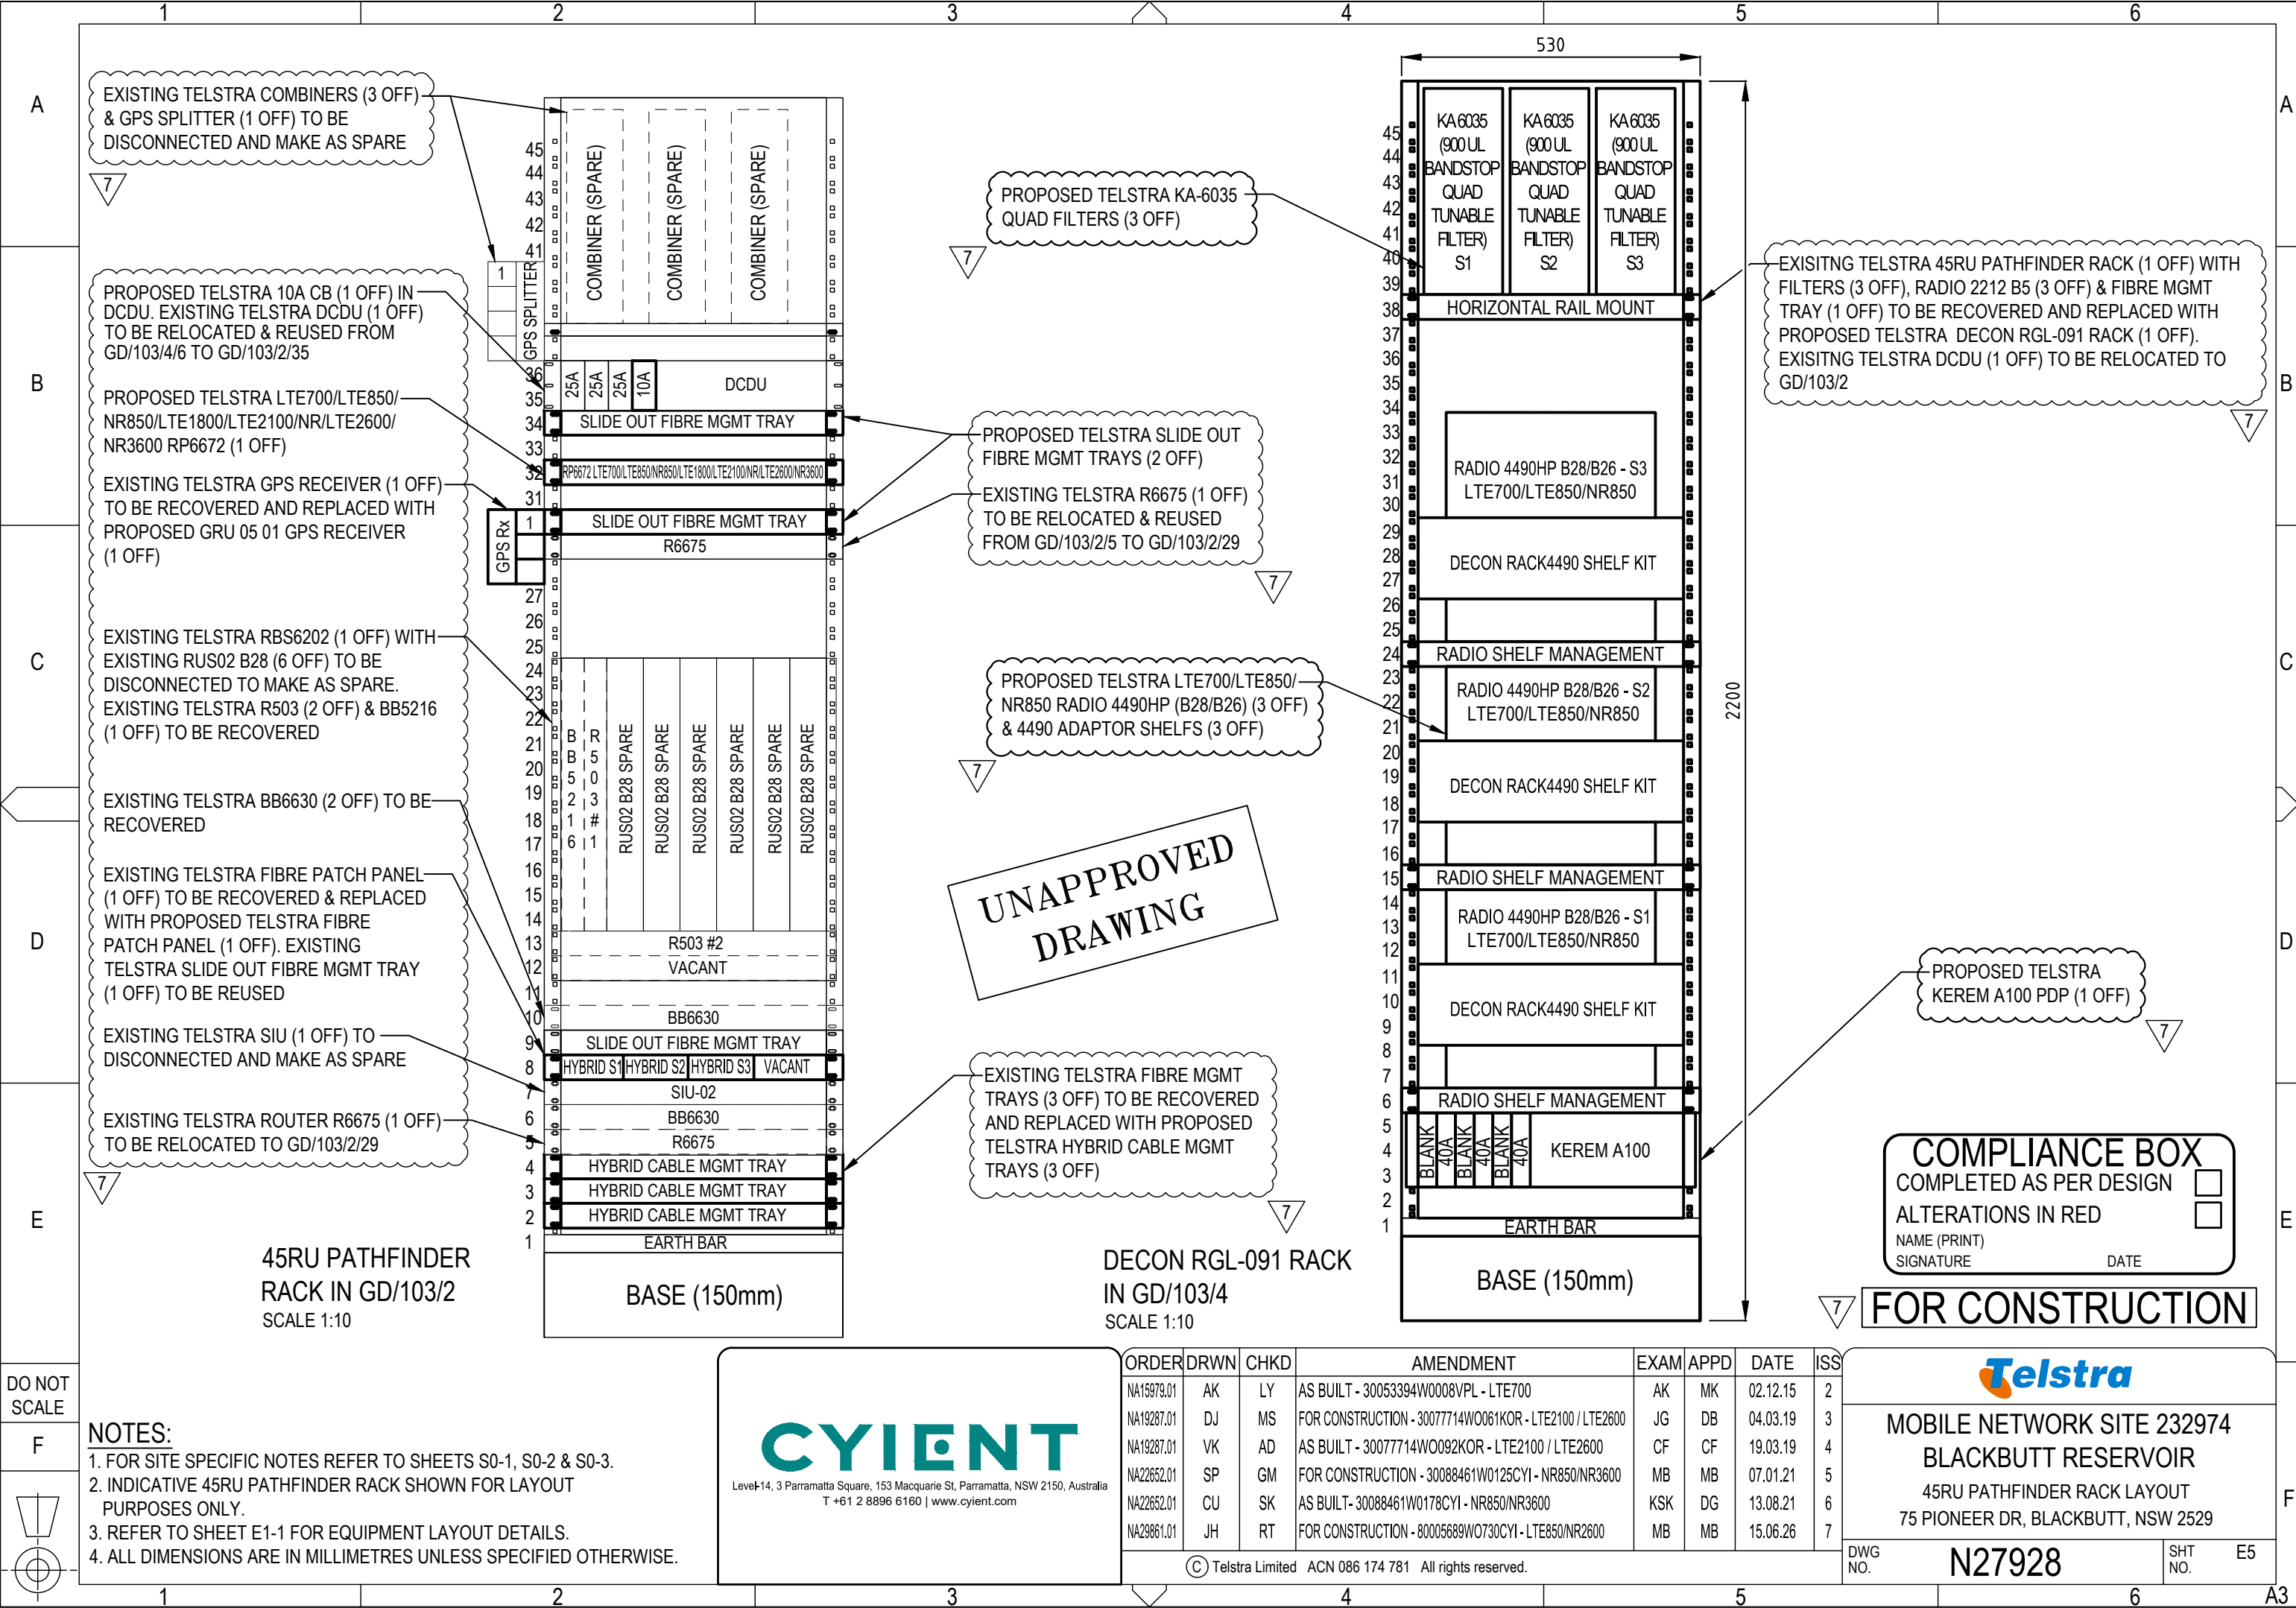

DO NOT SCALE

F

NOTES:
1. FOR SITE SPECIFIC NOTES REFER TO SHEETS S0-1, S0-2 & S0-3.
2. INDICATIVE 45RU PATHFINDER RACK SHOWN FOR LAYOUT PURPOSES ONLY.
3. REFER TO SHEET E1-1 FOR EQUIPMENT LAYOUT DETAILS.
4. ALL DIMENSIONS ARE IN MILLIMETRES UNLESS SPECIFIED OTHERWISE.

Level 14, 3 Parramatta Square, 153 Macquarie St, Parramatta, NSW 2150, Australia
T +61 2 8896 6160 | www.cyient.com


ORDER	DRWN	CHKD	AMENDMENT	EXAM	APPD	DATE	ISS
NA15979.01	AK	LY	AS BUILT - 30053394W0008VPL - LTE700	AK	MK	02.12.15	2
NA19287.01	DJ	MS	FOR CONSTRUCTION - 30077714W0061KOR - LTE2100 / LTE2600	JG	DB	04.03.19	3
NA19287.01	VK	AD	AS BUILT - 30077714W0092KOR - LTE2100 / LTE2600	CF	CF	19.03.19	4
NA22652.01	SP	GM	FOR CONSTRUCTION - 30088461W0125CYI - NR850/NR3600	MB	MB	07.01.21	5
NA22652.01	CU	SK	AS BUILT - 30088461W0178CYI - NR850/NR3600	KSK	DG	13.08.21	6
NA29861.01	JH	RT	FOR CONSTRUCTION - 80005689W0730CYI - LTE850/NR2600	MB	MB	15.06.26	7

COMPLIANCE BOX
COMPLETED AS PER DESIGN ☐
ALTERATIONS IN RED ☐
NAME (PRINT) _____
SIGNATURE _____ DATE _____

FOR CONSTRUCTION

**MOBILE NETWORK SITE 232974
BLACKBUTT RESERVOIR**
45RU PATHFINDER RACK LAYOUT
75 PIONEER DR, BLACKBUTT, NSW 2529

DWG NO. **N27928** SHT NO. **E5**

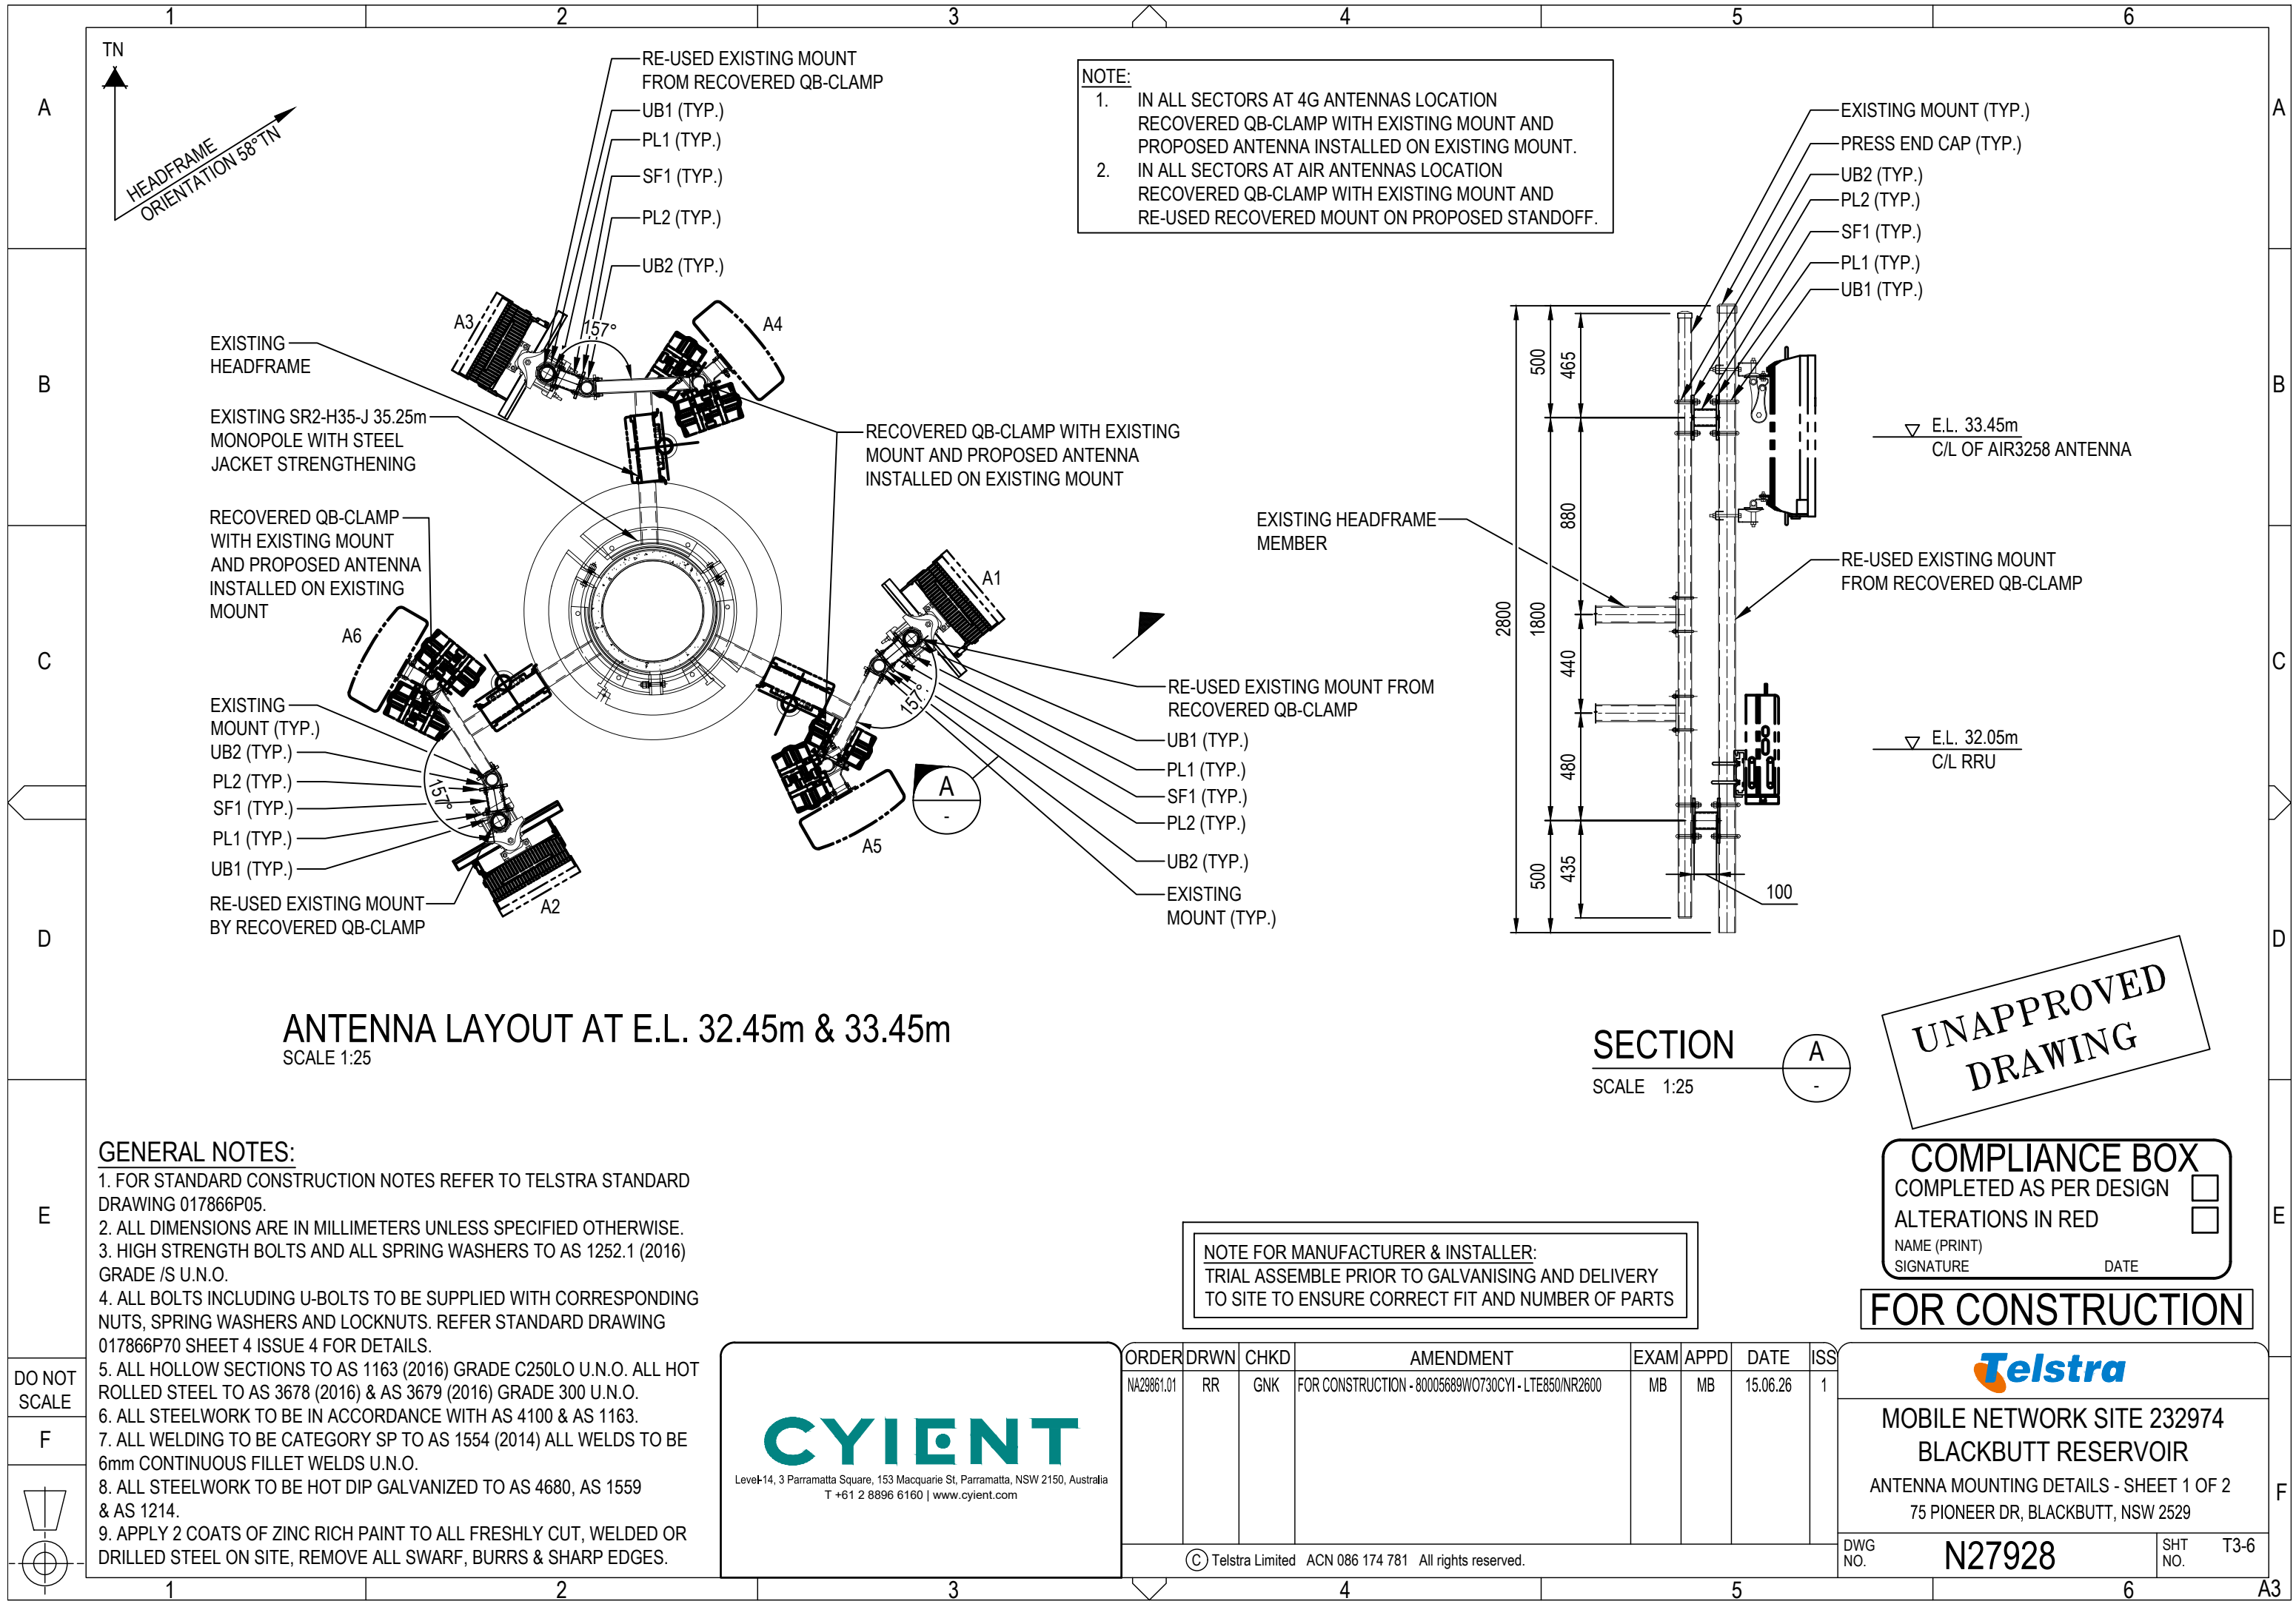

ANTENNA LAYOUT AT E.L. 32.45m & 33.45m
SCALE 1:25

SECTION
SCALE 1:25

UNAPPROVED
DRAWING

GENERAL NOTES:

1. FOR STANDARD CONSTRUCTION NOTES REFER TO TELSTRA STANDARD DRAWING 017866P05.
2. ALL DIMENSIONS ARE IN MILLIMETERS UNLESS SPECIFIED OTHERWISE.
3. HIGH STRENGTH BOLTS AND ALL SPRING WASHERS TO AS 1252.1 (2016) GRADE /S U.N.O.
4. ALL BOLTS INCLUDING U-BOLTS TO BE SUPPLIED WITH CORRESPONDING NUTS, SPRING WASHERS AND LOCKNUTS. REFER STANDARD DRAWING 017866P70 SHEET 4 ISSUE 4 FOR DETAILS.
5. ALL HOLLOW SECTIONS TO AS 1163 (2016) GRADE C250LO U.N.O. ALL HOT ROLLED STEEL TO AS 3678 (2016) & AS 3679 (2016) GRADE 300 U.N.O.
6. ALL STEELWORK TO BE IN ACCORDANCE WITH AS 4100 & AS 1163.
7. ALL WELDING TO BE CATEGORY SP TO AS 1554 (2014) ALL WELDS TO BE 6mm CONTINUOUS FILLET WELDS U.N.O.
8. ALL STEELWORK TO BE HOT DIP GALVANIZED TO AS 4680, AS 1559 & AS 1214.
9. APPLY 2 COATS OF ZINC RICH PAINT TO ALL FRESHLY CUT, WELDED OR DRILLED STEEL ON SITE, REMOVE ALL SWARF, BURRS & SHARP EDGES.

NOTE FOR MANUFACTURER & INSTALLER:
TRIAL ASSEMBLE PRIOR TO GALVANISING AND DELIVERY
TO SITE TO ENSURE CORRECT FIT AND NUMBER OF PARTS

COMPLIANCE BOX
COMPLETED AS PER DESIGN ☐
ALTERATIONS IN RED ☐
NAME (PRINT) _____
SIGNATURE _____ DATE _____


FOR CONSTRUCTION

CYIENT
Level 14, 3 Parramatta Square, 153 Macquarie St, Parramatta, NSW 2150, Australia
T +61 2 8896 6160 | www.cyient.com

ORDER	DRWN	CHKD	AMENDMENT	EXAM	APPD	DATE	ISS
NA29861.01	RR	GNK	FOR CONSTRUCTION - 80005689W0730CY1 - LTE850/NR2600	MB	MB	15.06.26	1

Telstra
MOBILE NETWORK SITE 232974
BLACKBUTT RESERVOIR
ANTENNA MOUNTING DETAILS - SHEET 1 OF 2
75 PIONEER DR, BLACKBUTT, NSW 2529

DWG NO.	N27928	SHT NO.	T3-6
---------	--------	---------	------

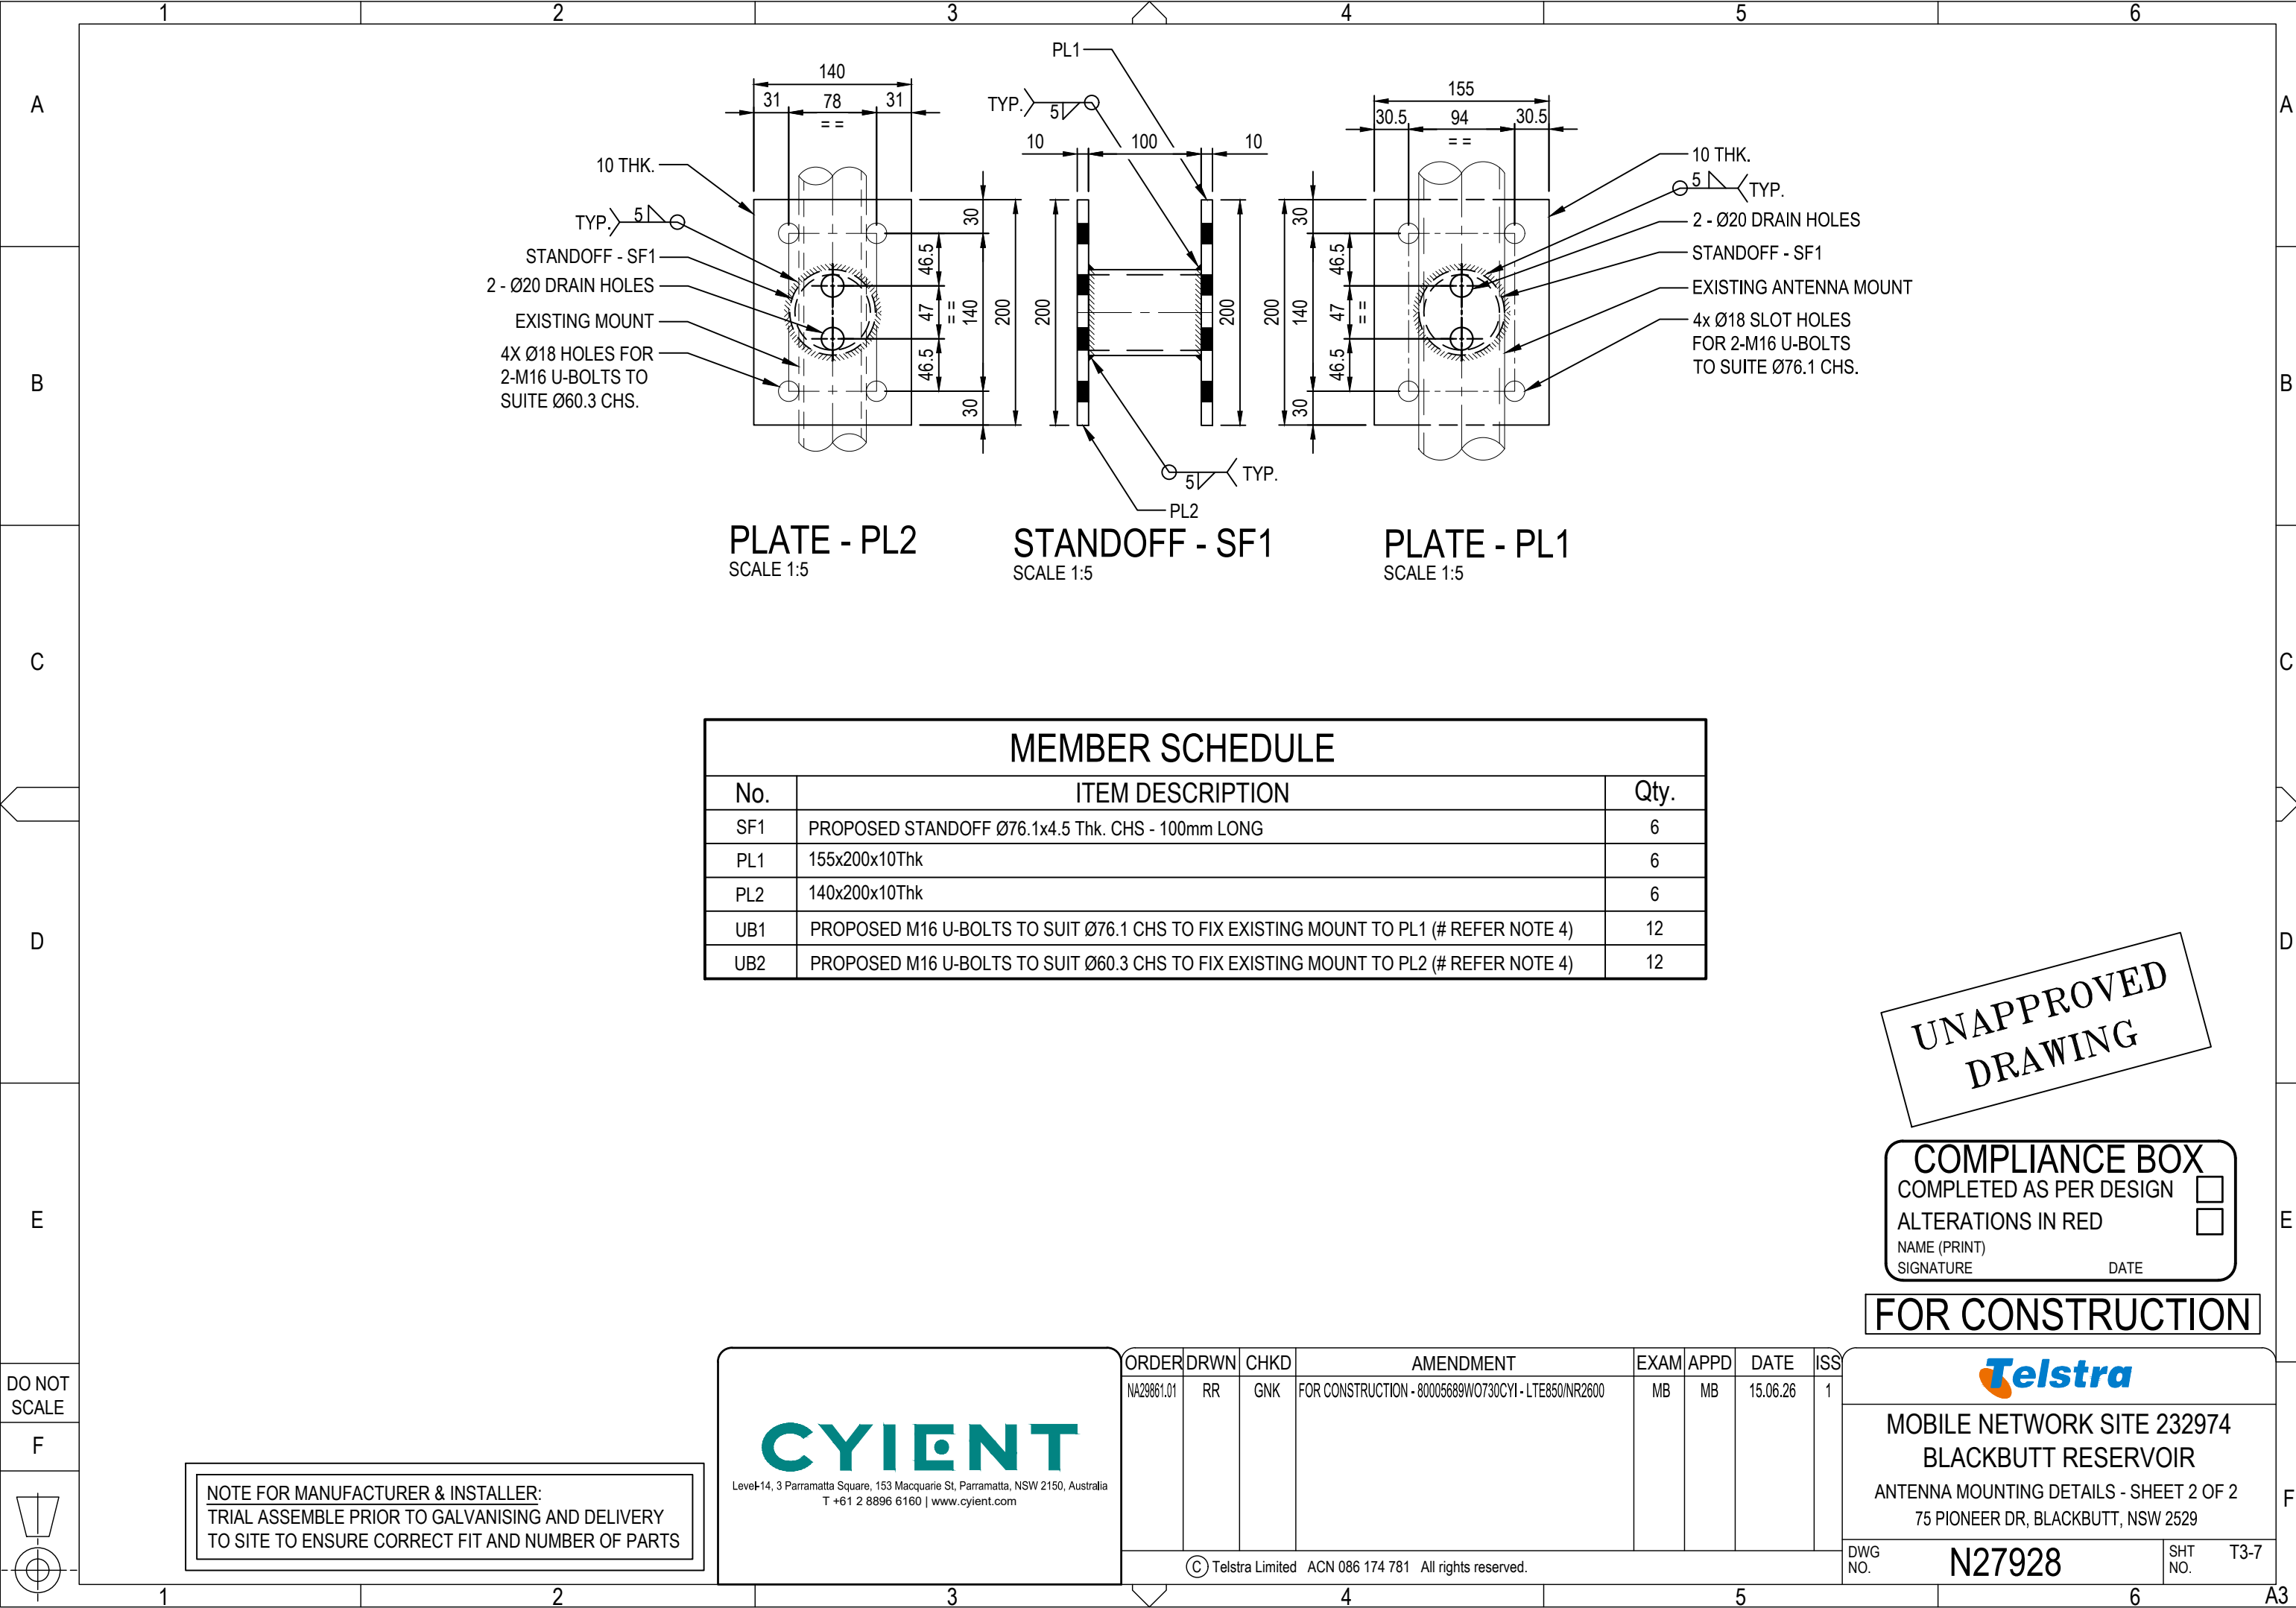

MEMBER SCHEDULE		
No.	ITEM DESCRIPTION	Qty.
SF1	PROPOSED STANDOFF Ø76.1x4.5 Thk. CHS - 100mm LONG	6
PL1	155x200x10Thk	6
PL2	140x200x10Thk	6
UB1	PROPOSED M16 U-BOLTS TO SUIT Ø76.1 CHS TO FIX EXISTING MOUNT TO PL1 (# REFER NOTE 4)	12
UB2	PROPOSED M16 U-BOLTS TO SUIT Ø60.3 CHS TO FIX EXISTING MOUNT TO PL2 (# REFER NOTE 4)	12

UNAPPROVED
DRAWING

COMPLIANCE BOX

COMPLETED AS PER DESIGN

ALTERATIONS IN RED

NAME (PRINT)

SIGNATURE

DATE

FOR CONSTRUCTION

DO NOT SCALE

NOTE FOR MANUFACTURER & INSTALLER:
TRIAL ASSEMBLE PRIOR TO GALVANISING AND DELIVERY TO SITE TO ENSURE CORRECT FIT AND NUMBER OF PARTS

CYIENT

Level 14, 3 Parramatta Square, 153 Macquarie St, Parramatta, NSW 2150, Australia
T +61 2 8896 6160 | www.cyient.com

ORDER	DRWN	CHKD	AMENDMENT	EXAM	APPD	DATE	ISS
NA29861.01	RR	GNK	FOR CONSTRUCTION - 80005689W0730CYI - LTE850/NR2600	MB	MB	15.06.26	1

© Telstra Limited ACN 086 174 781 All rights reserved.

Telstra

MOBILE NETWORK SITE 232974
BLACKBUTT RESERVOIR
ANTENNA MOUNTING DETAILS - SHEET 2 OF 2
75 PIONEER DR, BLACKBUTT, NSW 2529

DWG NO.

N27928

SHT NO.

T3-7

