

<

1

2

3

4

5

6

A

B

C

D

E

F

EQUIPMENT NOTES - PROJECT NO. NA30121.01

ITEM	EQUIPMENT	EQUIPMENT DETAILS	EXISTING	PROPOSED	TOTAL	REFERENCE DWG
1	ERICSSON OUTDOOR UNIT RBS6102	1300 x 700 x 1450mm (W, D, H) NATURAL COLOUR	1	0	1	SHEETS E1 & E5
2	EATON EBE PSU	-	1	-1	0	SHEET E1
3	ICS CABINET	-	1 (SPARE)	0	1	-
4	EATON EBE RECTIFIERS	2kW APR48-ES	6	-6	0	SHEET E1
5	EATON EBE BATTERY STRINGS	FXH190-12S	2	-2	0	SHEET E1
6	VERTIV SP22 MACRO ODU (PSU)	755x1080x1950mm(W,D,H)	0	1	1	SHEETS E1 & E4
7	VERTIV SP22 MACRO ODU RECTIFIERS	G3 R48-2000E3 2kW 48V	0	5	5	SHEETS E1 & E4
8	VERTIV SP22 MACRO ODU DCDC CONVERTERS	G3 C48/48-1500E3 1.5kW	0	9	9	SHEETS E1 & E4
9	VERTIV SP22 MACRO ODU BATTERY STRINGS	SB190F EON	0	2	2	SHEETS E1 & E4
10	ERICSSON RBS6102 (LEFT SUBRACK)	INSTALLED IN RBS6102 ODU RT/1/02	1	0	1	SHEET E5
11	ERICSSON RBS6102 (RIGHT SUBRACK)	INSTALLED IN RBS6102 ODU RT/1/02	1	-1	0	SHEET E5
12	ERICSSON RP6672 (LTE700/NR850/LTE1800/LTE2100/NR/LTE2600/NR3600)	TO BE INSTALLED IN RBS6102 ODU RT/1/02	0	1	1	SHEETS E1 & E5
13	ERICSSON DUW 31 01	INSTALLED IN RBS6102 ODU SUBRAK AT RT/1/02	1 (SPARE)	-1	0	SHEETS E1 & E5
14	ERICSSON RUS 02 (B5)	INSTALLED IN RBS6102 ODU SUBRAK AT RT/1/02	3 (SPARE)	-3	0	SHEETS E1 & E5
15	ERICSSON RUS 02 (B28B)	INSTALLED IN RBS6102 ODU SUBRAK AT RT/1/02	6	-6	0	SHEETS E1 & E5
16	ERICSSON R503	INSTALLED IN RBS6102 ODU SUBRAK AT RT/1/02	2	-2	0	SHEETS E1 & E5
17	IANOS CHASSIS	INSTALLED IN RBS6102 ODU SUBRAK AT RT/1/02	1	0	1	SHEETS E1 & E5
18	DWDM	INSTALLED IN RBS6102 ODU SUBRAK AT RT/1/02	4	-4	0	SHEETS E1 & E5
19	DWDM (OMD-9-S-BCD)	TO BE INSTALLED RBS6102 SUBRACK	0	1	1	SHEETS E1 & E5
20	ERICSSON R6471 ROUTER	TO BE INSTALLED IN RBS6102 ODU RT/1/02	0	1	1	SHEETS E1 & E5
21	ERICSSON SITE INTEGRATION UNIT (SIU)	INSTALLED AT RT/1/4	1 (SPARE)	0	1	SHEET E1
22	FIBRE PATCH PANEL	425 x 350 x 44mm (W,D,H)	1	-1	0	SHEETS E1 & E5
23	W&B FIBRE PATCH PANEL	425 x 350 x 44mm (W,D,H)	0	1	1	SHEETS E1 & E5
24	FIBRE MANAGEMENT TRAYS	TO BE INSTALLED IN RBS6102 ODU SUBRAK AT RT/1/02	2	2	4	SHEETS E1 & E5
25	HYBRID CABLE MANAGEMENT TRAYS	INSTALLED IN RBS6102 ODU SUBRAK AT RT/1/02	3	-3	0	SHEETS E1 & E5
26	W&B HYBRID CABLE MANAGEMENT TRAYS	TO BE INSTALLED IN RBS6102 ODU SUBRAK AT RT/1/02	0	3	3	SHEETS E1 & E5
27	ERICSSON SITE CONTROLLER (ESC)	TO BE INSTALLED IN RBS6102 ODU SUBRAK AT RT/1/02	0	1	1	SHEETS E1 & E5
28	LENMIC SURGE PROTECTION DEVICE (SPD 12.3 WAY)	IN WEATHER PROOF ENCLOSURE WALL MOUNTED	1	1 (SPARE)	1	SHEET E1
29	5G AUGMENTATION BOX	200 x 150 x 400mm (W,D,H)	1	1 (SPARE)	1	SHEET E1
30	VERTIV INTERNAL SURGE PROTECTION DEVICE (12.3 WAY)	IN WEATHER PROOF ENCLOSURE WALL MOUNTED	0	1	1	SHEET E1

SITE DESIGN BRIEF NR850 NA30121.01

ISSUE 01 DATED 24/04/2026

NOTE: THIS DRAWING TO BE READ IN CONJUNCTION WITH SHEETS S0 & S0-2

CYIENT

Level-14, 3 Parramatta Square, 153 Macquarie St, Parramatta, NSW 2150, Australia
T +61 8887 8600 | www.cyient.com

ORDER	DRWN	CHKD	AMENDMENT	EXAM	APPD	DATE	ISS
NA13444.01	JA	JA	KSD537-SP71780001-AS-BUILT-W01-ERIC	JA	SEL	14.06.13	3
NA16383.01	CJ	MS	FOR CONSTRUCTION - 30053284W0244KOR - LTE700	TM	TM	08.04.16	4
NA16383.01	DJB	MS	AS BUILT - 30053284W054KOR - LTE700	RV	RV	06.09.16	5
NA18965.01	MT	MR	AS BUILT - 30069071W0563SSNC - LTE2100 / LTE2600	KV	RV	28.09.18	6
NA20815.01	ICM	PD	AS BUILT - 30084100W00060LL - 5G	GVR	DEG	18.08.20	7
NA30121.01	AK	RT	FOR CONSTRUCTION - 80005689W0804CYI - NR850	MB	MB	06.08.26	8

© Telstra Limited ACN 086 174 781 All rights reserved.

Telstra

MOBILE NETWORK SITE 117609
TELOPEA CMTS

SITE SPECIFIC NOTES - SHEET 2 OF 3
33 STURT ST, TELOPEA, NSW 2117

DWG NO.

N26894

SHT NO.

S0-1

UNAPPROVED
DRAWING

COMPLIANCE BOX
COMPLETED AS PER DESIGN
ALTERATIONS IN RED
NAME (PRINT)
SIGNATURE
DATE

FOR CONSTRUCTION

DO NOT
SCALE

F

1

2

3

4

5

6

A3

1

2

3

4

5

6

A

B

C

D

E

F

EQUIPMENT NOTES - PROJECT NO. NA30121.01

ITEM	EQUIPMENT	EQUIPMENT DETAILS	EXISTING	PROPOSED	TOTAL	REFERENCE DWG
31	W&B RRU INTERFACE JUNCTION BOX	TC4039MOBILE02	3	3 (SPARE)	3	SHEETS S1-2 & S3
32	W&B RRU INTERFACE JUNCTION BOX	TC4039MOBILE08	0	3	3	SHEETS S1-2 & S3
33	ERICSSON RRUS 32 B7	431 (W) x 182 (D) x 500mm (H) NATURAL COLOUR	3	-3	0	SHEETS S1-2 & S3
34	ERICSSON RADIO 4443 B1/B3 (LTE1800/LTE2100)	402 (W) x 149 (D) x 420mm (H) NATURAL COLOUR	3	-3	0	SHEETS S1-2 & S3
35	ERICSSON RADIO 4490 HP (B28/B26) (LTE700/NR850)	397 x 165 x 522mm (W,D,H) NATURAL COLOUR	0	3	3	SHEETS S1-2 & S3
36	KAELUS DUAL DUPLEX FILTERS	DDF0035F1V1	3	-3	0	SHEETS S1-1 & S3
37	KAELUS QUAD FILTERS	KA-6035	0	3	3	SHEETS S1-1 & S3
38	KAELUS TWIN COMBINER	DBC0086F1V1-1	3	3 (SPARE)	3	SHEETS S1-1 & S3
39	KAELUS TWIN TMA	TMA2094F01V2-1	3	-3	0	SHEETS S1-1 & S3
40	RFS LCF78-50J	22m LENGTH	2	2 (SPARE)	2	SHEETS S1 & S3
41	RFS LCF78-50J	21m LENGTH	2 (SPARE)	0	2	SHEETS S1 & S3
42	RFS LCF78-50J	19m LENGTH	2 (SPARE)	0	2	SHEETS S1 & S3
43	RFS LCF78-50J	12m LENGTH	2	2 (SPARE)	2	SHEETS S1 & S3
44	RFS LCF78-50J	14m LENGTH	2 (SPARE)	0	2	SHEETS S1 & S3
45	RFS LCF78-50J	2m LENGTH	2	2 (SPARE)	2	SHEETS S1 & S3
46	W&B HYBRID CABLE 7/8 8P16F	25m LENGTH	3	3 (SPARE)	3	SHEETS S1-1 & S3
47	W&B HYBRID CABLE 7/8 8P24F	25m LENGTH	0	3	3	SHEETS S1-1 & S3
48	GPS SPLITTER	INSTALLED IN RBS6102 ODU RT/1/02	1	1 (SPARE)	1	SHEET E5
49	GPS RECEIVER	INSTALLED IN RBS6102 ODU RT/1/02	1	-1	0	SHEET E5
50	GPS RECEIVER UNIT	ERICSSON GRU 05 01 RECEIVER NCD90189/1	0	1	1	SHEET E5
51	GPS ANTENNA (LTE)	ROSENBERGER GPS-36-N-SA OMNI	1	-1	0	SHEETS S1 & S3
52	KAELUS, DUAL BAND GNSS GPS ACTIVE ANT	KA-7005-1110	0	1	1	SHEETS S1 & S3
53	RF JUMPER 1_5M N F TO SMA M	TSR951339/1500	0	1	1	-
54	GPS WBT TOD CABLE	WBT R6000 TOD CABLE - 3M	0	1	1	-
55	GPS SYNC CABLE	RPM1136127/2000	0	1	1	-

UNAPPROVED
DRAWING

COMPLIANCE BOX

COMPLETED AS PER DESIGN

ALTERATIONS IN RED

NAME (PRINT)

SIGNATURE

DATE

FOR CONSTRUCTION

DO NOT
SCALE

F

CYIENT

Level-14, 3 Parramatta Square, 153 Macquarie St, Parramatta, NSW 2150, Australia
T +61 8887 8600 | www.cyient.com

ORDER	DRWN	CHKD	AMENDMENT	EXAM	APPD	DATE	ISS
NA30121.01	AK	RT	FOR CONSTRUCTION - 80005689W0804CYI - NR850	MB	MB	06.08.26	1

© Telstra Limited ACN 086 174 781 All rights reserved.

Telstra

MOBILE NETWORK SITE 117609
TELOPEA CMTS

SITE SPECIFIC NOTES - SHEET 3 OF 3
33 STURT ST, TELOPEA, NSW 2117

DWG
NO.

N26894

SHT
NO.

S0-2

1

2


3

4

5

6

A3

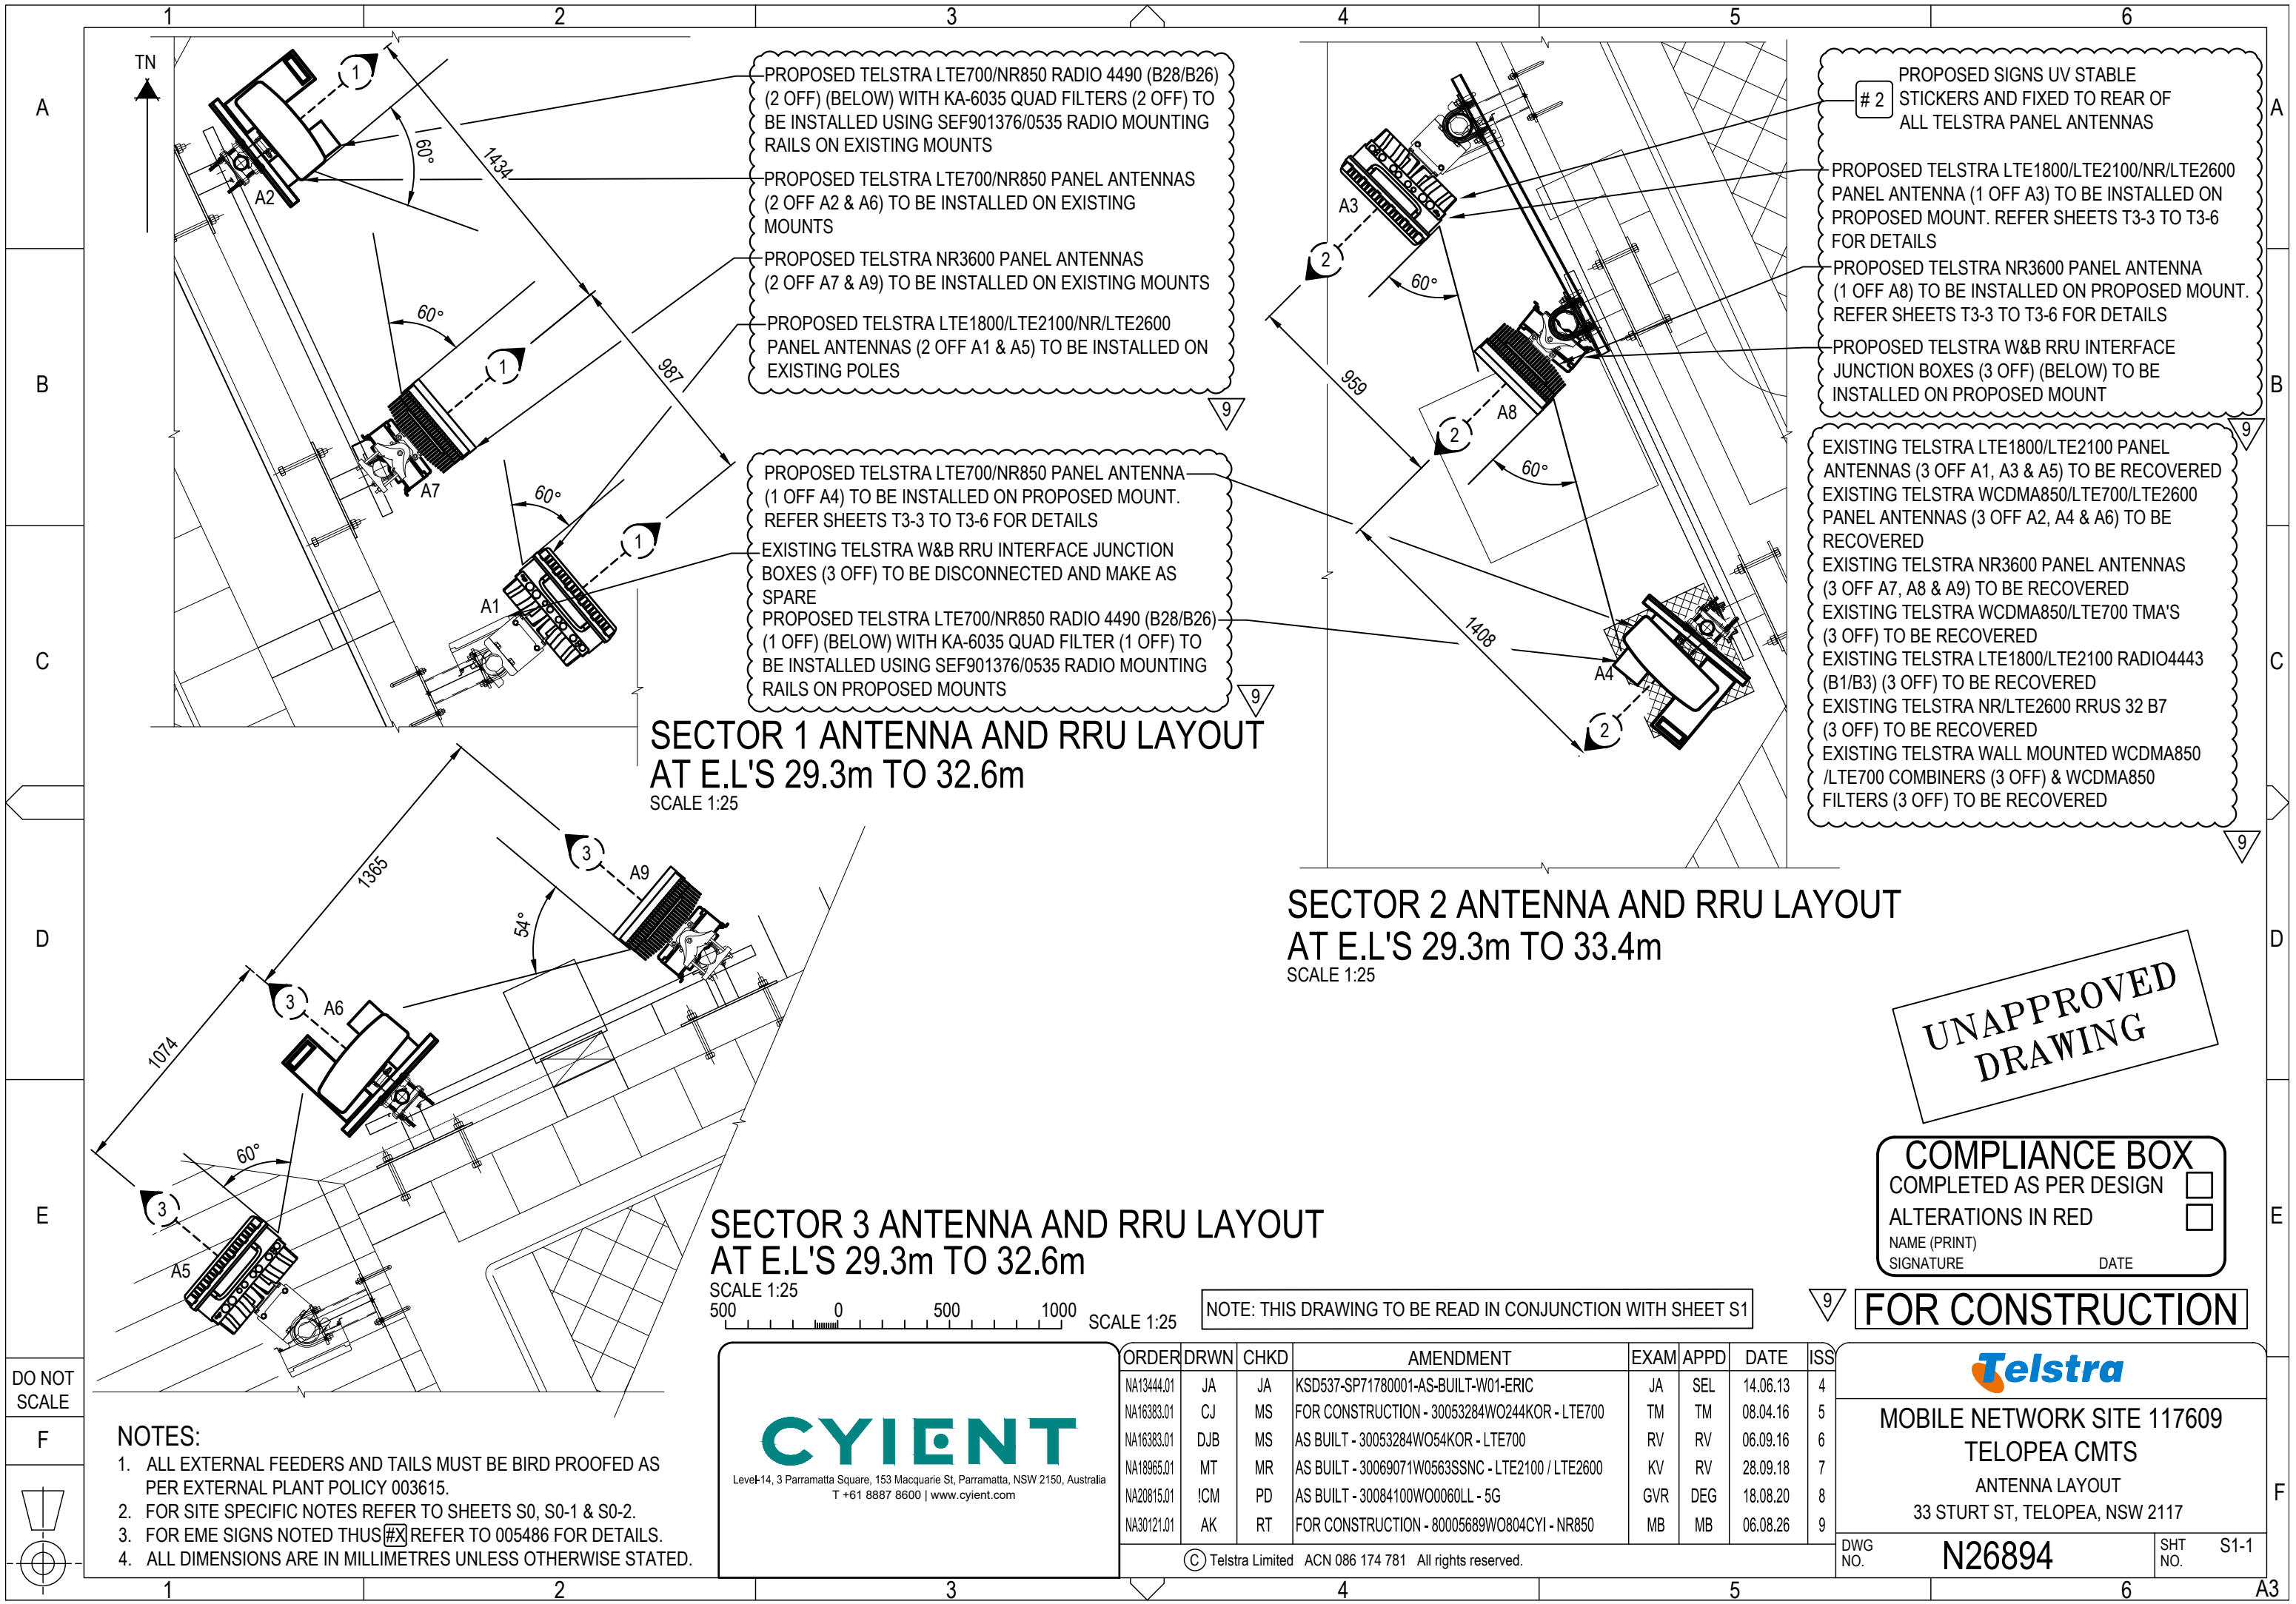

SECTOR 1 ANTENNA AND RRU LAYOUT
AT E.L'S 29.3m TO 32.6m
SCALE 1:25

SECTOR 2 ANTENNA AND RRU LAYOUT
AT E.L'S 29.3m TO 33.4m
SCALE 1:25

SECTOR 3 ANTENNA AND RRU LAYOUT
AT E.L'S 29.3m TO 32.6m
SCALE 1:25


UNAPPROVED
DRAWING

COMPLIANCE BOX
COMPLETED AS PER DESIGN ☐
ALTERATIONS IN RED ☐
NAME (PRINT) _____
SIGNATURE _____ DATE _____

FOR CONSTRUCTION

DO NOT
SCALE

F

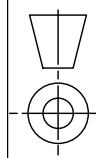

- NOTES:
1. ALL EXTERNAL FEEDERS AND TAILS MUST BE BIRD PROOFED AS PER EXTERNAL PLANT POLICY 003615.
 2. FOR SITE SPECIFIC NOTES REFER TO SHEETS S0, S0-1 & S0-2.
 3. FOR EME SIGNS NOTED THUS [X] REFER TO 005486 FOR DETAILS.
 4. ALL DIMENSIONS ARE IN MILLIMETRES UNLESS OTHERWISE STATED.

CYIENT
Level-14, 3 Parramatta Square, 153 Macquarie St, Parramatta, NSW 2150, Australia
T +61 8887 8600 | www.cyient.com


ORDER	DRWN	CHKD	AMENDMENT	EXAM	APPD	DATE	ISS
NA13444.01	JA	JA	KSD537-SP71780001-AS-BUILT-W01-ERIC	JA	SEL	14.06.13	4
NA16383.01	CJ	MS	FOR CONSTRUCTION - 30053284W0244KOR - LTE700	TM	TM	08.04.16	5
NA16383.01	DJB	MS	AS BUILT - 30053284W054KOR - LTE700	RV	RV	06.09.16	6
NA18965.01	MT	MR	AS BUILT - 30069071W0563SSNC - LTE2100 / LTE2600	KV	RV	28.09.18	7
NA20815.01	ICM	PD	AS BUILT - 30084100W0060LL - 5G	GVR	DEG	18.08.20	8
NA30121.01	AK	RT	FOR CONSTRUCTION - 80005689W0804CYI - NR850	MB	MB	06.08.26	9

© Telstra Limited ACN 086 174 781 All rights reserved.

Telstra


MOBILE NETWORK SITE 117609
TELOPEA CMTS
ANTENNA LAYOUT
33 STURT ST, TELOPEA, NSW 2117

DWG NO. **N26894** SHT NO. S1-1

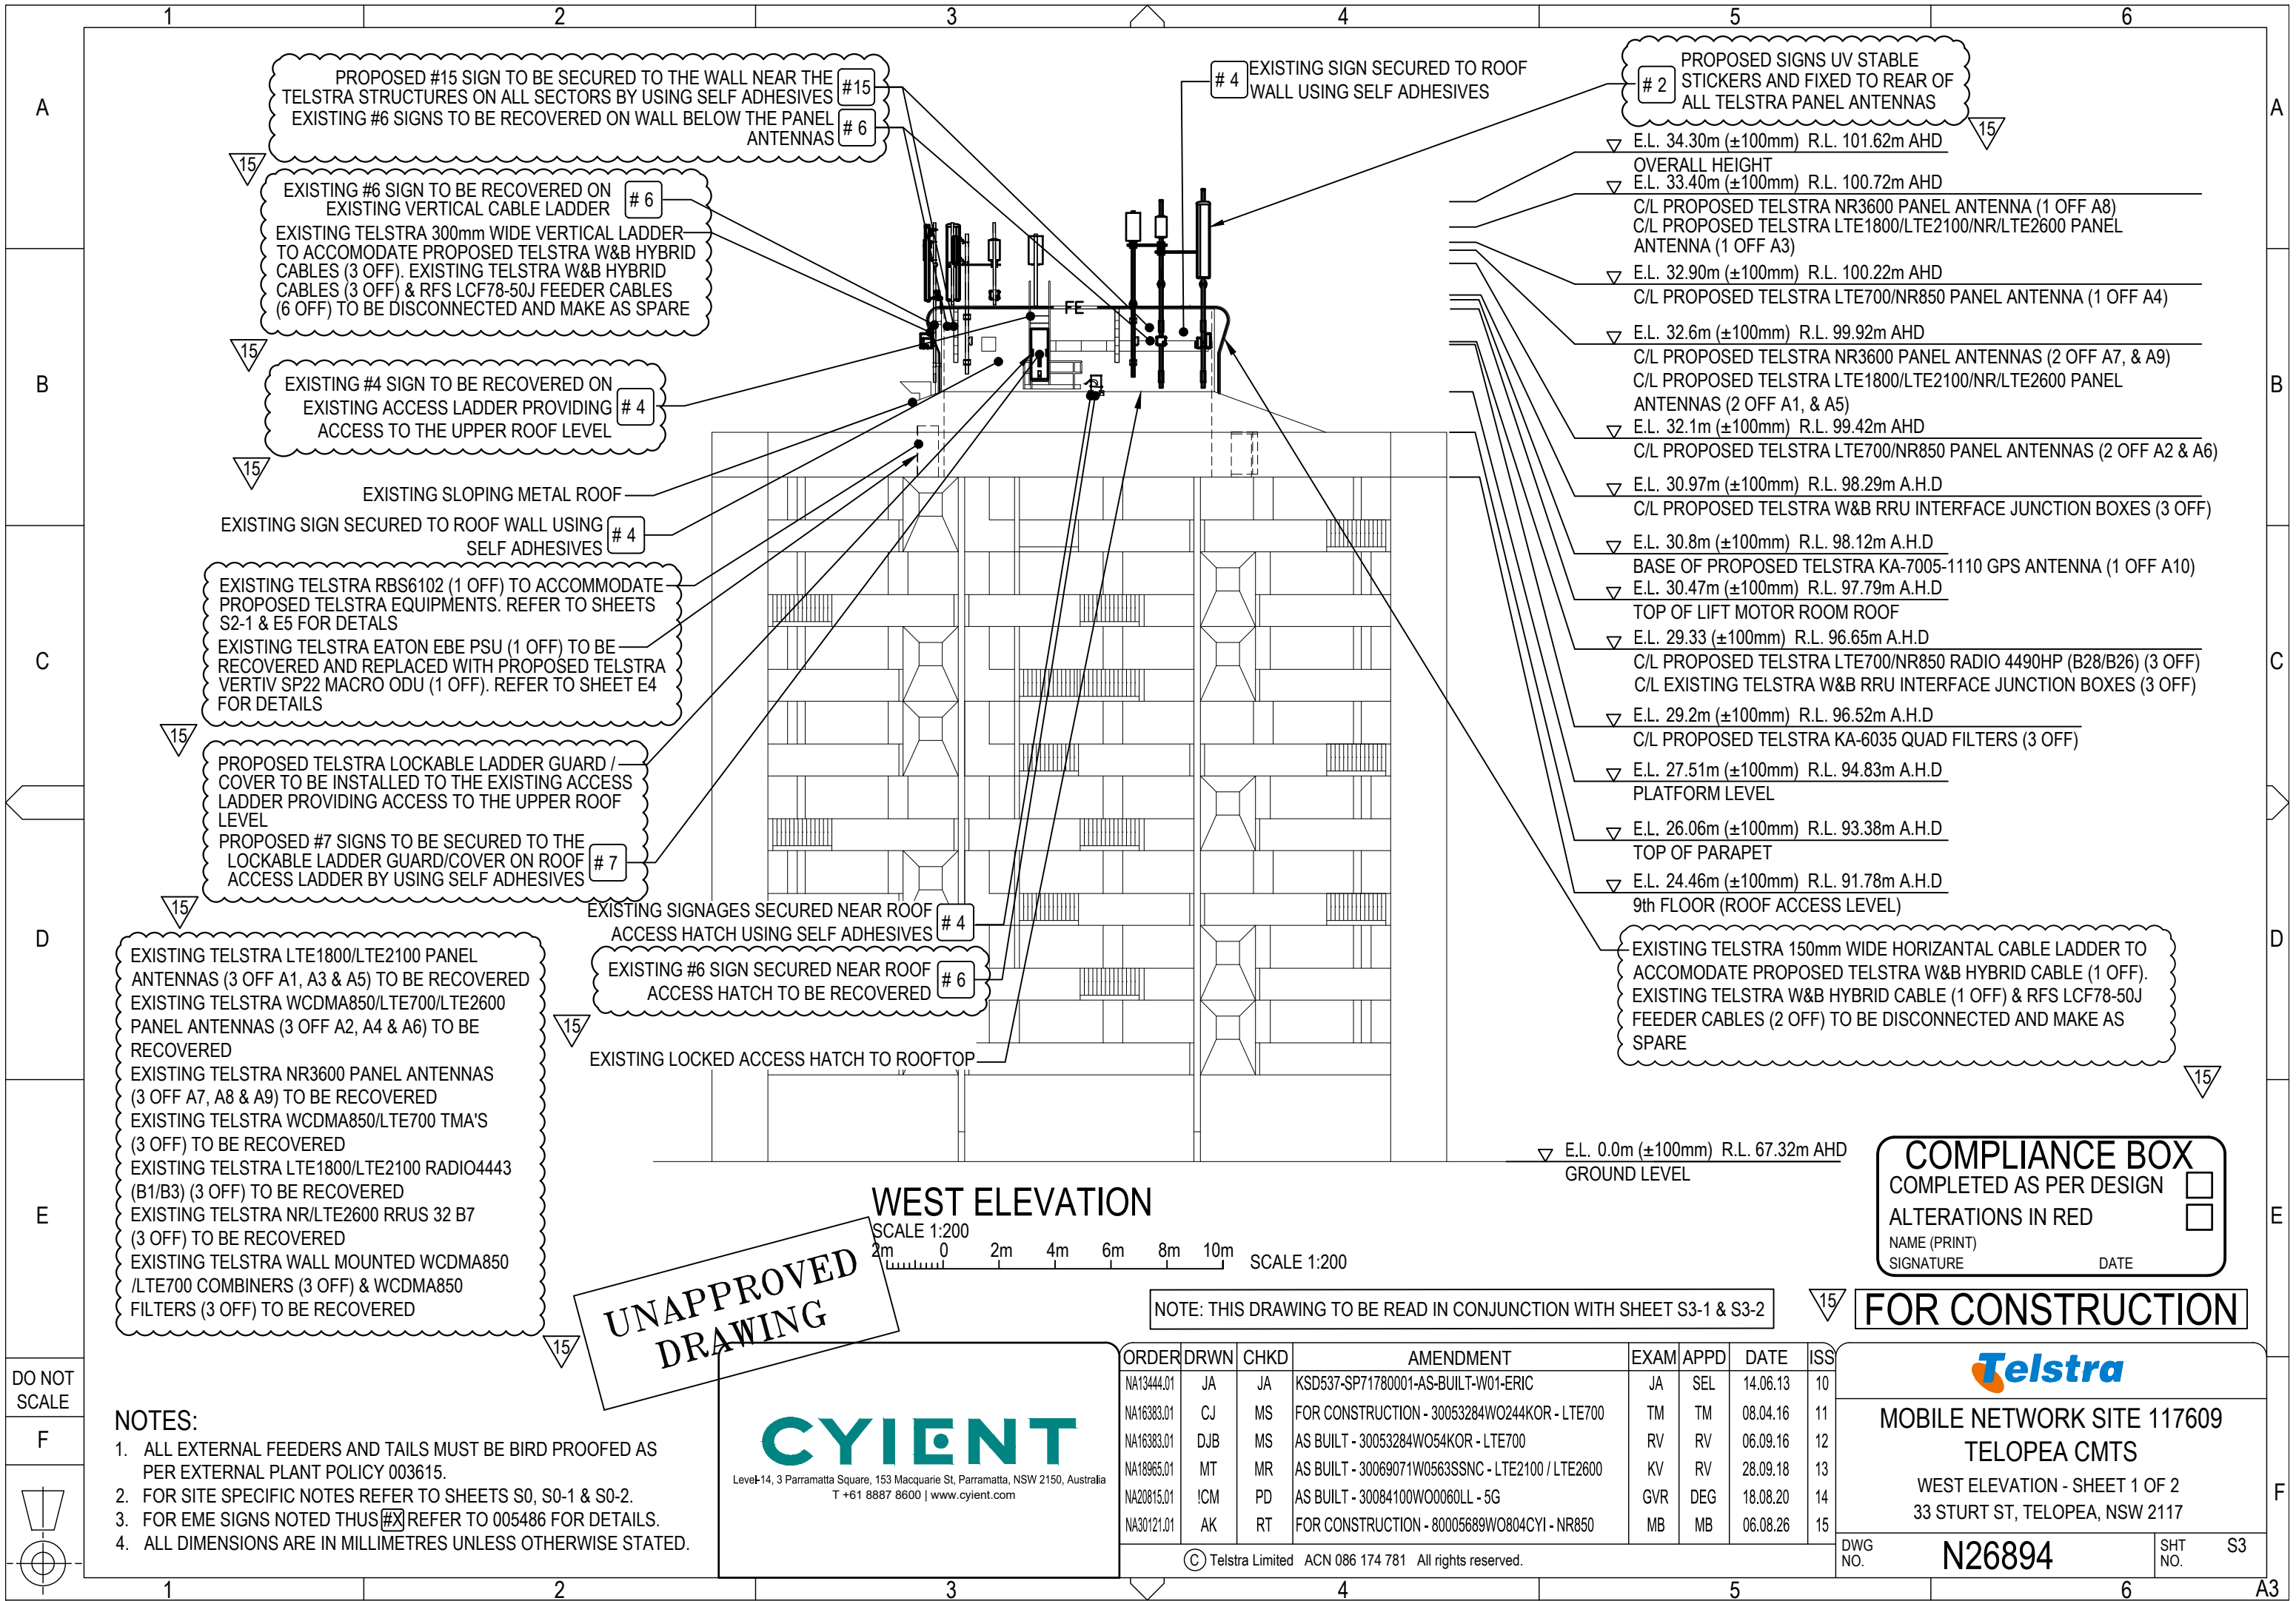

DO NOT
SCALE

F

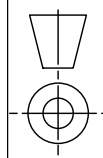

NOTES:

1. ALL EXTERNAL FEEDERS AND TAILS MUST BE BIRD PROOFED AS PER EXTERNAL PLANT POLICY 003615.
2. FOR SITE SPECIFIC NOTES REFER TO SHEETS S0, S0-1 & S0-2.
3. FOR EME SIGNS NOTED THUS ~~XX~~ REFER TO 005486 FOR DETAILS.
4. ALL DIMENSIONS ARE IN MILLIMETRES UNLESS OTHERWISE STATED.

CYIENT

Level-14, 3 Parramatta Square, 153 Macquarie St, Parramatta, NSW 2150, Australia
T +61 8887 8600 | www.cyient.com

NOTE: THIS DRAWING TO BE READ IN CONJUNCTION WITH SHEET S3-1 & S3-2

ORDER	DRWN	CHKD	AMENDMENT	EXAM	APPD	DATE	ISS
NA13444.01	JA	JA	KSD537-SP71780001-AS-BUILT-W01-ERIC	JA	SEL	14.06.13	10
NA16383.01	CJ	MS	FOR CONSTRUCTION - 30053284W0244KOR - LTE700	TM	TM	08.04.16	11
NA16383.01	DJB	MS	AS BUILT - 30053284W054KOR - LTE700	RV	RV	06.09.16	12
NA18965.01	MT	MR	AS BUILT - 30069071W0563SSNC - LTE2100 / LTE2600	KV	RV	28.09.18	13
NA20815.01	ICM	PD	AS BUILT - 30084100W0060LL - 5G	GVR	DEG	18.08.20	14
NA30121.01	AK	RT	FOR CONSTRUCTION - 80005689W0804CYI - NR850	MB	MB	06.08.26	15

© Telstra Limited ACN 086 174 781 All rights reserved.

COMPLIANCE BOX	
COMPLETED AS PER DESIGN	☐
ALTERATIONS IN RED	☐
NAME (PRINT)	
SIGNATURE	DATE

FOR CONSTRUCTION




MOBILE NETWORK SITE 117609
TELOPEA CMTS
WEST ELEVATION - SHEET 1 OF 2
33 STURT ST, TELOPEA, NSW 2117


DWG
NO.

N26894

SHT
NO.

S3

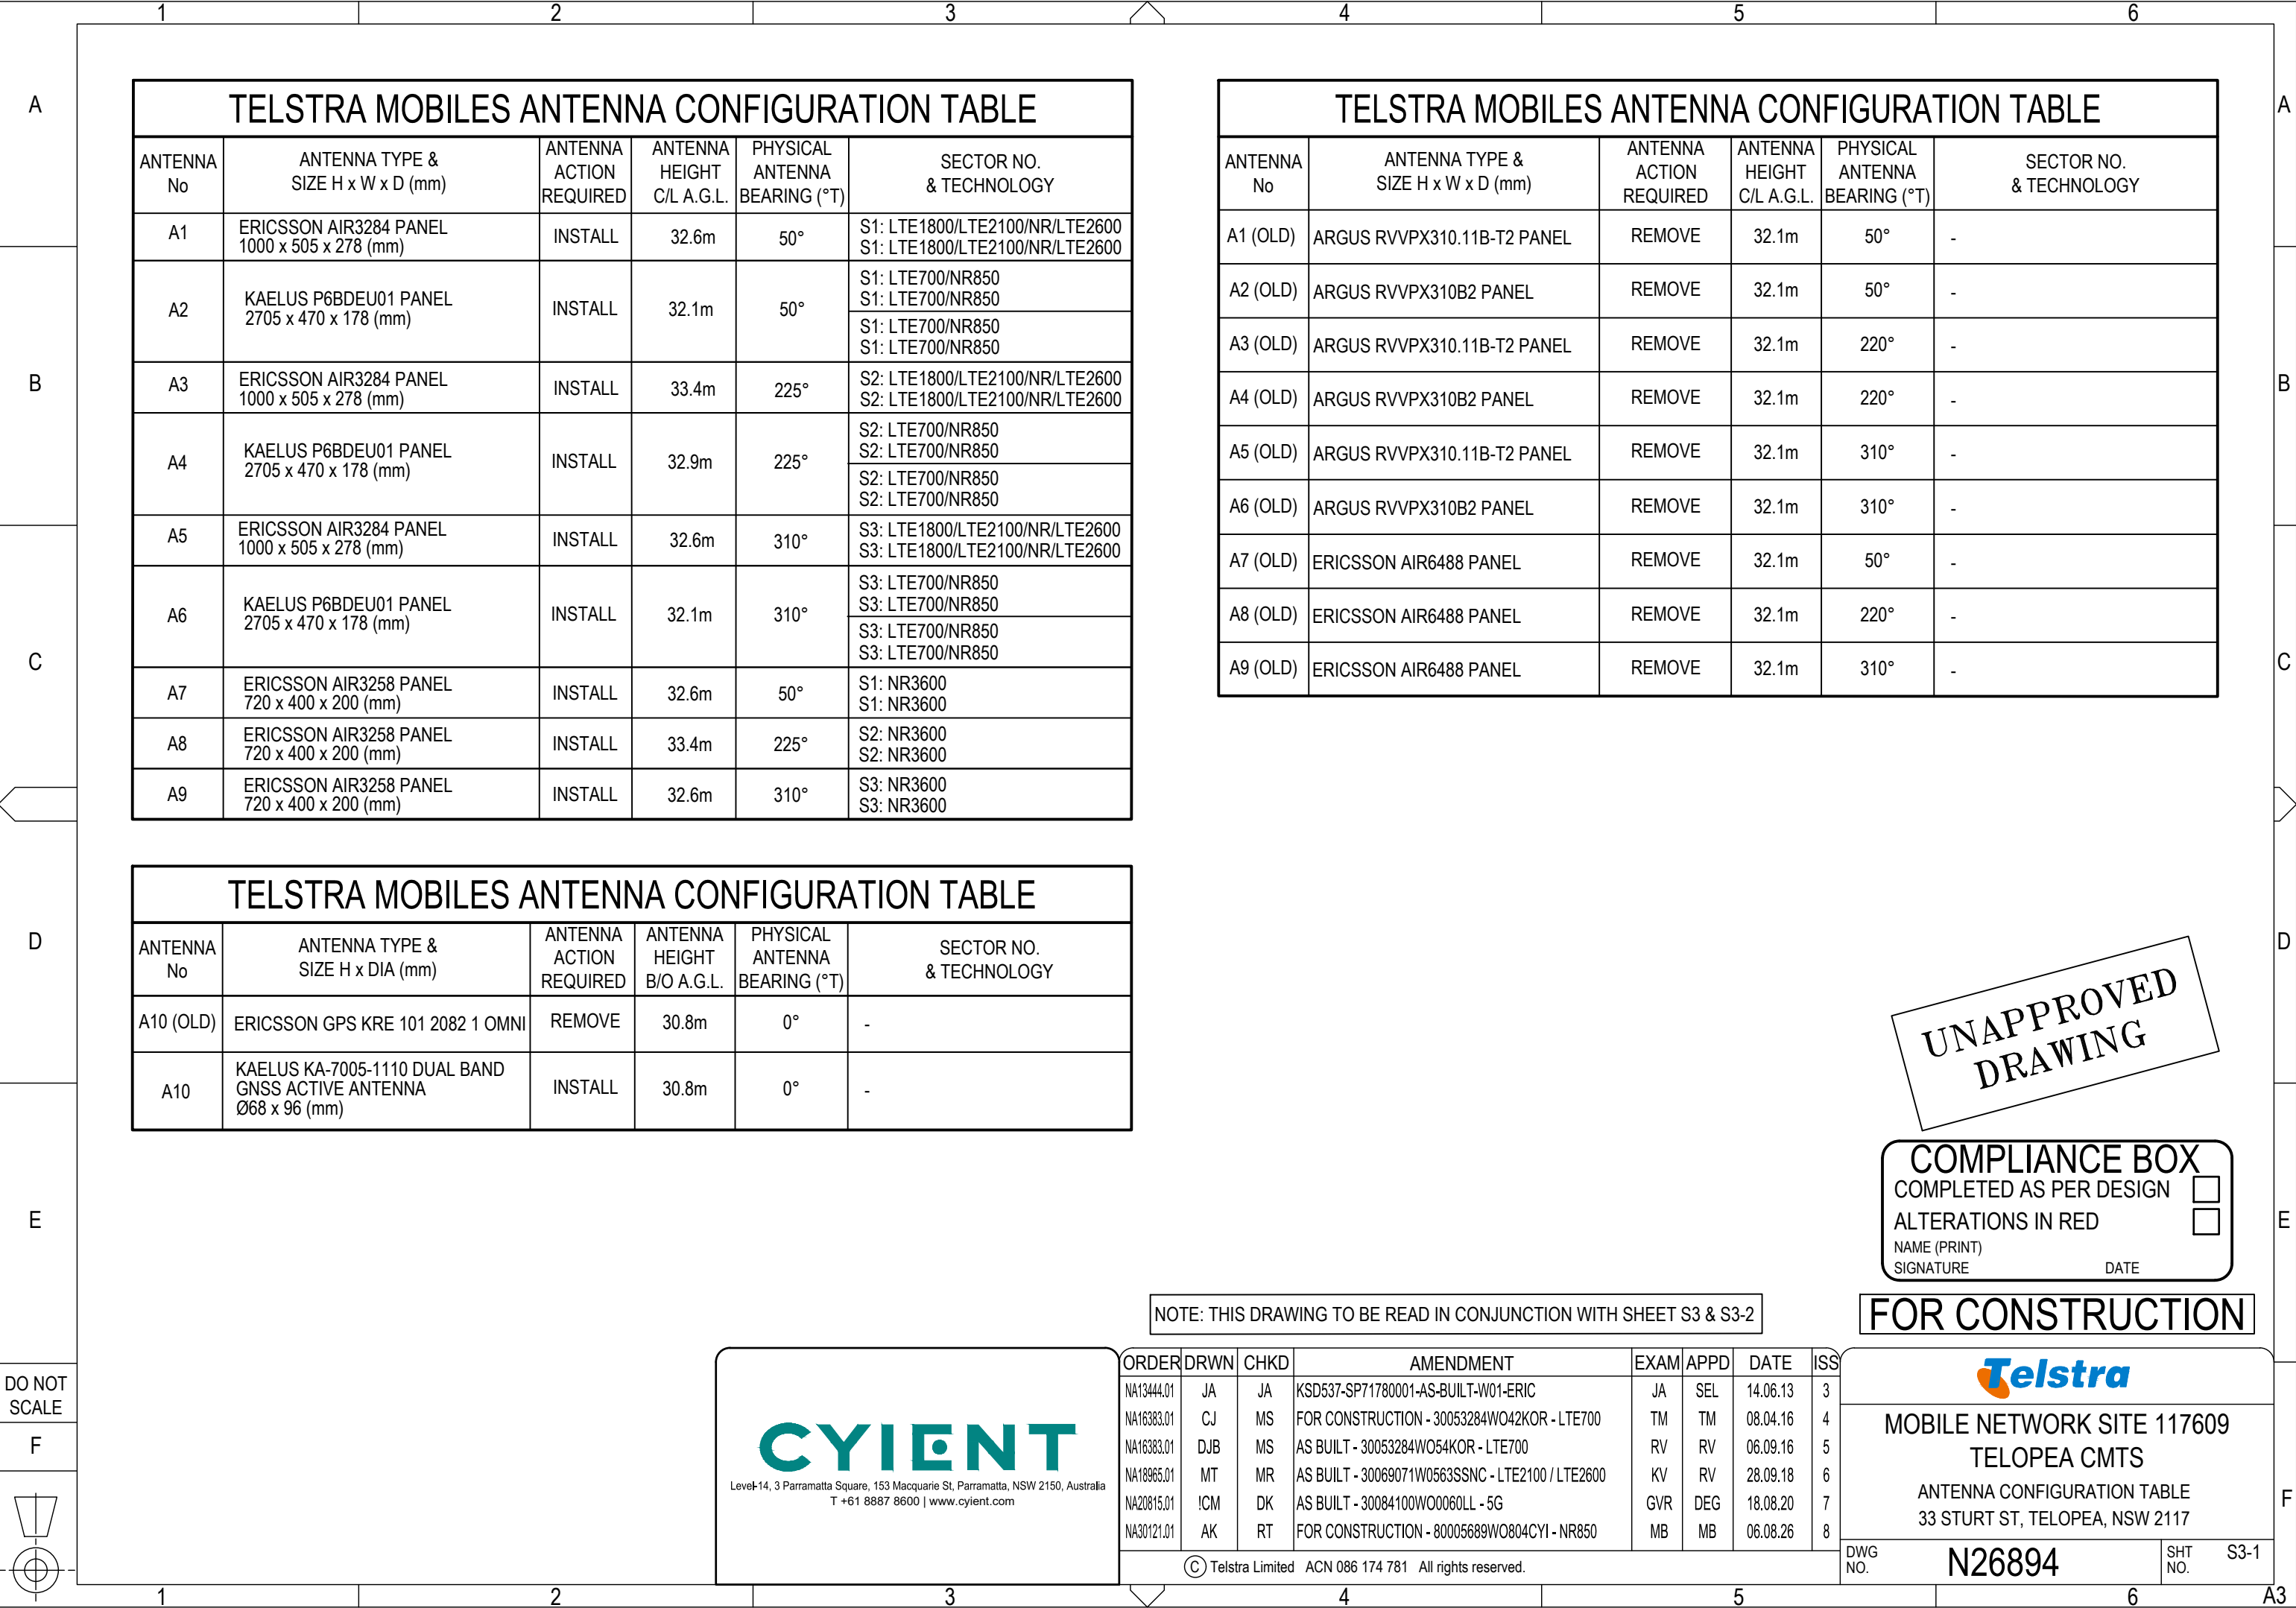

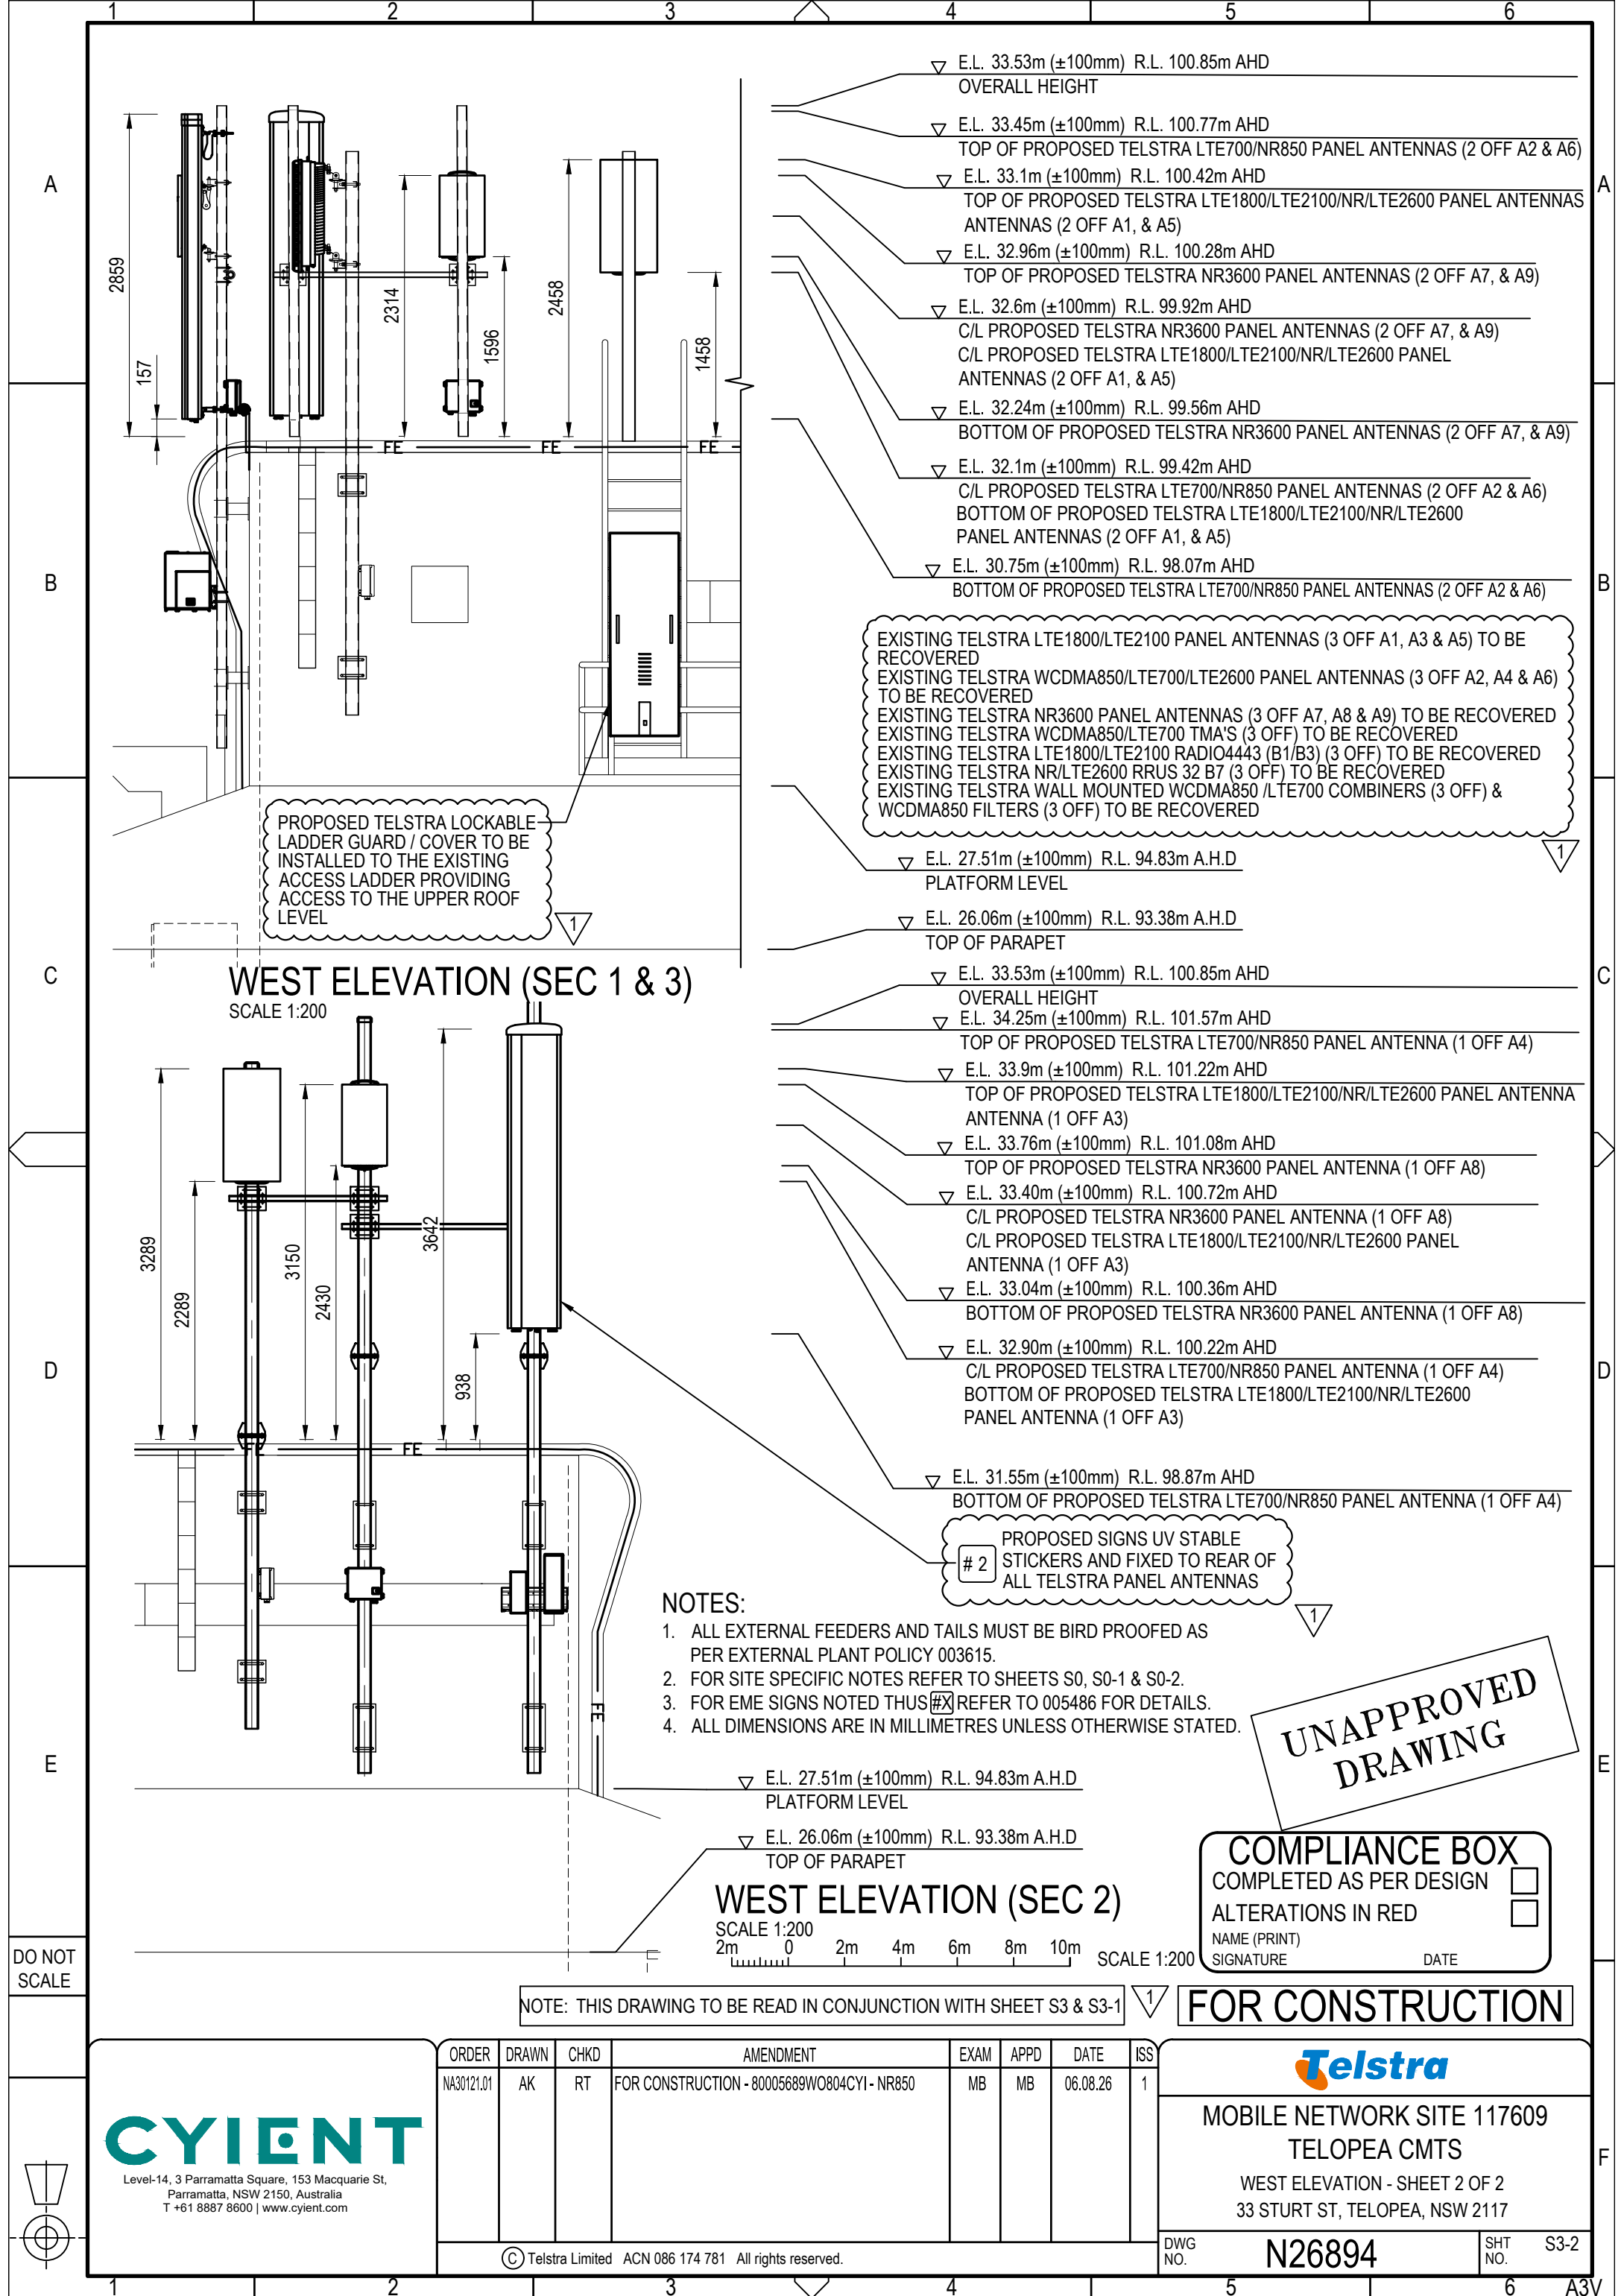

DO NOT
SCALE

CYIENT
Level-14, 3 Parramatta Square, 153 Macquarie St,
Parramatta, NSW 2150, Australia
T +61 8887 8600 | www.cyient.com

ORDER	DRAWN	CHKD	AMENDMENT	EXAM	APPD	DATE	ISS
NA30121.01	AK	RT	FOR CONSTRUCTION - 80005689W0804CY1 - NR850	MB	MB	06.08.26	1
© Telstra Limited ACN 086 174 781 All rights reserved.							

Telstra

MOBILE NETWORK SITE 117609
TELOPEA CMTS
WEST ELEVATION - SHEET 2 OF 2
33 STURT ST, TELOPEA, NSW 2117

DWG NO. **N26894** SHT NO. **S3-2**

**UNAPPROVED
DRAWING**

COMPLIANCE BOX

COMPLETED AS PER DESIGN

ALTERATIONS IN RED

NAME (PRINT)

SIGNATURE

DATE

FOR CONSTRUCTION

NOTE: THIS DRAWING TO BE READ IN CONJUNCTION WITH SHEET S3 & S3-1

NOTES:


- ALL EXTERNAL FEEDERS AND TAILS MUST BE BIRD PROOFED AS PER EXTERNAL PLANT POLICY 003615.
- FOR SITE SPECIFIC NOTES REFER TO SHEETS S0, S0-1 & S0-2.
- FOR EME SIGNS NOTED THUS REFER TO 005486 FOR DETAILS.
- ALL DIMENSIONS ARE IN MILLIMETRES UNLESS OTHERWISE STATED.

WEST ELEVATION (SEC 2)

SCALE 1:200
2m 0 2m 4m 6m 8m 10m

WEST ELEVATION (SEC 1 & 3)

SCALE 1:200

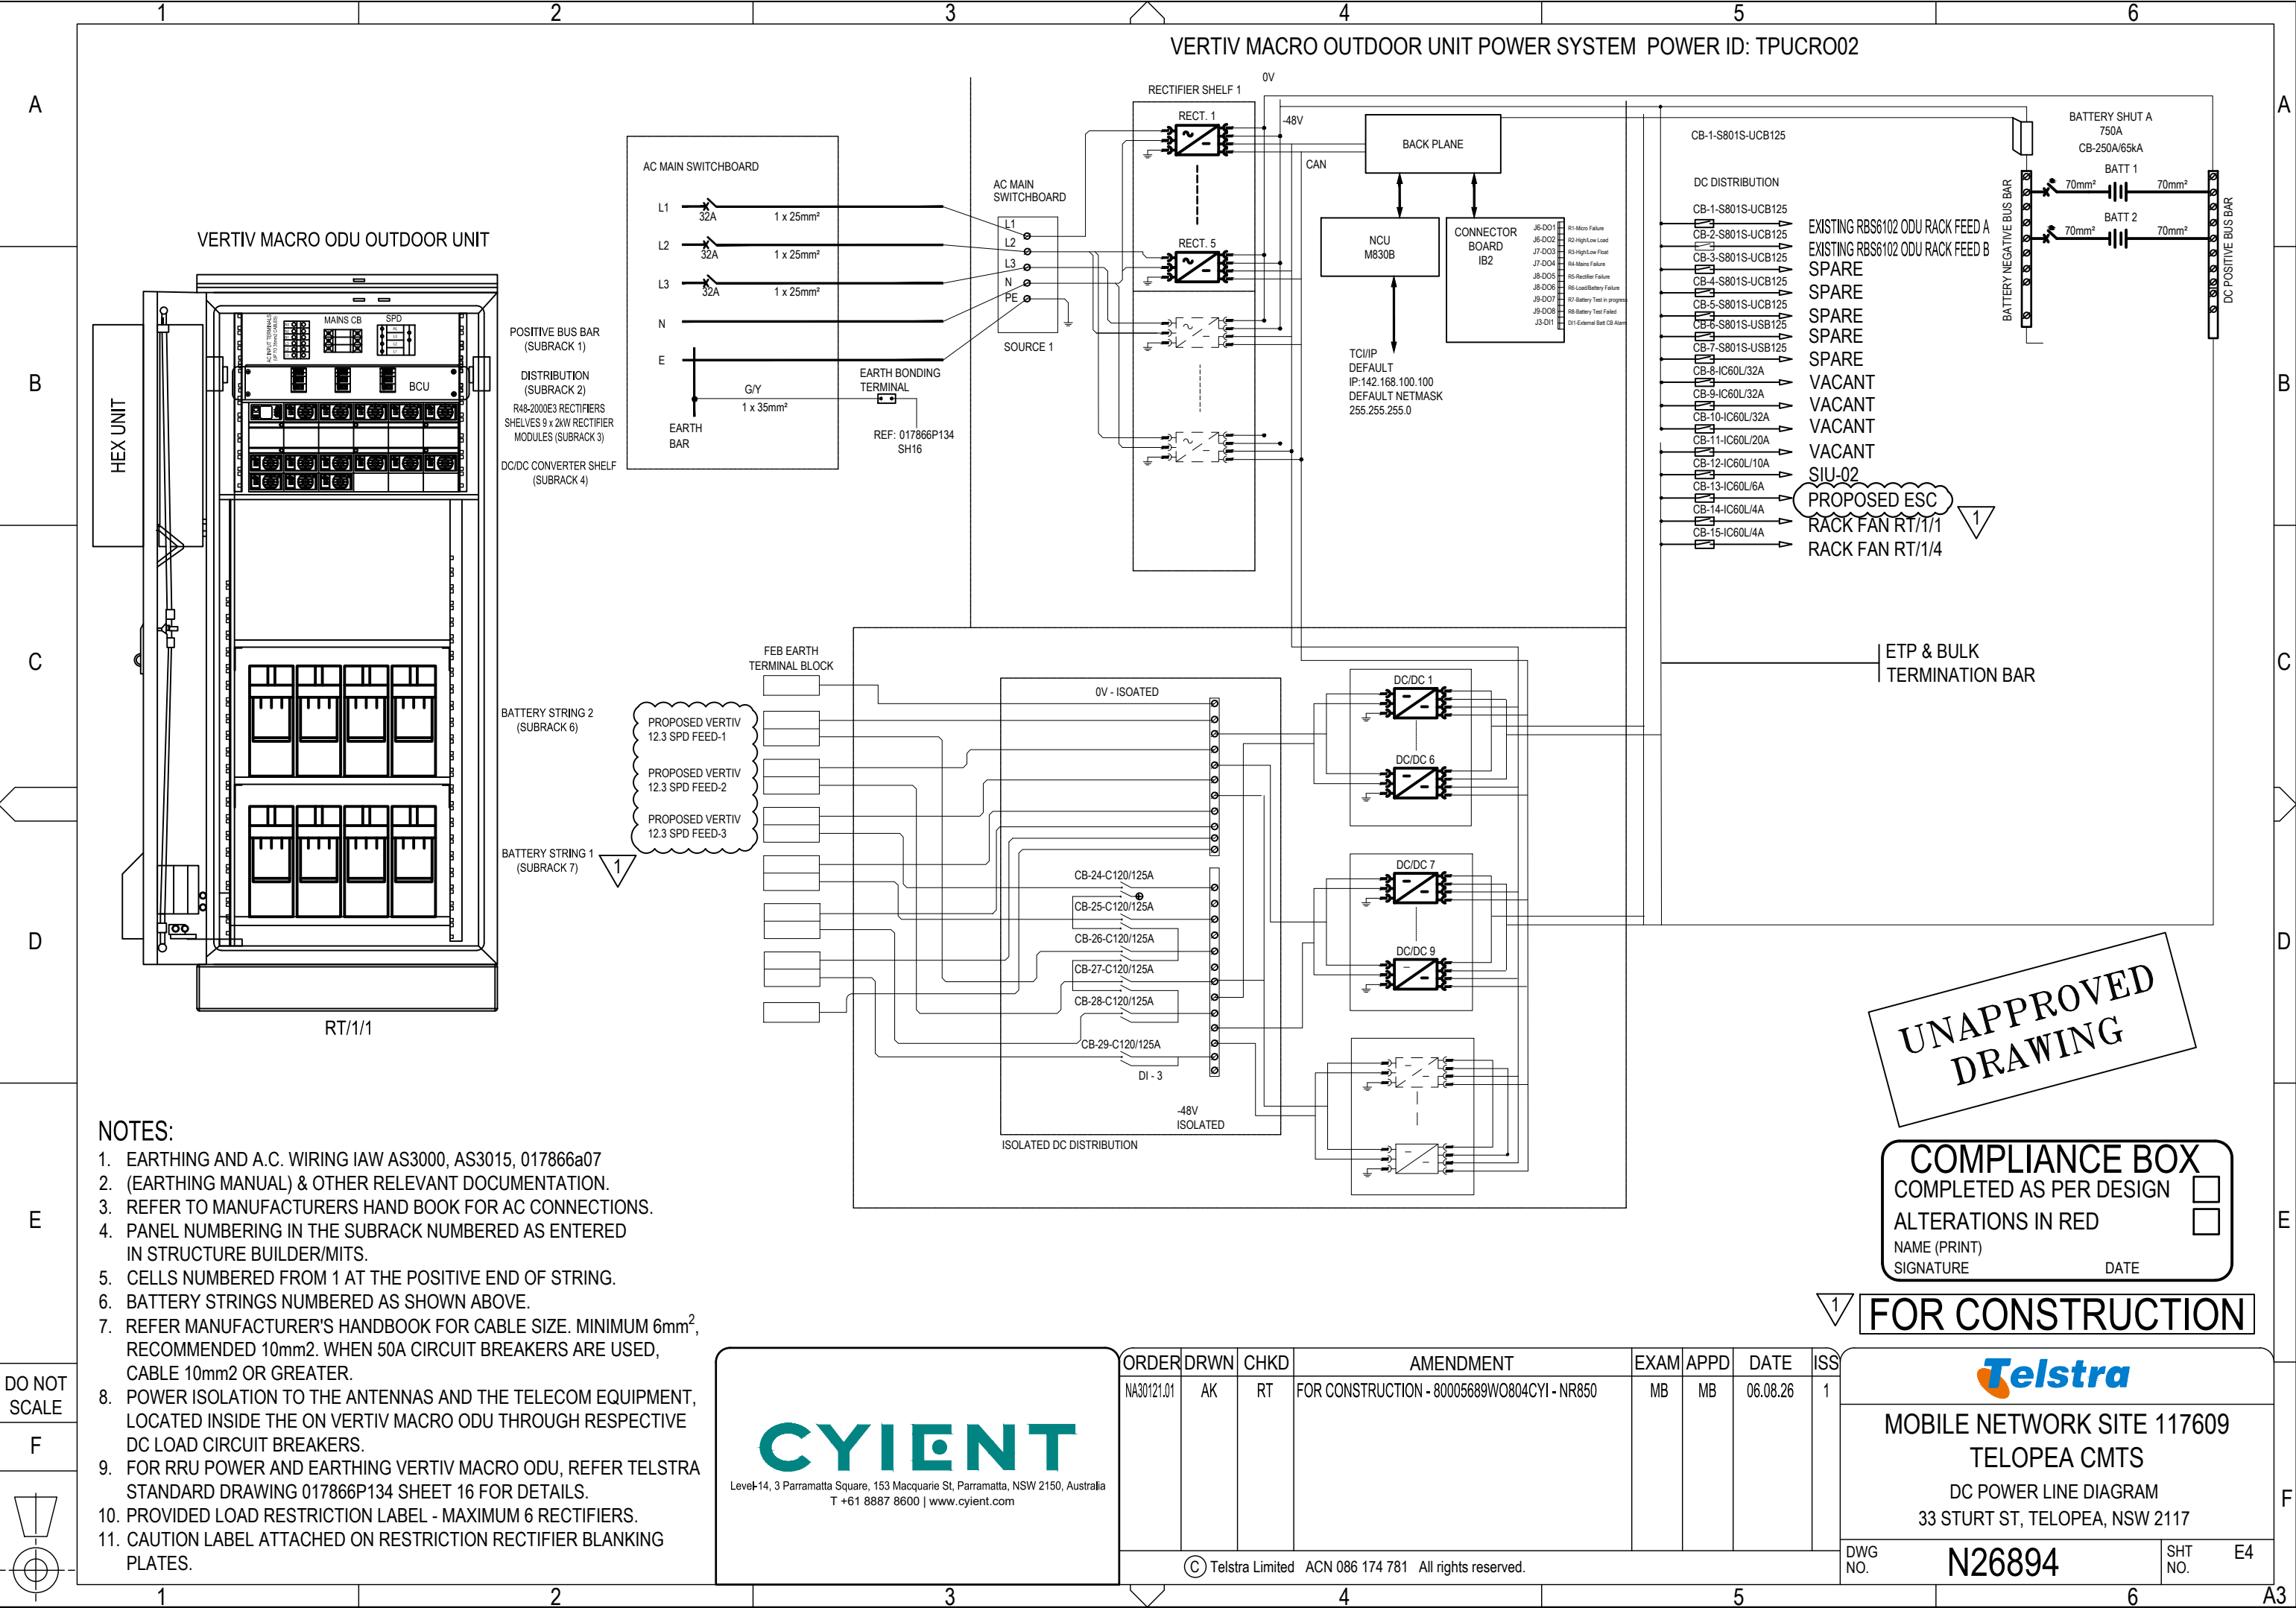

NOTES:

1. EARTHING AND A.C. WIRING IAW AS3000, AS3015, 017866a07
2. (EARTHING MANUAL) & OTHER RELEVANT DOCUMENTATION.
3. REFER TO MANUFACTURERS HAND BOOK FOR AC CONNECTIONS.
4. PANEL NUMBERING IN THE SUBRACK NUMBERED AS ENTERED IN STRUCTURE BUILDER/MITS.
5. CELLS NUMBERED FROM 1 AT THE POSITIVE END OF STRING.
6. BATTERY STRINGS NUMBERED AS SHOWN ABOVE.
7. REFER MANUFACTURER'S HANDBOOK FOR CABLE SIZE. MINIMUM 6mm², RECOMMENDED 10mm². WHEN 50A CIRCUIT BREAKERS ARE USED, CABLE 10mm² OR GREATER.
8. POWER ISOLATION TO THE ANTENNAS AND THE TELECOM EQUIPMENT, LOCATED INSIDE THE ON VERTIV MACRO ODU THROUGH RESPECTIVE DC LOAD CIRCUIT BREAKERS.
9. FOR RRU POWER AND EARTHING VERTIV MACRO ODU, REFER TELSTRA STANDARD DRAWING 017866P134 SHEET 16 FOR DETAILS.
10. PROVIDED LOAD RESTRICTION LABEL - MAXIMUM 6 RECTIFIERS.
11. CAUTION LABEL ATTACHED ON RESTRICTION RECTIFIER BLANKING PLATES.

CYIENT

Level-14, 3 Parramatta Square, 153 Macquarie St, Parramatta, NSW 2150, Australia
T +61 8887 8600 | www.cyient.com

ORDER	DRWN	CHKD	AMENDMENT	EXAM	APPD	DATE	ISS
NA30121.01	AK	RT	FOR CONSTRUCTION - 80005689W0804CYI - NR850	MB	MB	06.08.26	1


© Telstra Limited ACN 086 174 781 All rights reserved.


DWG NO.

N26894

SHT NO.

E4

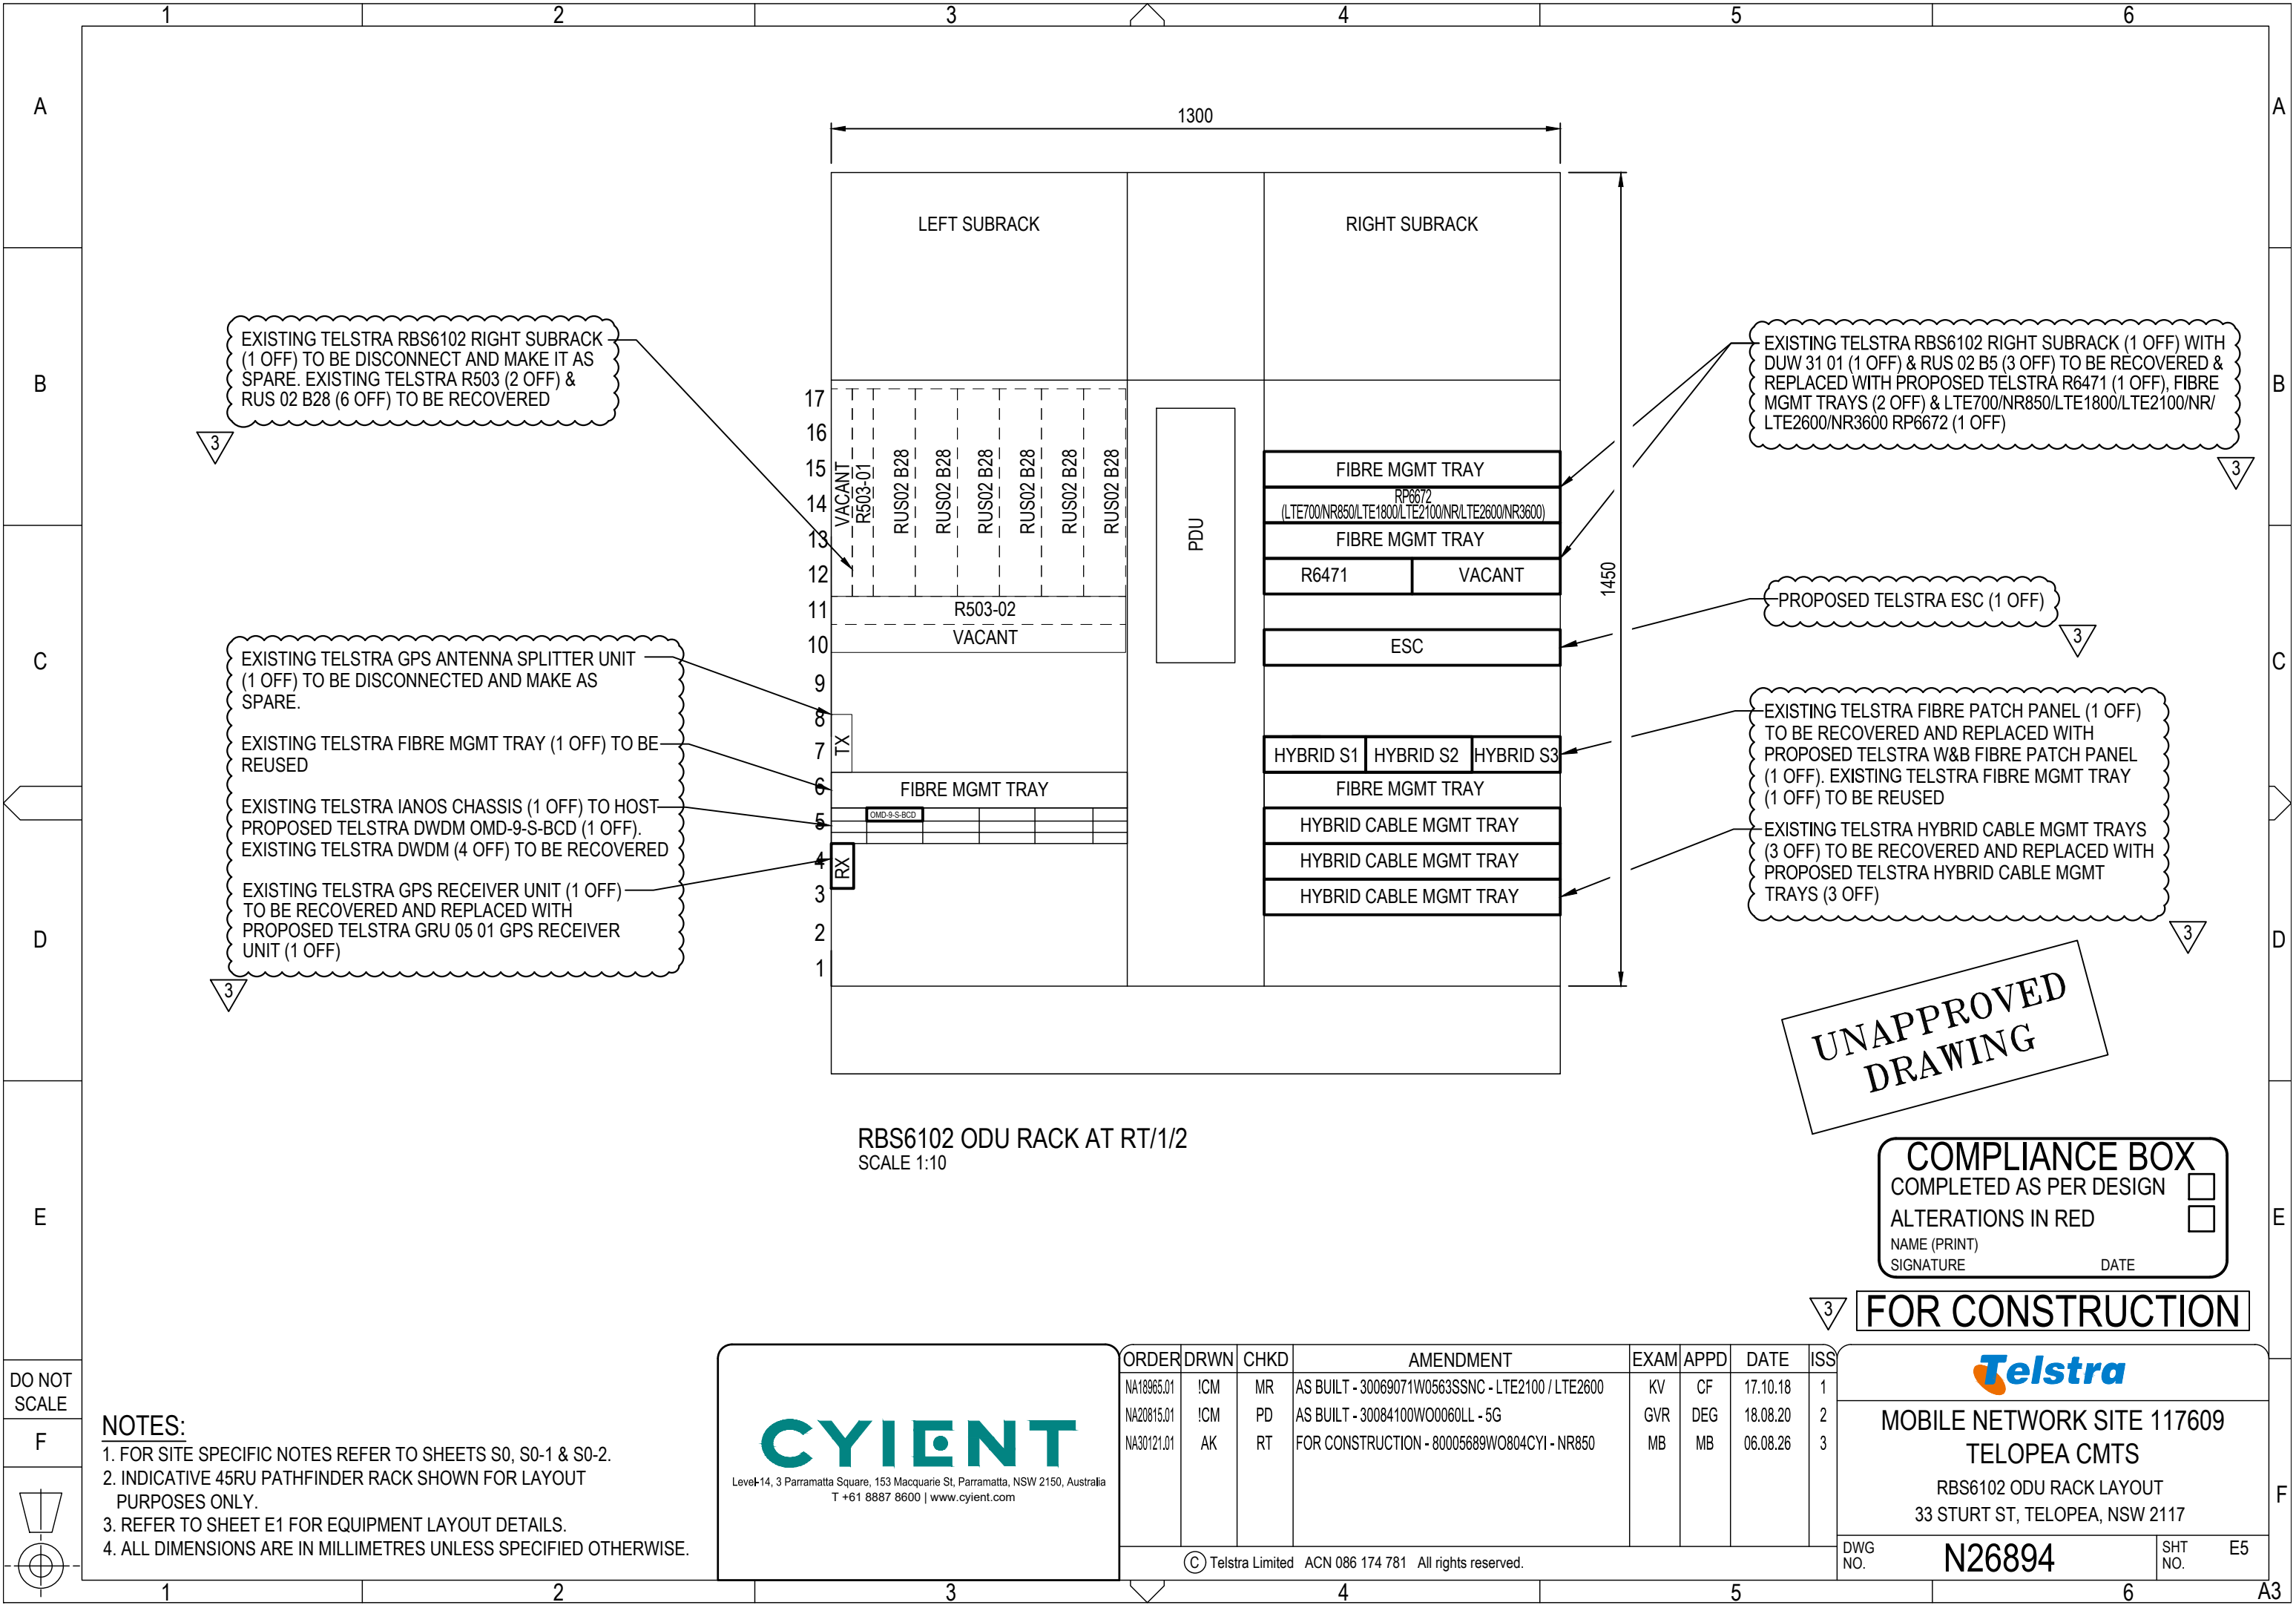

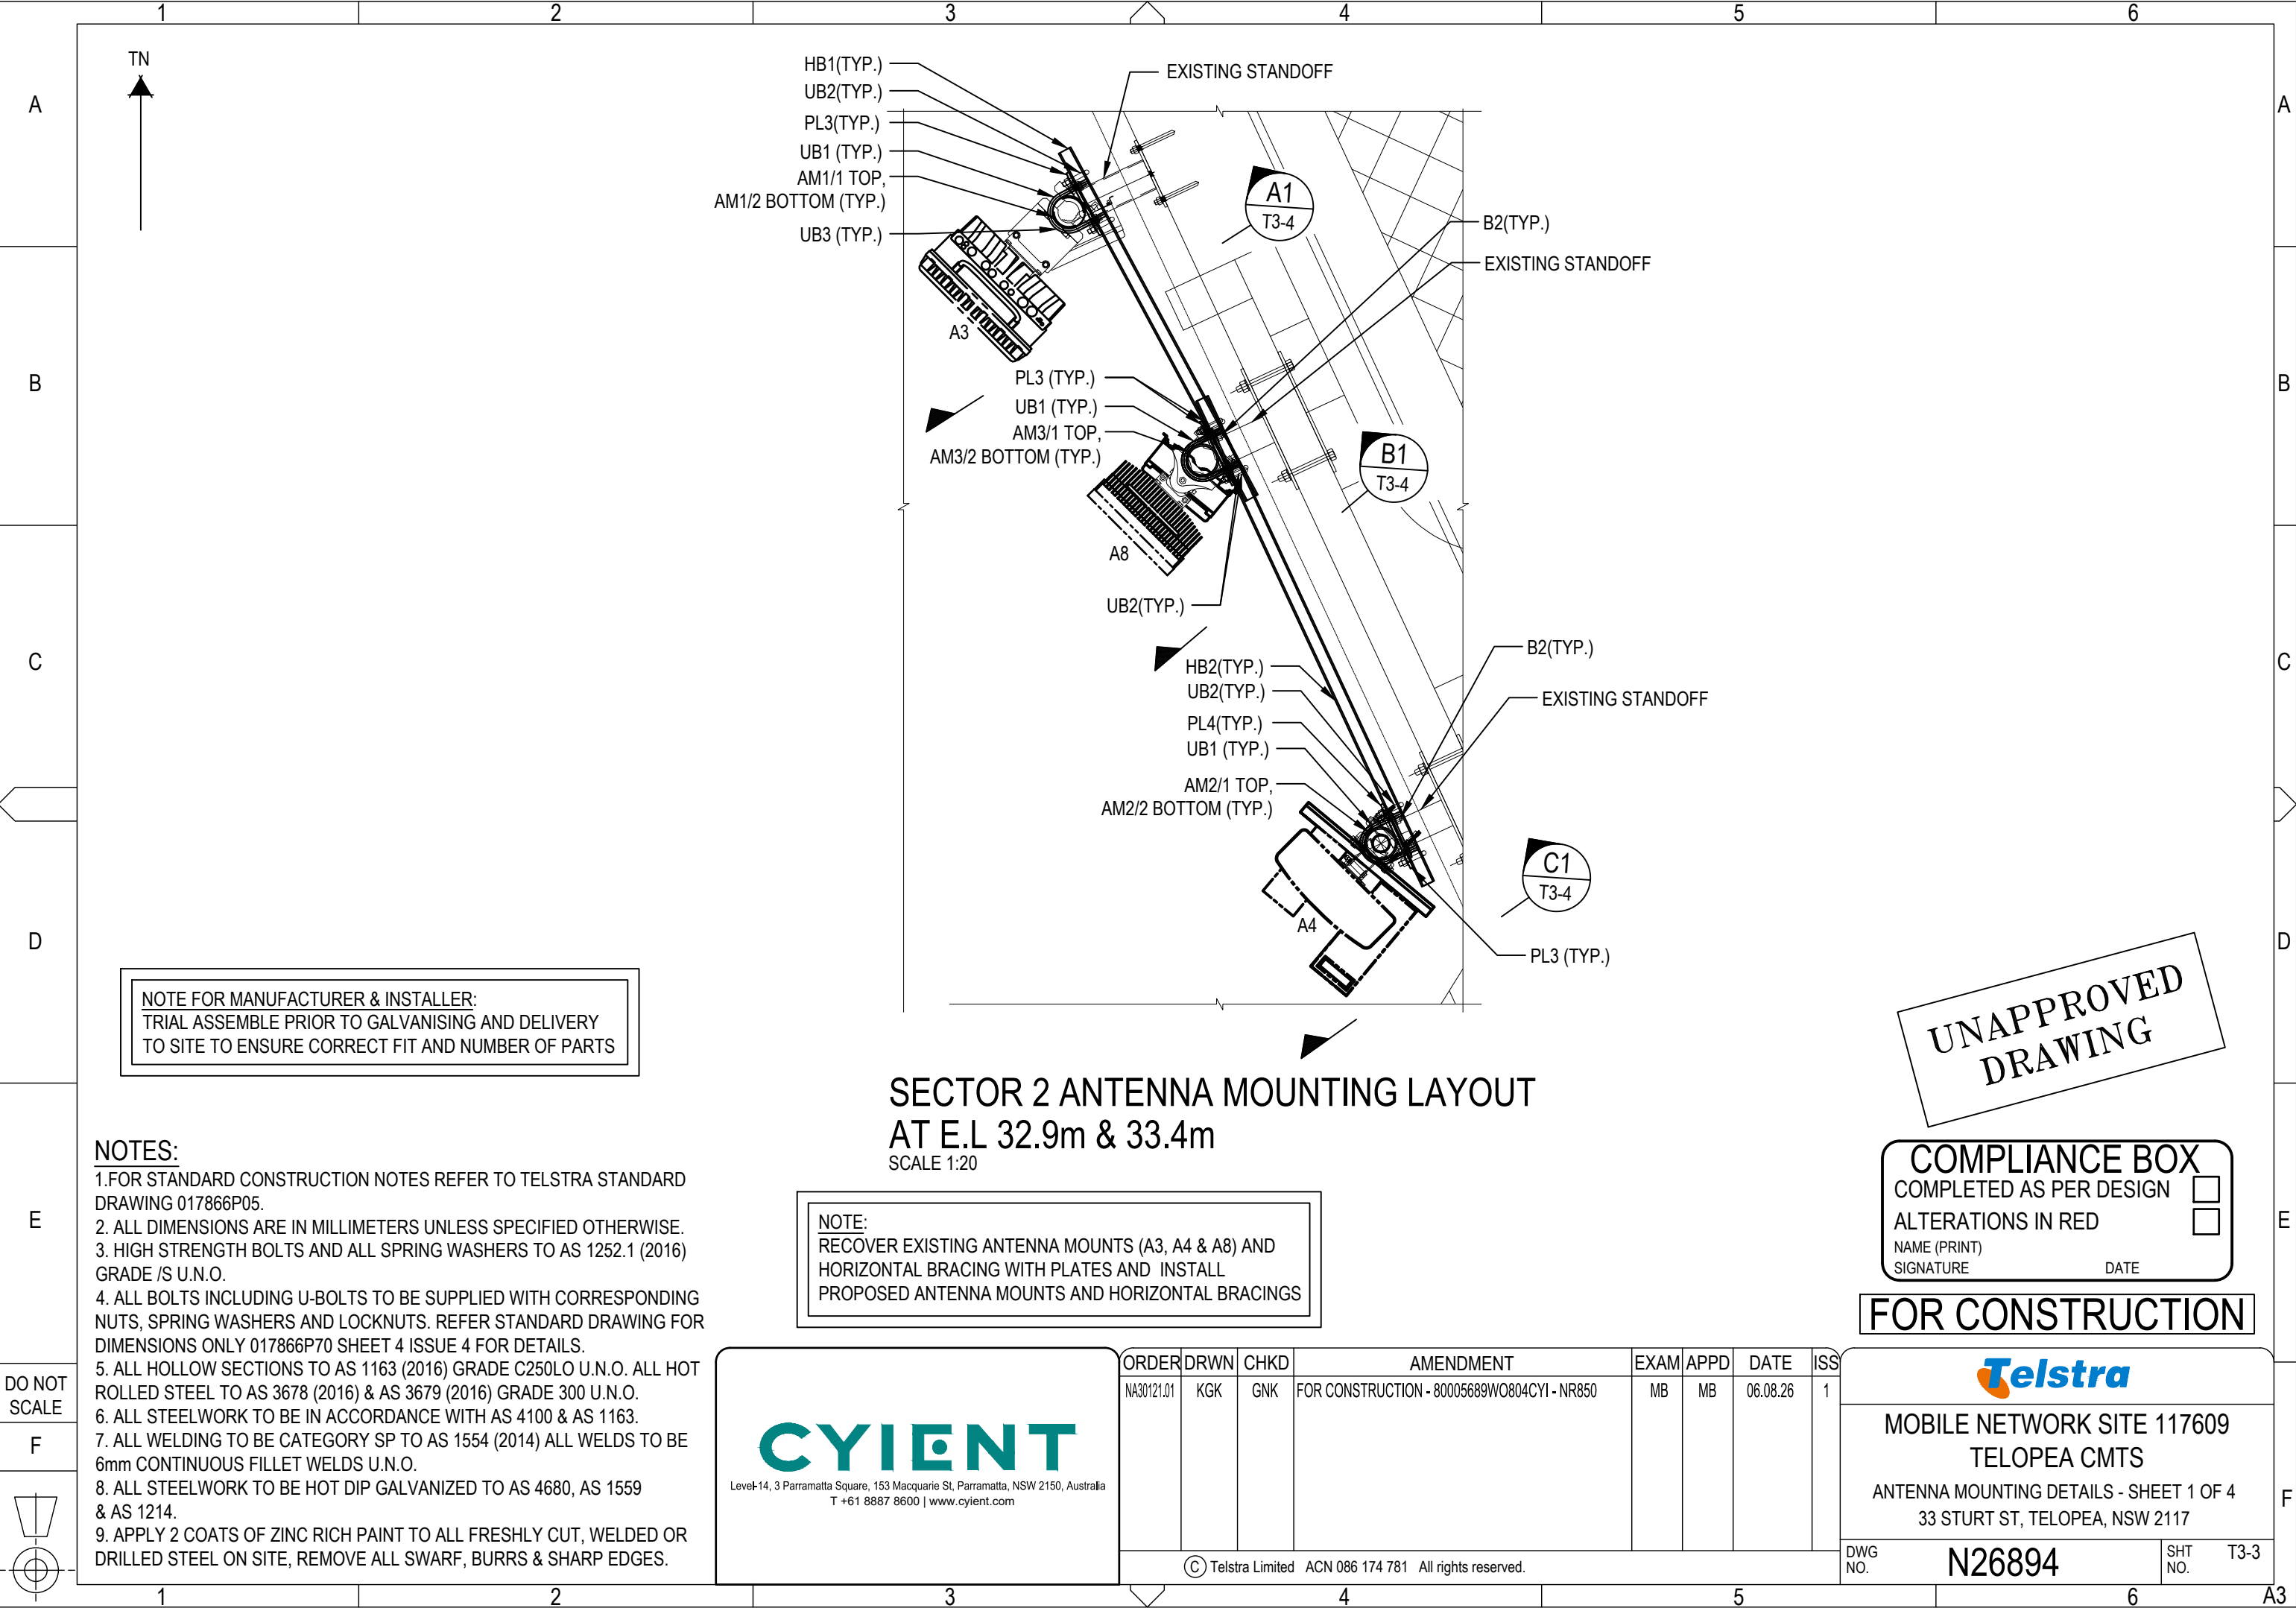

NOTE FOR MANUFACTURER & INSTALLER:
TRIAL ASSEMBLE PRIOR TO GALVANISING AND DELIVERY
TO SITE TO ENSURE CORRECT FIT AND NUMBER OF PARTS

- NOTES:**
- 1.FOR STANDARD CONSTRUCTION NOTES REFER TO TELSTRA STANDARD DRAWING 017866P05.
 - 2. ALL DIMENSIONS ARE IN MILLIMETERS UNLESS SPECIFIED OTHERWISE.
 - 3. HIGH STRENGTH BOLTS AND ALL SPRING WASHERS TO AS 1252.1 (2016) GRADE /S U.N.O.
 - 4. ALL BOLTS INCLUDING U-BOLTS TO BE SUPPLIED WITH CORRESPONDING NUTS, SPRING WASHERS AND LOCKNUTS. REFER STANDARD DRAWING FOR DIMENSIONS ONLY 017866P70 SHEET 4 ISSUE 4 FOR DETAILS.
 - 5. ALL HOLLOW SECTIONS TO AS 1163 (2016) GRADE C250LO U.N.O. ALL HOT ROLLED STEEL TO AS 3678 (2016) & AS 3679 (2016) GRADE 300 U.N.O.
 - 6. ALL STEELWORK TO BE IN ACCORDANCE WITH AS 4100 & AS 1163.
 - 7. ALL WELDING TO BE CATEGORY SP TO AS 1554 (2014) ALL WELDS TO BE 6mm CONTINUOUS FILLET WELDS U.N.O.
 - 8. ALL STEELWORK TO BE HOT DIP GALVANIZED TO AS 4680, AS 1559 & AS 1214.
 - 9. APPLY 2 COATS OF ZINC RICH PAINT TO ALL FRESHLY CUT, WELDED OR DRILLED STEEL ON SITE, REMOVE ALL SWARF, BURRS & SHARP EDGES.

NOTE:
RECOVER EXISTING ANTENNA MOUNTS (A3, A4 & A8) AND
HORIZONTAL BRACING WITH PLATES AND INSTALL
PROPOSED ANTENNA MOUNTS AND HORIZONTAL BRACINGS

CYIENT

Level-14, 3 Parramatta Square, 153 Macquarie St, Parramatta, NSW 2150, Australia
T +61 8887 8600 | www.cyient.com

ORDER	DRWN	CHKD	AMENDMENT	EXAM	APPD	DATE	ISS
NA30121.01	KGK	GNK	FOR CONSTRUCTION - 80005689W0804CYI - NR850	MB	MB	06.08.26	1

© Telstra Limited ACN 086 174 781 All rights reserved.

UNAPPROVED
DRAWING

COMPLIANCE BOX
COMPLETED AS PER DESIGN ☐
ALTERATIONS IN RED ☐
NAME (PRINT) _____
SIGNATURE _____ DATE _____

FOR CONSTRUCTION

Telstra


MOBILE NETWORK SITE 117609
TELOPEA CMTS
ANTENNA MOUNTING DETAILS - SHEET 1 OF 4
33 STURT ST, TELOPEA, NSW 2117

DWG
NO.

N26894

SHT
NO.

T3-3

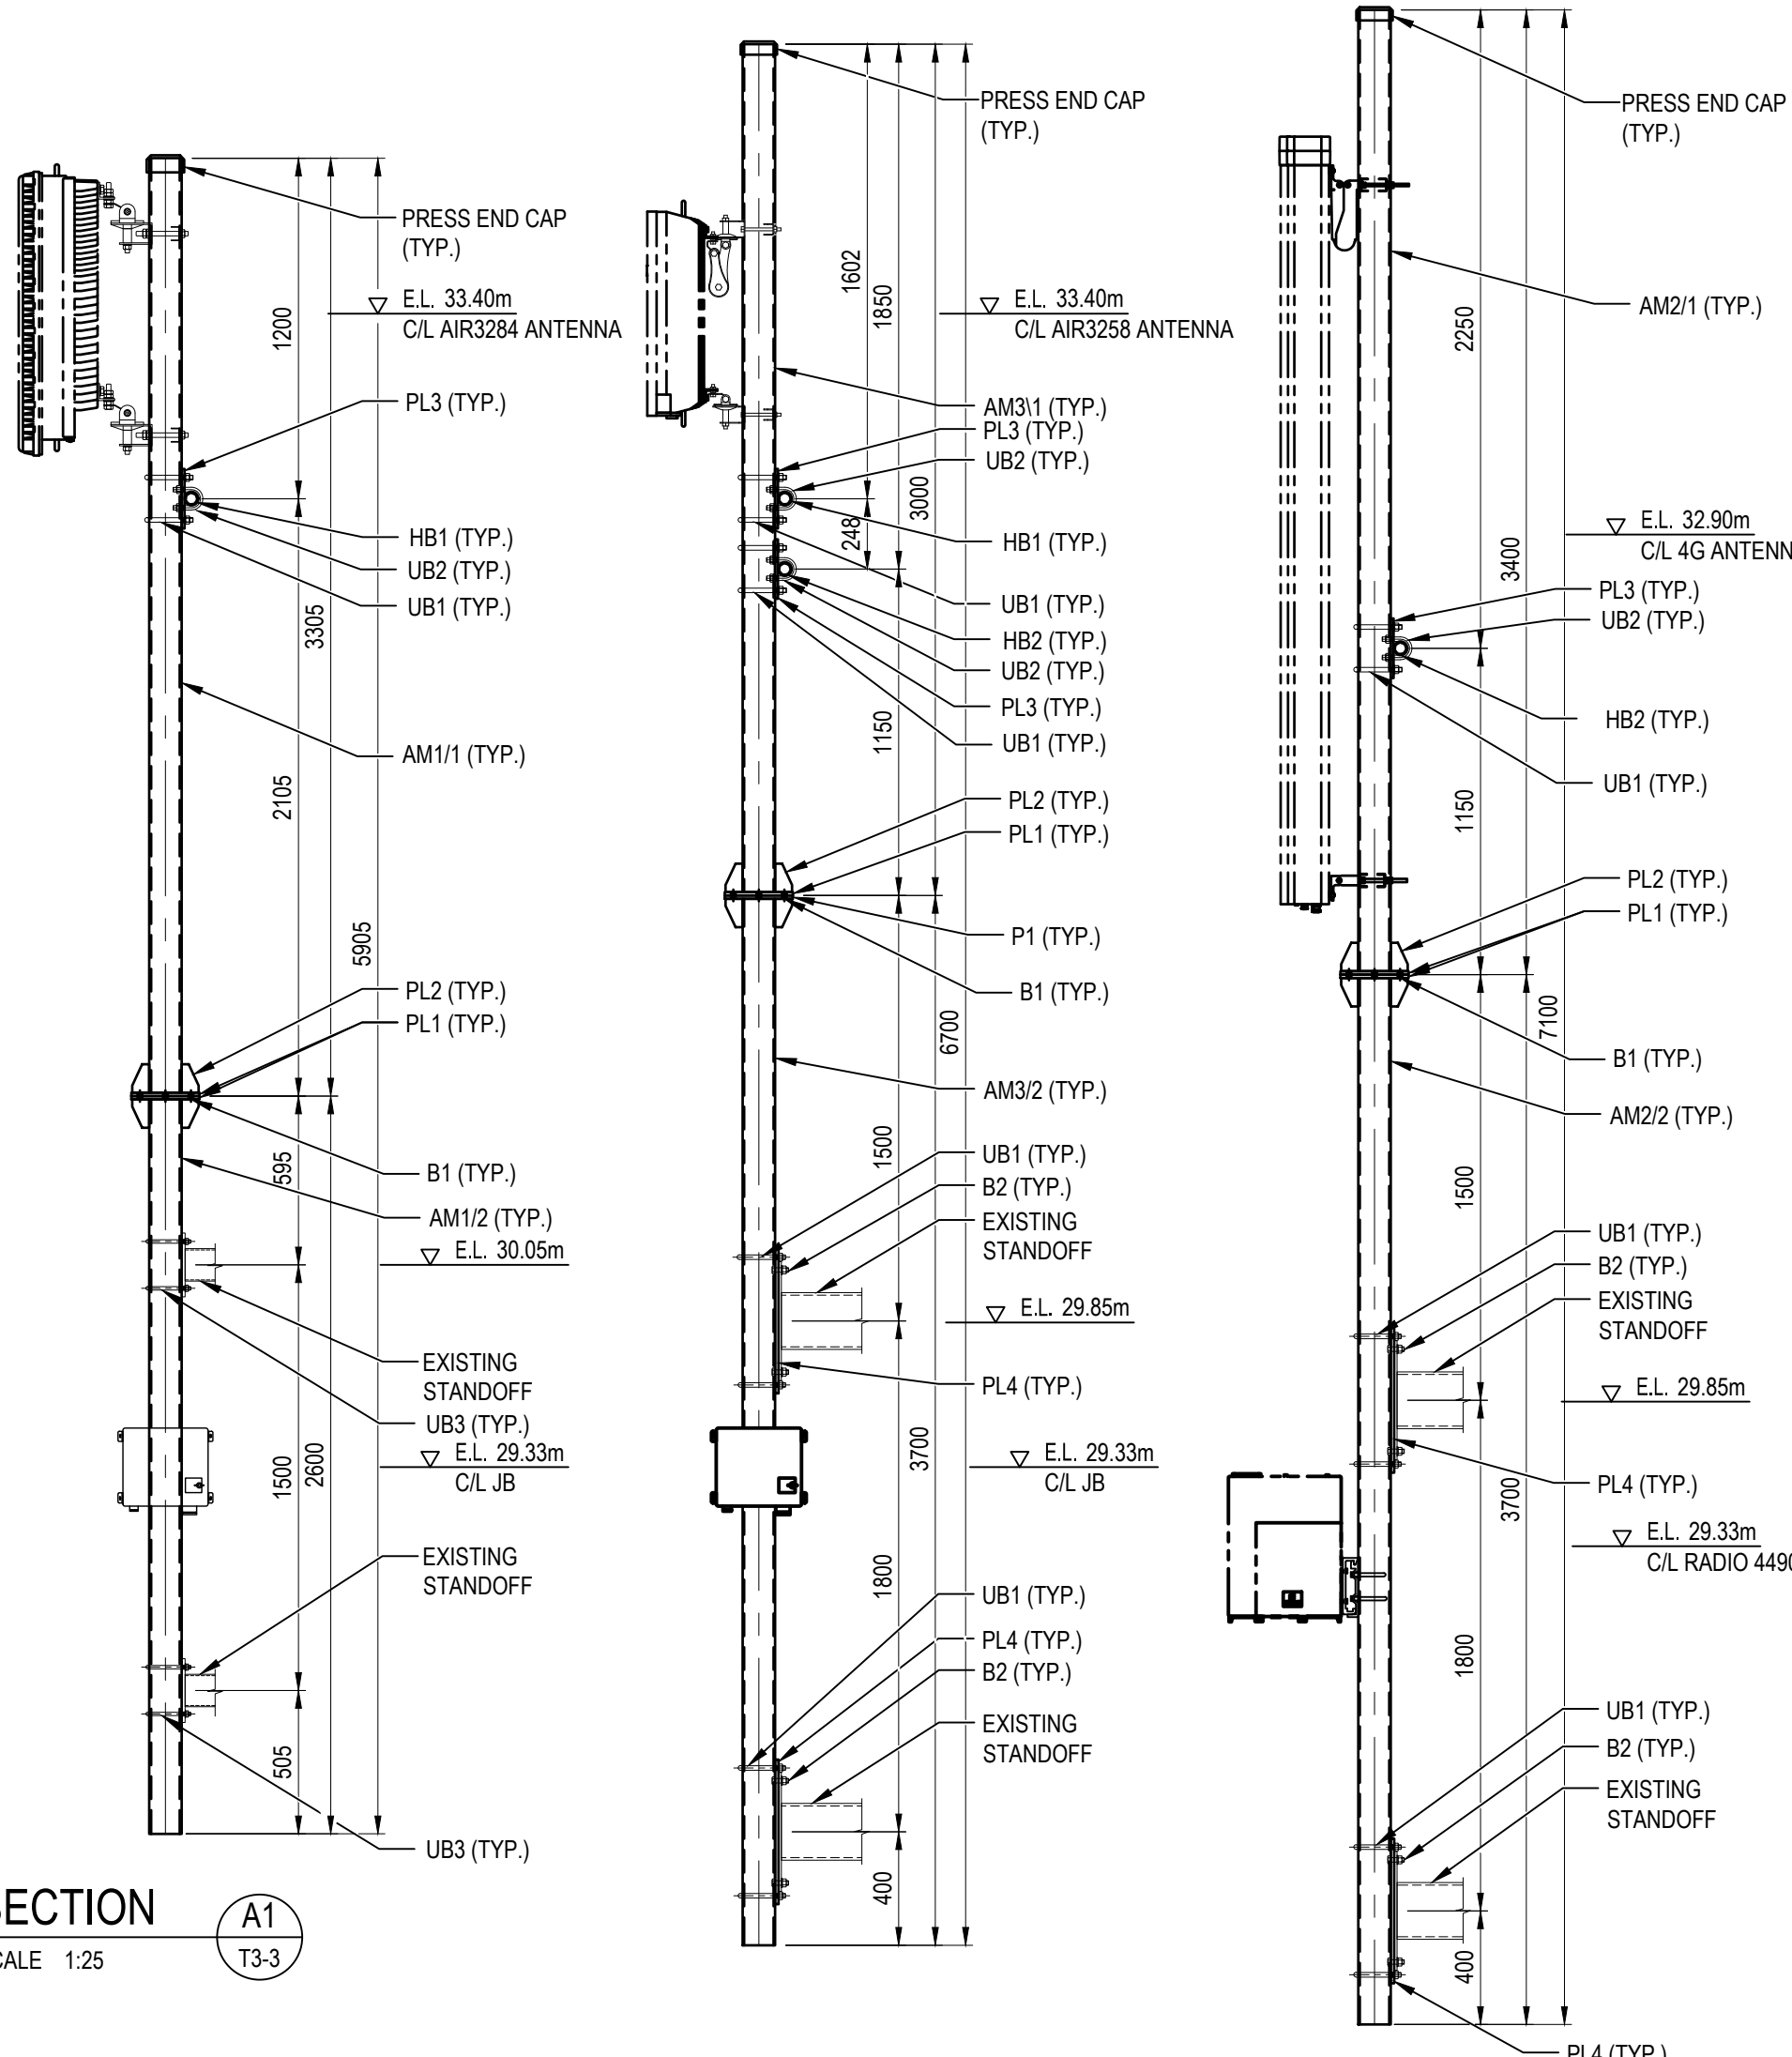

SECTION A1
SCALE 1:25
T3-3

SECTION B1
SCALE 1:25
T3-3

SECTION C1
SCALE 1:25
T3-3

NOTE FOR MANUFACTURER & INSTALLER:
TRIAL ASSEMBLE PRIOR TO GALVANISING AND DELIVERY
TO SITE TO ENSURE CORRECT FIT AND NUMBER OF PARTS

UNAPPROVED
DRAWING

COMPLIANCE BOX
COMPLETED AS PER DESIGN ☐
ALTERATIONS IN RED ☐
NAME (PRINT) _____
SIGNATURE _____ DATE _____

FOR CONSTRUCTION


CYIENT
Level-14, 3 Parramatta Square, 153 Macquarie St,
Parramatta, NSW 2150, Australia
T +61 8887 8600 | www.cyient.com

ORDER	DRAWN	CHKD	AMENDMENT	EXAM	APPD	DATE	ISS
NA30121.01	KGK	GNK	FOR CONSTRUCTION - 80005689W/O804CYI - NR850	MB	MB	06.08.26	1
© Telstra Limited ACN 086 174 781 All rights reserved.							



MOBILE NETWORK SITE 117609
TELOPEA CMTS
ANTENNA MOUNTING DETAILS - SHEET 2 OF 4
33 STURT ST, TELOPEA, NSW 2117

DWG NO. N26894 SHT NO. T3-4

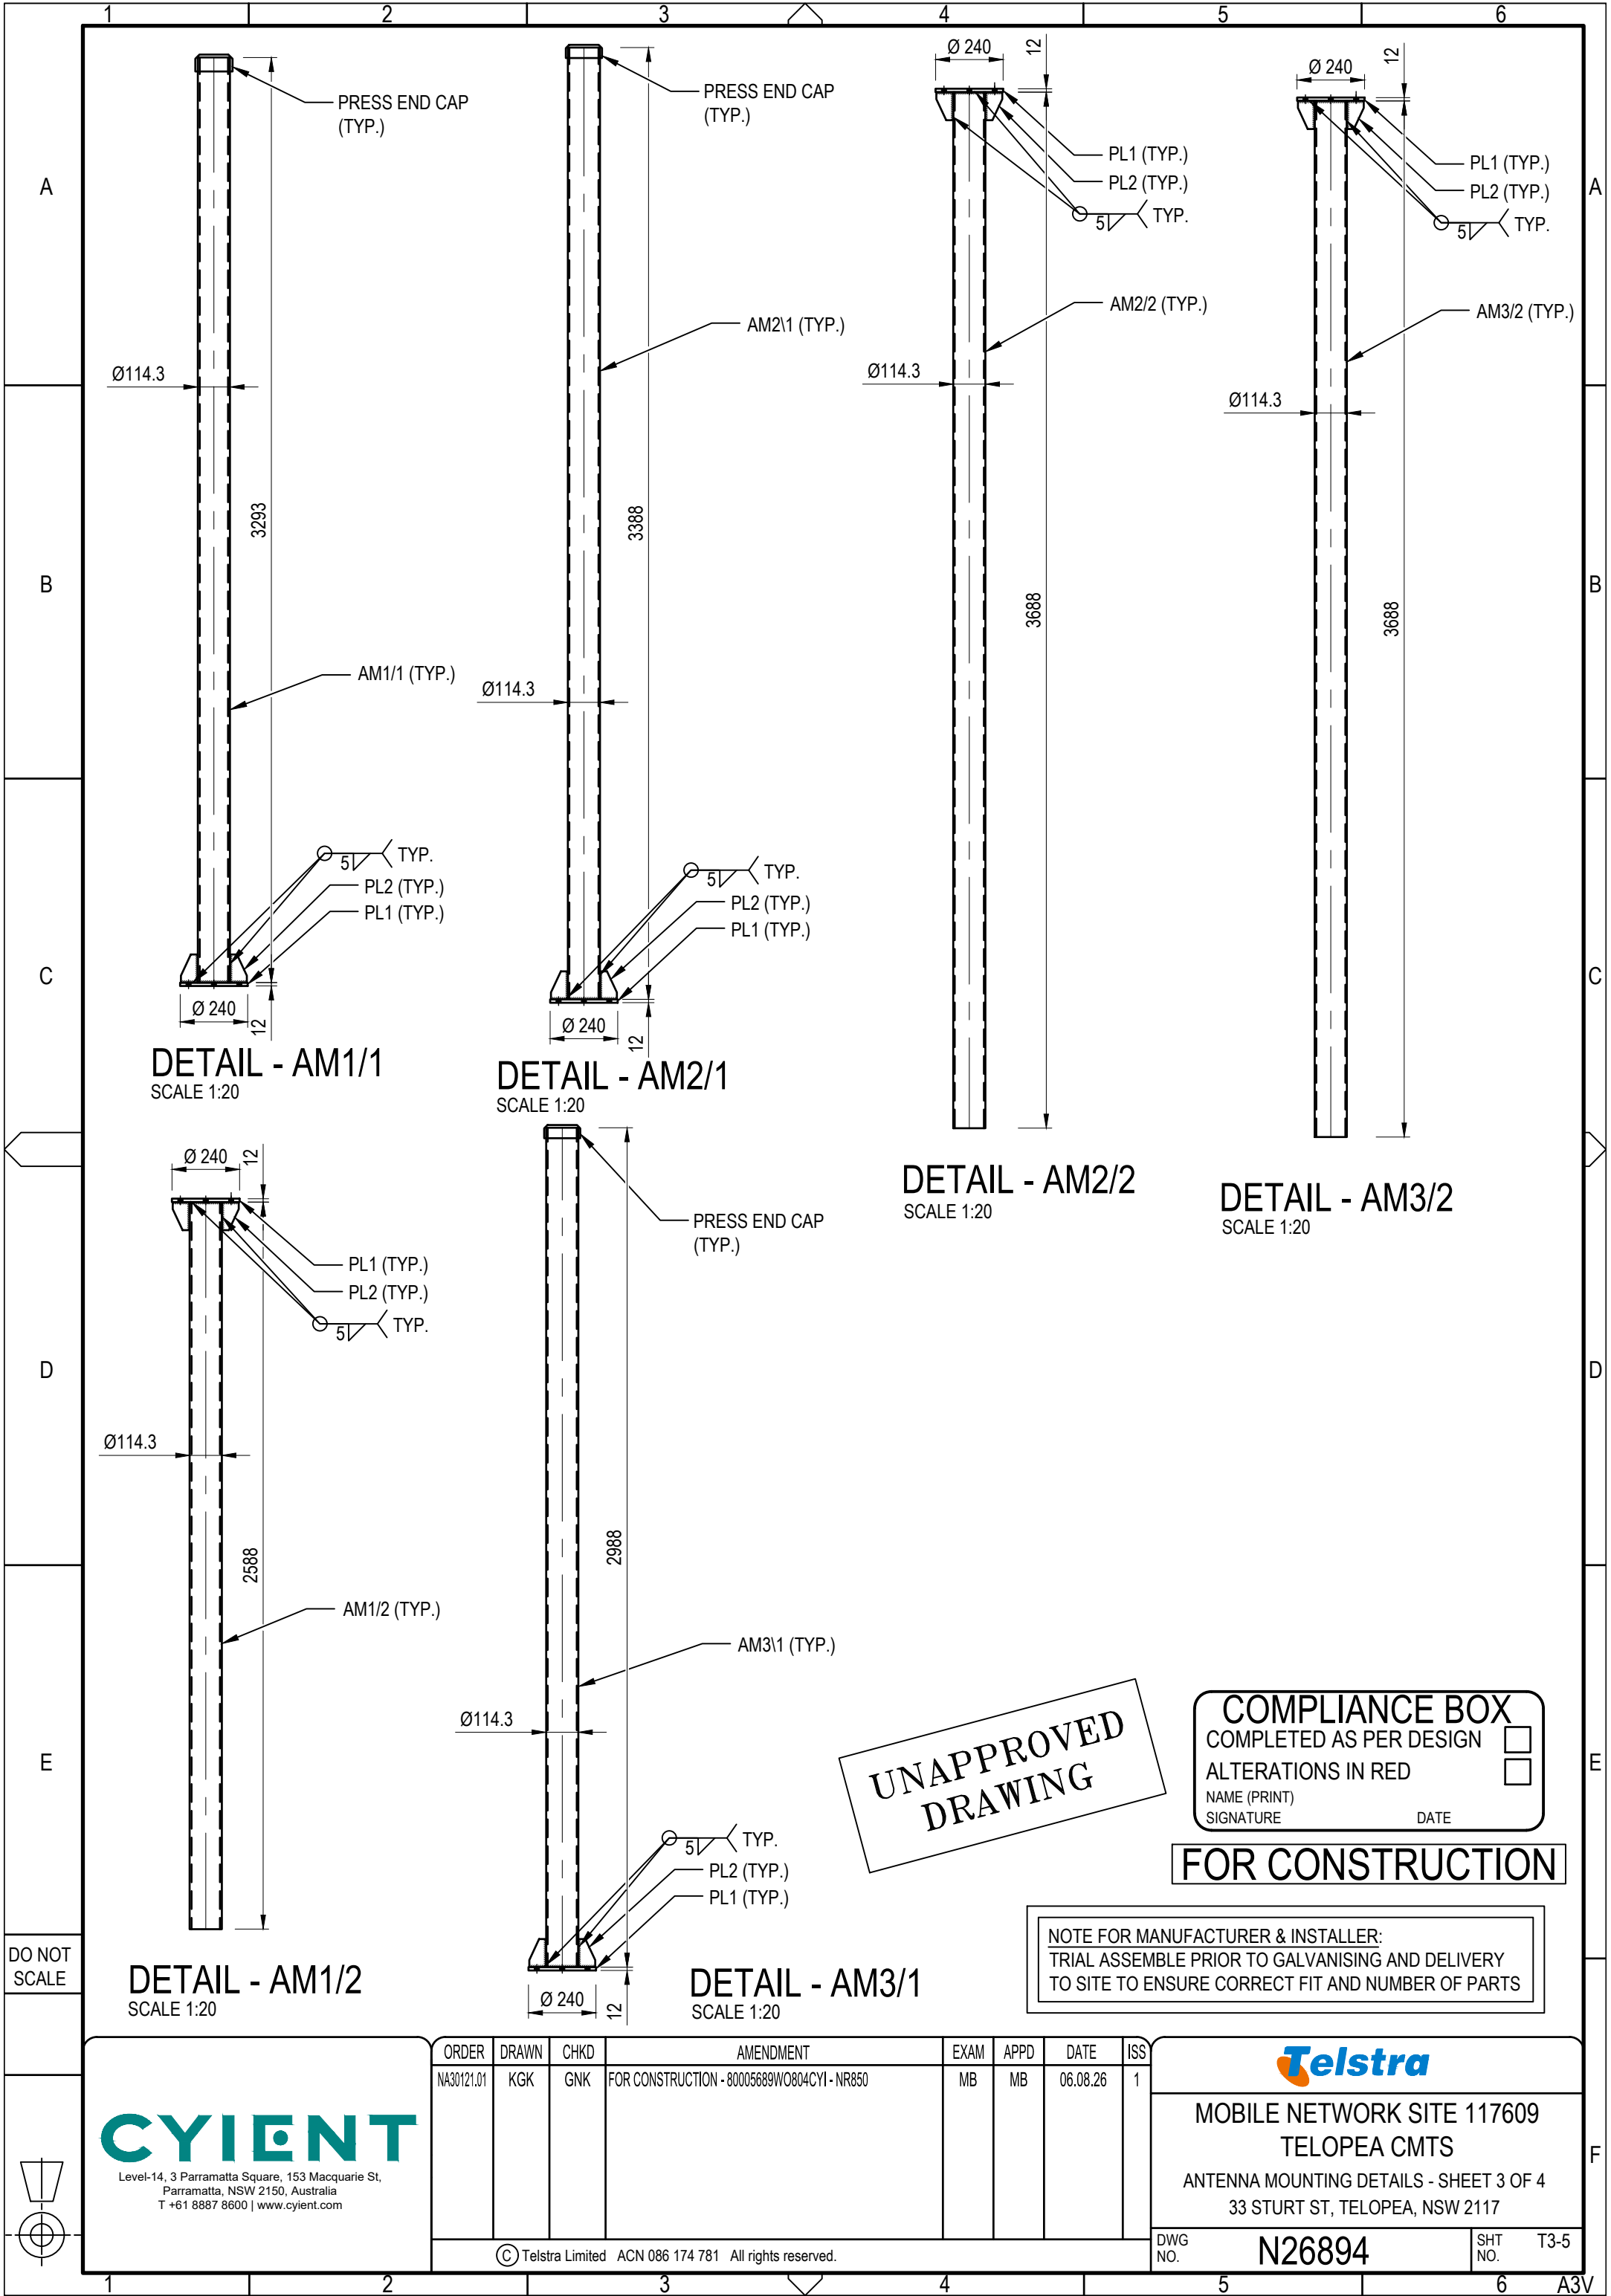

DETAIL - AM1/1
SCALE 1:20

DETAIL - AM2/1
SCALE 1:20

DETAIL - AM2/2
SCALE 1:20

DETAIL - AM3/2
SCALE 1:20

DETAIL - AM1/2
SCALE 1:20

DETAIL - AM3/1
SCALE 1:20

UNAPPROVED
DRAWING

COMPLIANCE BOX	
COMPLETED AS PER DESIGN	☐
ALTERATIONS IN RED	☐
NAME (PRINT)	
SIGNATURE	DATE

FOR CONSTRUCTION

NOTE FOR MANUFACTURER & INSTALLER:
TRIAL ASSEMBLE PRIOR TO GALVANISING AND DELIVERY
TO SITE TO ENSURE CORRECT FIT AND NUMBER OF PARTS






CYIENT
Level-14, 3 Parramatta Square, 153 Macquarie St,
Parramatta, NSW 2150, Australia
T +61 8887 8600 | www.cyient.com

ORDER	DRAWN	CHKD	AMENDMENT	EXAM	APPD	DATE	ISS
NA30121.01	KGK	GNK	FOR CONSTRUCTION - 80005689W0804CYI - NR850	MB	MB	06.08.26	1
© Telstra Limited ACN 086 174 781 All rights reserved.							



MOBILE NETWORK SITE 117609
TELOPEA CMTS
ANTENNA MOUNTING DETAILS - SHEET 3 OF 4
33 STURT ST, TELOPEA, NSW 2117

DWG NO.	N26894	SHT NO.	T3-5
---------	--------	---------	------

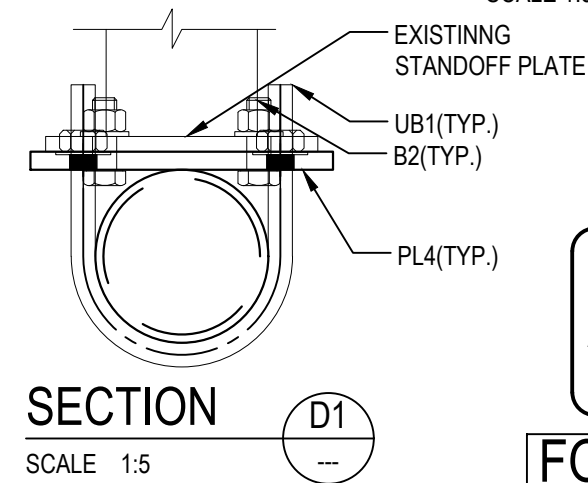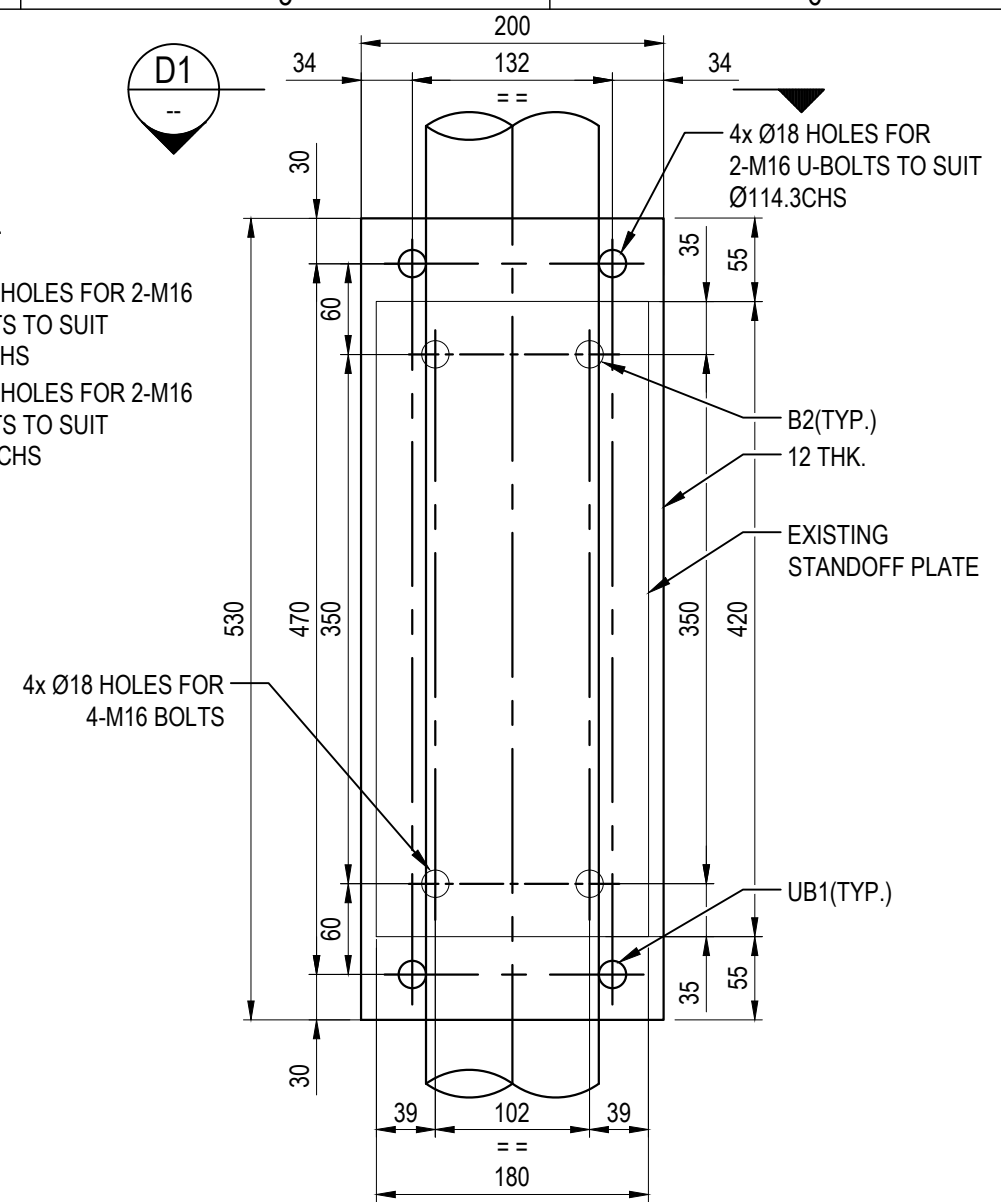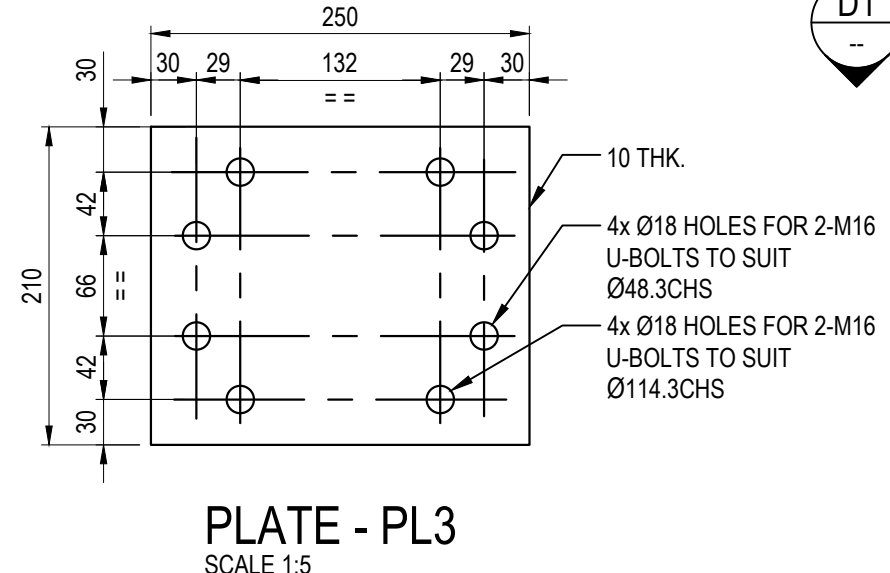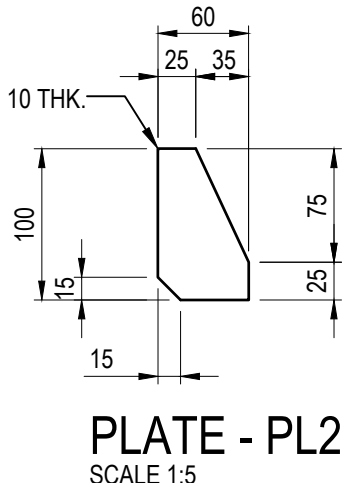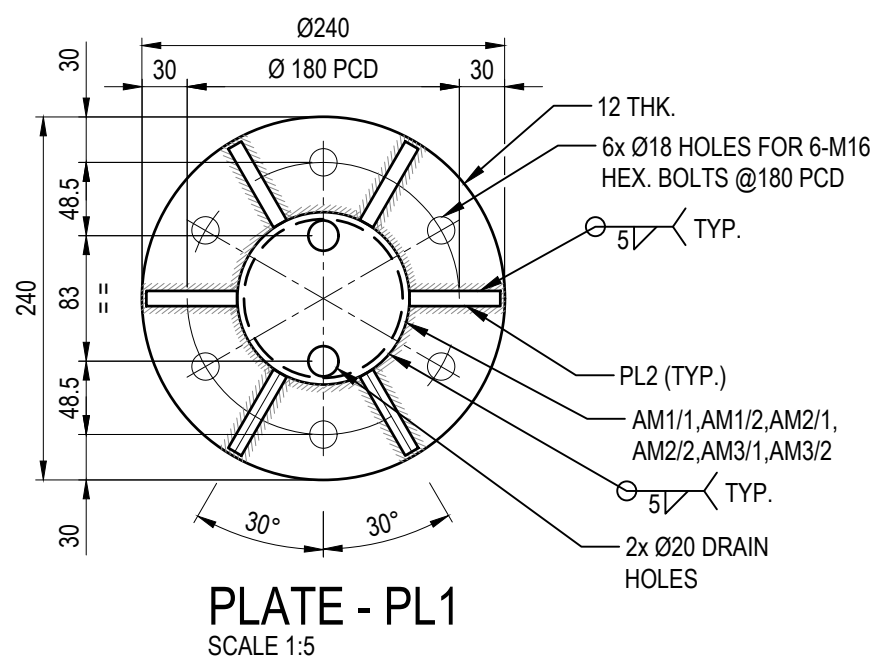

UNAPPROVED
DRAWING

COMPLIANCE BOX
COMPLETED AS PER DESIGN ☐
ALTERATIONS IN RED ☐
NAME (PRINT) _____
SIGNATURE _____ DATE _____

FOR CONSTRUCTION

MEMBER SCHEDULE		
ITEM No.	ITEM DESCRIPTION	Qty.
AM1/1	PROPOSED ANTENNA MOUNT Ø114.3x5.4Thk CHS,3293mm LONG	1
AM1/2	PROPOSED ANTENNA MOUNT Ø114.3x5.4Thk CHS, 2588mm LONG	1
AM2/1	PROPOSED ANTENNA MOUNT Ø114.3x5.4Thk CHS, 3388mm LONG	1
AM2/2	PROPOSED ANTENNA MOUNT Ø114.3x5.4Thk CHS, 3688mm LONG	1
AM3/1	PROPOSED ANTENNA MOUNT Ø114.3x5.4Thk CHS, 2988mm LONG	1
AM3/2	PROPOSED ANTENNA MOUNT Ø114.3x5.4Thk CHS, 3688mm LONG	1
UB1	M16 U-BOLTS TO SUIT Ø114.3 CHS WITH NUTS & WASHER GR. 8.8 TO FIX PROPOSED MOUNT AM2\2,AM3\2 TO PL4 (# REFER NOTE 4)	8
UB1	M16 U-BOLTS TO SUIT Ø114.3 CHS WITH NUTS & WASHER GR. 8.8 TO FIX PROPOSED MOUNT AM1\1,AM2\1,AM3\1 TO PL3 (# REFER NOTE 4)	8
UB2	M16 U-BOLTS TO SUIT Ø48.3 CHS WITH NUTS & WASHER GR. 8.8 TO FIX PROPOSED MOUNTS AM1\1,AM2\1,AM3\1 TO PL3 (# REFER NOTE 4)	8
UB3	M12 U-BOLTS TO SUIT Ø114.3 CHS WITH NUTS & WASHER GR. 8.8 TO FIX PROPOSED MOUNT AM1\2 TO EXISTING PLATE (# REFER NOTE 4)	4
PL1	Ø240x12Thk.	6
PL2	100x60x10Thk.	36
PL3	210x250x10Thk.	4
PL4	200x530x12Thk.	4
HB1	PROPOSED HORIZONTAL BRACING Ø48.3X5.4THK CHS,1400mm LONG	1
HB2	PROPOSED HORIZONTAL BRACING Ø48.3X5.4THK CHS,1900mm LONG	1
B1	M16 x 60mm LONG FULLY THREADED HEX. BOLTS WITH NUT AND WASHER OF GRADE 8.8 TO FIX PL1 TO PL1 (# REFER NOTE 3)	18
B2	M16 x 55mm LONG FULLY THREADED HEX. BOLTS WITH NUT AND WASHER OF GRADE 8.8 TO FIX PL4 TO EXISTING PLATE (# REFER NOTE 3)	16

NOTE :
IF EXISTING U-BOLTS ARE NOT IN GOOD CONDITION
THEN USE UB3 U-BOLTS

NOTE FOR MANUFACTURER & INSTALLER:
TRIAL ASSEMBLE PRIOR TO GALVANISING AND DELIVERY
TO SITE TO ENSURE CORRECT FIT AND NUMBER OF PARTS

CYIENT
Level-14, 3 Parramatta Square, 153 Macquarie St, Parramatta, NSW 2150, Australia
T +61 8887 8600 | www.cyient.com

ORDER	DRWN	CHKD	AMENDMENT	EXAM	APPD	DATE	ISS
NA30121.01	KGK	GNK	FOR CONSTRUCTION - 80005689W0804CY1 - NR850	MB	MB	06.08.26	1

© Telstra Limited ACN 086 174 781 All rights reserved.

Telstra
MOBILE NETWORK SITE 117609
TELOPEA CMTS
ANTENNA MOUNTING DETAILS - SHEET 4 OF 4
33 STURT ST, TELOPEA, NSW 2117
DWG NO. **N26894** SHT NO. T3-6